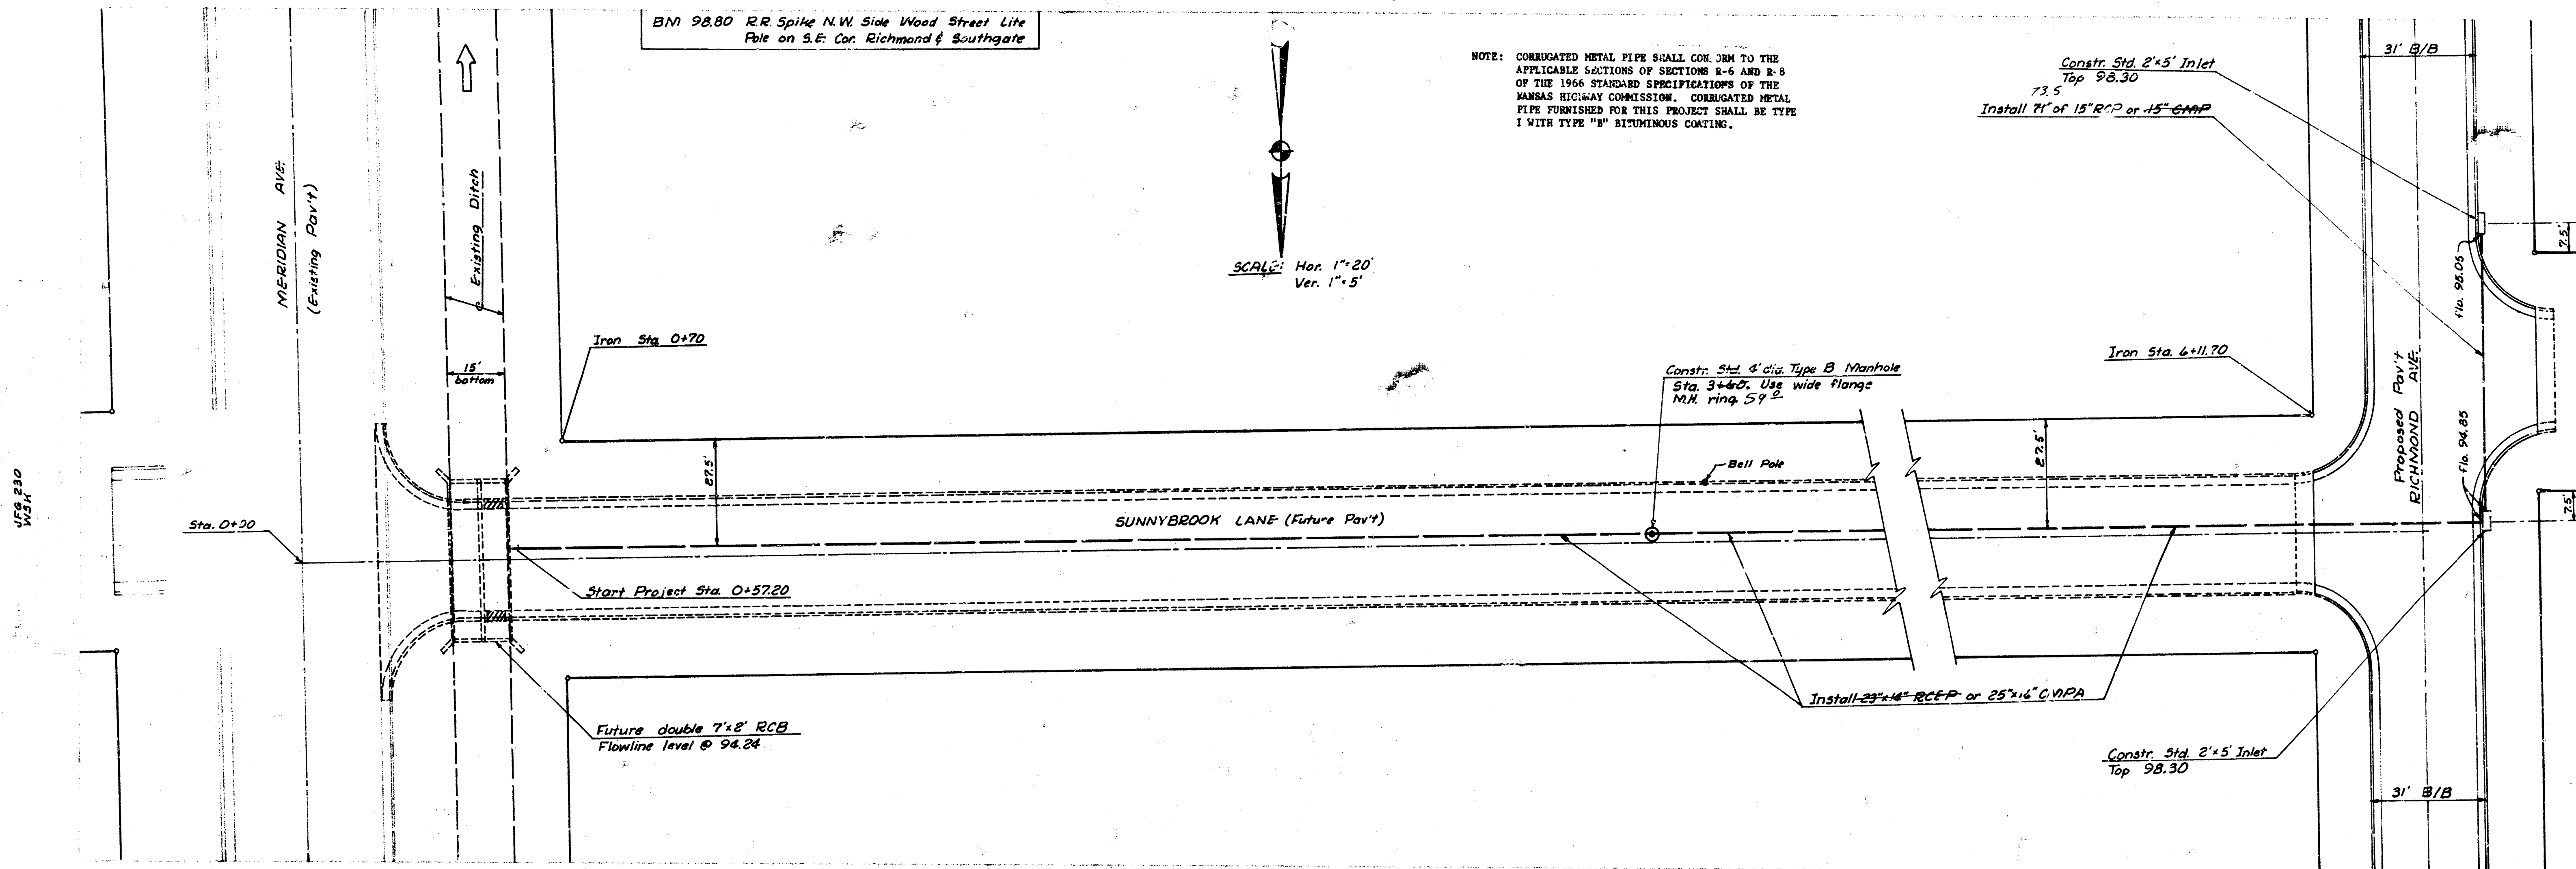


INCIDENTAL DRAINAGE IN CONNECTION WITH RICHMOND AVE. FROM S.E. SOUTHGATE TO N.E. BLOCK 4, BUILDERS 14th ADDITION.

CITY OF WICHITA, KANSAS

R.W. LINN, CITY ENGINEER

DATE: Dec. 1973

PROJECT NO. DAND 549054

SHEET 1 OF 1