
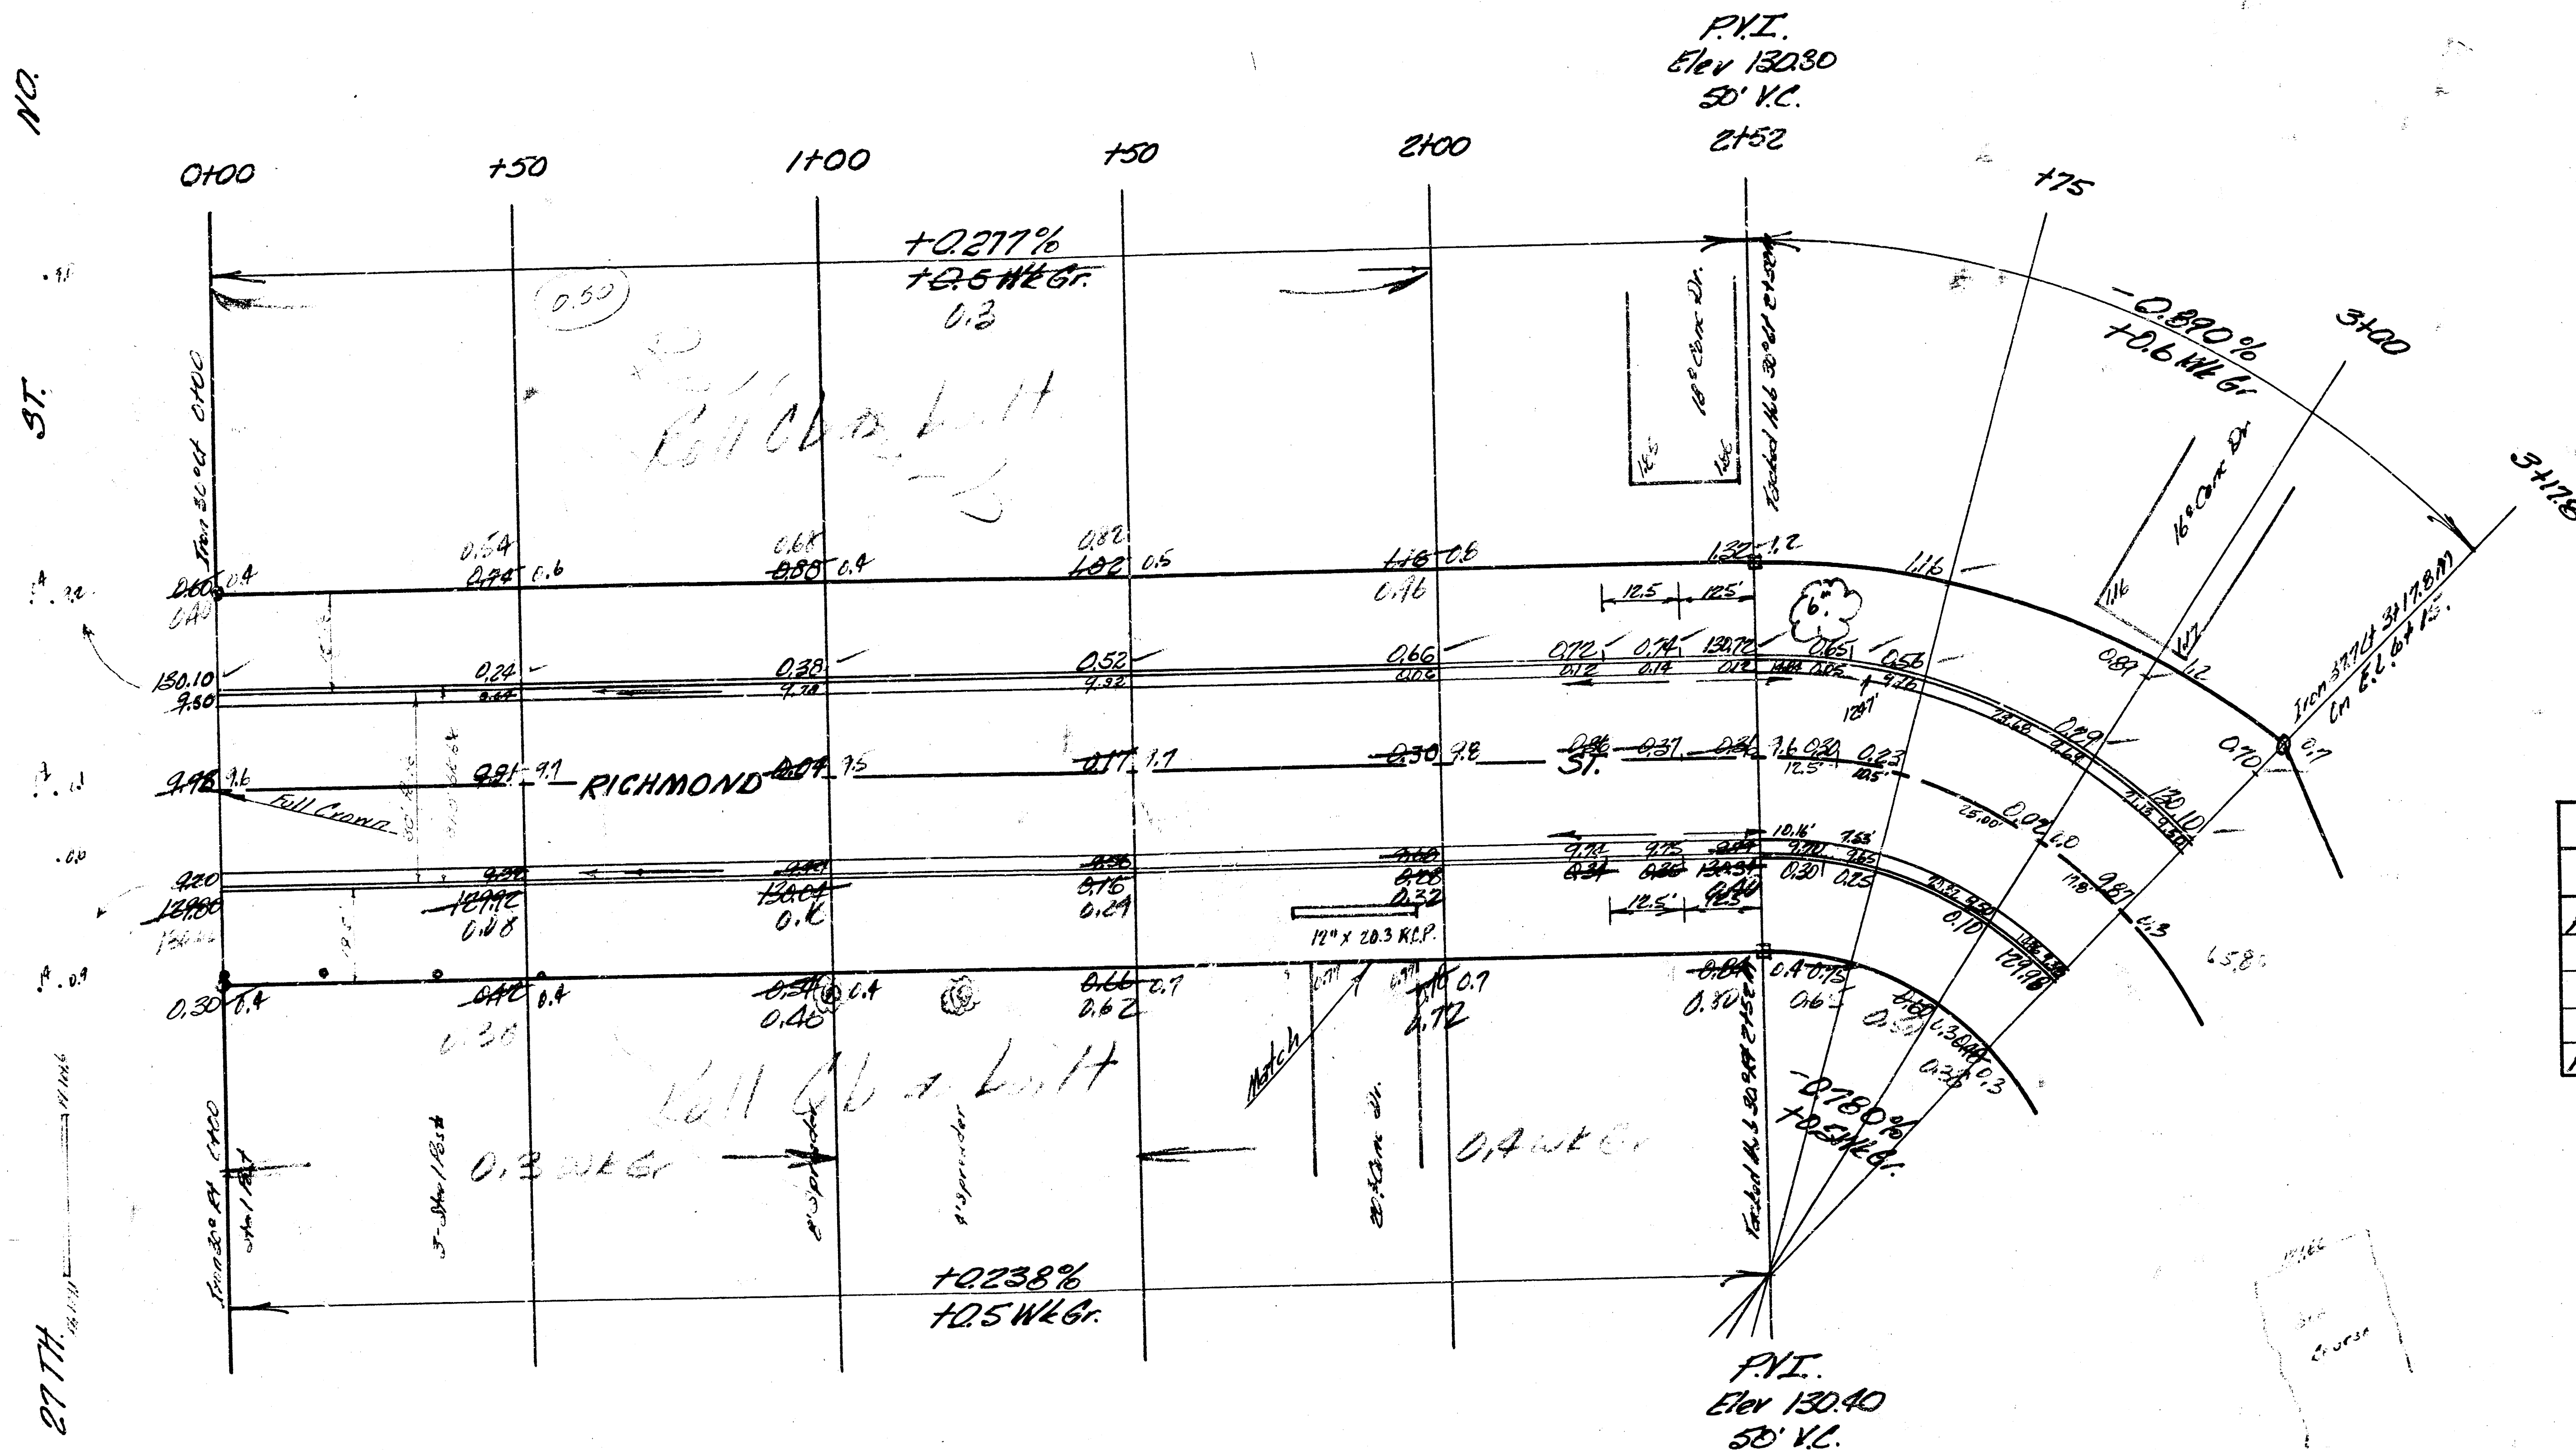


B.M. 131.00 3E. Cor. 1st Conc. Strip N.E. Cor. 27th & Richmond

NOTE TO CONTRACTOR & FIELD ENGR.
From Sta 2+12 to 3+17.8 West side.
Construct back of Walk in Drives 30' from
C of P.B.T. N.E. Grds. Shown are 30' &

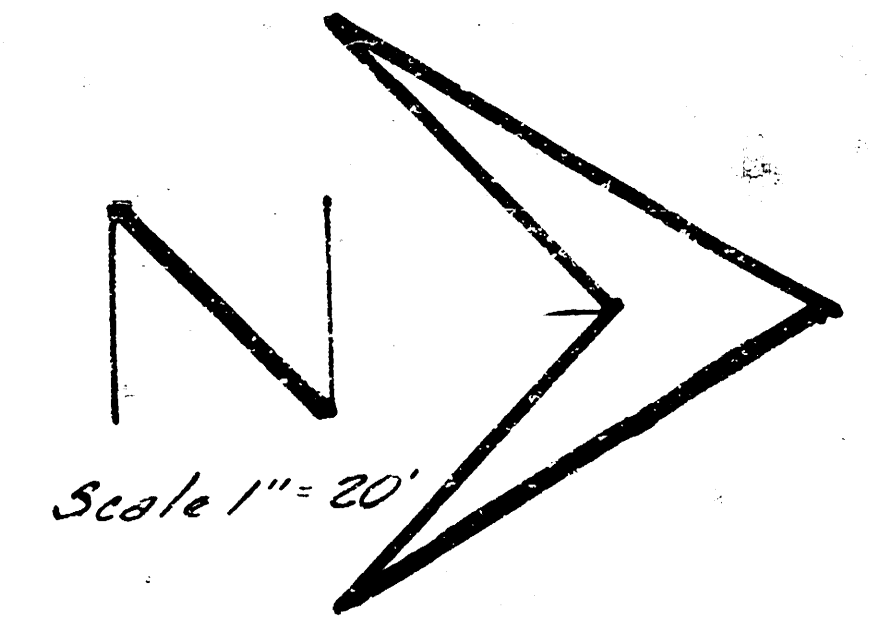

CURVE DATA BASED ON Q.R. 80.06' Δ 67°-44'					
Sta	Arc	Chord S. @ West Cb.	Chord S. @ East Cb.	Deflection	Total Chord
PT. 2+52					
+75	23°	29.51'	16.34'	8° 13' 48"	8° 13' 48"
3+00	25°	32.05'	17.74'	8° 56' 44"	17° 10' 32"
3+17.8	17.2	22.87'	12.66'	6° 22' 10"	25° 30' 48"
PT. 3+14.64	28.82	36.93'	20.45'	10° 19' 18"	35° 32' 20"

2146981' total R.



Baseline - 30' W of E.R.

Excavation
Prop.

304.0 CY. 176.301
30.4 +10%
334.4 CY. Total

Comp. Fill
Prop.

2.6 CY. 50.101
2.8 +10%
2.9 CY. Total

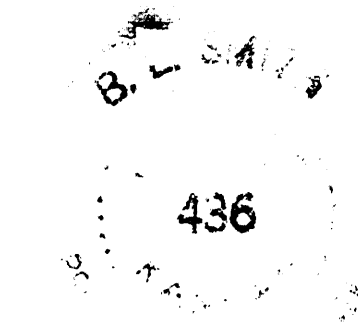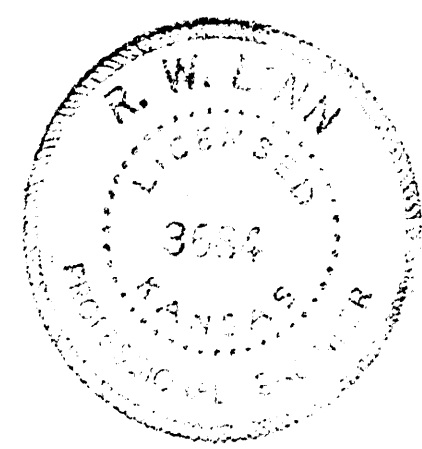

1/2

RICHMOND ST.
N.E. 27th St. No. 10
E.L. Lot 15 Bldg 3, Valley Park Add.

26'-2" - 30' AC.

CITY OF WICHITA, KANSAS
BESMITH CITY ENGINEER
DATE: JUNE 1966 PROJ. C15-7