


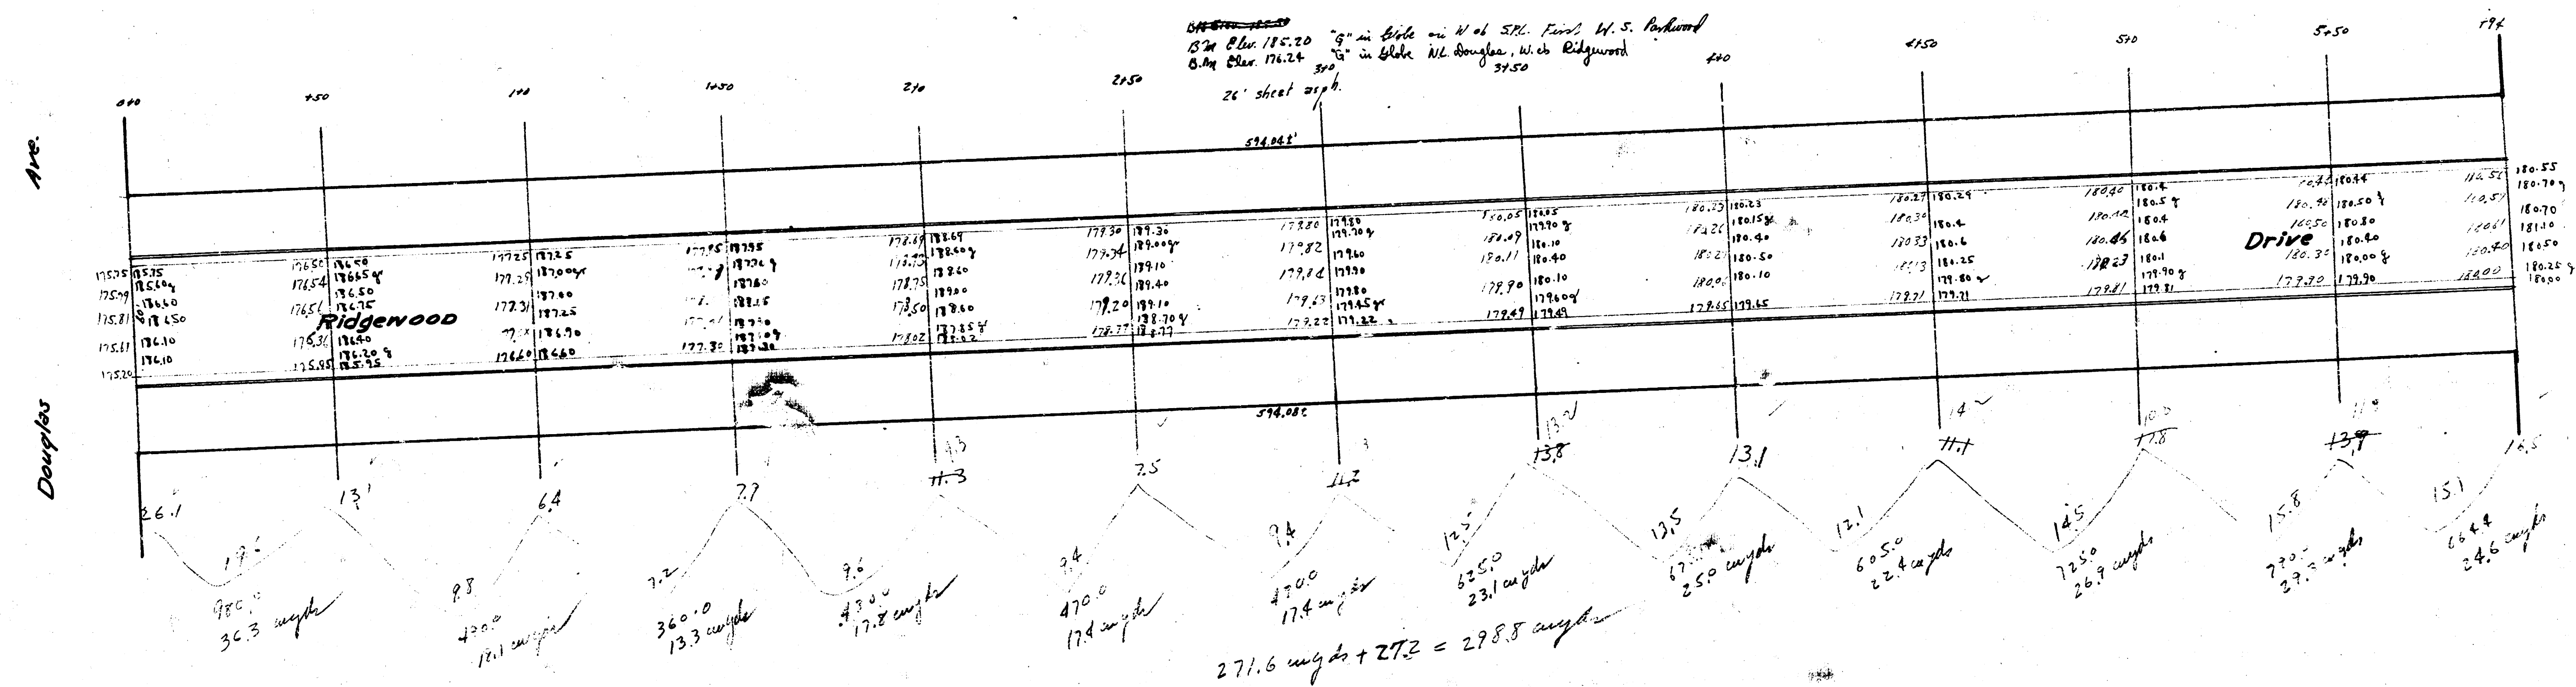

$$\begin{array}{r} \text{Soc} = 714.0 \\ + 12 = \underline{12} \\ \text{Total} = 726.0 \end{array}$$

