


26' Sheet Asph. - 8. Base
 817. 1155 W. Curb Ridgewood SL 1st St.

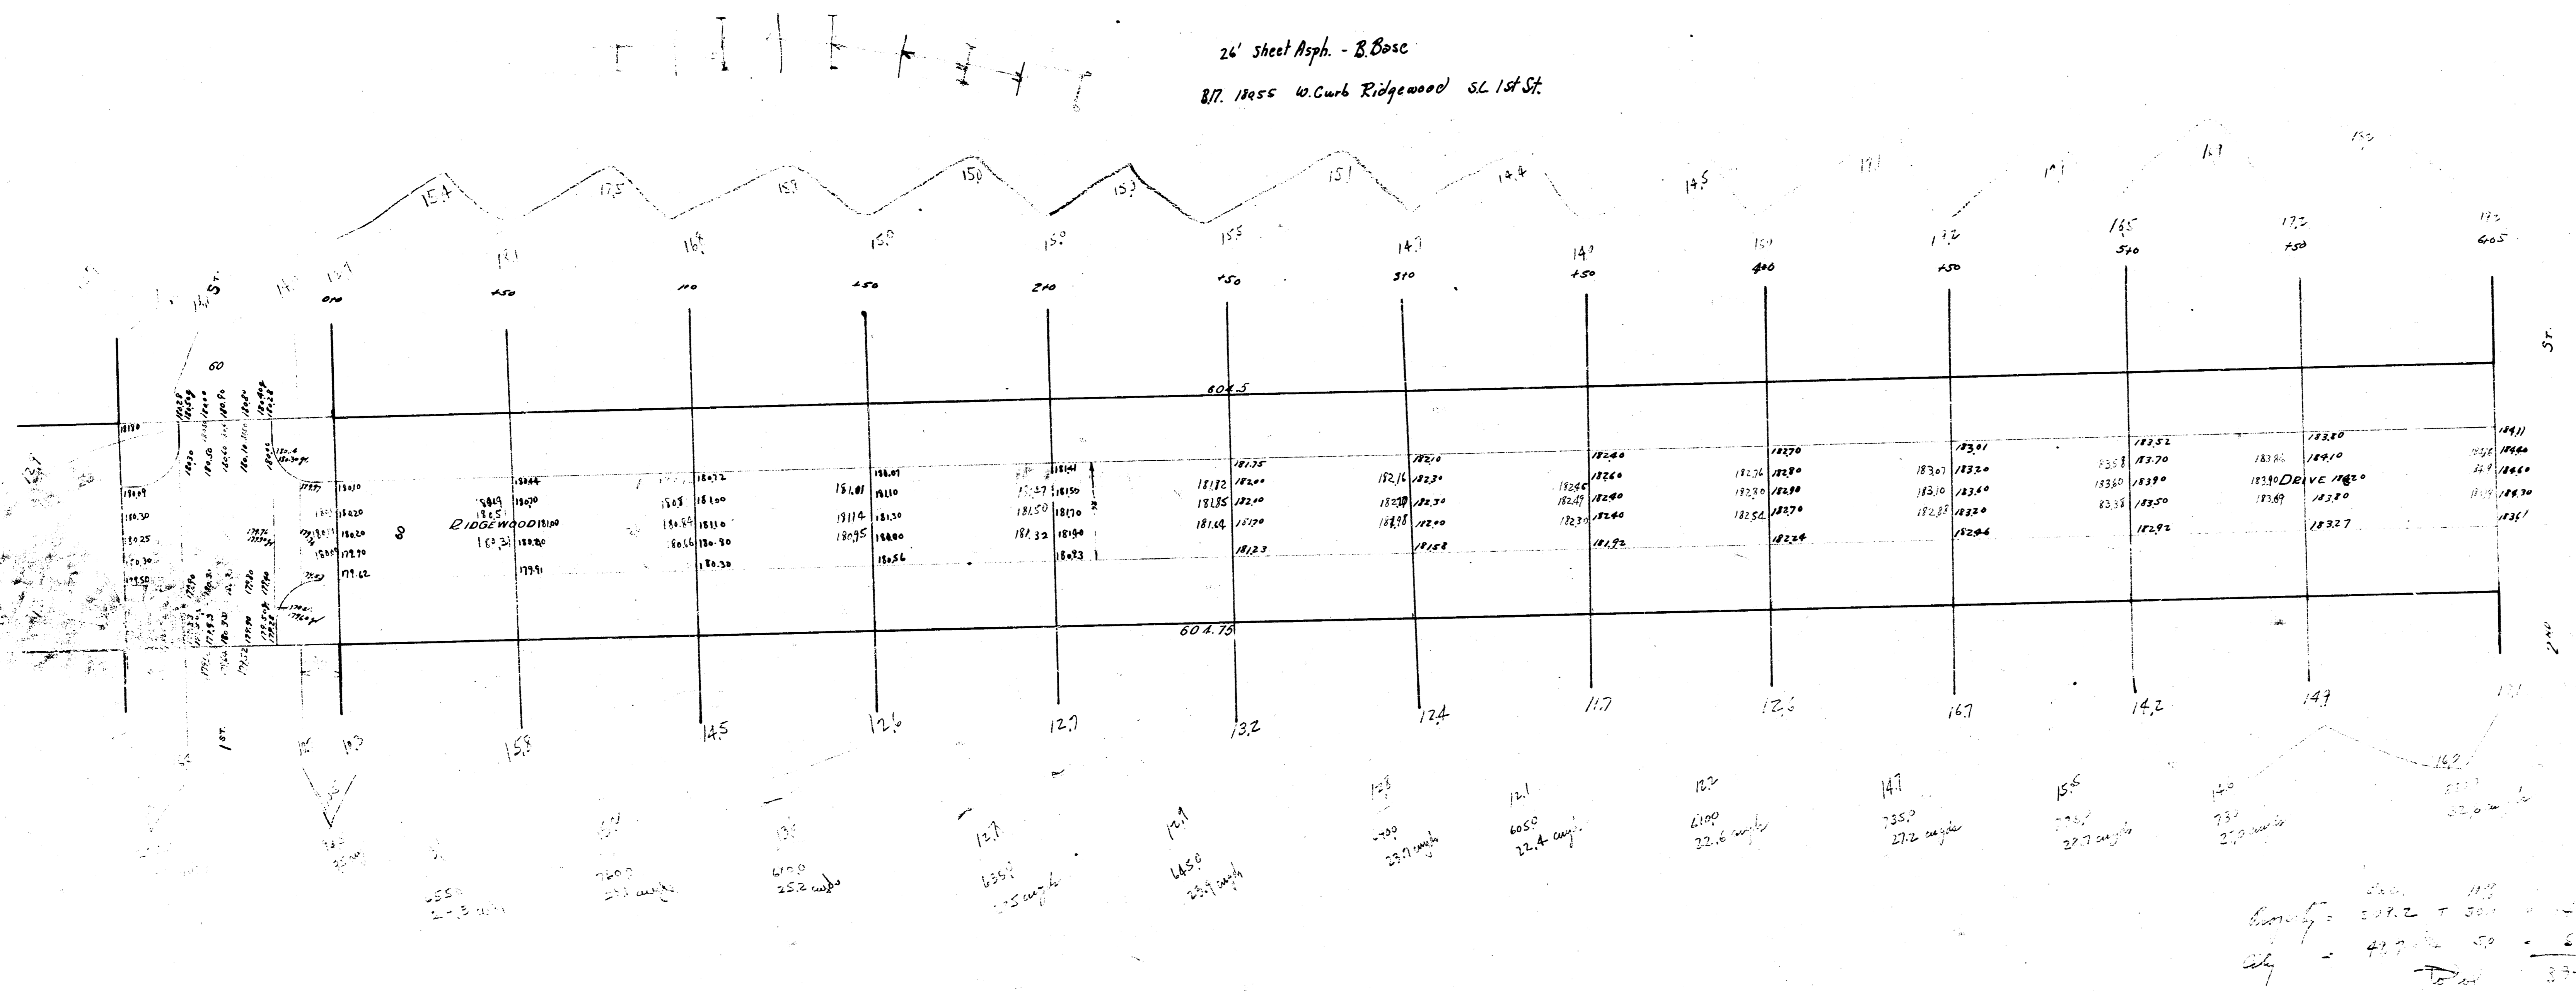

