


B.M. 20709 "G" in GLOBE, N.E. Edgewood, S.S. 10th
 R.M. 200.11 "H" in Mueller, Fire Hydrant, S.E. Cor. Edgewood & Edgewood
 Stationing on N.E.

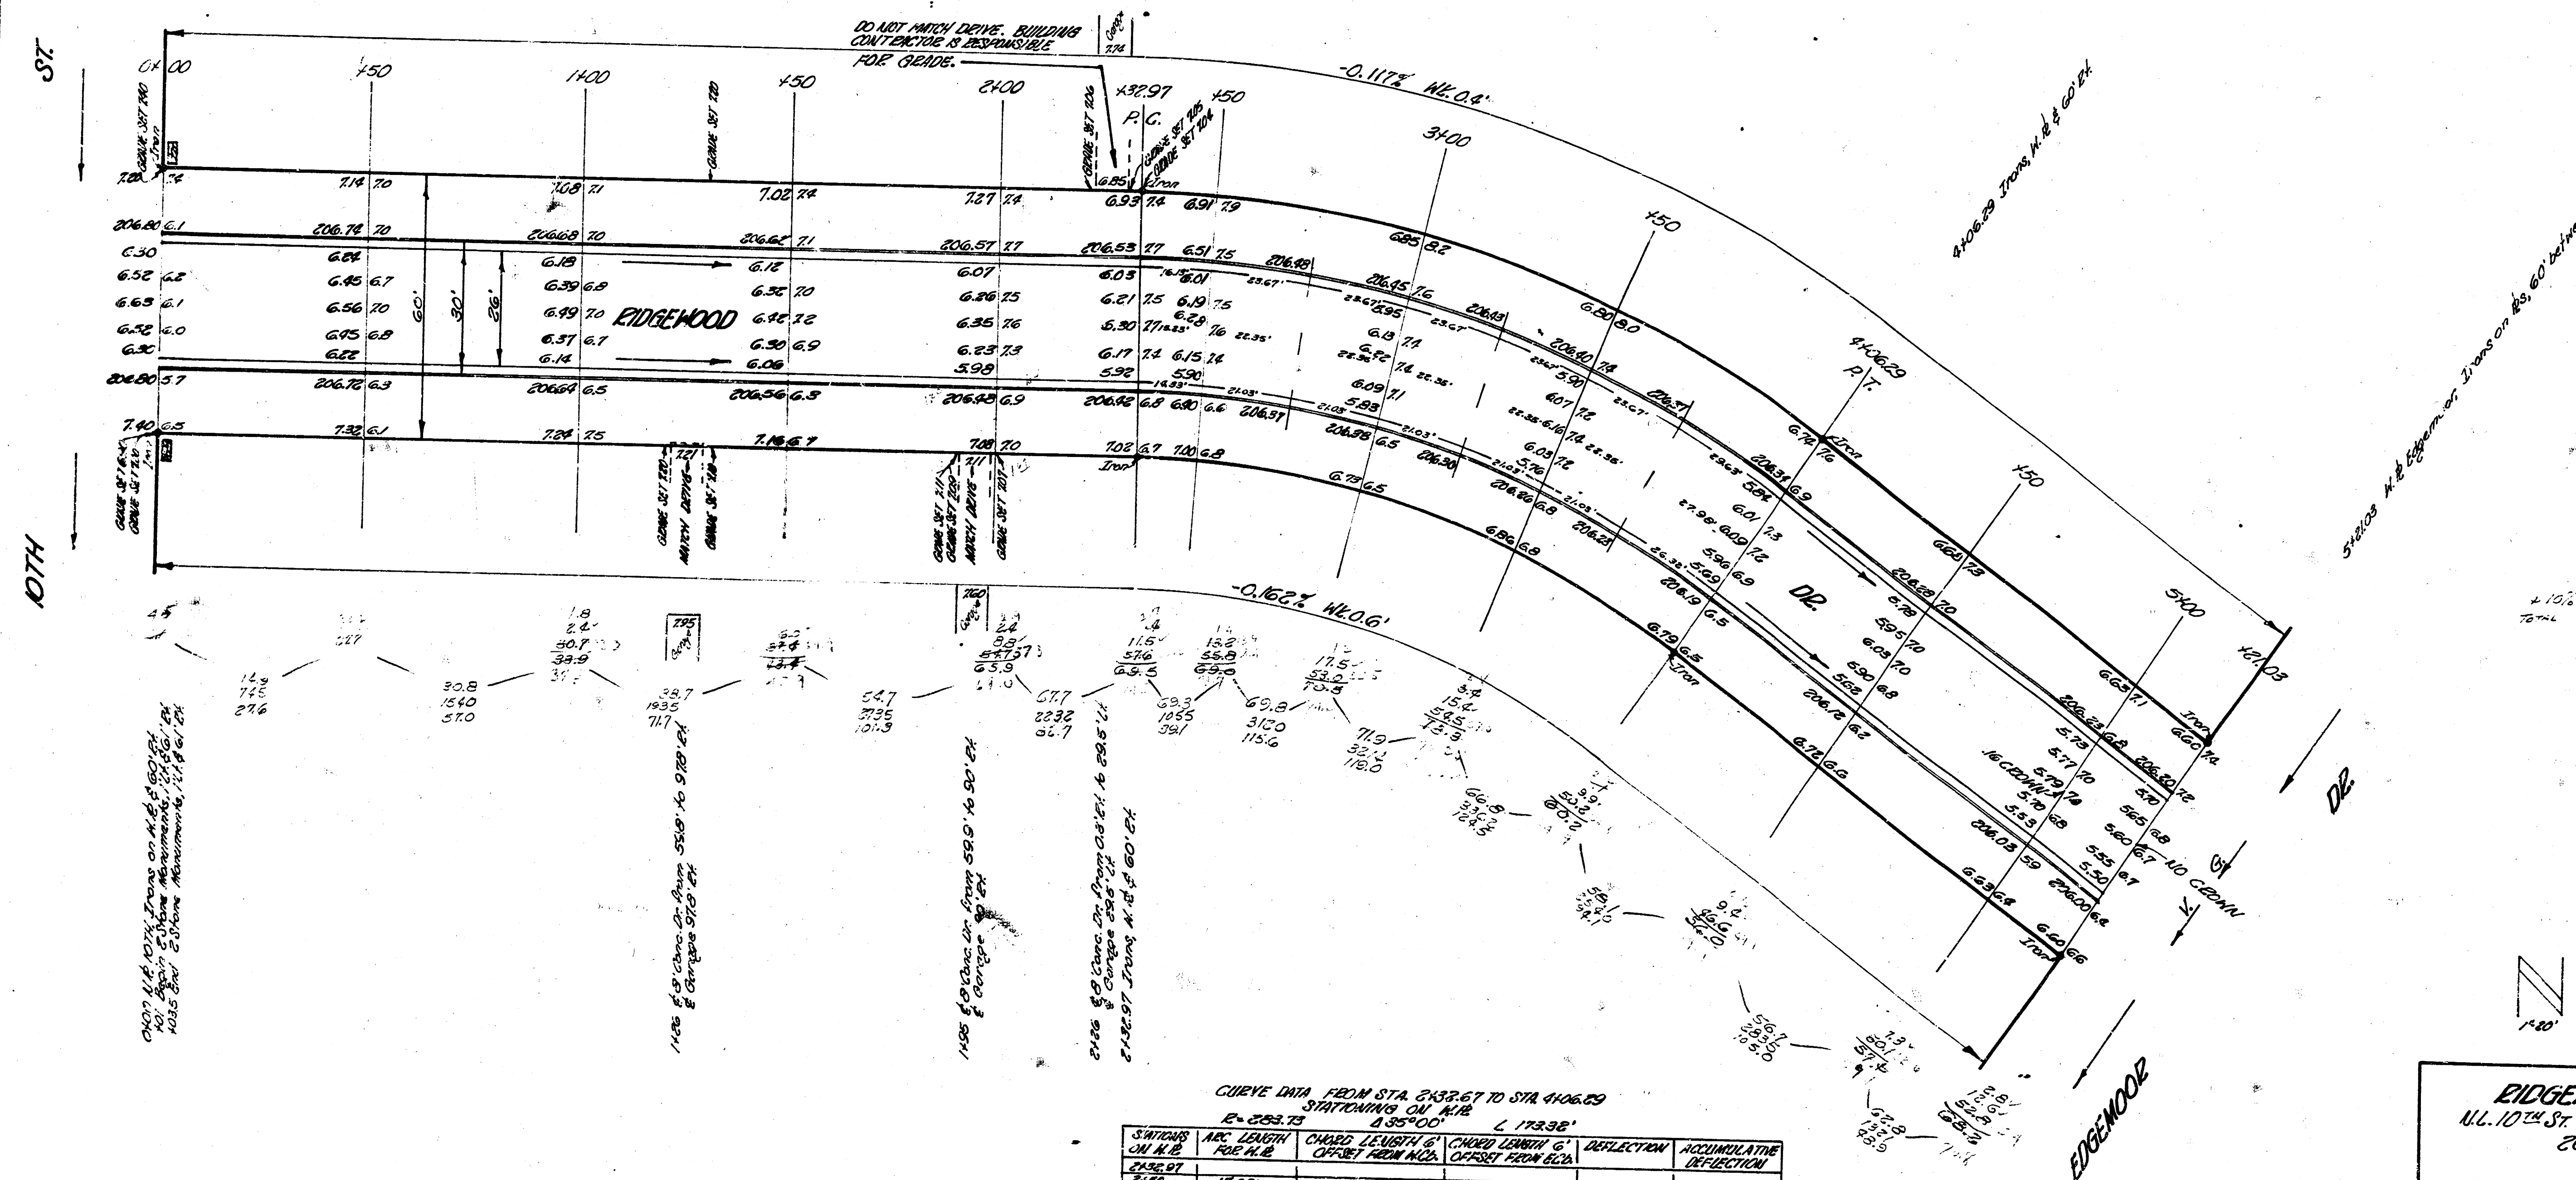


STATION	ARC LENGTH CHORD	CHORD LENGTH OFFSET FROM N.E.	CHORD LENGTH OFFSET FROM S.E.	DEFLECTION	ACCUMULATED DEFLECTION

 E.G.-2-30.A.C.

CITY OF WICHITA, KANSAS

DE SMITH
 June 1953
 CITY ENGINEER
 From W.A. DE-258



Survey M.C.
 E.G. 2-30
 Checked