
B.M. STD. 6' NO. & 2' E. OF S.E. COR. MERIDIAN & MAY — ELEV. 104.85
B.M. 1/2 D SPIKE IN E.FC. A.T.&T. POLE 90' NO. & 22' W. OF NO. IRON AT MERIDIAN & RITA — ELEV. 104.32


NOTE
INSTALL 40-15" R.C.P. IN DITCH ON MERIDIAN
CONSTR. A DIRT & SAND HOOKUP.

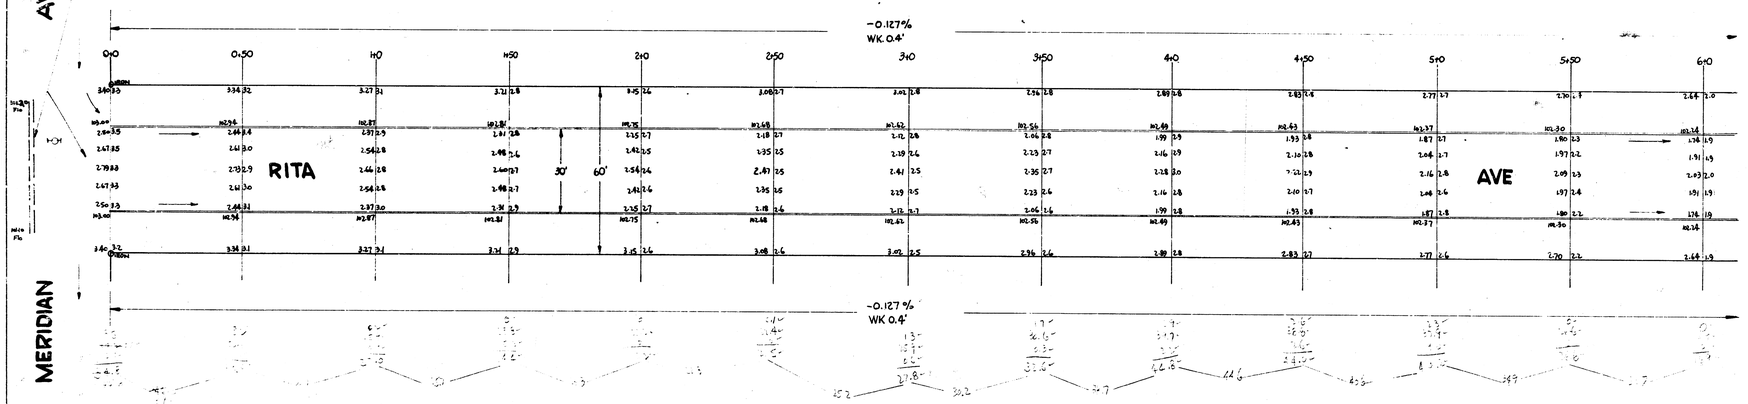

B. E. SMITH 436

RITA AVE
E. L. MERIDIAN TO W. L. EVERETT
30' CONC & CURB
CITY OF WICHITA, KANSAS
B.E. SMITH — CITY ENGINEER
JULY 1955 — PROJ. NO C14-365

B.M. "M" IN MUELLER FIRE PLUG N.W. COR RITA & EVERETT ELEV. 105.44

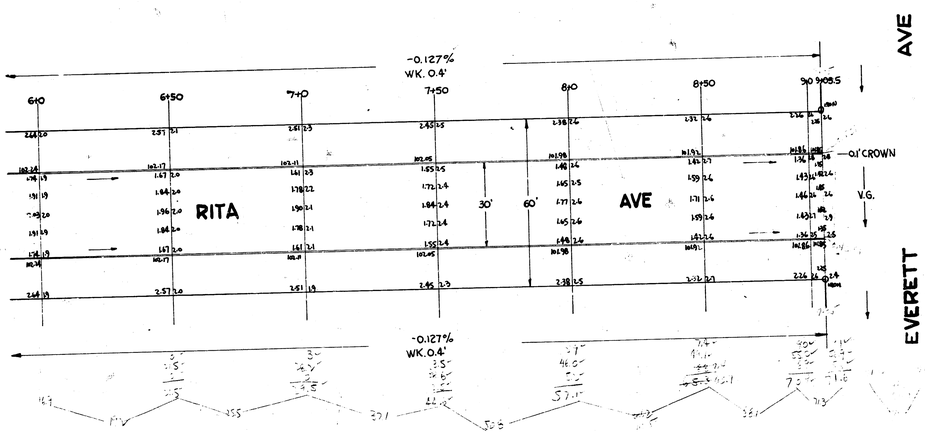

N

RITA AVE

PROJ. NO. C14-365