


NOTE TO CONTRACTOR

APPROXIMATELY 1960, THE CONSTRUCTOR
FROM ANY EMPLOYMENT OF THE
OPERATIONS FROM THE
REQUIREMENTS OF THE
EMPLOYMENT, WAS
4-18-74

DES

0-6-72

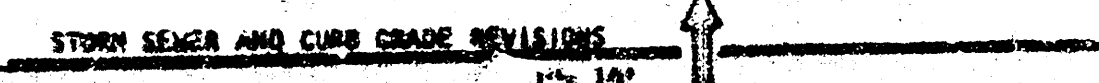

RELOCATION OF RIVERVIEW STREET NORTH
OF SECOND STREET.

DATY OF MICHITA PROJECT: BMB 503028 (4/25/1973)

