



ROCHESTER AVENUE

N.L. 14TH ST. TO S.L. 15TH ST.

PROJ. NO. C12-232

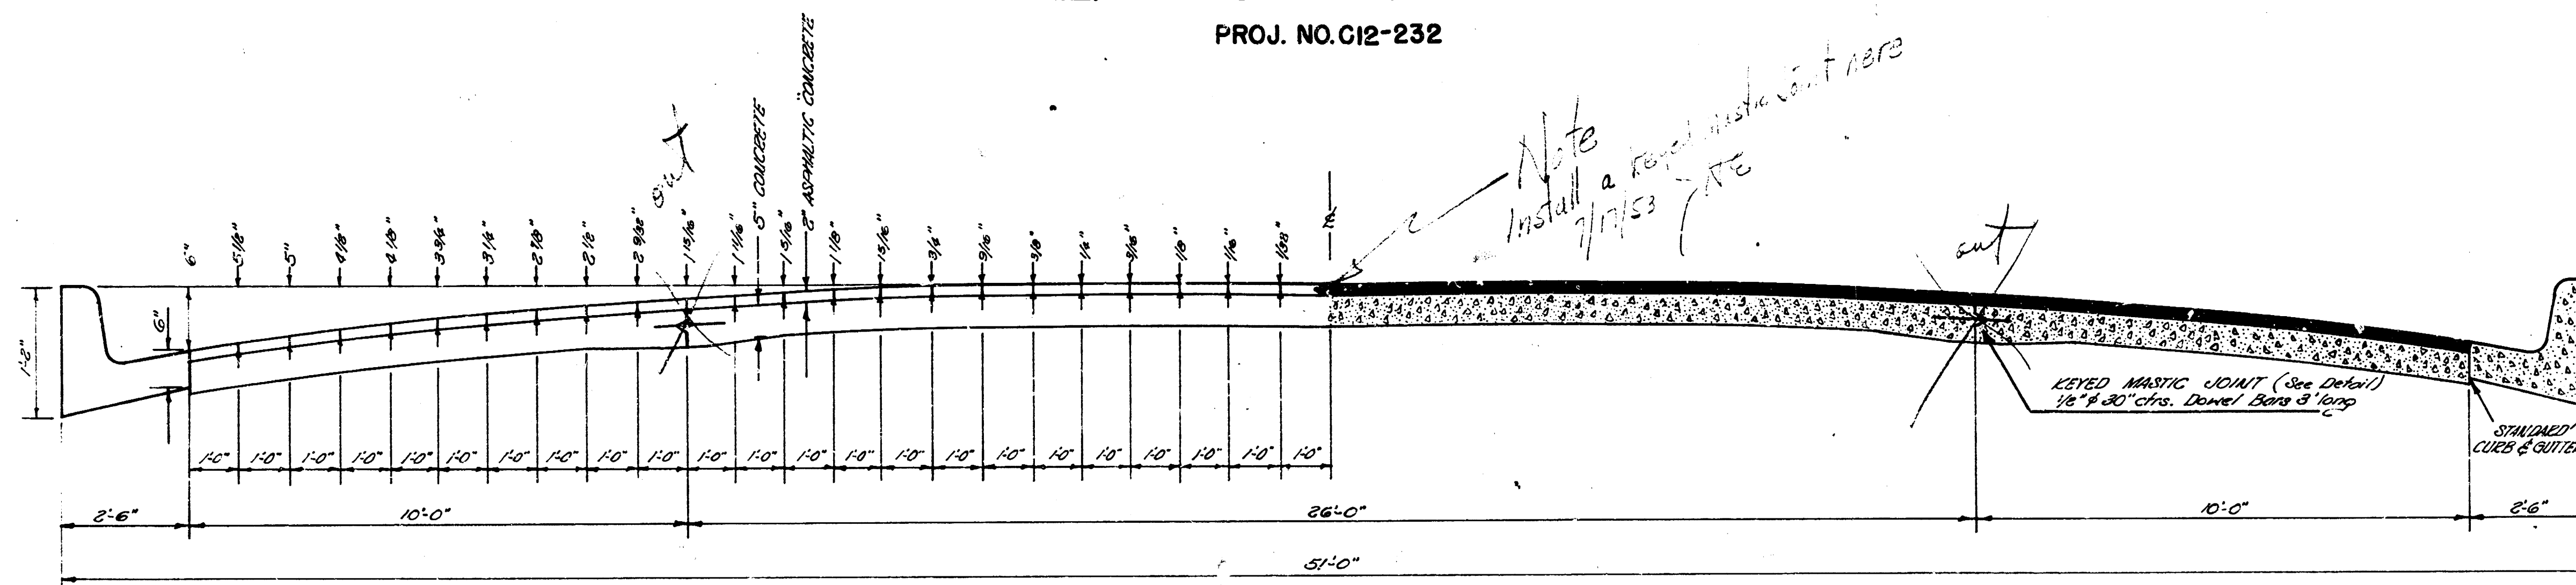

TYPICAL SECTION
NOT TO SCALE

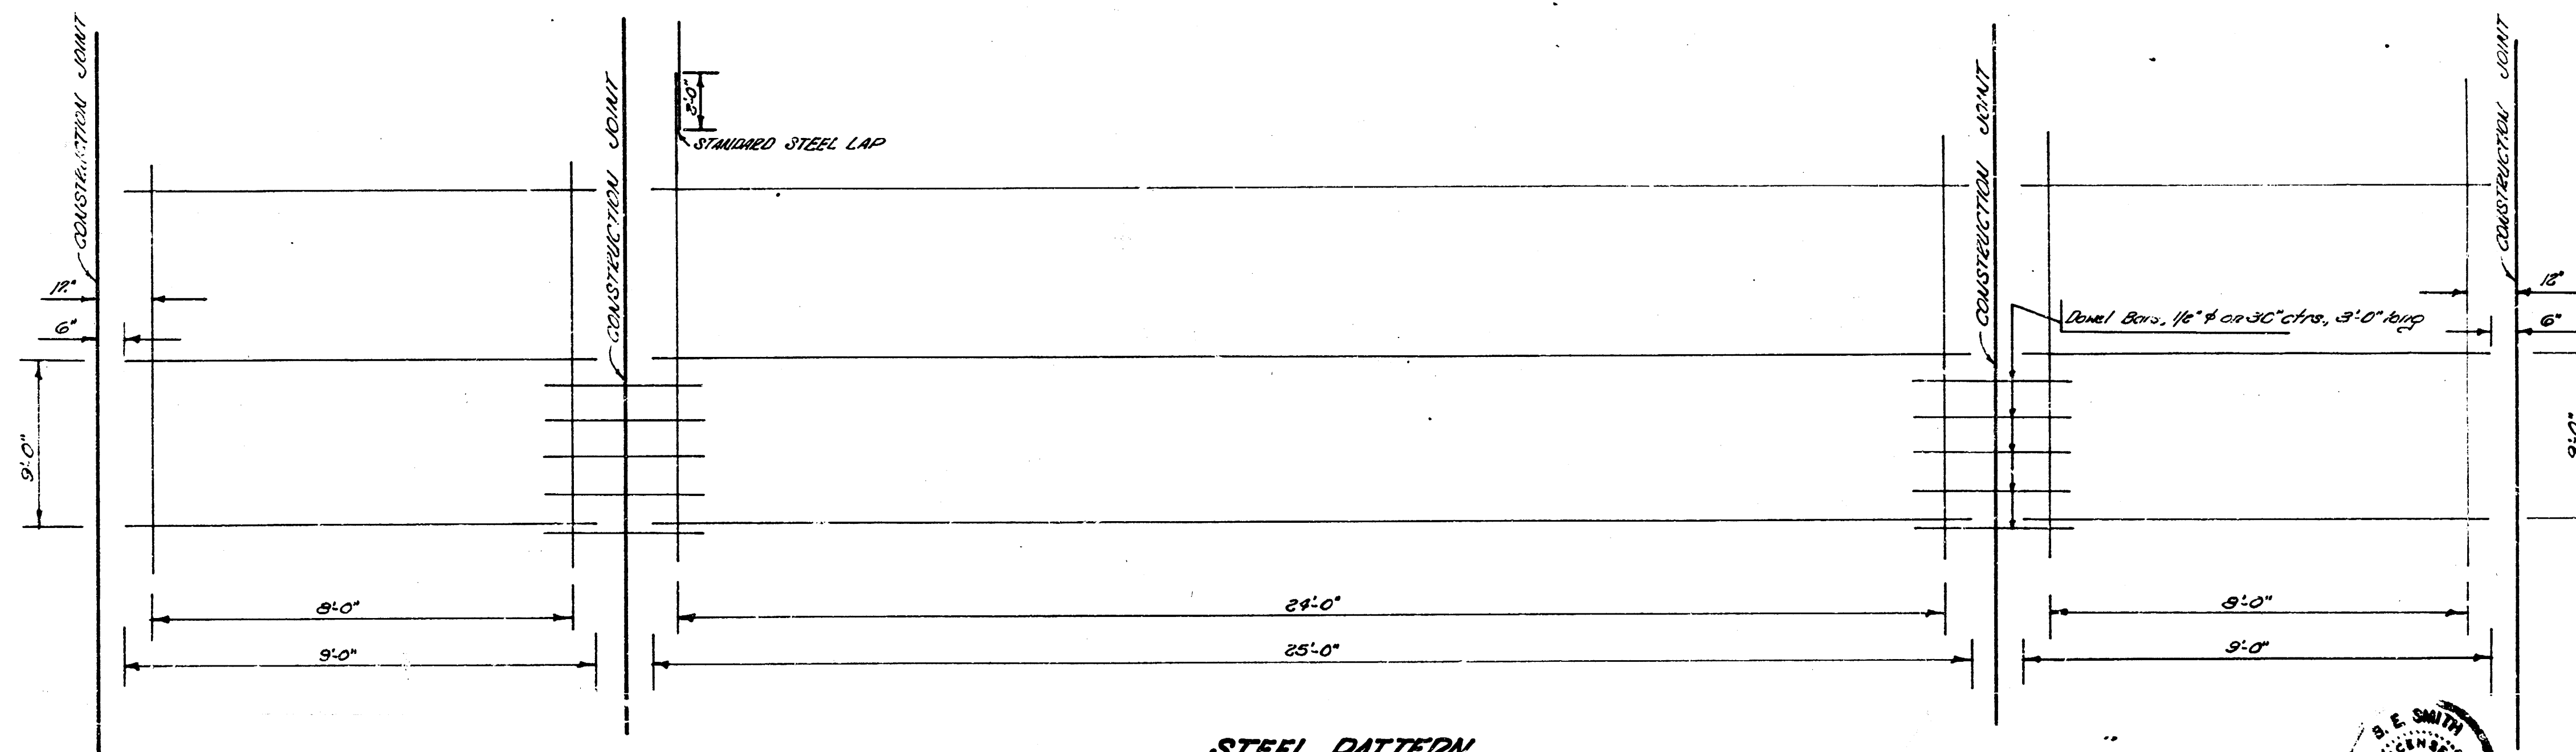

STEEL PATTERN
NOT TO SCALE

USE $3/4"$ ϕ BARS EXCEPT WHERE OTHERWISE NOTED

