



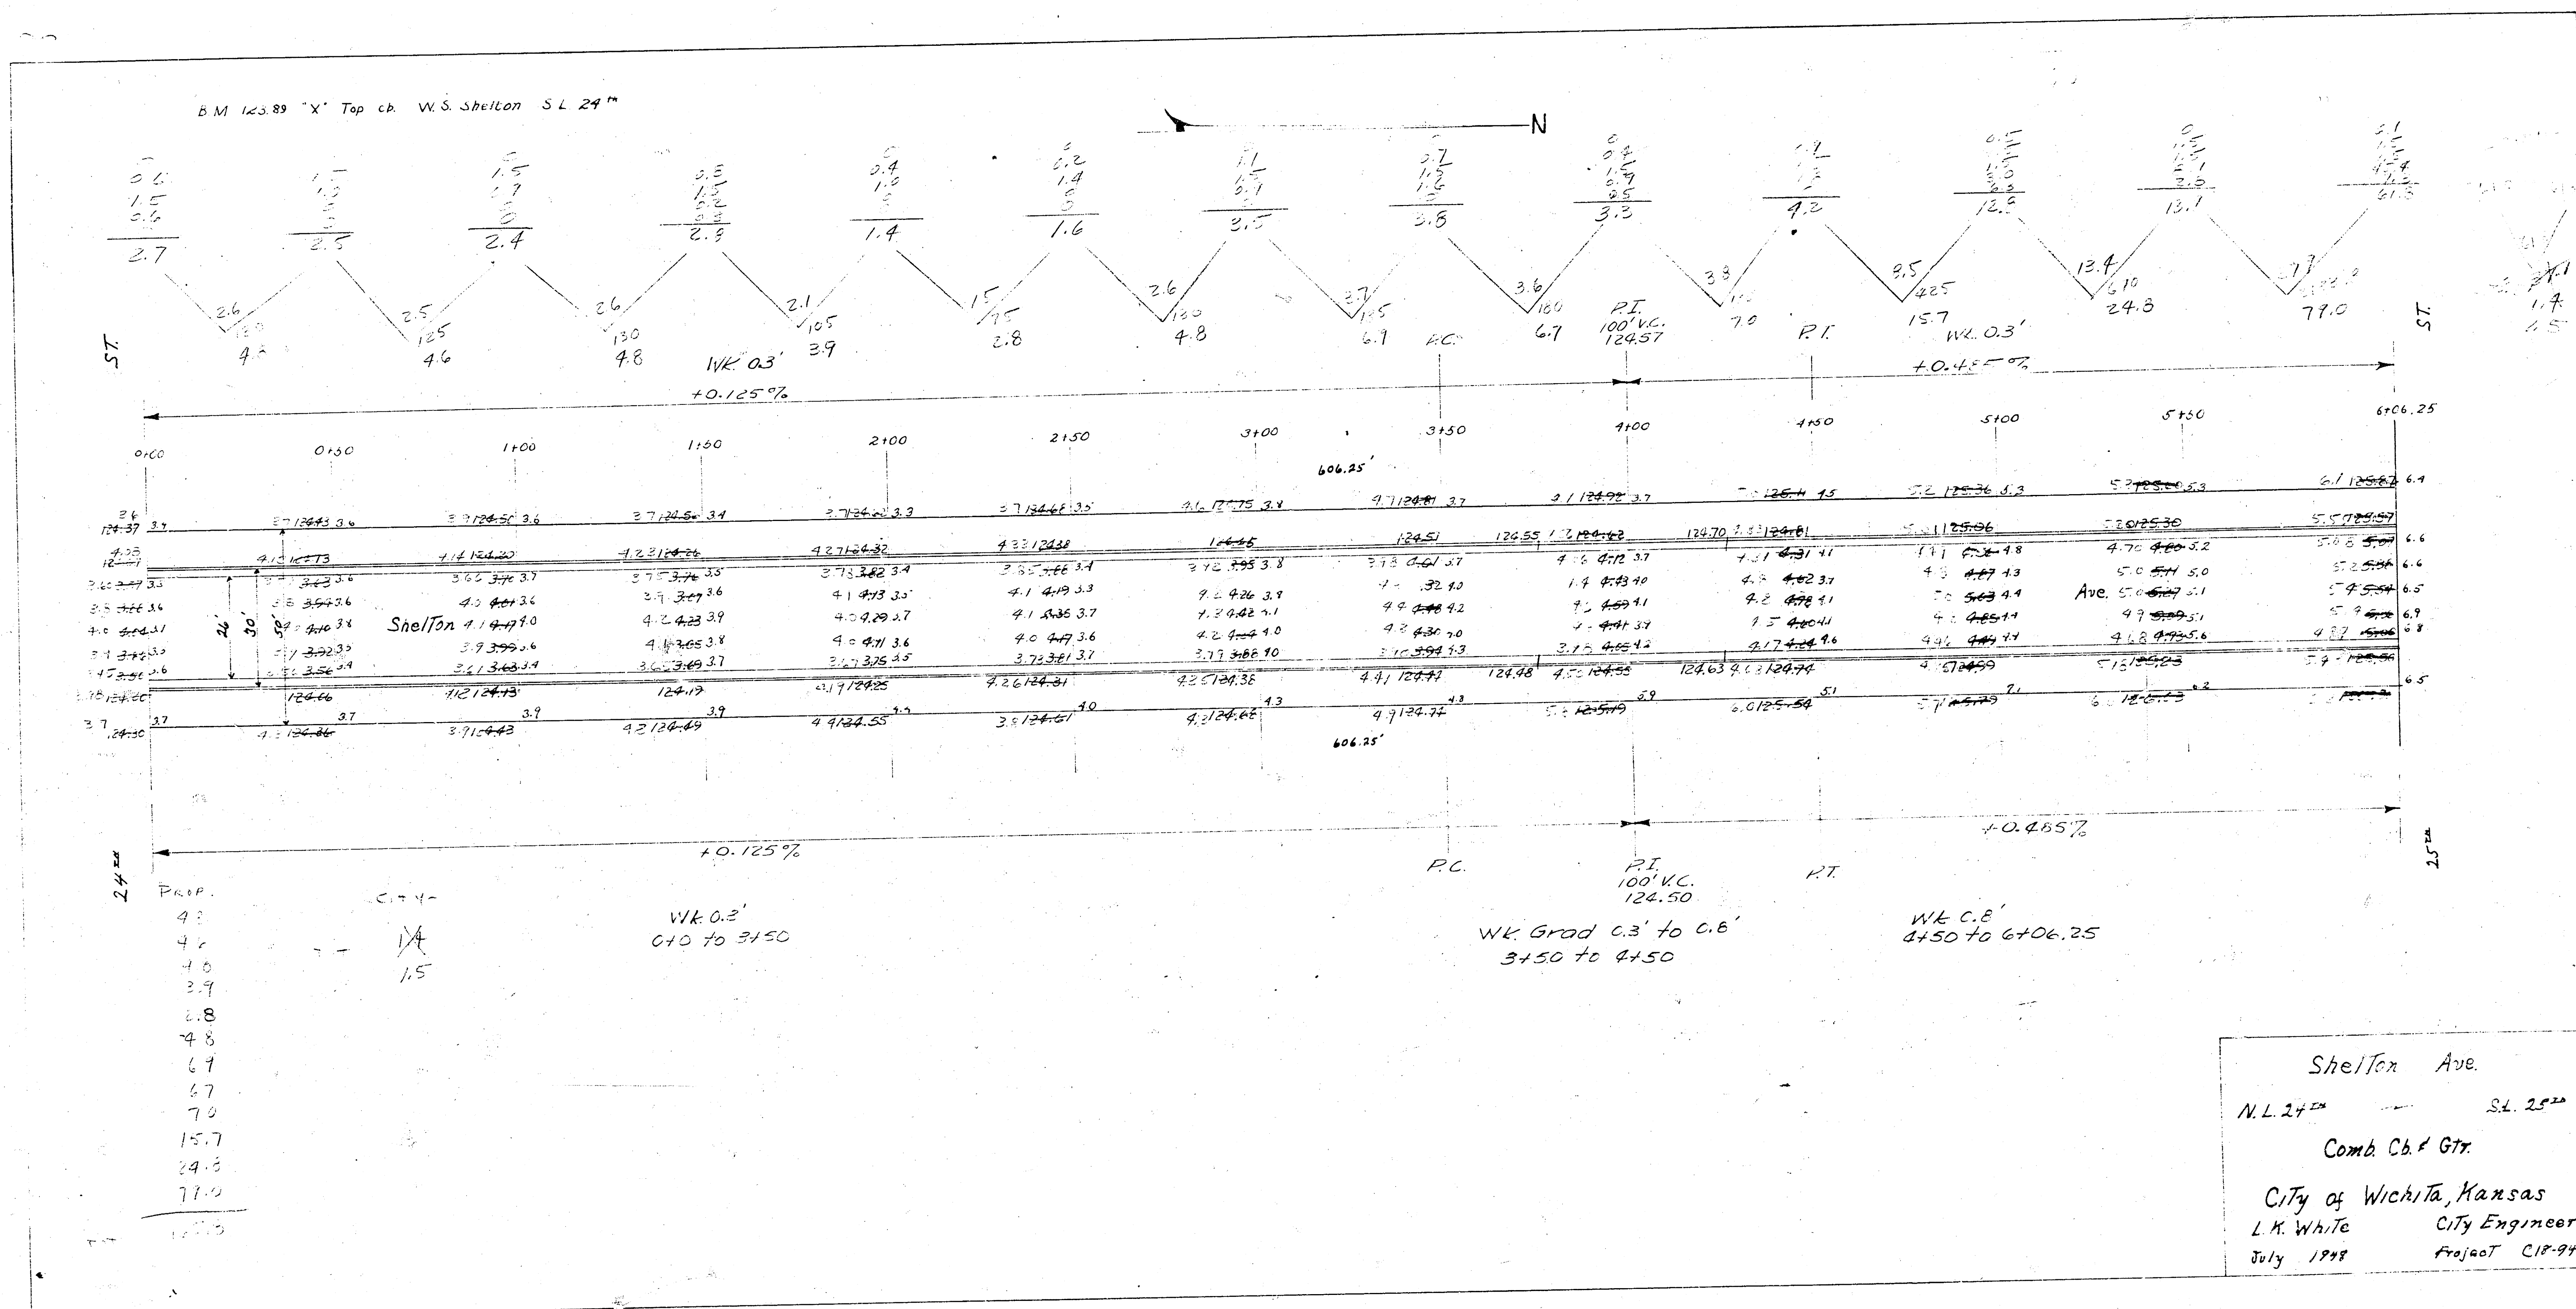

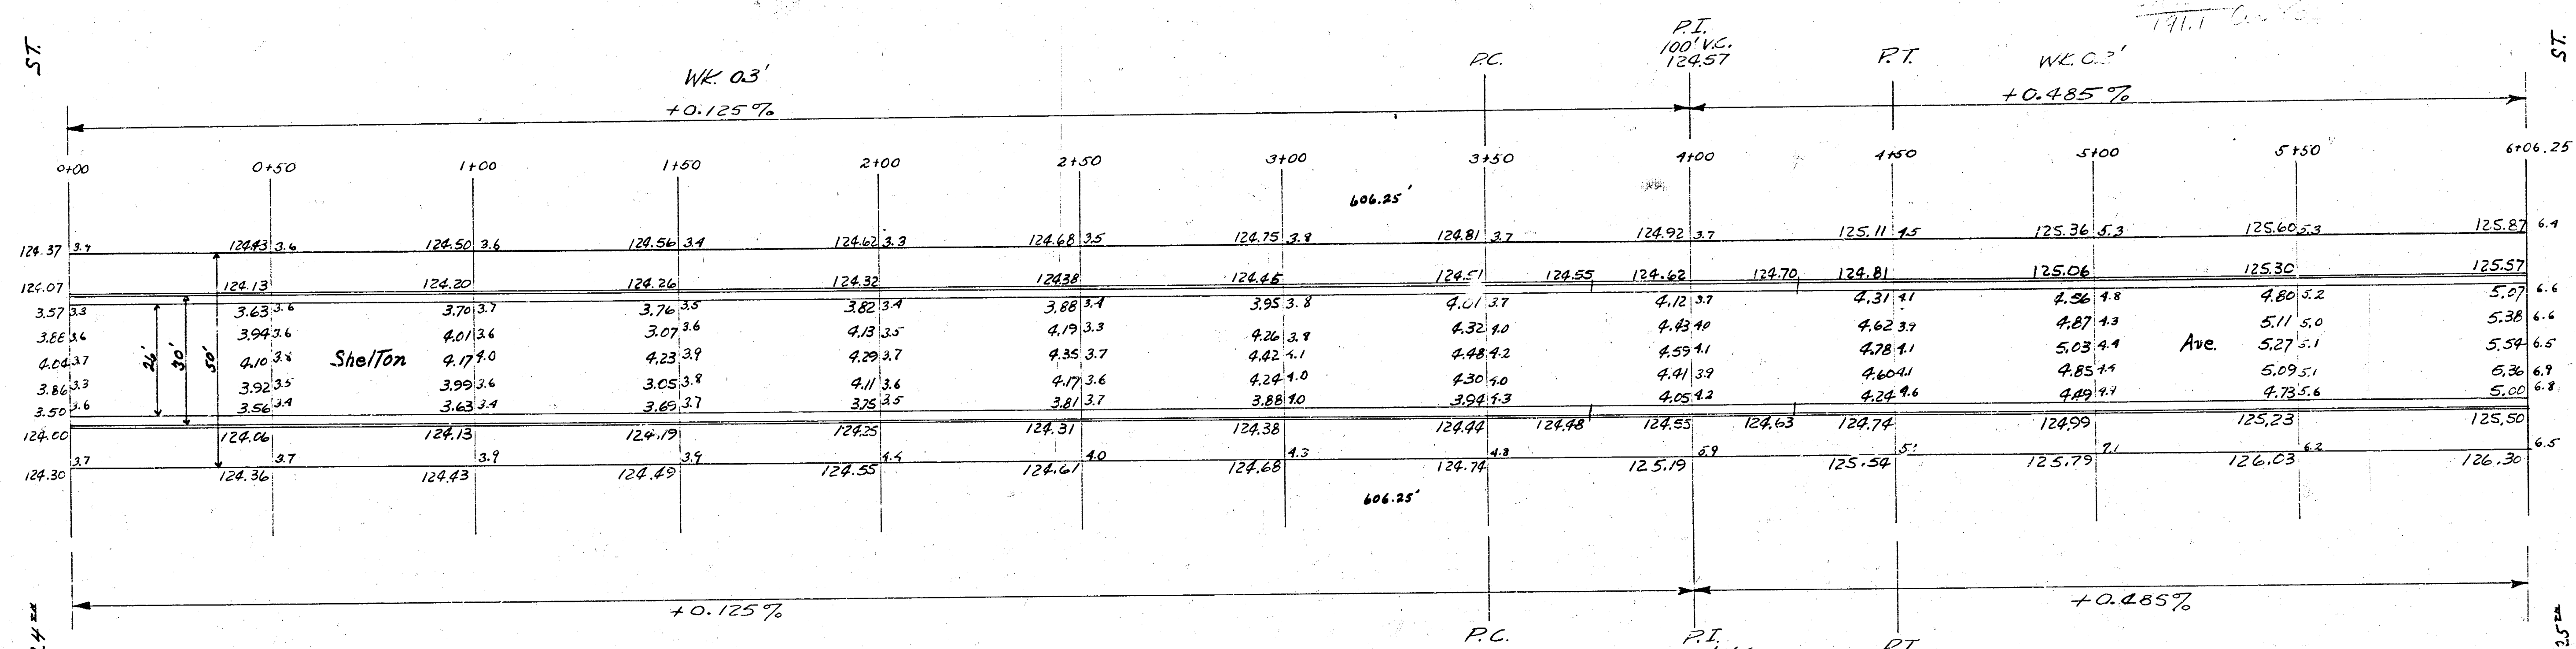

WK 0.8'
4+50 to 6+06.25

Shelton Ave.
N.L. 24th — S.L. 25th
Comb. Cb. & Gtr.
City of Wichita, Kansas
L.M. White City Engineer
July 1918 Project C18-94