


Seal # S-29

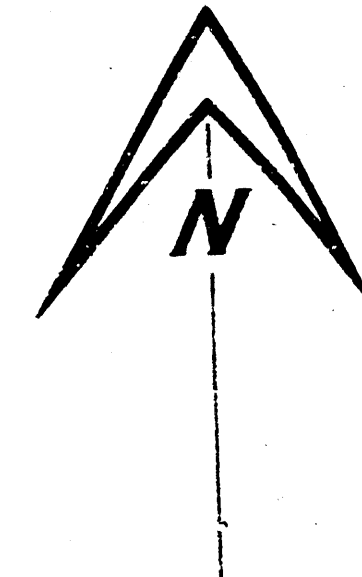

<u>EXCAVATION</u>	
<u>PROP.</u>	<u>CITY</u>
224.5	174
22.5	1.7
<u>247.0</u>	<u>19.1</u>

SKINNER
EL. Ida to AL. 1000
30' Corro. & Corro.
City of AL. 1000
SE Skinner
2012