


B.M. 102.03 "P" in P.K.S. east end s.e. cor. Skinner & Greenway Blvd.
 B.M. 103.89 "T" in Troy top fire hyd. n.w. cor. Skinner & Exchange.
 B.M. 104.48 "T" in Troy top fire hyd. s.w. cor. Exchange & Funston.

0+00: 100.00 ft. west of west line Silver on & extended.

Stations & chaining East on &

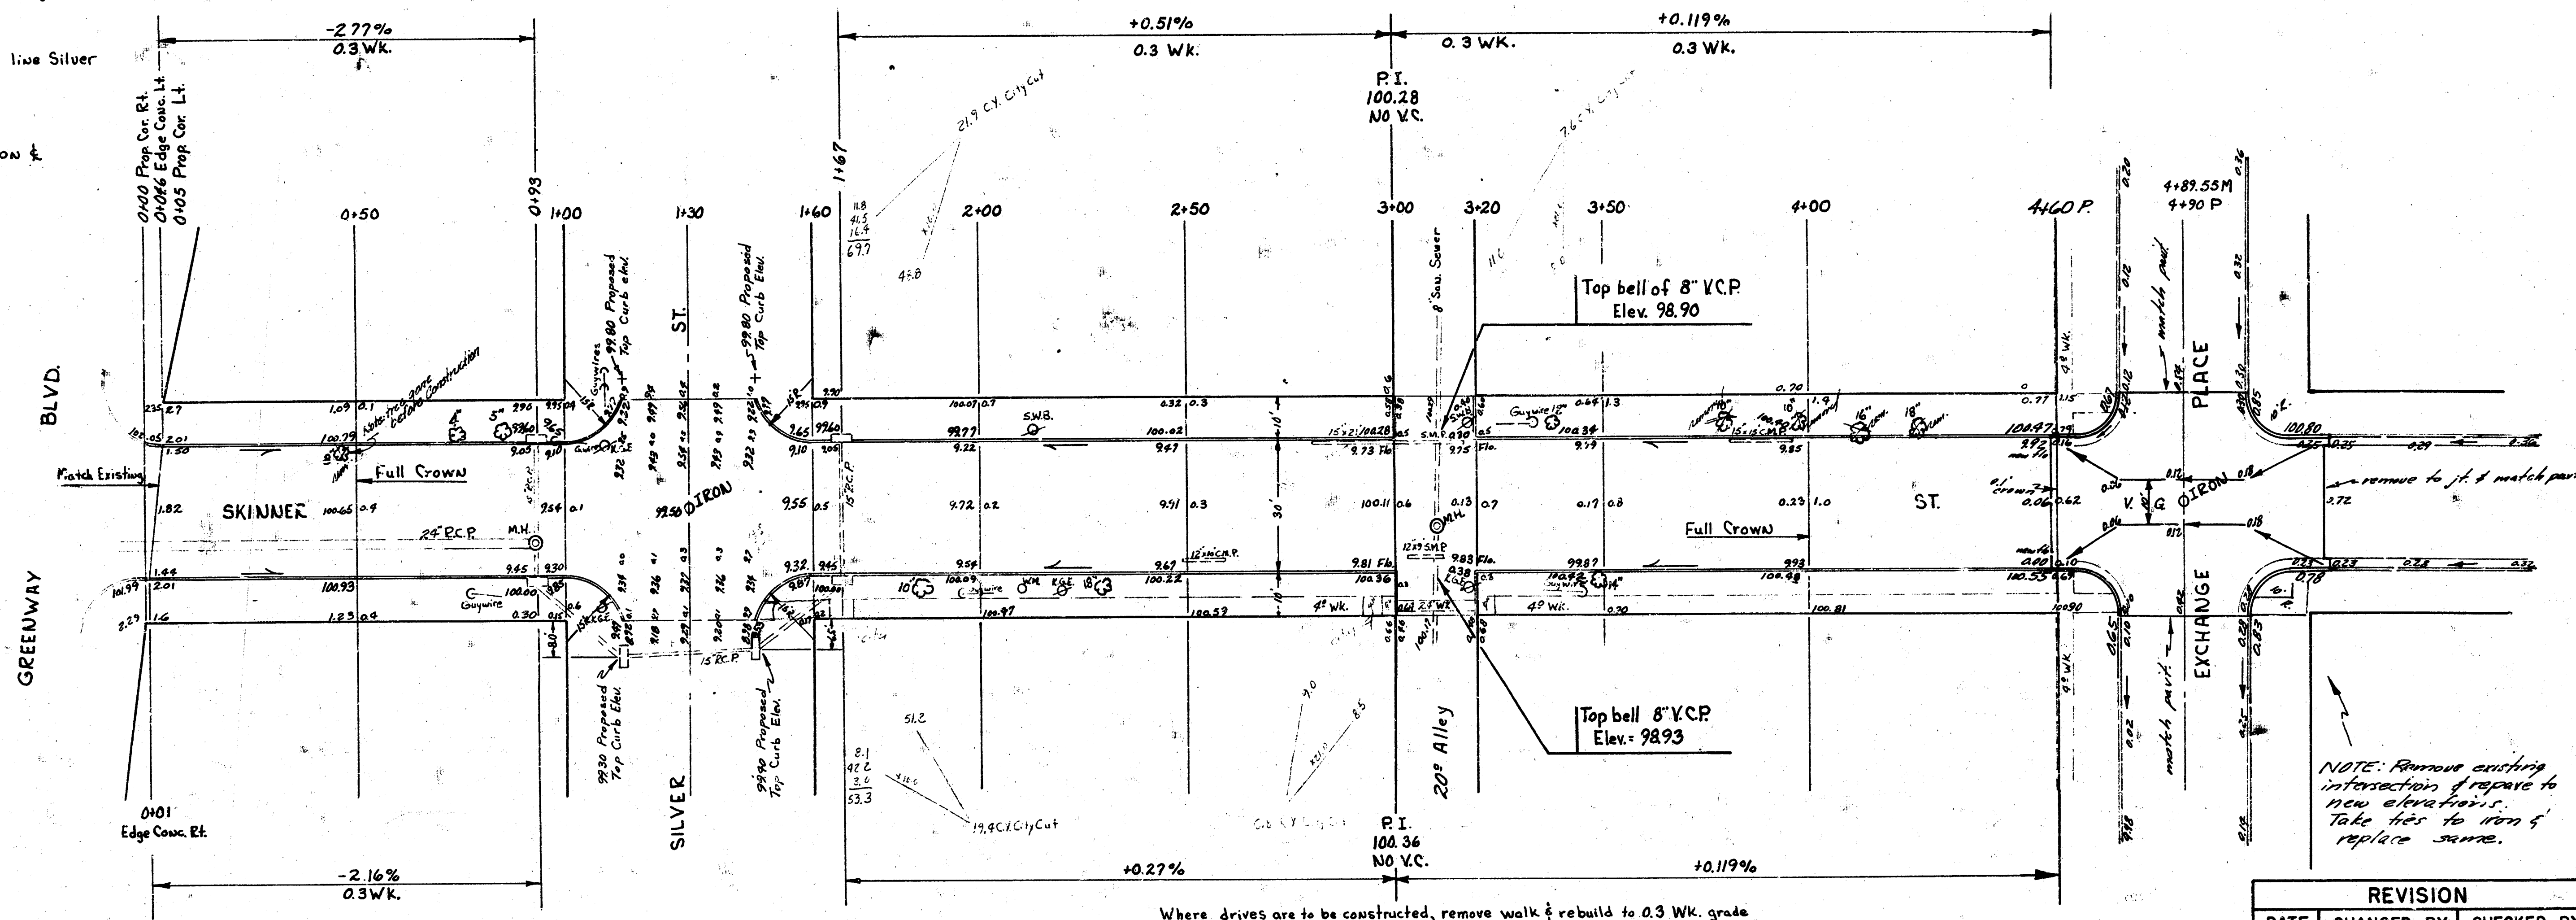


Where drives are to be constructed, remove walk & rebuild to 0.3 WK. grade

NOTE:
 Sanitary sewer @ alley to be
 excavated prior to paving.

REVISION		
DATE	CHANGED BY	CHECKED BY
Feb. 59	Swickard	D. Linn

SKINNER ST.
 EL. GREENWAY to W.L. EXCHANGE
 30° CONC. & CB.
CITY OF WICHITA, KANSAS

B.E. SMITH
 DATE: NOV. 1958
 CITY ENGINEER
 PROJ. NO. C18-142

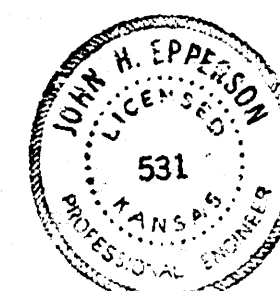

E.I.C.
 120.5
 410.5
 132.9

5