




BM 115.43 N.W. COR. CONC. PORCH HOUSE #402 SE COR. UNIVERSITY & SHERIDAN
 BM 113.82 16" IN GLOUSE & N.E. E. O. N.E. COR. SHERIDAN & MAPLE
 B.M. 114.018 CITY E.M. 41' N 135' W OF E. SHERIDAN & MAPLE
 STATIONING ON E. OF SHERIDAN

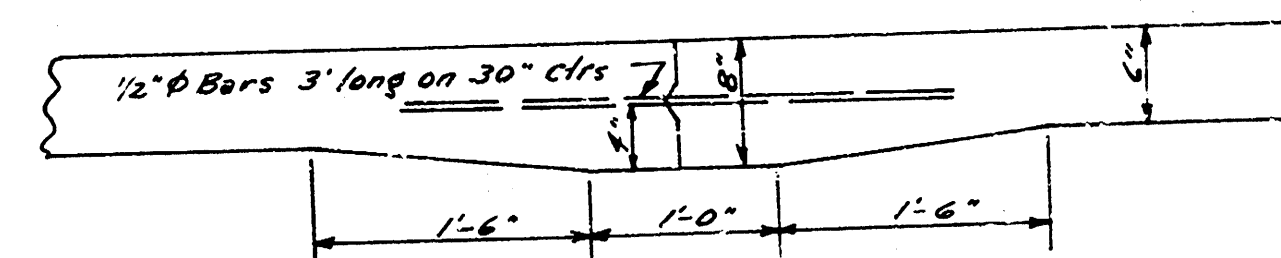

Mastic Joint Detail
 No Scale

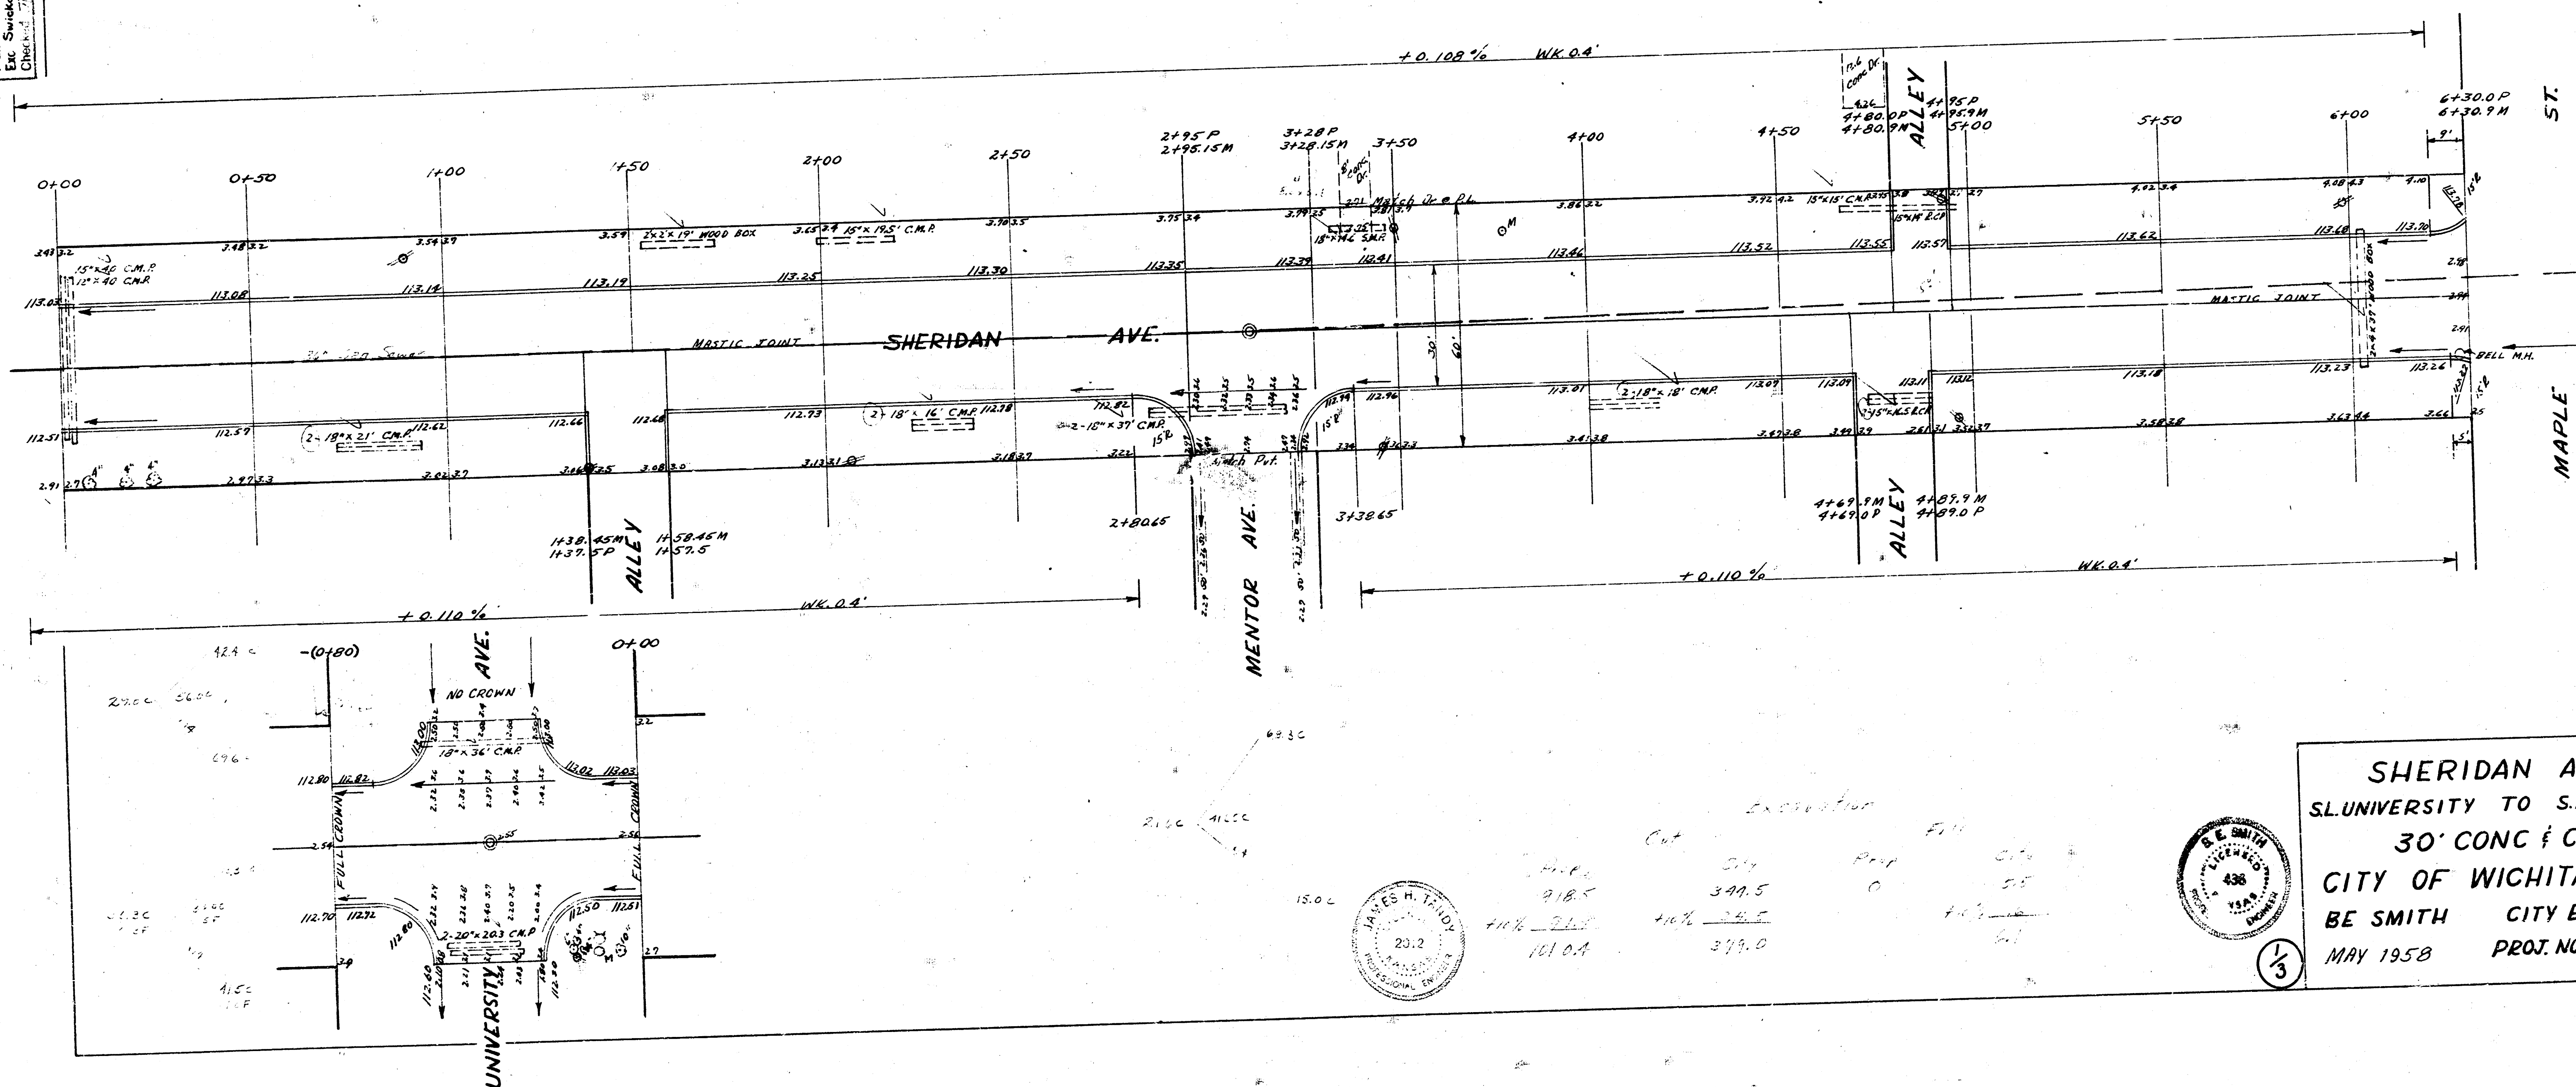

SHERIDAN AVE.
 S. UNIVERSITY TO S. MAPLE
 30' CONC & CB.
 CITY OF WICHITA KAN.
 BE SMITH CITY ENGINEER
 MAY 1958 PROJ. NO. C17-10

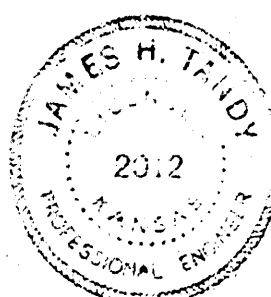

Excavation	Fill
918.5	349.5
918.5	349.5
1010.4	379.0

1024