

Ties To Iron & St. Louis & Edwards
1 60.72' N.W. To S.E. Cor Foundation Ho* 2702 N. St. Louis
2 35.60' S.W. To Face of Flag Pole
3 53.55' S.E. To N.W. Cor of N. Brick Porch Post Ho* 448 Edwards
85.75' N.E. to N.W. Cor of Foundation Ho* 2624 St. Louis






Ties To Iron & Richmond & St. Louis
1. 53.58' S.W. to E.E. Cor. H^o 449 Richmond
2. 52.19' S.E. to N.W. Cor. Foundation H^o 460 Richmond
3. 102.83' N. N.W. to face of Railroad Mile Post 487

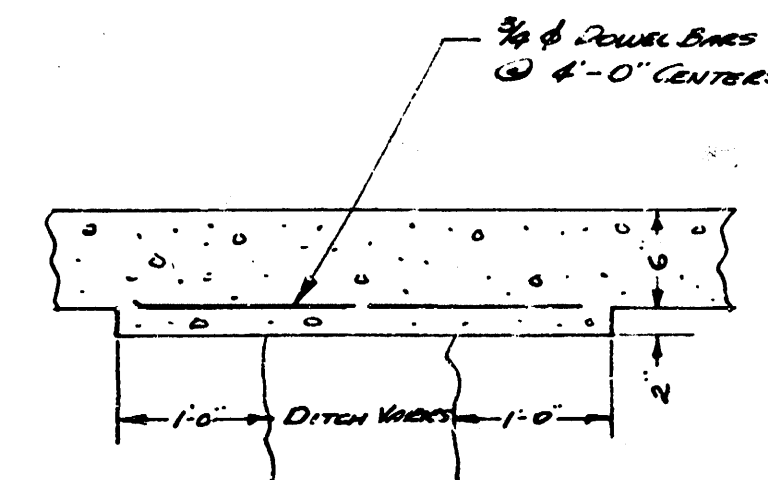

DETAIL OF SLAB OVER SEWER DITCH

