
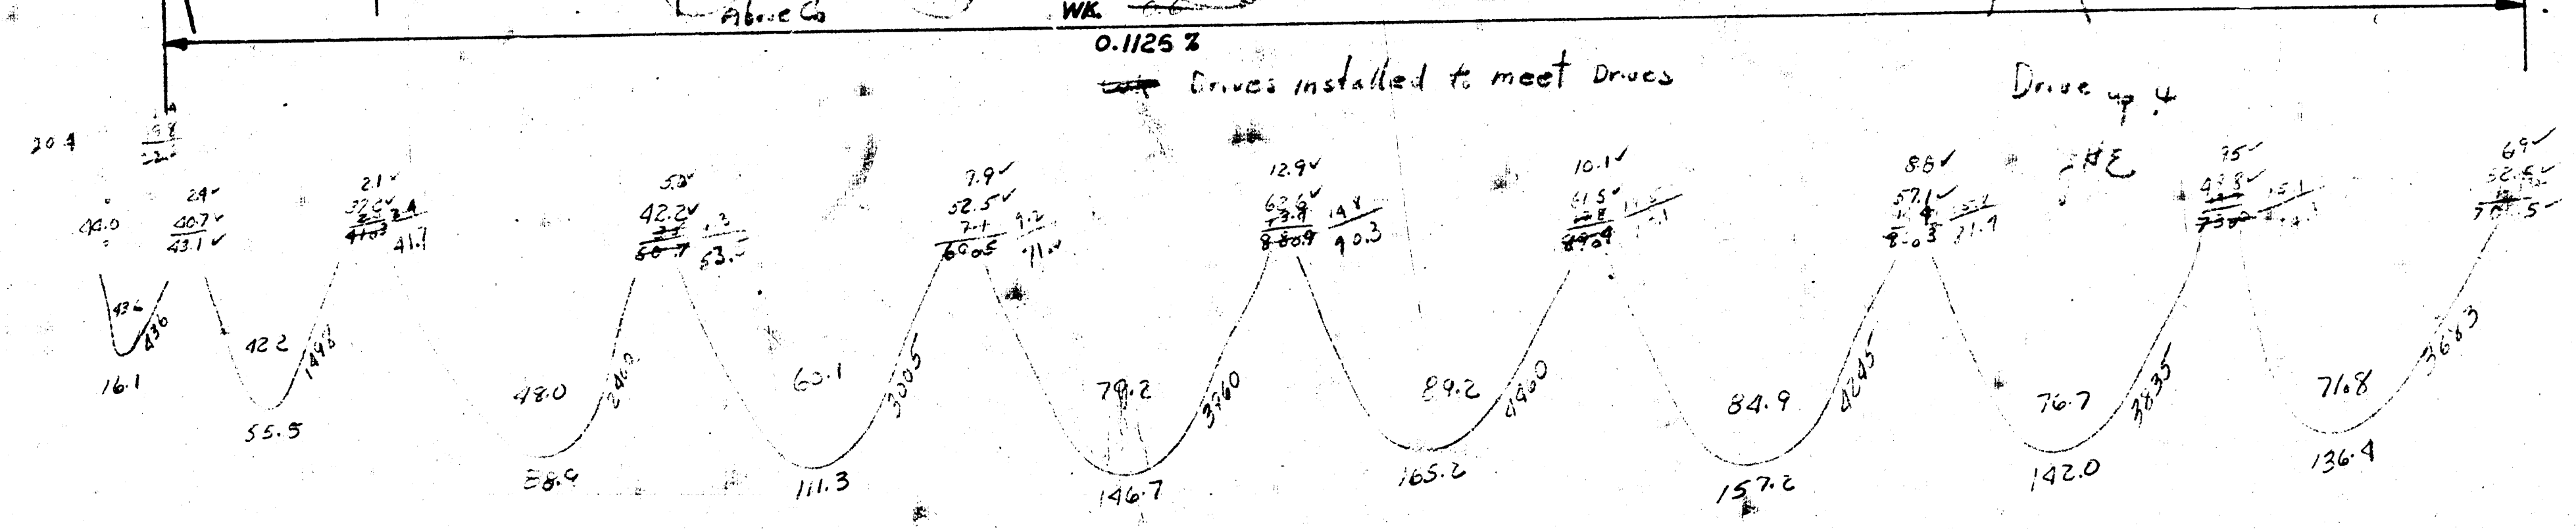


Property
 76.1
 55.5
 58.9
 111.3
 146.7
 145.2
 157.6
 142.0
 136.9
 1019.3

BM 98.74 SE cor. conc. porch Ho. NE cor. Ash & Rule.

Total Property City
 1019.3 0
 +10% 1121.2 aryd.

BM 98.60 SE cor. conc. porch NW cor. Rule & Spruce.

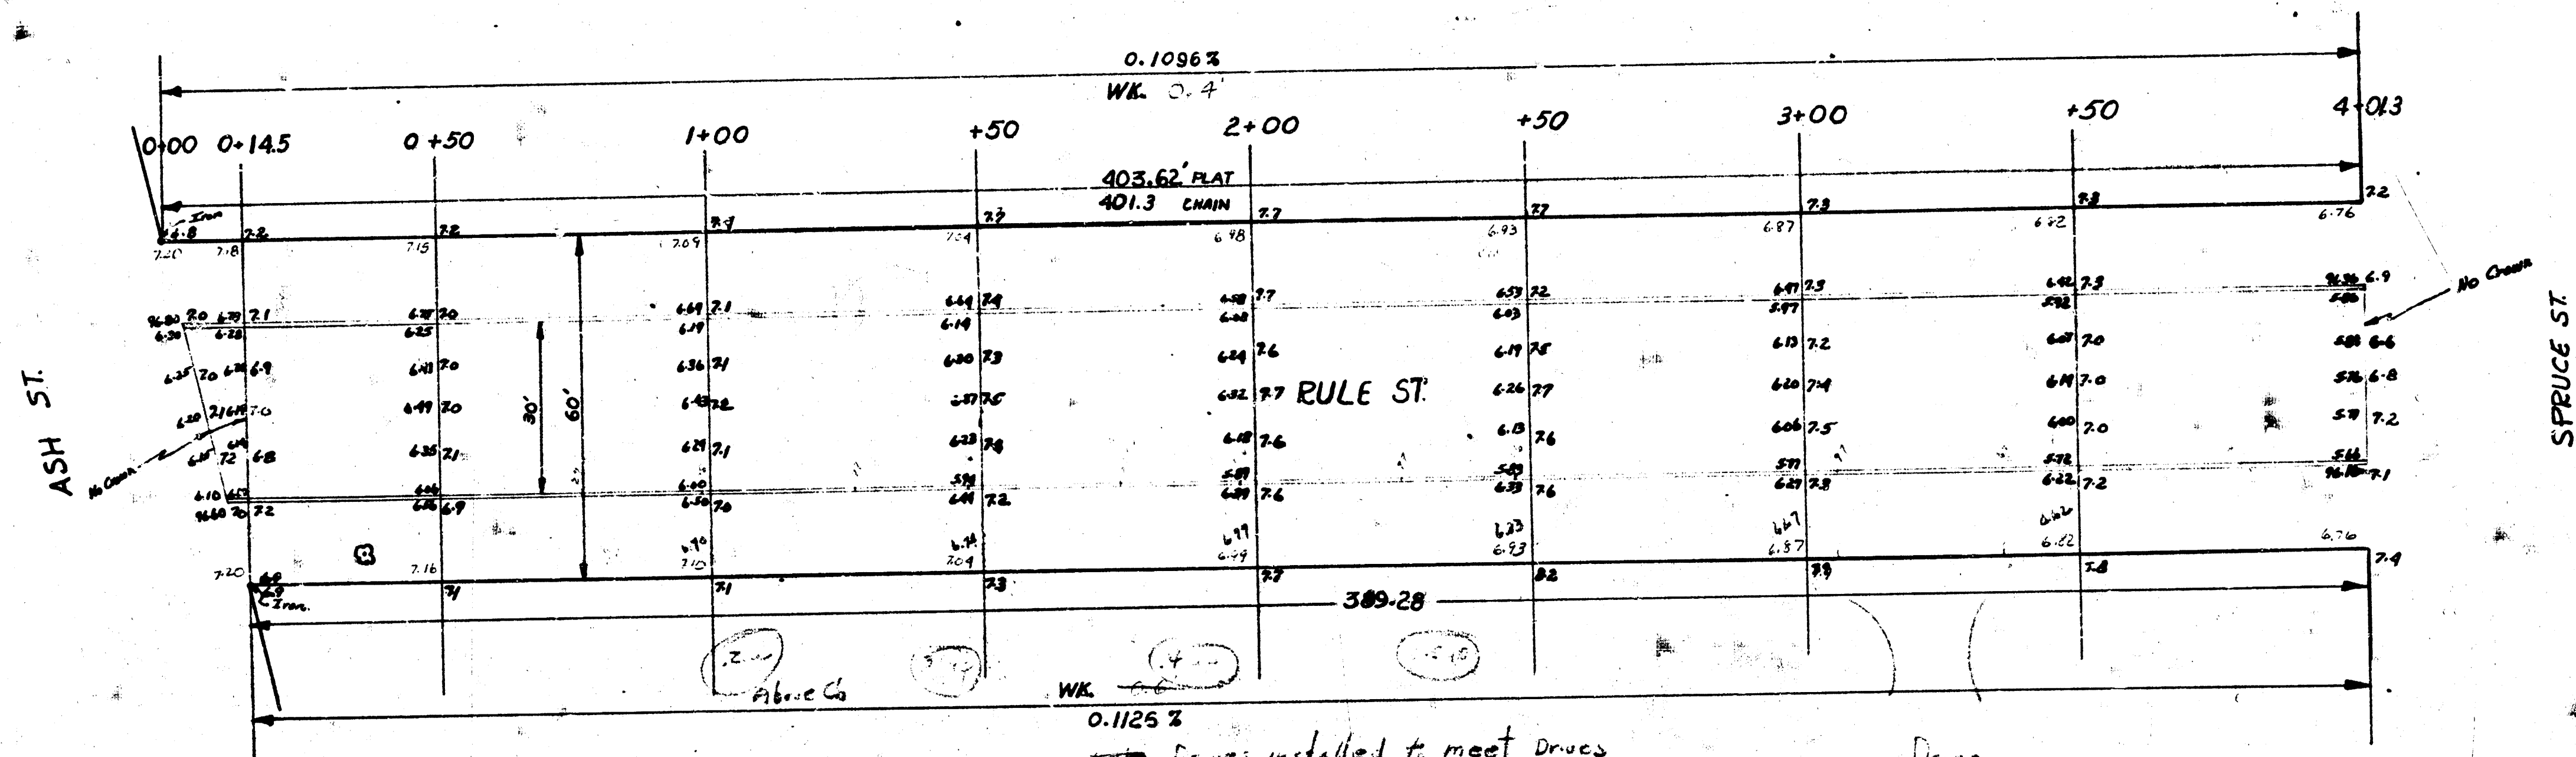

RULE ST.
 EL ASH WL SPRUCE
 30' CONC. & CB.
 CITY OF WICHITA, KANS.
 LK WHITE CITY ENGINEER
 AUGUST, 1950 C10-93

4 e 3 53