



B.M. = 175.02 R.R. Spike N Side 1/4 Sec. 200 Iso. 150 West, SW cor. Armour + Rockwood.
 T.P. = 177.175 "M" in Mueller Top Fire hyd. on NE cor. Rutland + Rockwood.

Base line = North Property Line ROCKWOOD ROAD.

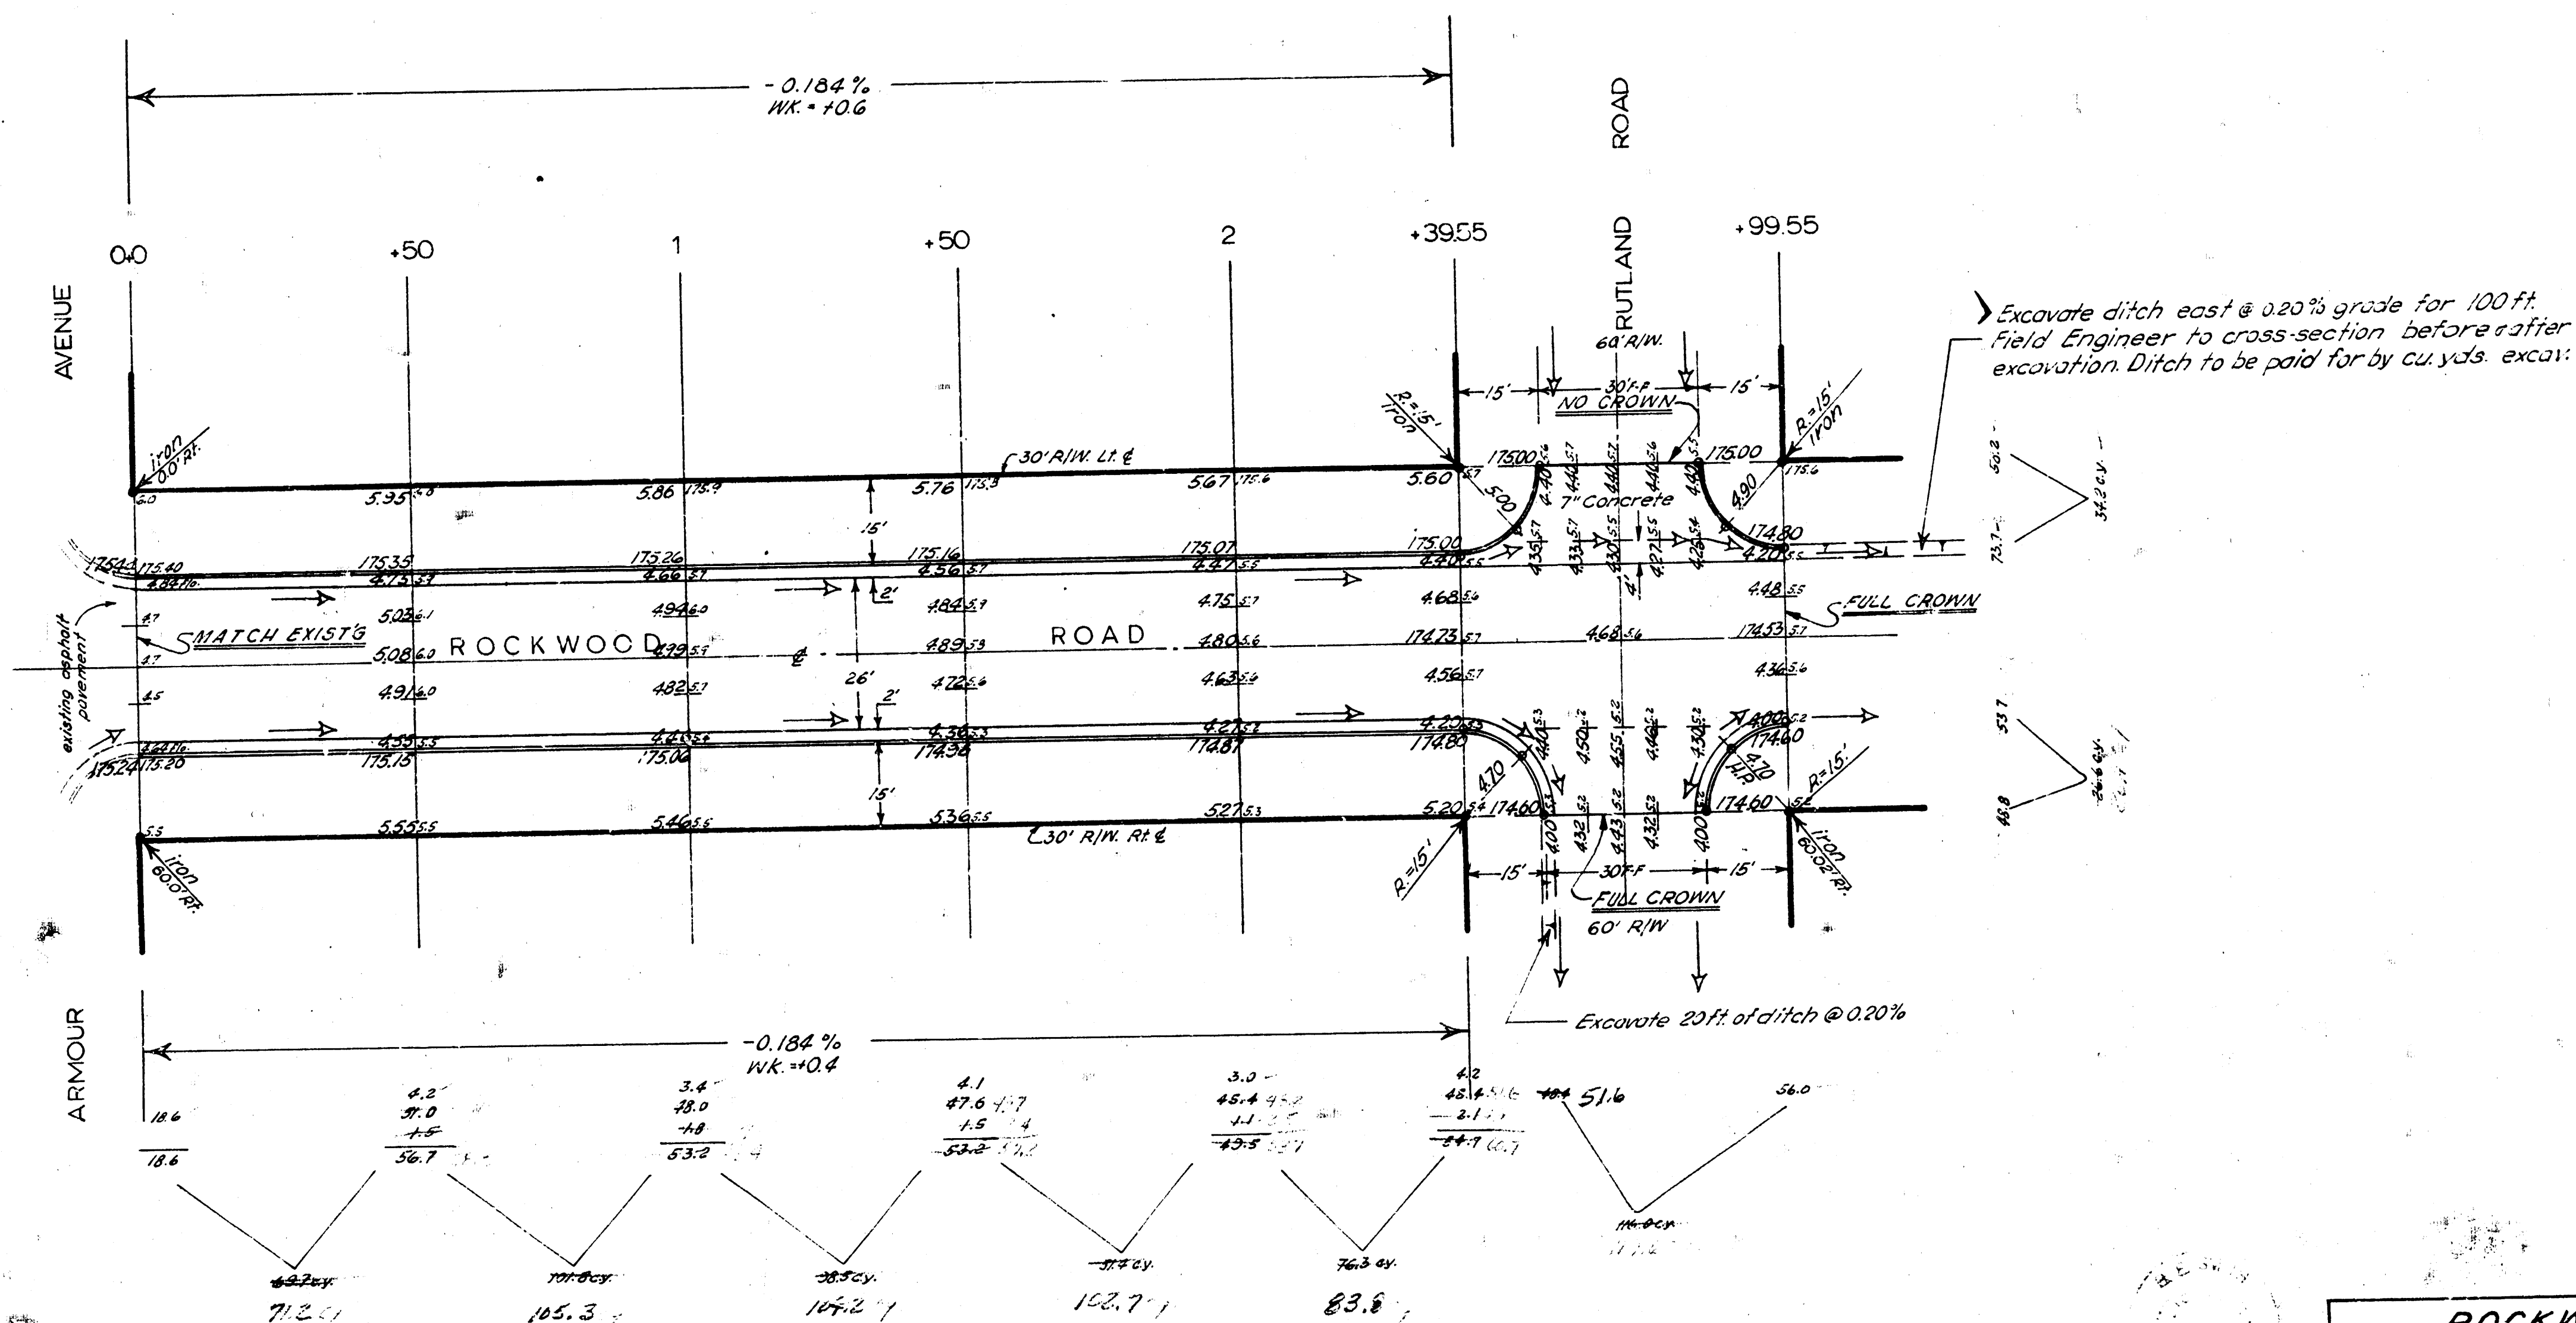

Sheet 1 of 2
 175.02
 177.175

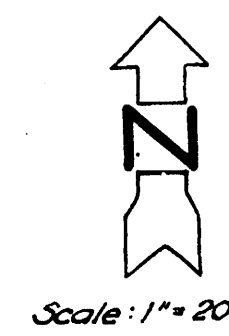

EARTHWORK QUANTITIES
 (EXCAVATION)

PROP.	CITY
397.7	176.6
392.2 + 0%	177.7 + 0%
437.5 cu.	194.5 cu.

ROCKWOOD ROAD		
EL. Armour Ave. to EL. Rutland Road		
25'-2'-30' Asphaltic Concrete		
City of Wichita, Kansas		
B.E. Smith	City Engineer	
Date: July 11, 1962	design - S. Seel	Proj. No. C/12-22