
BENCHMARK:
BM #1: ARKANSAS AND 33RD ST. N.
C.O.W. BENCHMARK
32.00 FT SOUTH OF CENTERLINE OF 33RD ST. GOING EAST
22.00 FT EAST OF CENTERLINE OF ARKANSAS
ELEV= 1317.21 (NGVD 29)
ELEV= 129.81 (CITY DATUM)


BM #2: C.O.W. DISK NE BRIDGE HEADWALL 33RD AND DRAINAGE CANAL
ELEV= 1320.98 (NGVD29)
ELEV= 133.58 (CITY DATUM)


All trench and manhole excavation areas from Sta. 1+72.3 to Sta. 2+50.0 and Sta. 2+93.0 to 3+80.3, Line 1 and Sta. 0+00.0 to Sta. 0+49.1, Line 1A shall be backfilled with sand. The sand backfill shall be within two feet of existing grade and shall be water-jetted and vibrated during backfilling. All costs shall be paid for as L.F. "Sand Backfill Jetted and Vibrated".

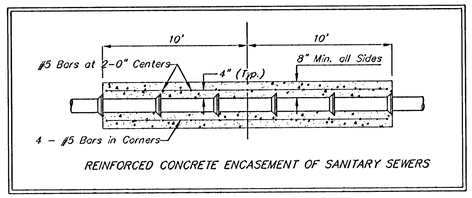

REINFORCED CONCRETE ENCASEMENT OF SANITARY SEWERS

Scale: 1" = 40' Horizontal
1" = 5' Vertical
• = Iron

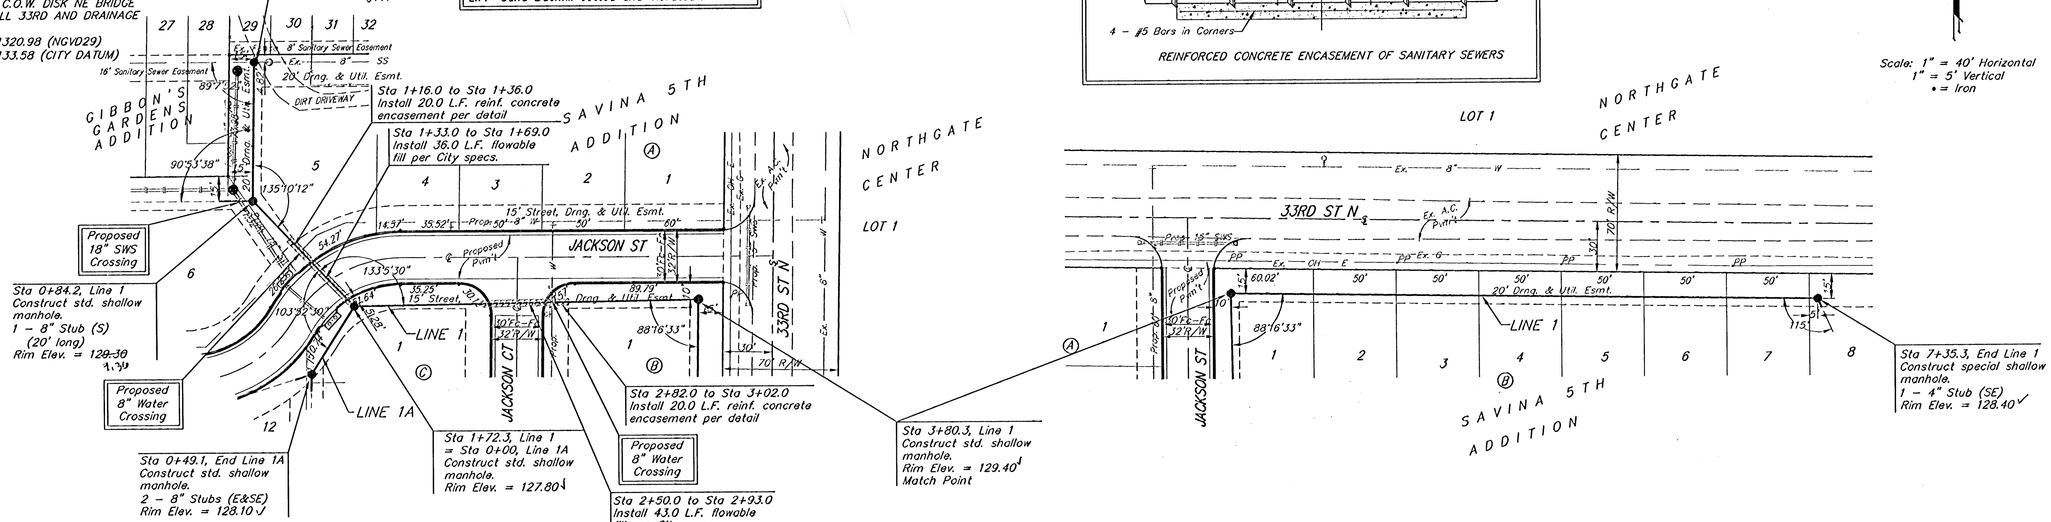

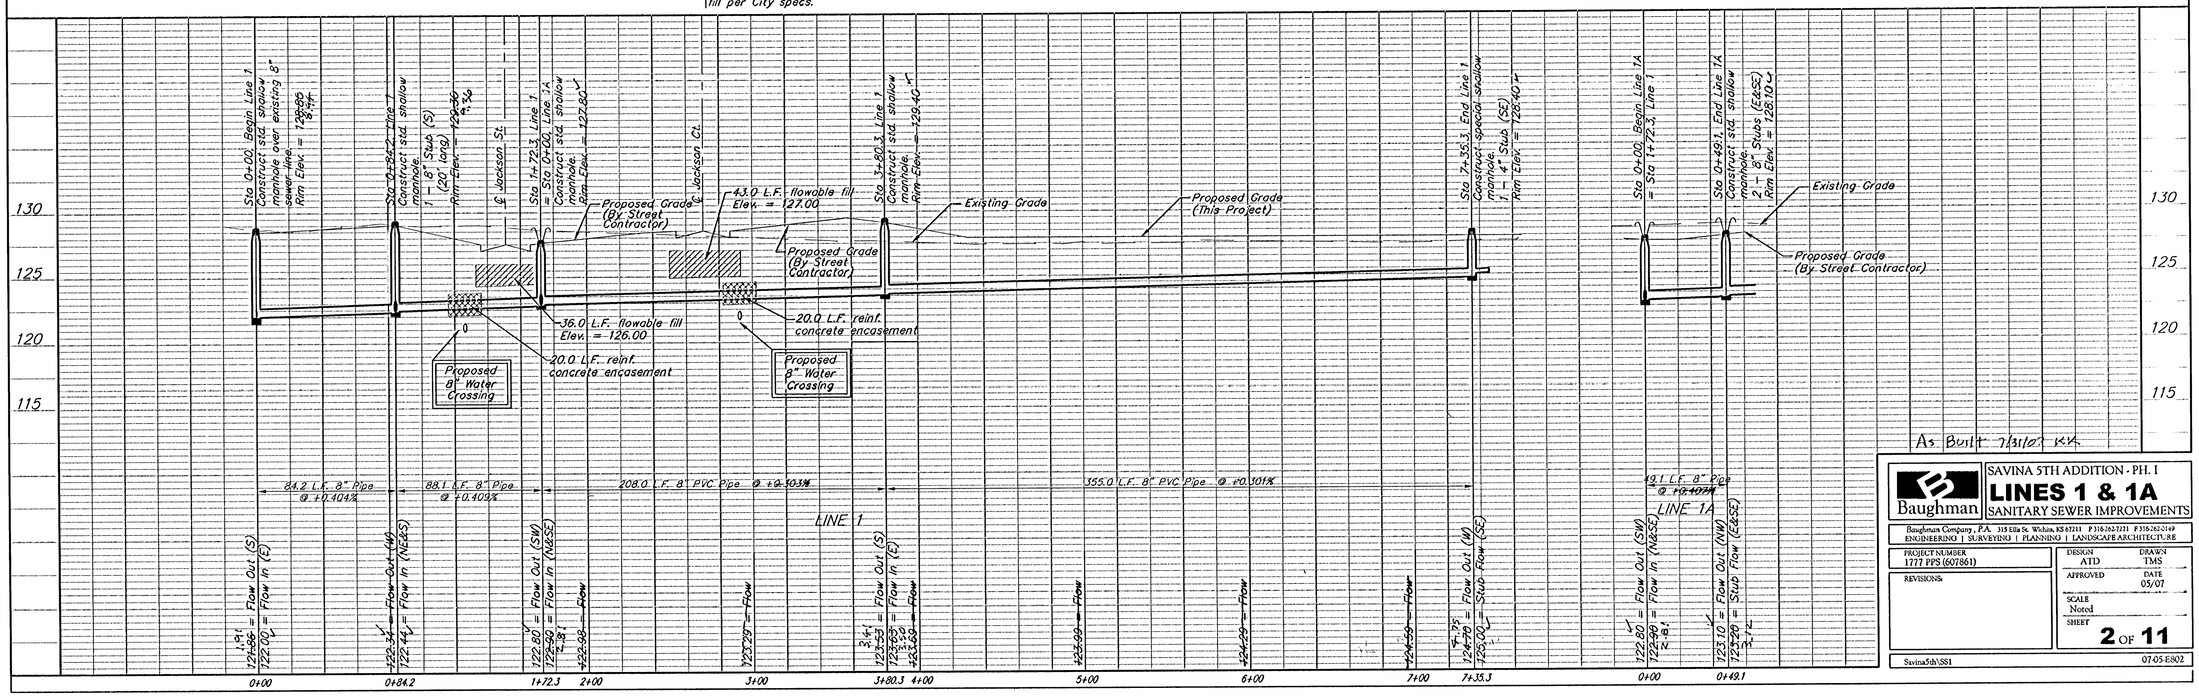

As Built 7/31/07 KK

Baughman

SAVINA 5TH ADDITION - PH. I

LINES 1 & 1A SANITARY SEWER IMPROVEMENTS

Baughman Company, P.A. 315 Ella St. Wichita, KS 67211 P 316.262.7271 F 316.262.0749
ENGINEERING | SURVEYING | PLANNING | LANDSCAPE ARCHITECTURE

PROJECT NUMBER 1777 PPS (607561)
DESIGN ATD
DRAWN TMS
APPROVED
DATE 05/07
REVISIONS:
SCALE Noted
SHEET 2 OF 11

SavinaSth\SS1 07-05-E802