Sta. 5+56.7
Match Point

Discus Field

Shot-put Pit

Line 1

691.0'

20' Utility Easement

Sta. 7+50.5, Line 1.
Construct 6' Dia.
Shallow Type "C" Manhole.
Top =148.20

CAUTION! VERIFY
SBC Line Crossing. Approximate Location Of Line. Contractor To Coordinate With SBC To Determine Exact Location Of Line & If It Needs To Be Moved. Contact Greg Tholstrup Of AT&T. (268-2213)

139°37'2"

24.1'

Service Access

Line 1

Unplatted

Track

#5 Bars at 2-0" Centers
4" (Typ.)
8" Min. all Sides
4 - #5 Bars in Corners

REINFORCED CONCRETE ENCASEMENT OF SANITARY SEWERS

SCALE:
1" = 20' HORIZONTAL
1" = 5' VERTICAL

CAUTION! VERIFY
8" Sanitary Sewer Crossing.

Sta. 11+25.8, Line 1.
Construct 2'x4' Drop Inlet.
Top =150.20
Install Sediment Barrier.
Match Point

81.1'

342.1'

Central

Woodchuck

Existing Building


Soccer Field

Contractor Shall Follow All Applicable Best Management Practices (BMP) For Erosion Control.

Contractor To Use Extreme Caution When Excavating Near Utility Lines. Contractor To Hand Dig To Expose All Utility Lines Prior To Construction. Verify Depth To Determine Conflict If Any.

Bench Mark:

Woodchuck & Central
City of Wichita Bench Mark.
52.00 ft. North of center line.
24.00 ft. West of center line.
Elevation = 154.05 (City Datum)

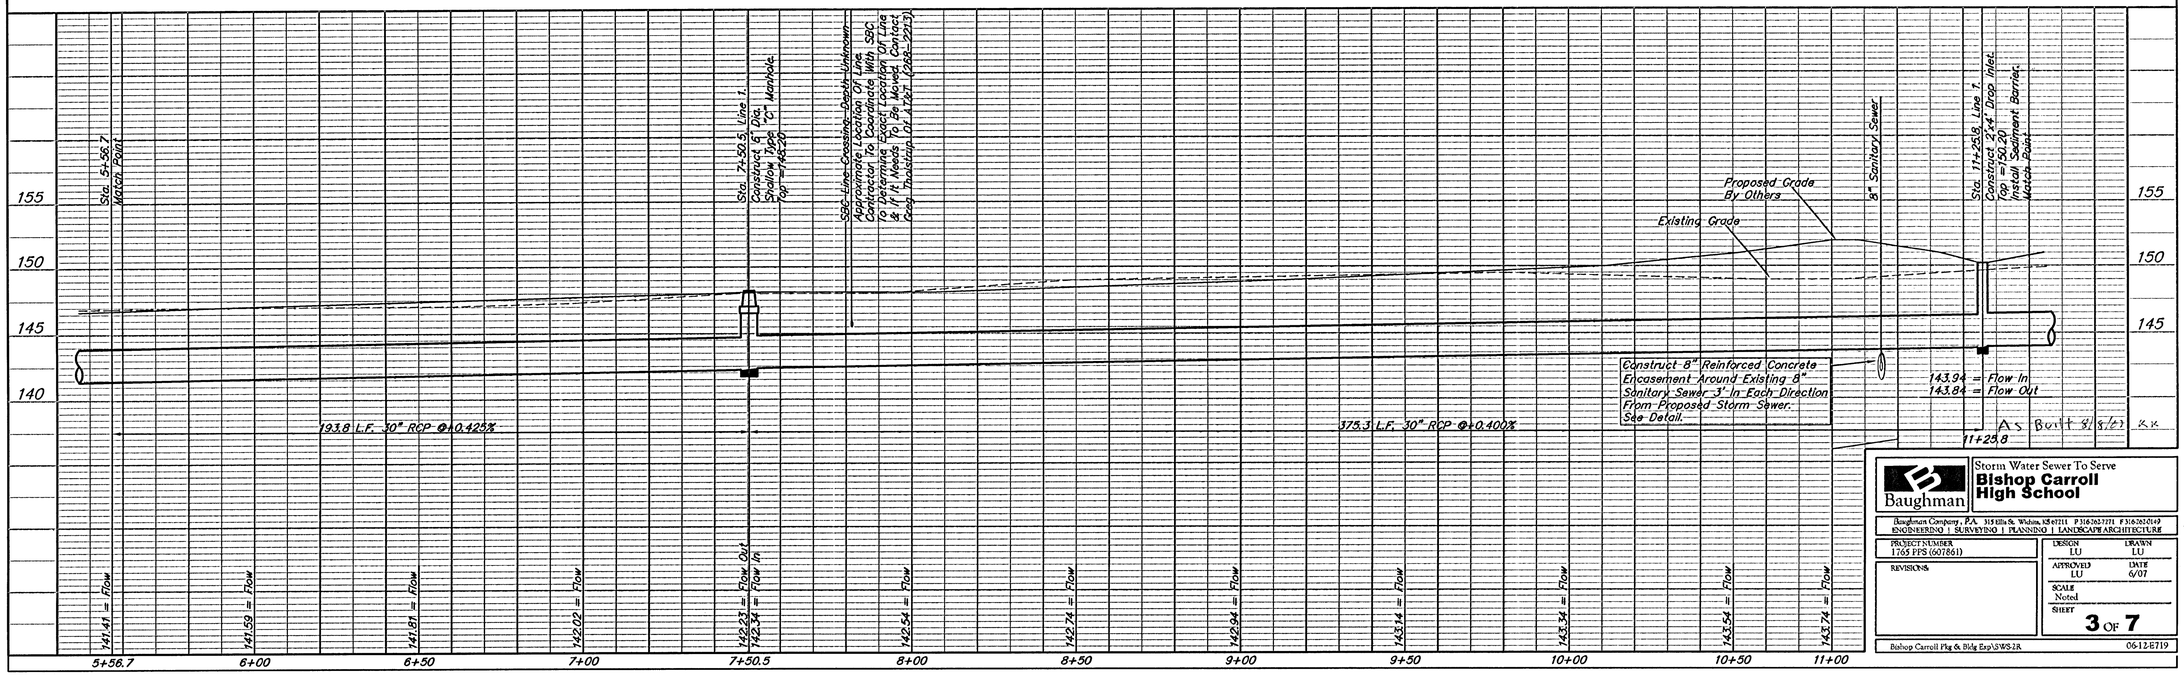

Baughman

Storm Water Sewer To Serve
Bishop Carroll High School

Baughman Company, P.A. 315 Ellis St. Wichita, KS 67211 P 316.263.7711 F 316.263.0149
ENGINEERING | SURVEYING | PLANNING | LANDSCAPE ARCHITECTURE

PROJECT NUMBER
1765 PFS (6007861)

REVISIONS:

DESIGN	DRAWN
LU	LU
APPROVED	DATE
LU	6/07

SCALE
Noted

SHEET
3 OF 7

Bishop Carroll Plg & Bldg Exp\SWS-2R 0612-E719