



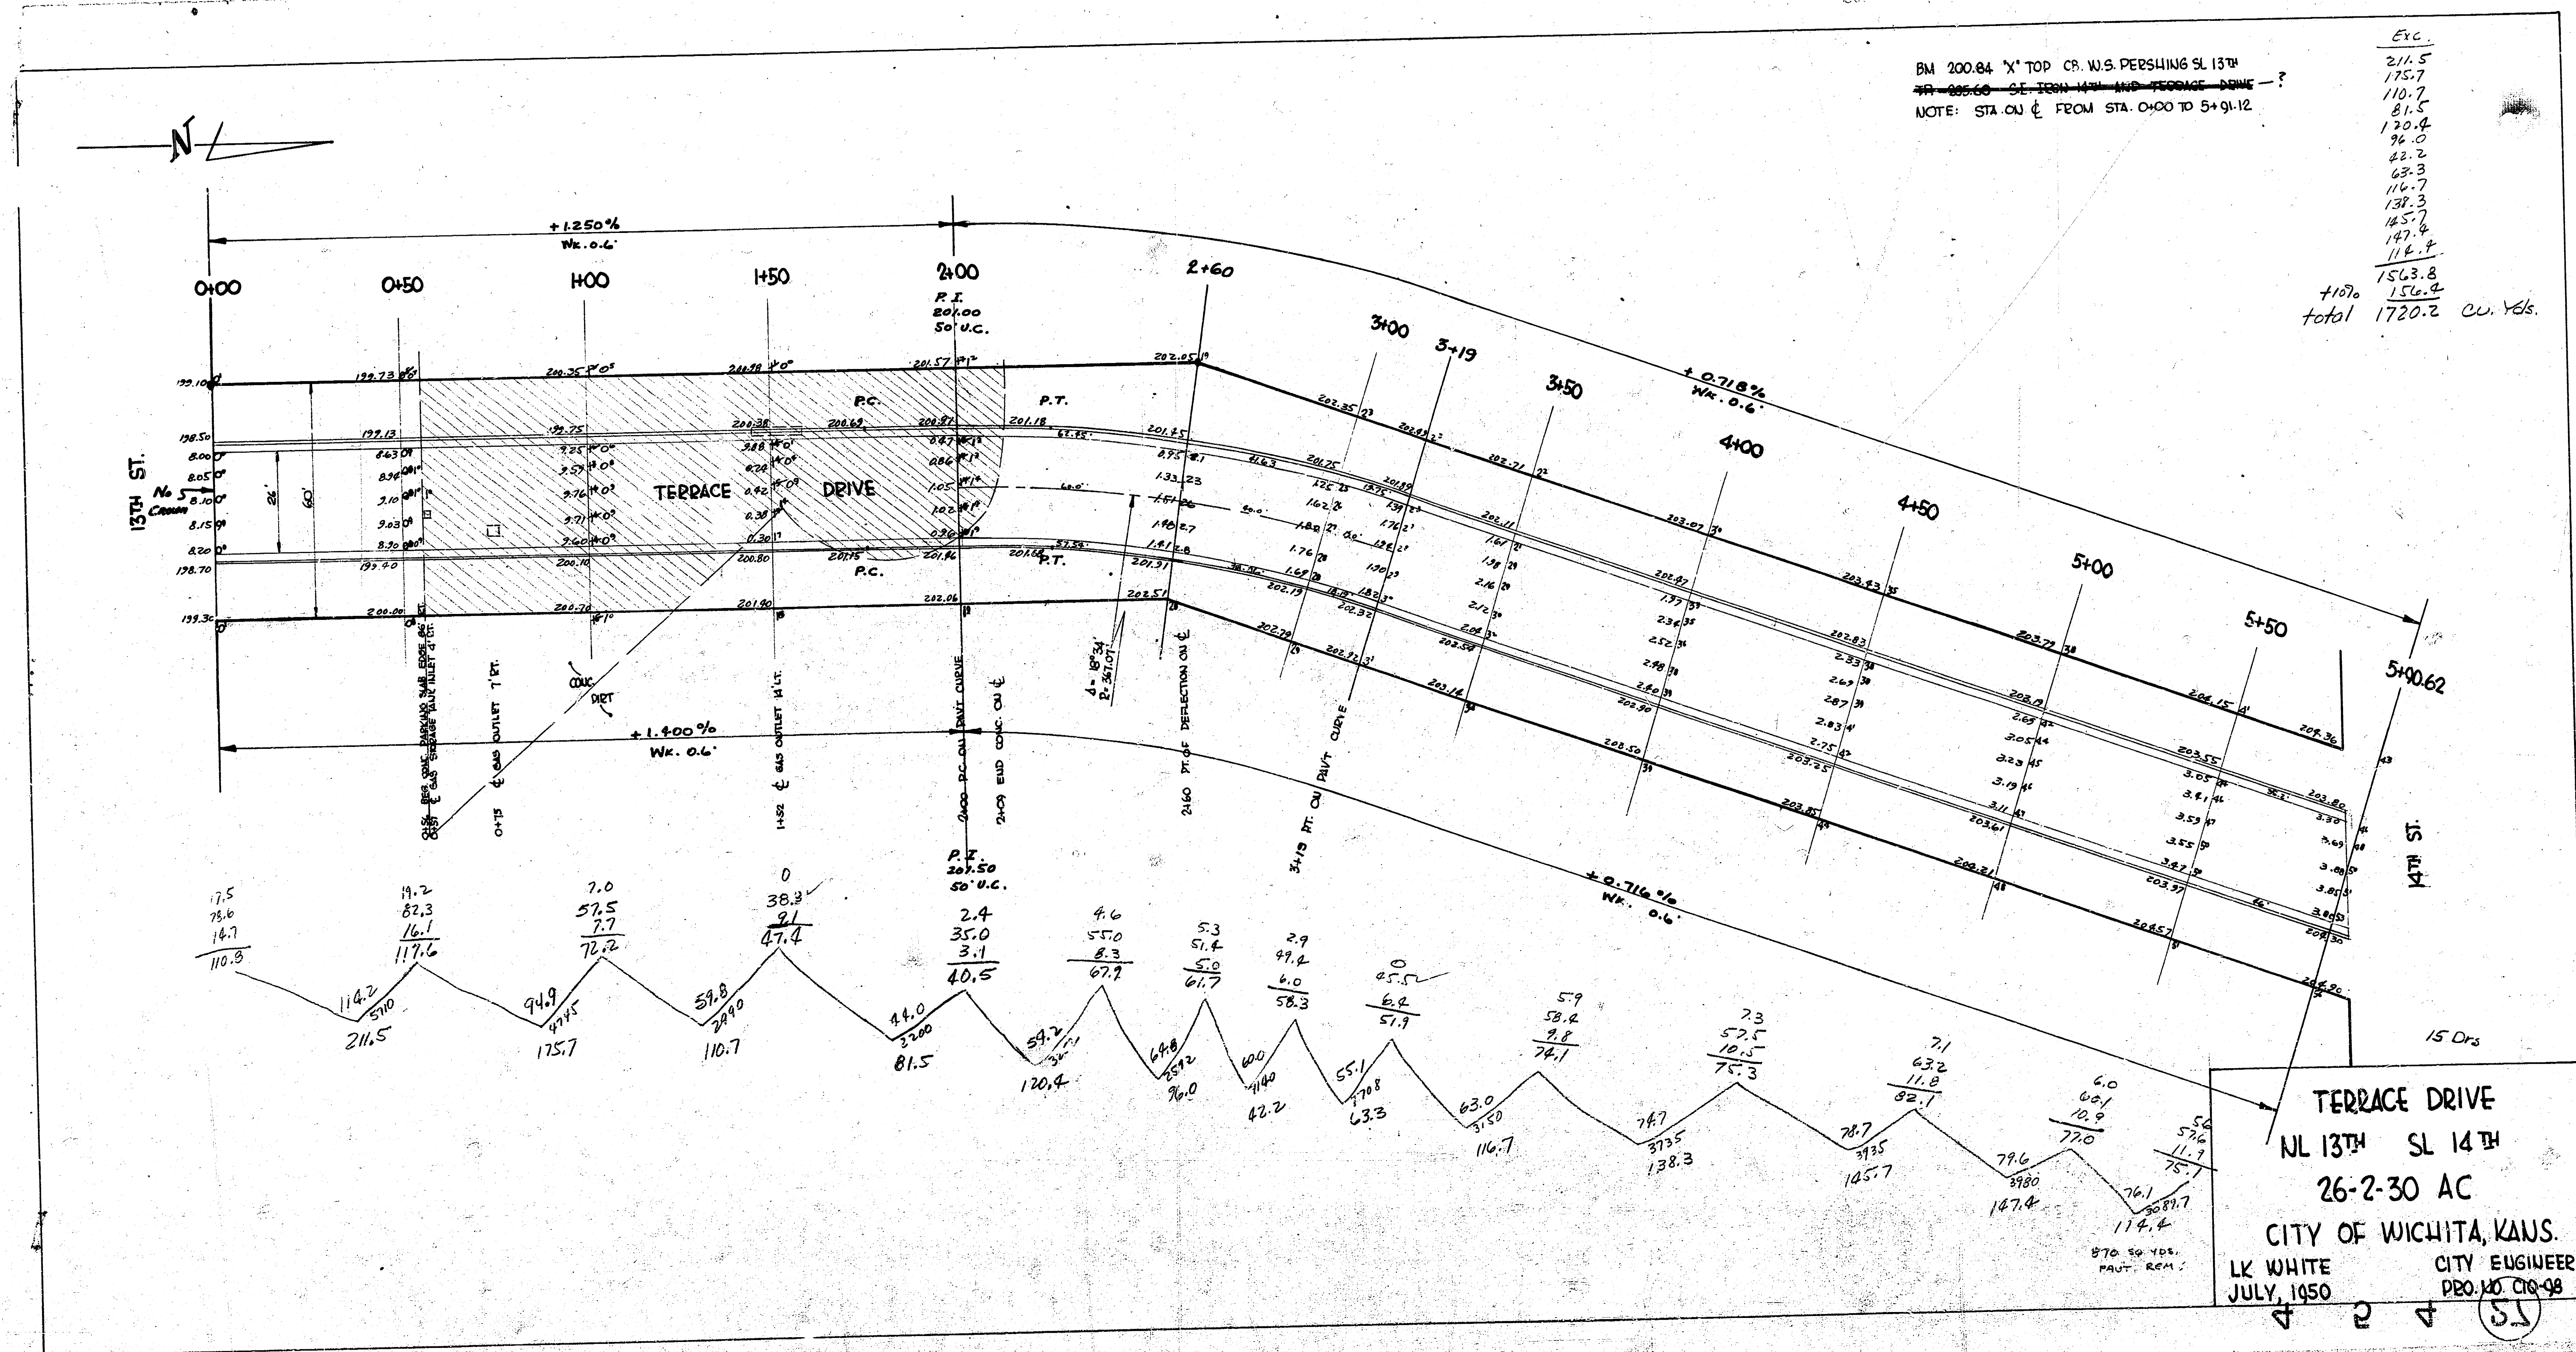


Bl # H-2 X Sections after Fill
 Bl # 439 X Sections before filling

B.M. 206.63 "M" in Mueller Fire Hydrant S.E. cor. 14th & Pershing.

FIELD ENGR

1-section shall be taken
 after exc of loose fill

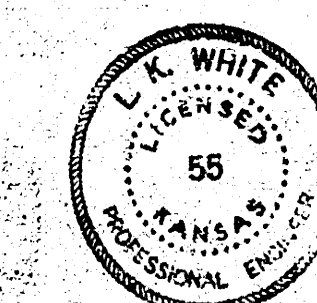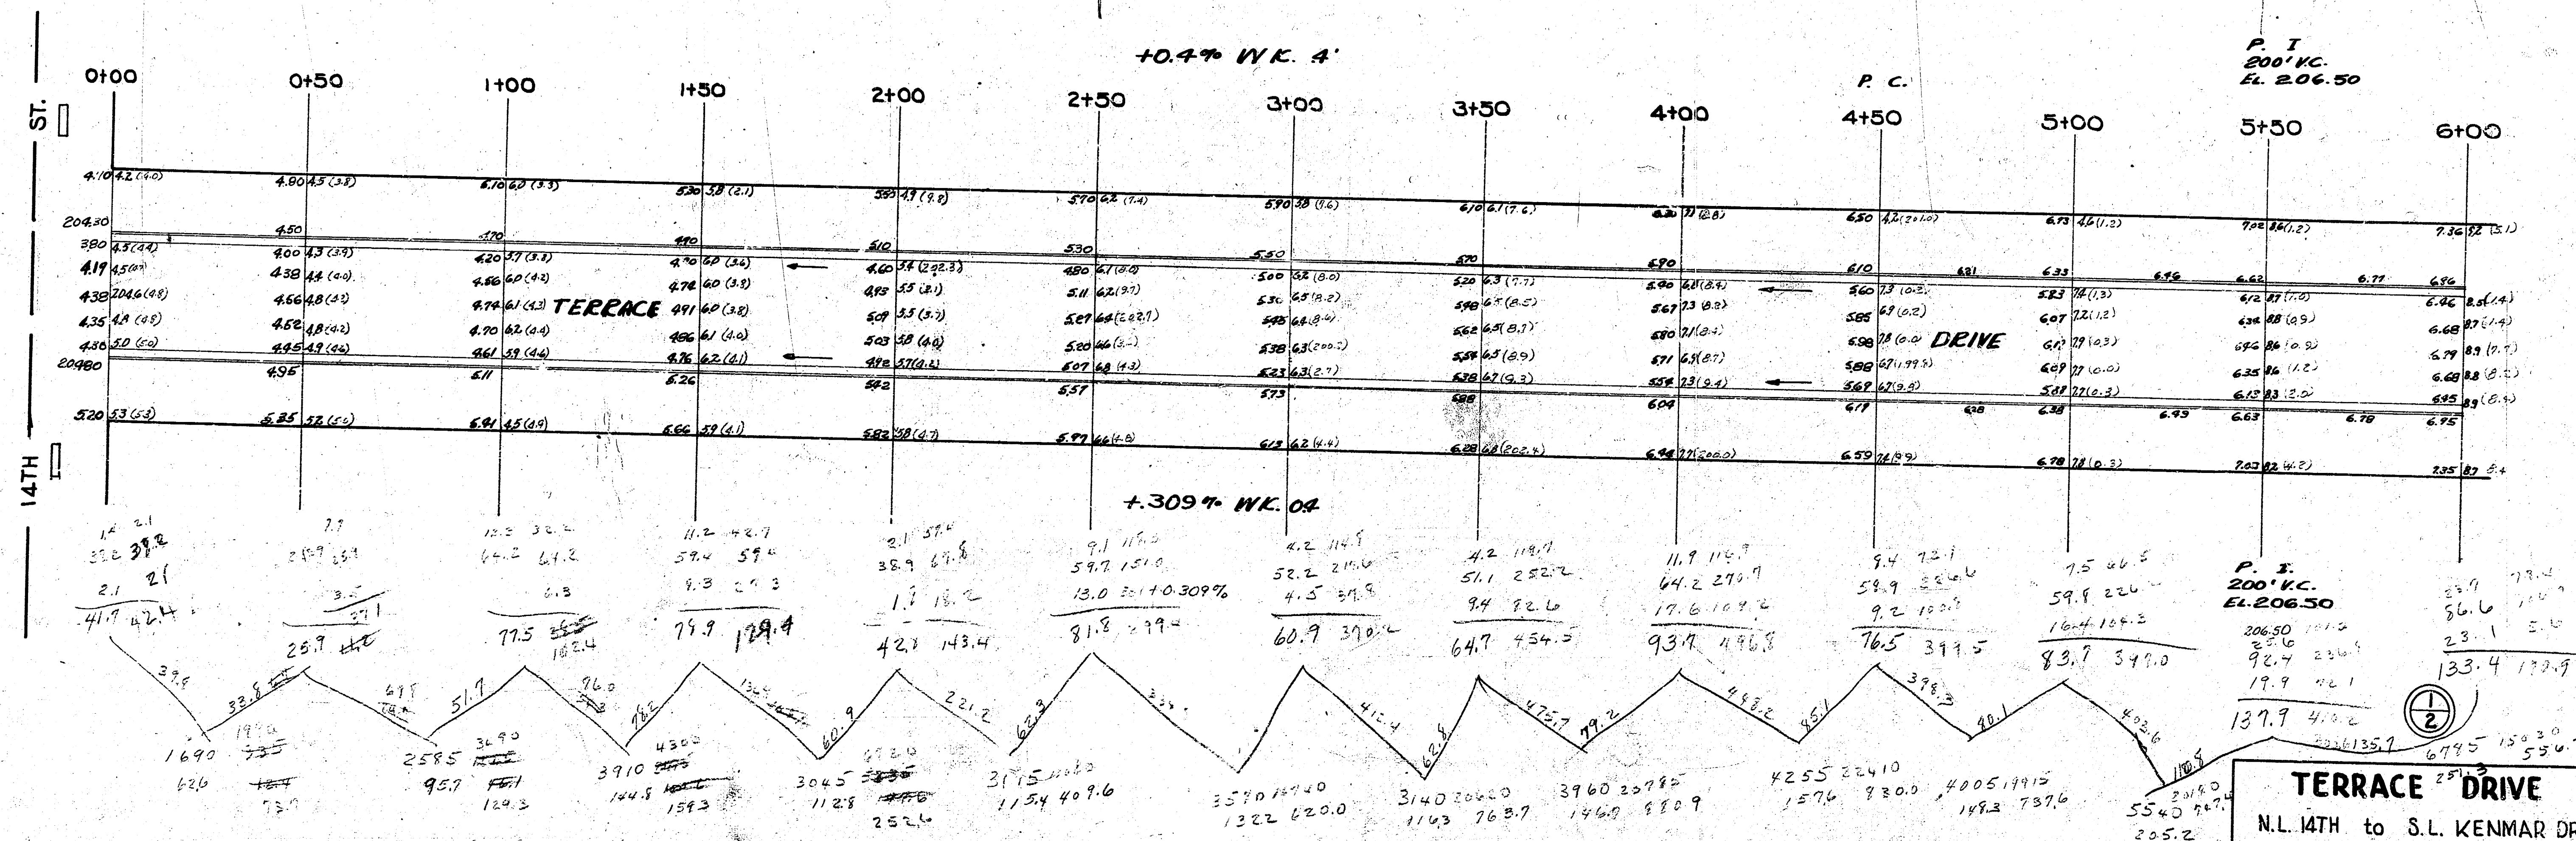


TERRACE DRIVE
 N.L. 14TH to S.L. KENMAR DR.
 26'-2'-30" A.C.
 CITY OF WICHITA, KANSAS
 L.K. WHITE CITY ENGINEER
 OCT. 28, 1951, PROJ. NO. CII-260


Bk # H-2

B.M. 215.57 S.E. cor. conc. Patch Ho. 1651 Jan 7, 1977

NOTE: Stationing on 3" offset E. R. L. E.I.C. 1270 7C44/ Sta 1+00 to 10+91.60

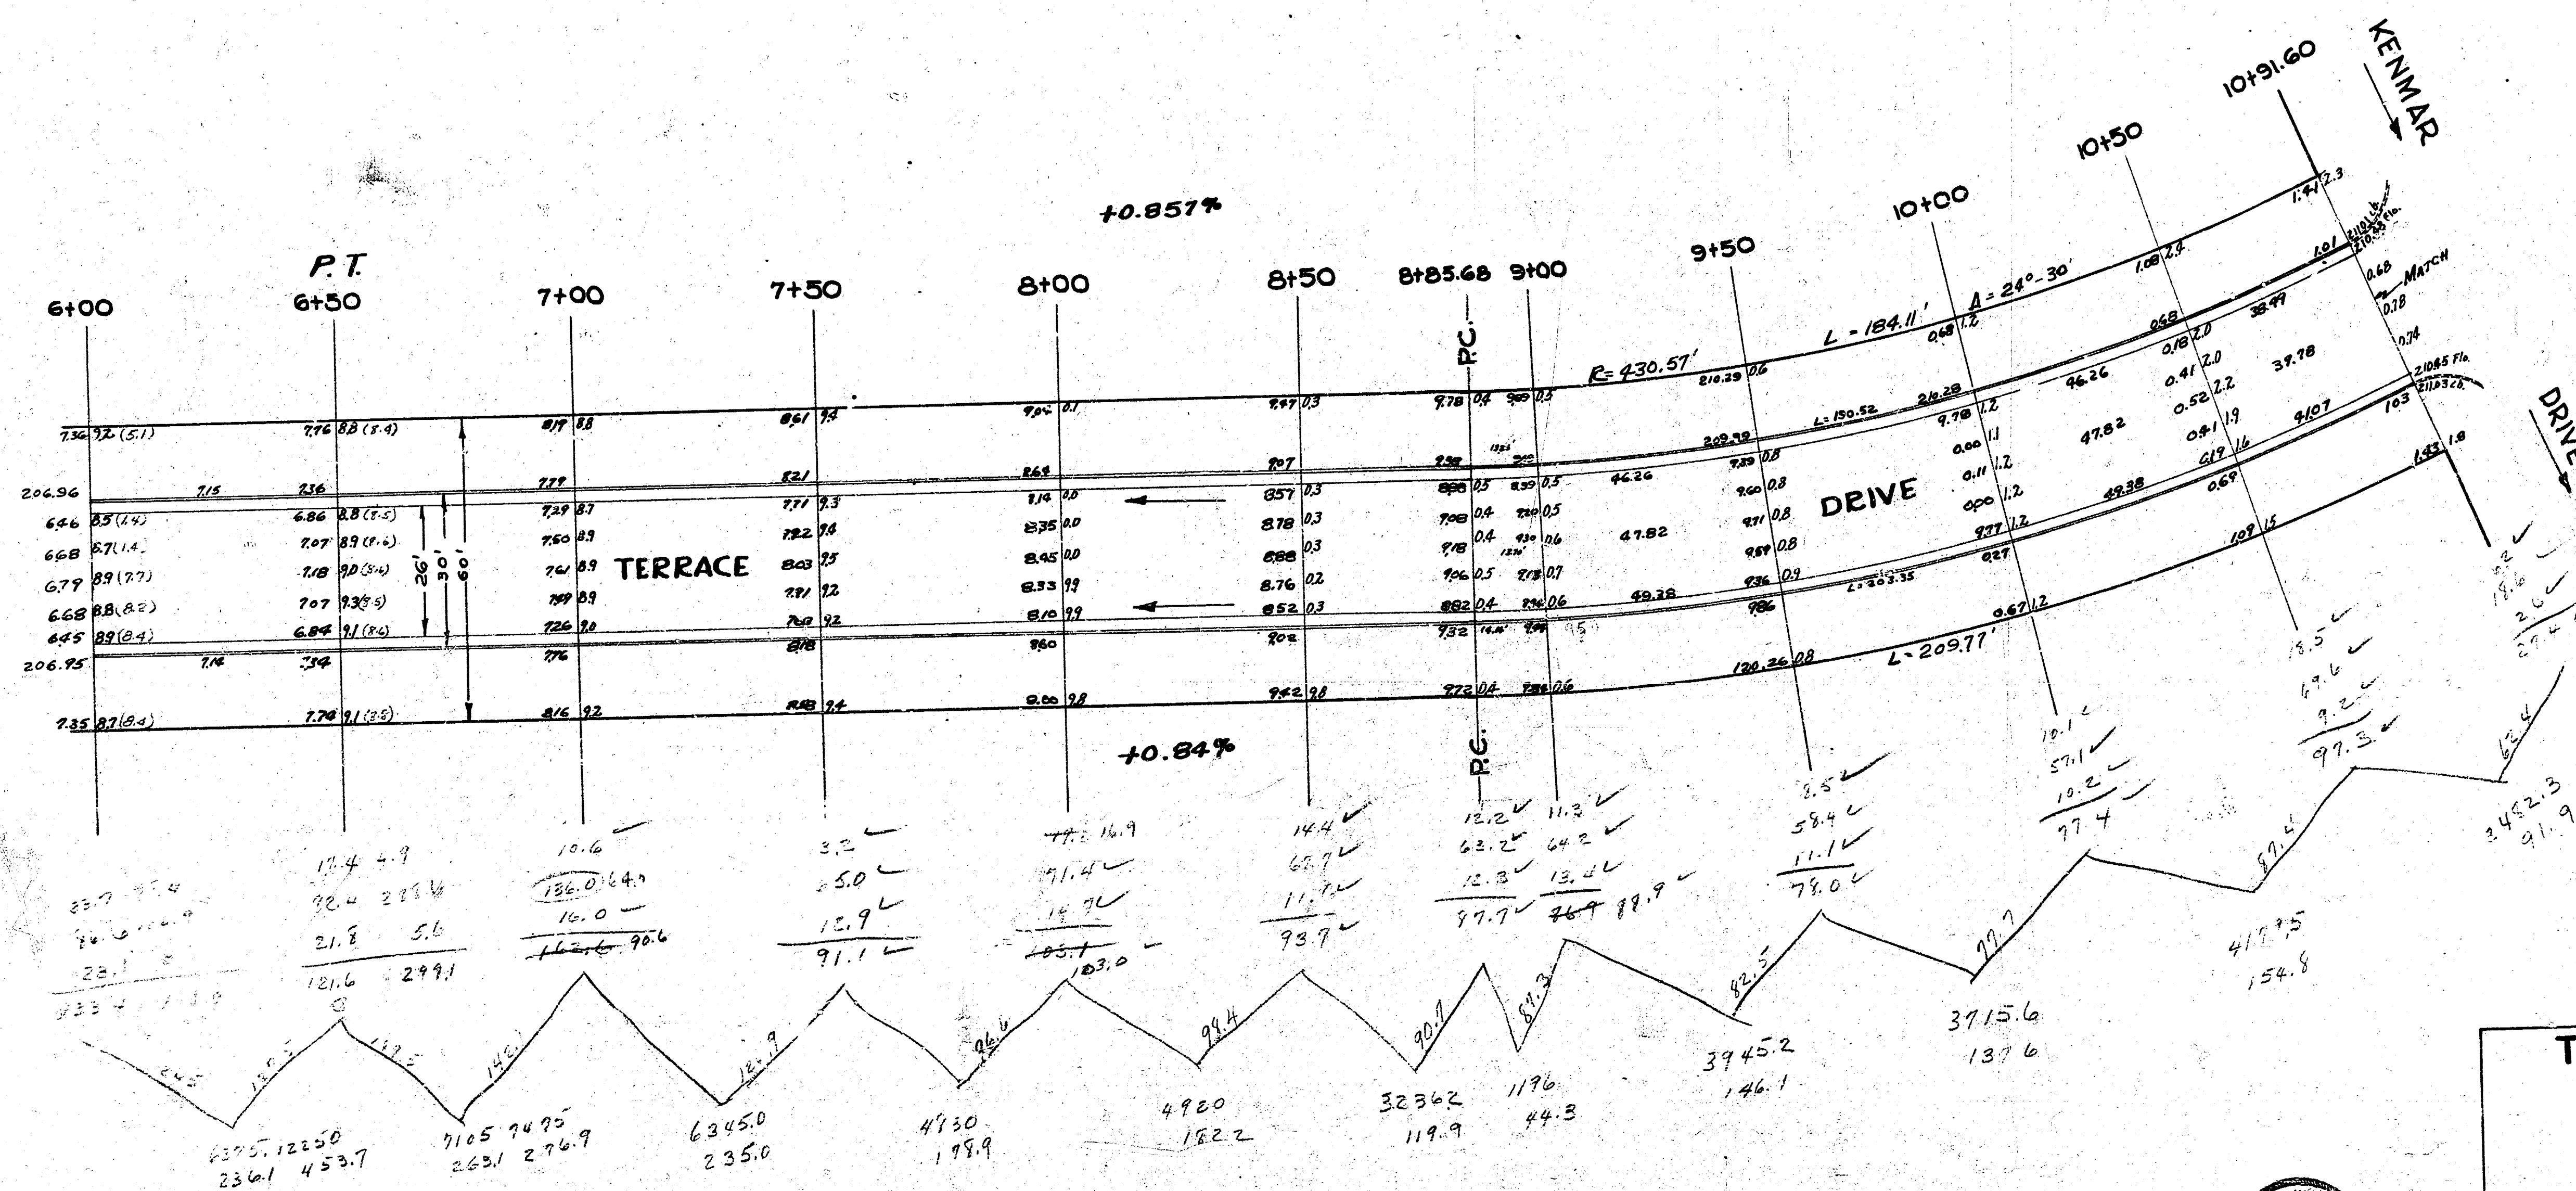

TERRACE DRIVE

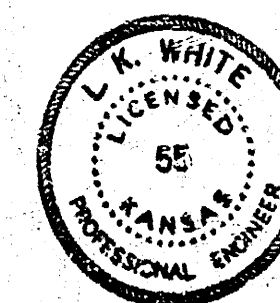

PROJ. NO. C11-260

4 2 4 (S)