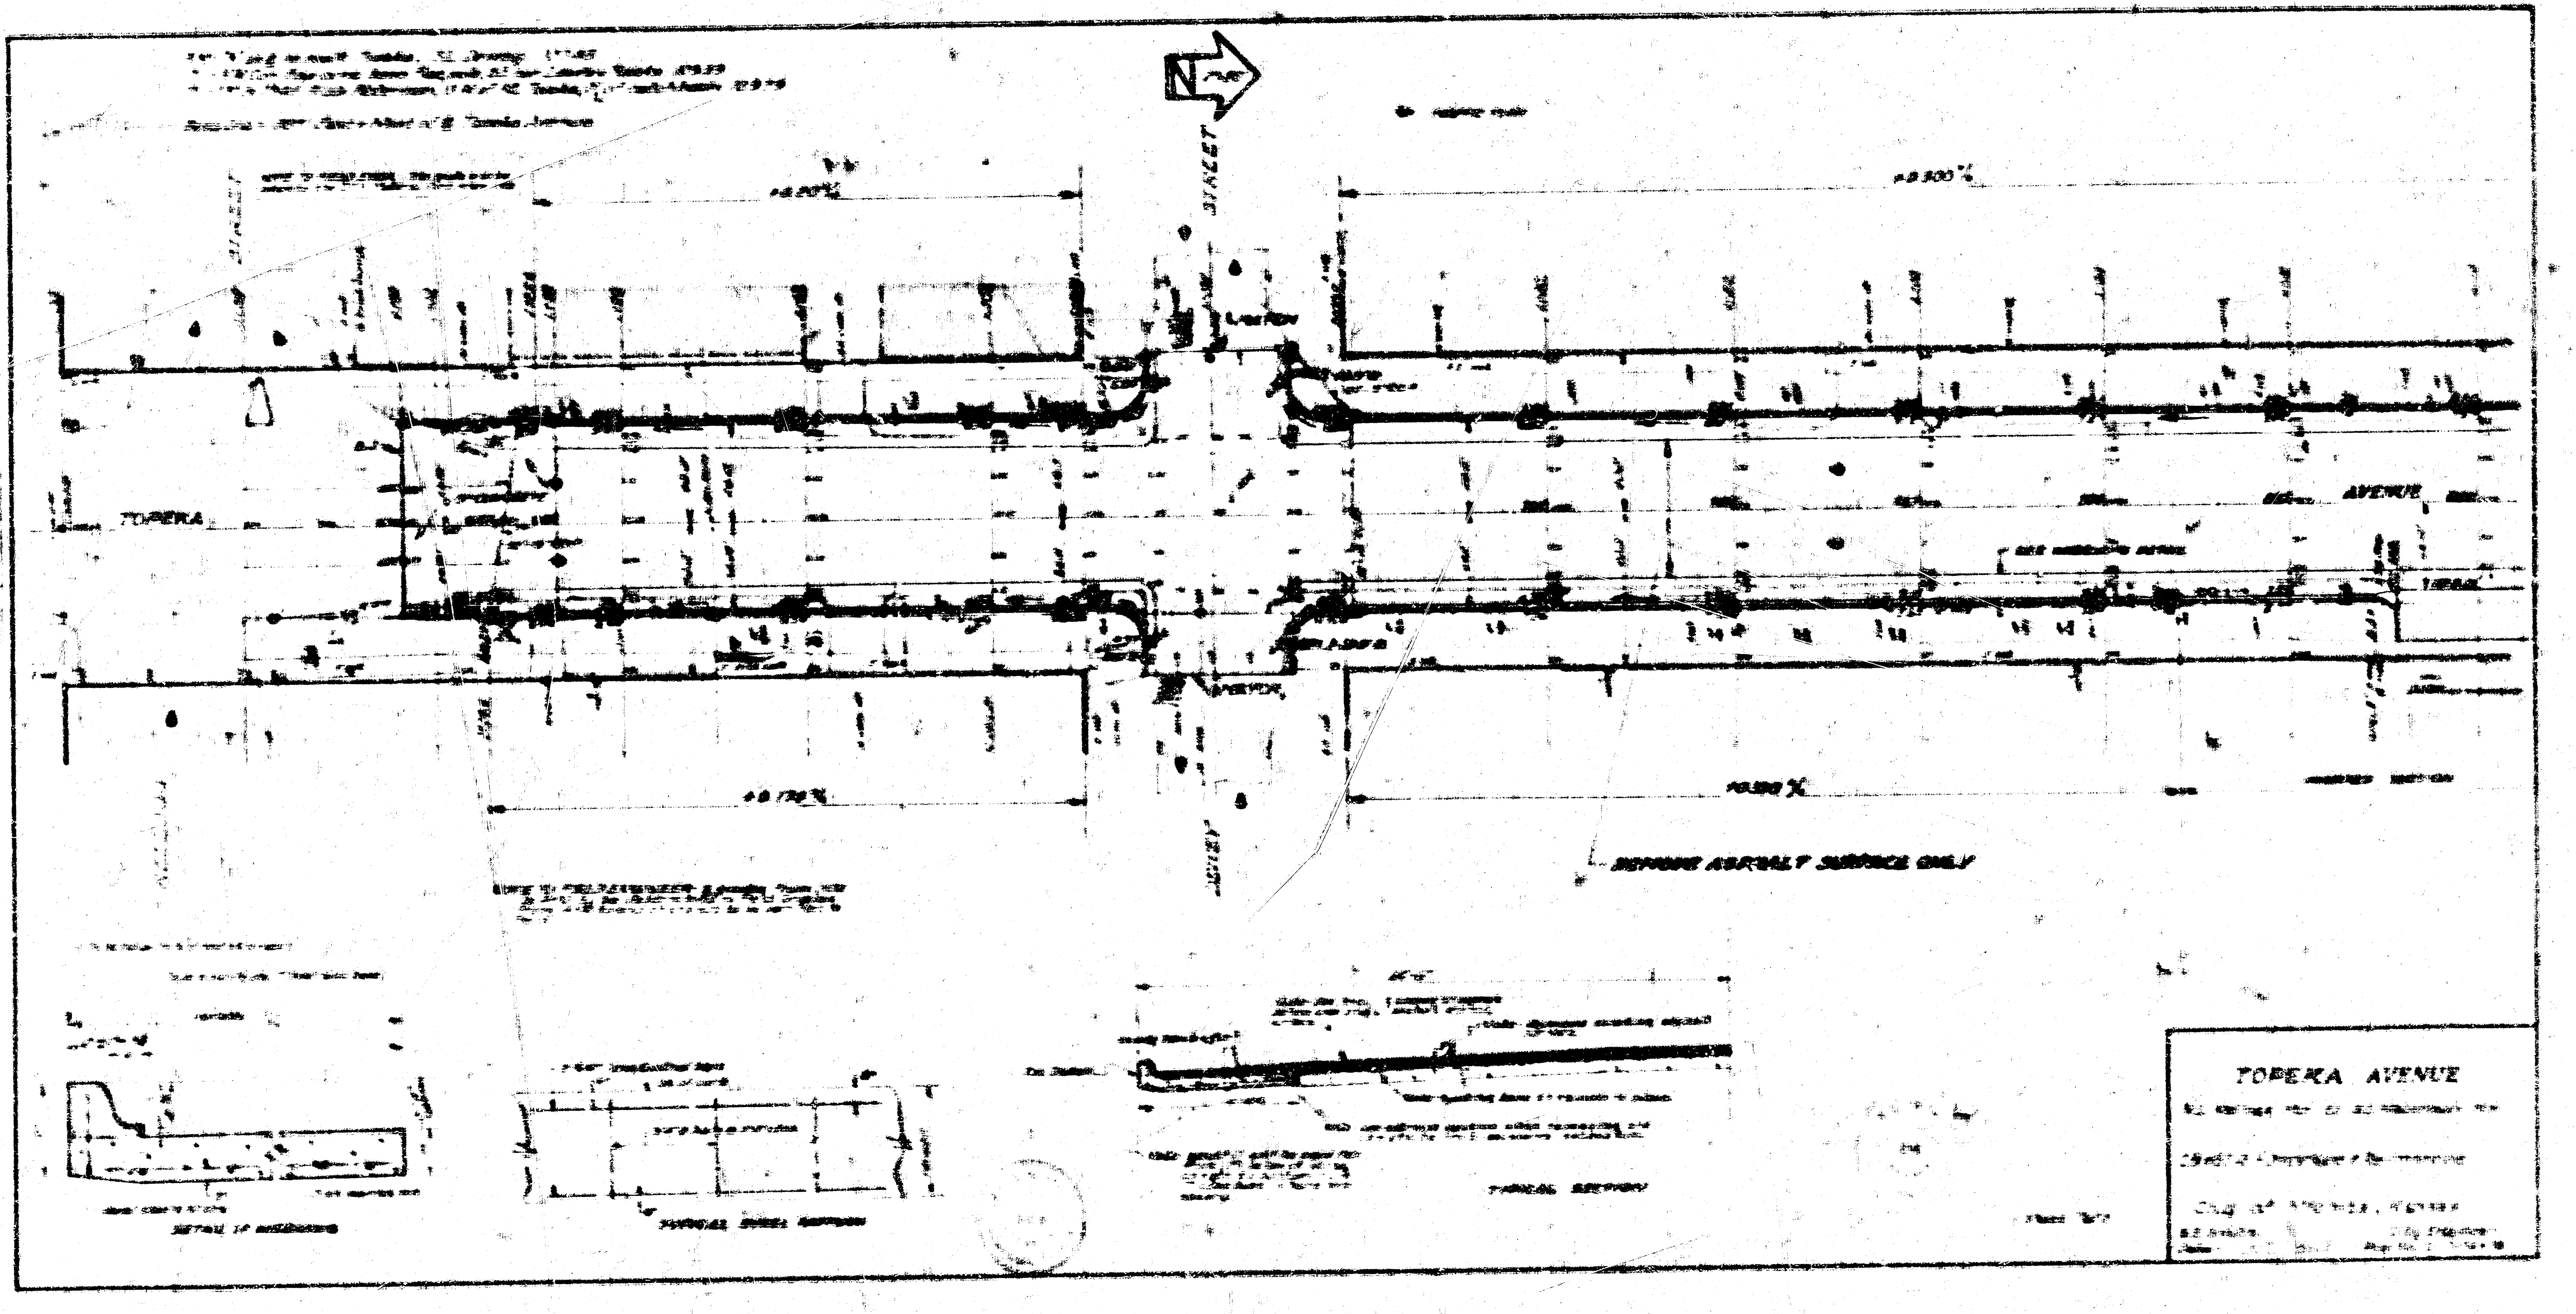
N
STREET
TOPEKA
AVENUE
ALLEY
ASPHALT SURFACE ONLY
TYPICAL SECTION
TOPEKA AVENUE
City of Wichita, Kansas

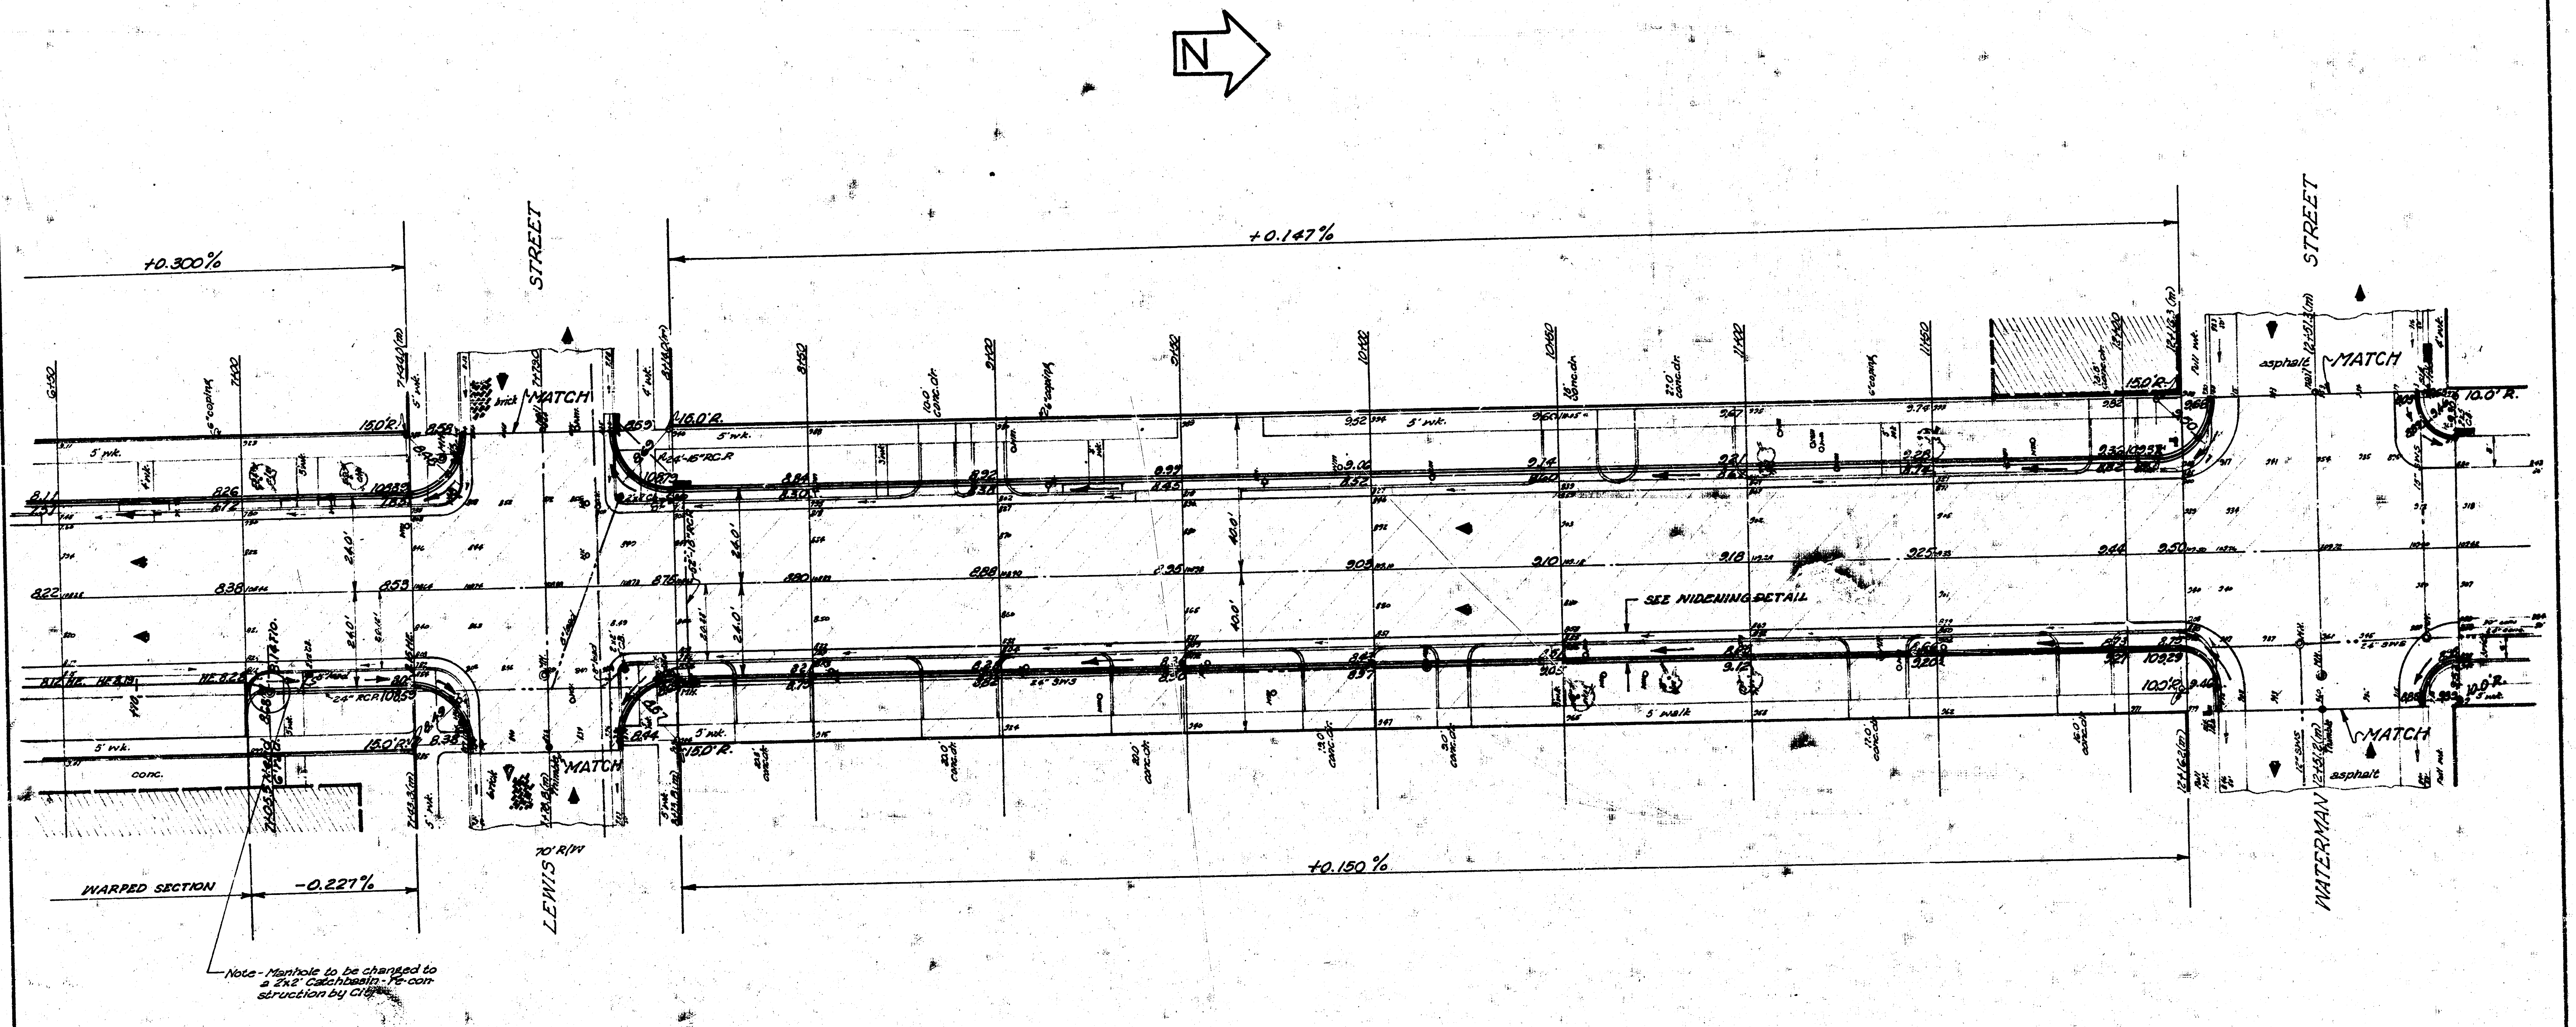
N
+0.300%
+0.147%
LEWIS STREET
70' R/W
WATERMAN STREET
MATCH
MATCH
MATCH
MATCH
brick
brick
asphalt
asphalt
5' wk.
5' wk.
5' walk
4' wk.
conc.
6" coping
2-6" coping
10.0' conc. dr.
21.0' conc. dr.
15.0' R.
15.0' R.
16.0' R.
15.0' R.
15.0' R.
10.0' R.
10.0' R.
10.0' R.
24.0'
24.0'
24.0'
24.0'
40.0'
40.0'
24" RCP
24"-15" RCP
24" SWS
15" SWS
SEE WIDENING DETAIL
WARPED SECTION
-0.227%
+0.150%
6+50
7+00
7+44.0 (m)
7+43.3 (m)
8+14.0 (m)
8+50
9+00
9+50
10+00
10+50
11+00
11+50
12+00
12+16.3 (m)
12+16.2 (m)
12+51.3 (m)
12+51.2 (m)
8.11
8.22
8.26
8.38
8.53
8.58
8.59
8.75
8.80
8.84
8.88
8.92
8.99
9.03
9.06
9.10
9.14
9.18
9.25
9.44
9.50
9.52
9.60
9.74
HE. 8.22
Note - Manhole to be changed to a 2'x2' Catchbasin - re-construction by City

Sht. 2 of 2

Survey C.H. Mills Bk 125+93
Plan Seal
Exc
Checked

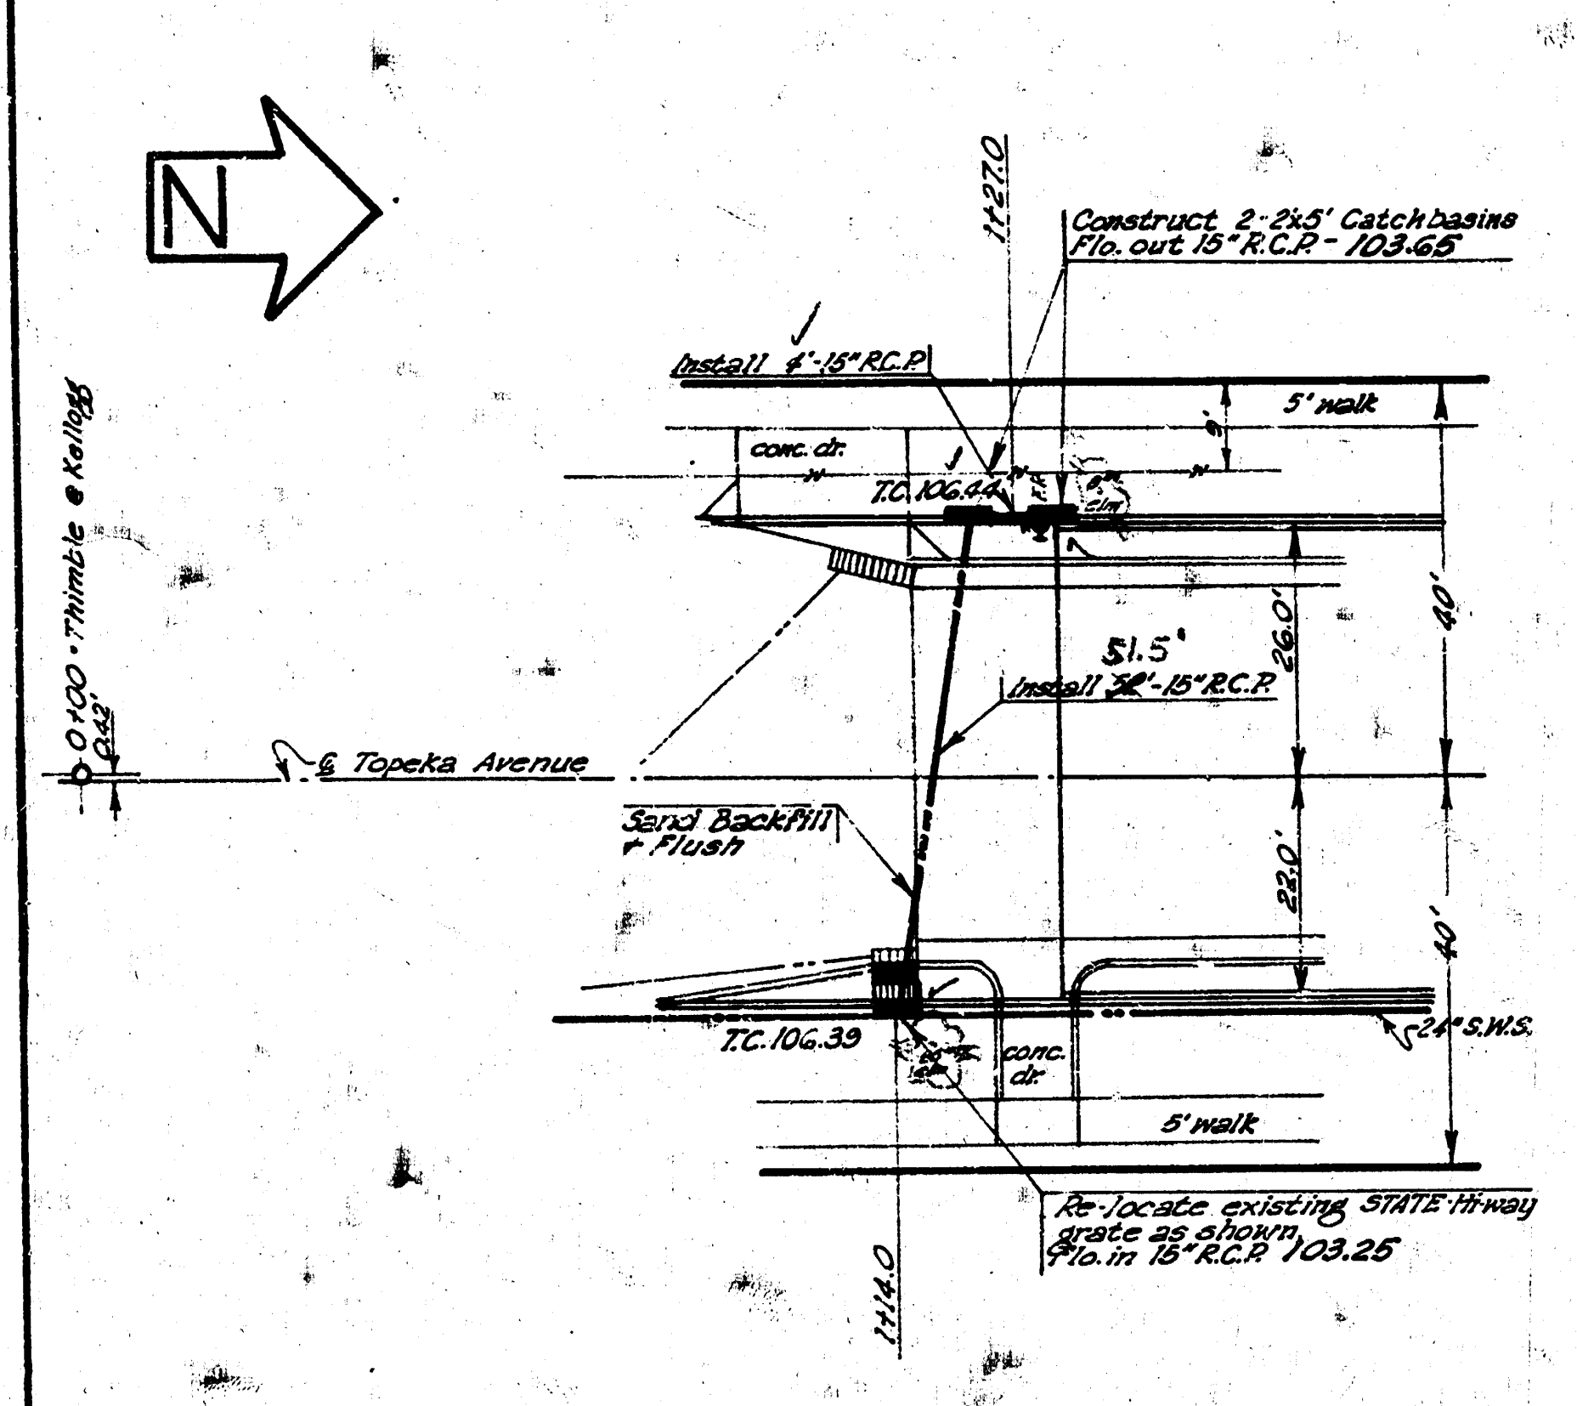
N
0+00 · Thimble @ Kellogg
0.42'
Install 4'-15" R.C.P.
1+27.0
Construct 2-2x5' Catchbasins
Flo. out 15" R.C.P. - 103.65
5' walk
conc. dr.
T.C. 106.44
51.5'
Install 52'-15" R.C.P.
26.0'
40'
℄ Topeka Avenue
Sand Backfill + Flush
23.0'
40'
24" S.W.S.
T.C. 106.39
conc. dr.
5' walk
Re-locate existing STATE Hi-way grate as shown, Flo. in 15" R.C.P. 103.25
1+14.0

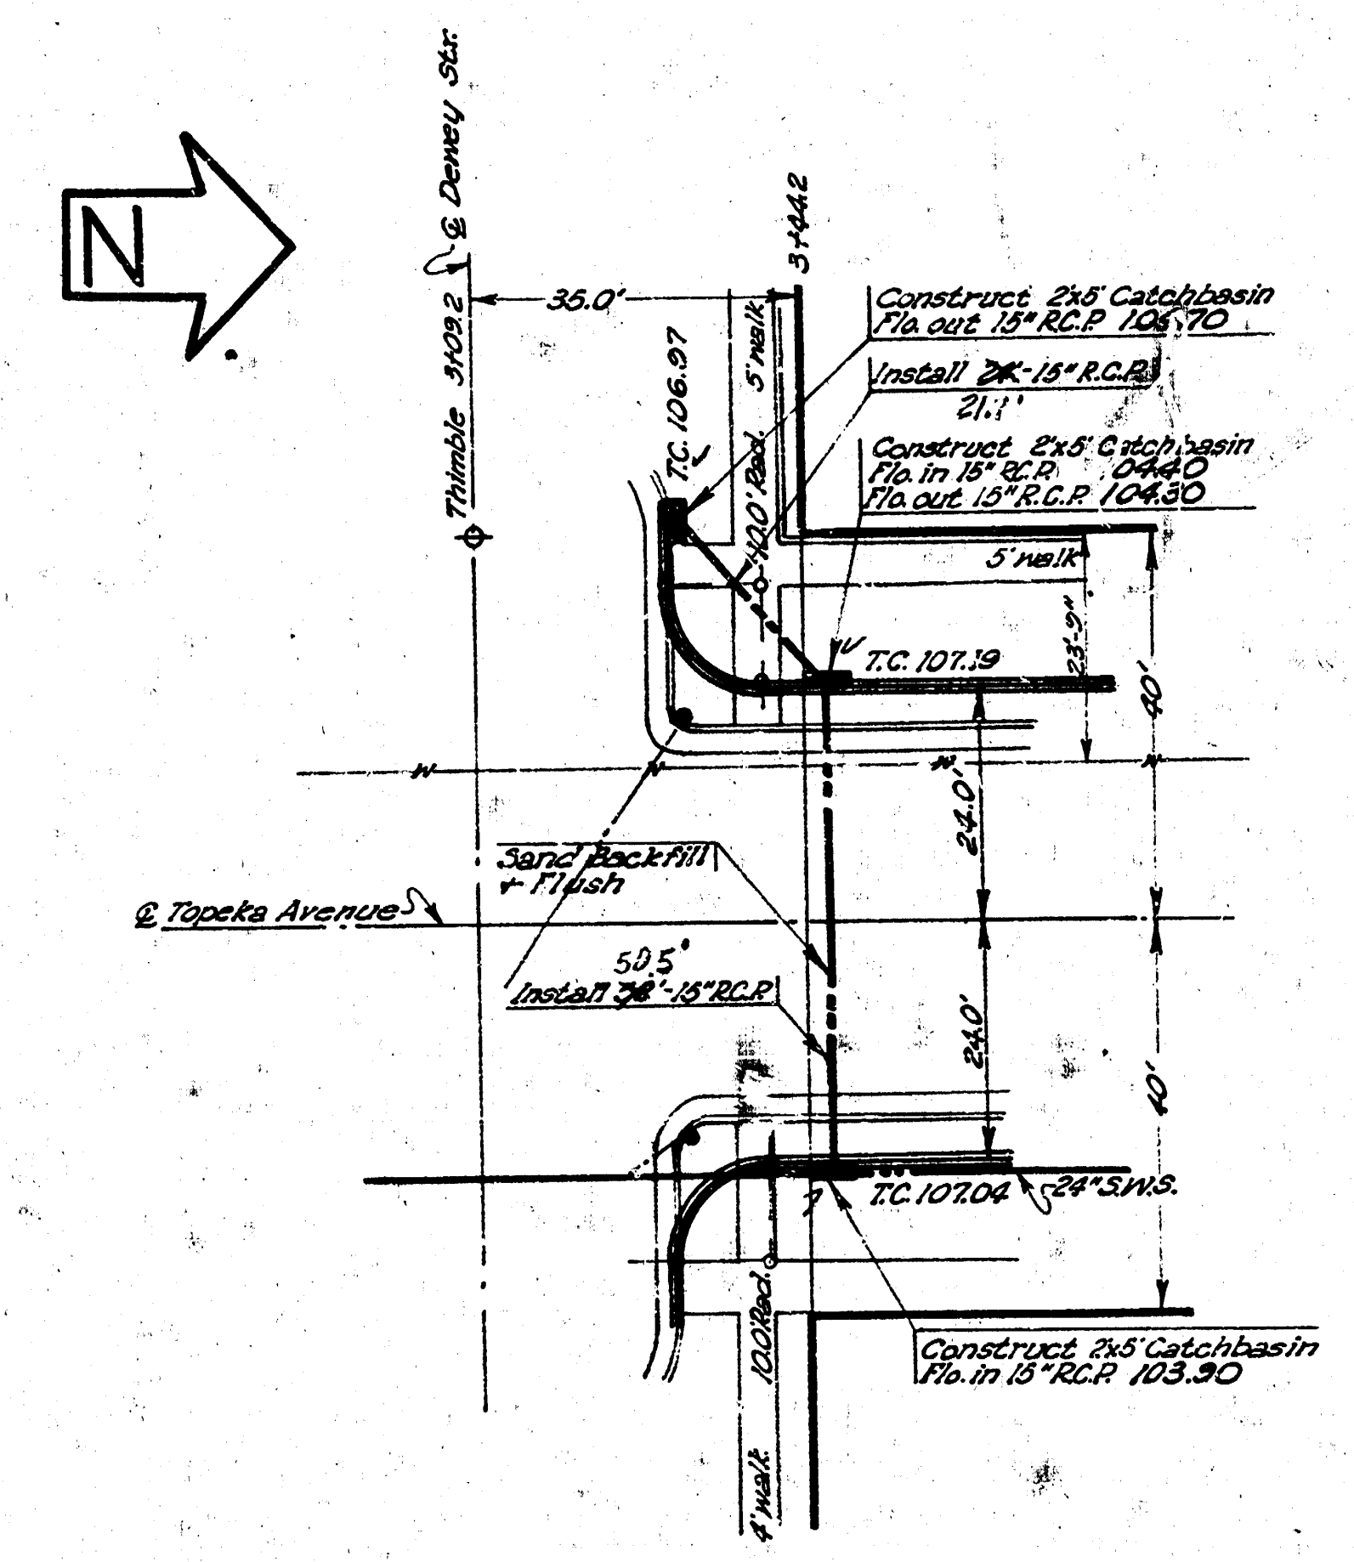
N
℄ Dewey Str.
Thimble 3+09.2
35.0'
3+44.2
5' walk
T.C. 106.97
10.0' Rad.
Construct 2'x5' Catchbasin
Flo. out 15" R.C.P. 106.70
Install 24'-15" R.C.P.
21.1'
Construct 2'x5' Catchbasin
Flo. in 15" R.C.P. 104.40
Flo. out 15" R.C.P. 104.30
5' walk
T.C. 107.19
23'-9"
40'
24.0'
Sand Backfill + Flush
℄ Topeka Avenue
50.5'
Install 58'-15" R.C.P.
24.0'
40'
T.C. 107.04
24" S.W.S.
10.0' Rad.
4' walk
Construct 2'x5' Catchbasin
Flo. in 15" R.C.P. 103.90

BM-"*" on ℄ west walk Topeka, SL. Dewey 107.45

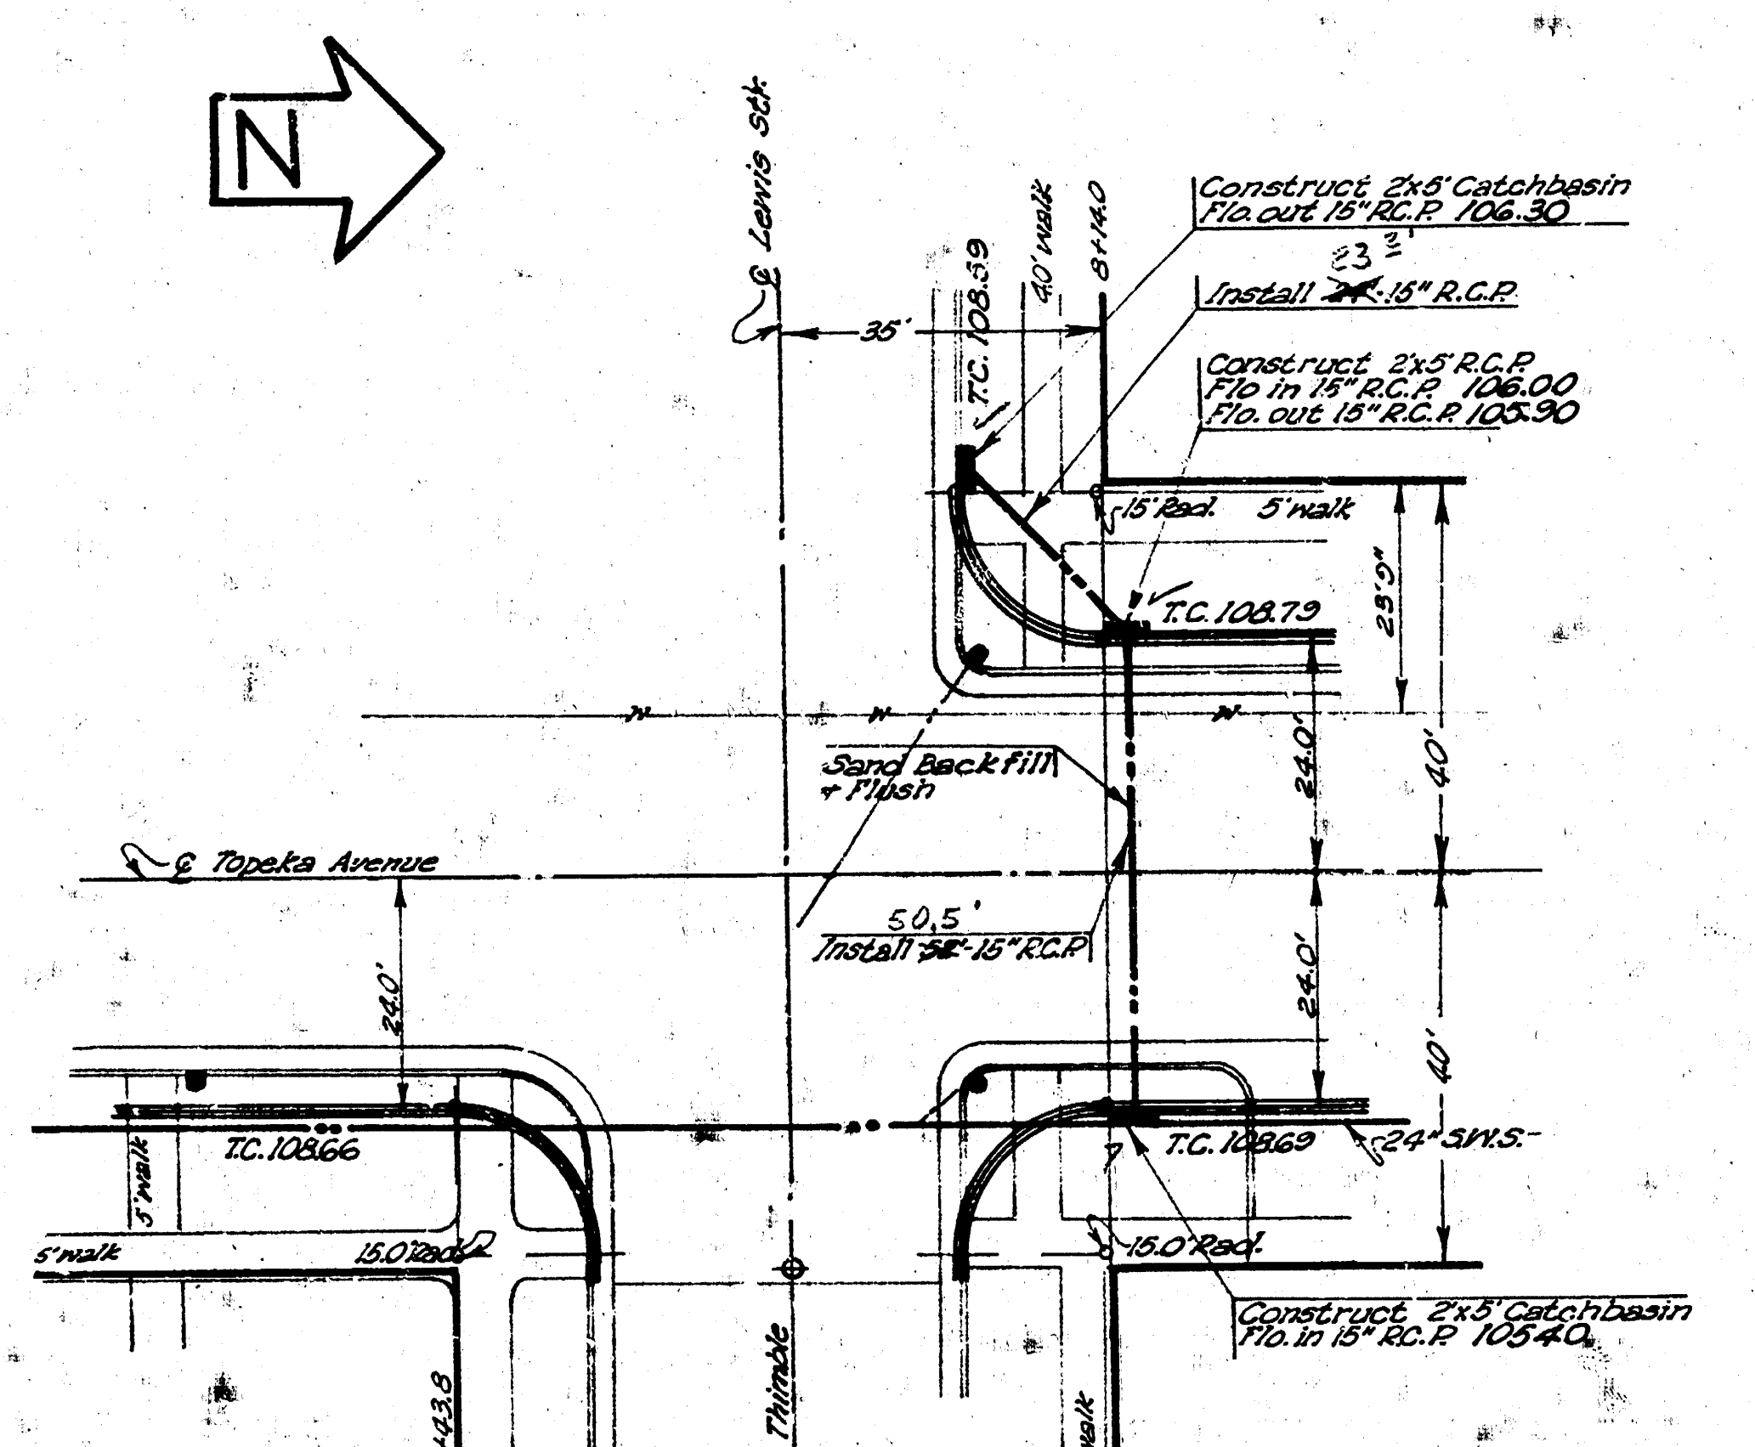
N
℄ Lewis St.
35'
T.C. 108.59
40' walk
8+14.0
Construct 2'x5' Catchbasin
Flo. out 15" R.C.P. 106.30
Install 23.3'-15" R.C.P.
Construct 2'x5' R.C.P.
Flo in 15" R.C.P. 106.00
Flo. out 15" R.C.P. 105.90
15' Rad.
5' walk
T.C. 108.79
23'-9"
40'
24.0'
Sand Backfill + Flush
℄ Topeka Avenue
50.5'
Install 58'-15" R.C.P.
24.0'
24.0'
40'
T.C. 108.66
5' walk
5' walk
15.0' Rad.
T.C. 108.69
24" S.W.S.
15.0' Rad.
Construct 2'x5' Catchbasin
Flo. in 15" R.C.P. 105.40
7+43.8
Thimble
5' walk

B.M.-N.W. cor. top conc. base, flag Pole-S.E. cor. Lewis r Topeka 109.39

B.E. SMITH 436

TOPEKA AVE.

NL. Kellogg Street - NL. Waterman Street

INCIDENTAL DRAINAGE

City of Wichita, Kansas

B.E. Smith　City Engineer
Date- Oct. 1940　Proj. No. C10-74 + 75

10 2 3 8