



E.M. 169.81 "X" on S. ab Laron @ ho. approach wk. S.E. Laron & Yale Blvd.
 B.M. 180.08 S.W. Cor curb on S.W.S. bulkhead 100' N. 15th & approx. @ Yale Blvd.S.

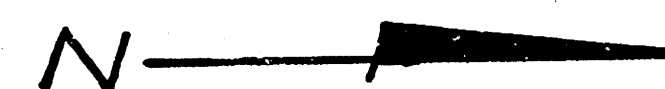

Note: Stationing is on W.P.L. to Sta. 2+48.01 and is 25'
 W of W. Cb. from Sta. 2+48.01 to Sta. 9+91.21

From P.T. of curve Sta. 6+21.91 to S.L. 15th, Sta. 9+91.21, the
 E. of Yale Blvd. is 35' E. of E.L. Yale Ave.

Grades set on Cb. line distances.

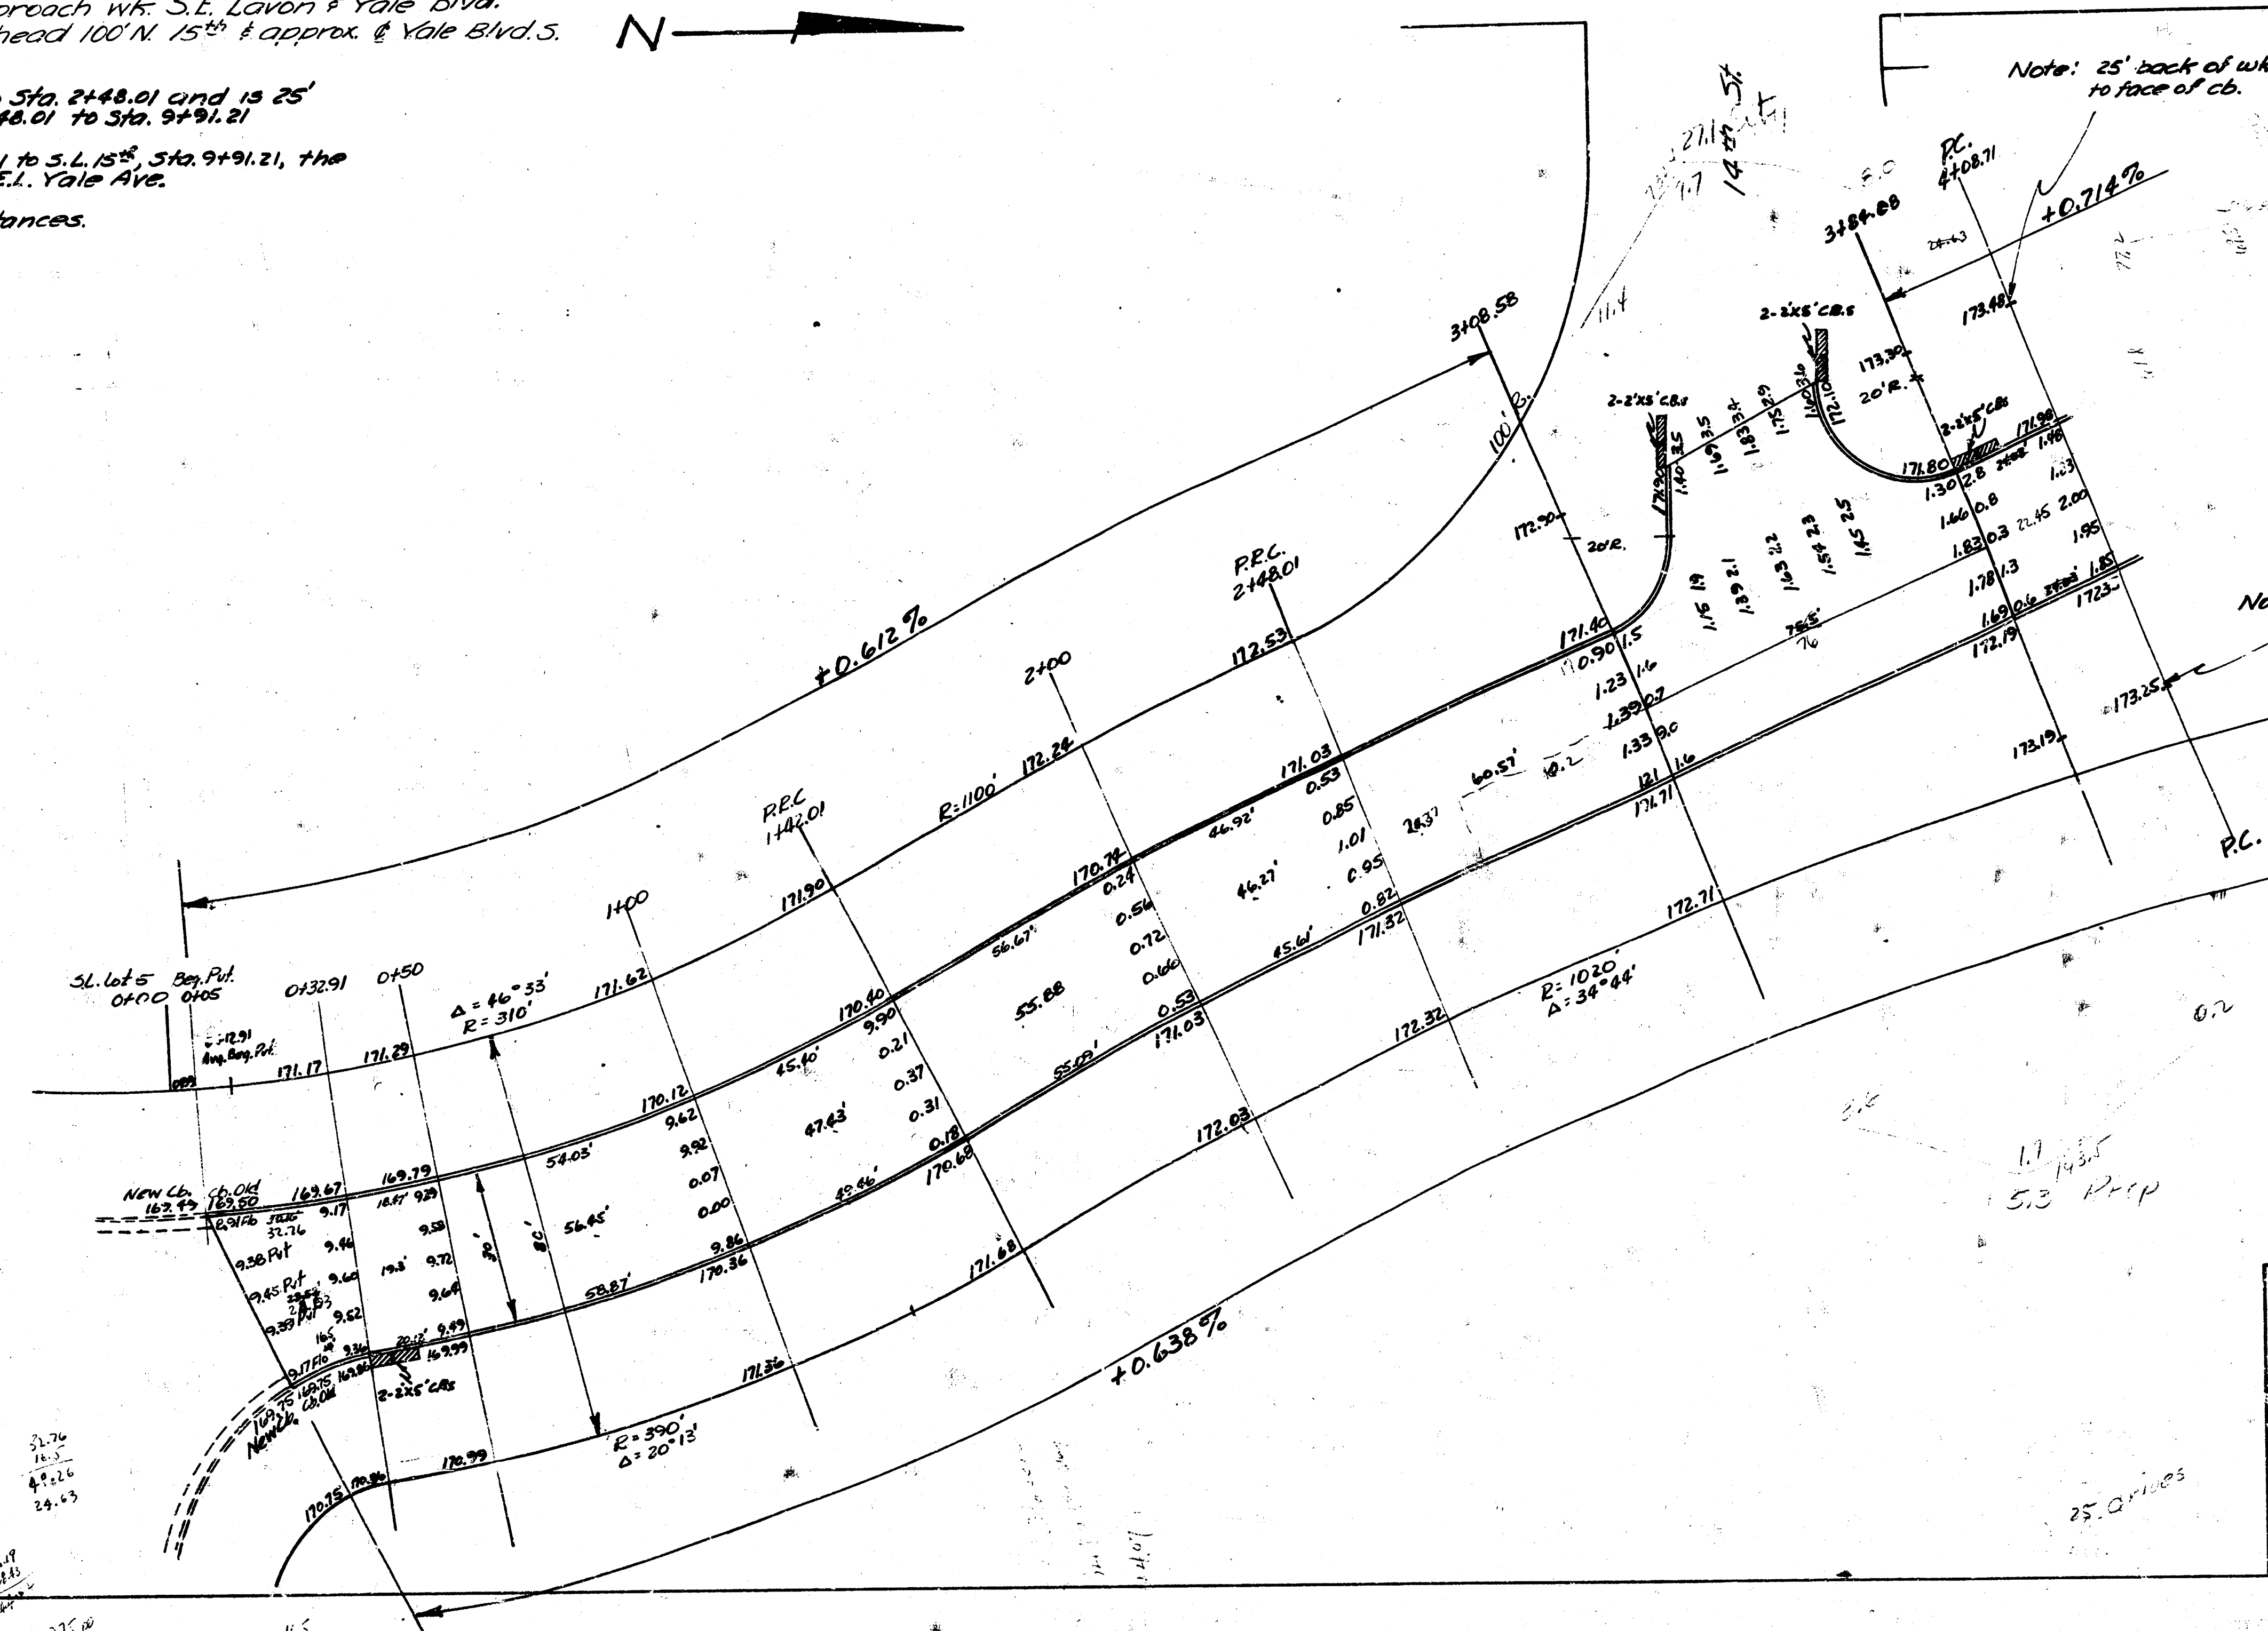

1
2

Yale Blvd
 S.L. Lot 5, Blk. B, Y.H. - S.L. 15th St.
 30' Conc. & Cb.
 City of Wichita, Kansas
 L.K. White City Engineer
 Proj. No. C18-91

