


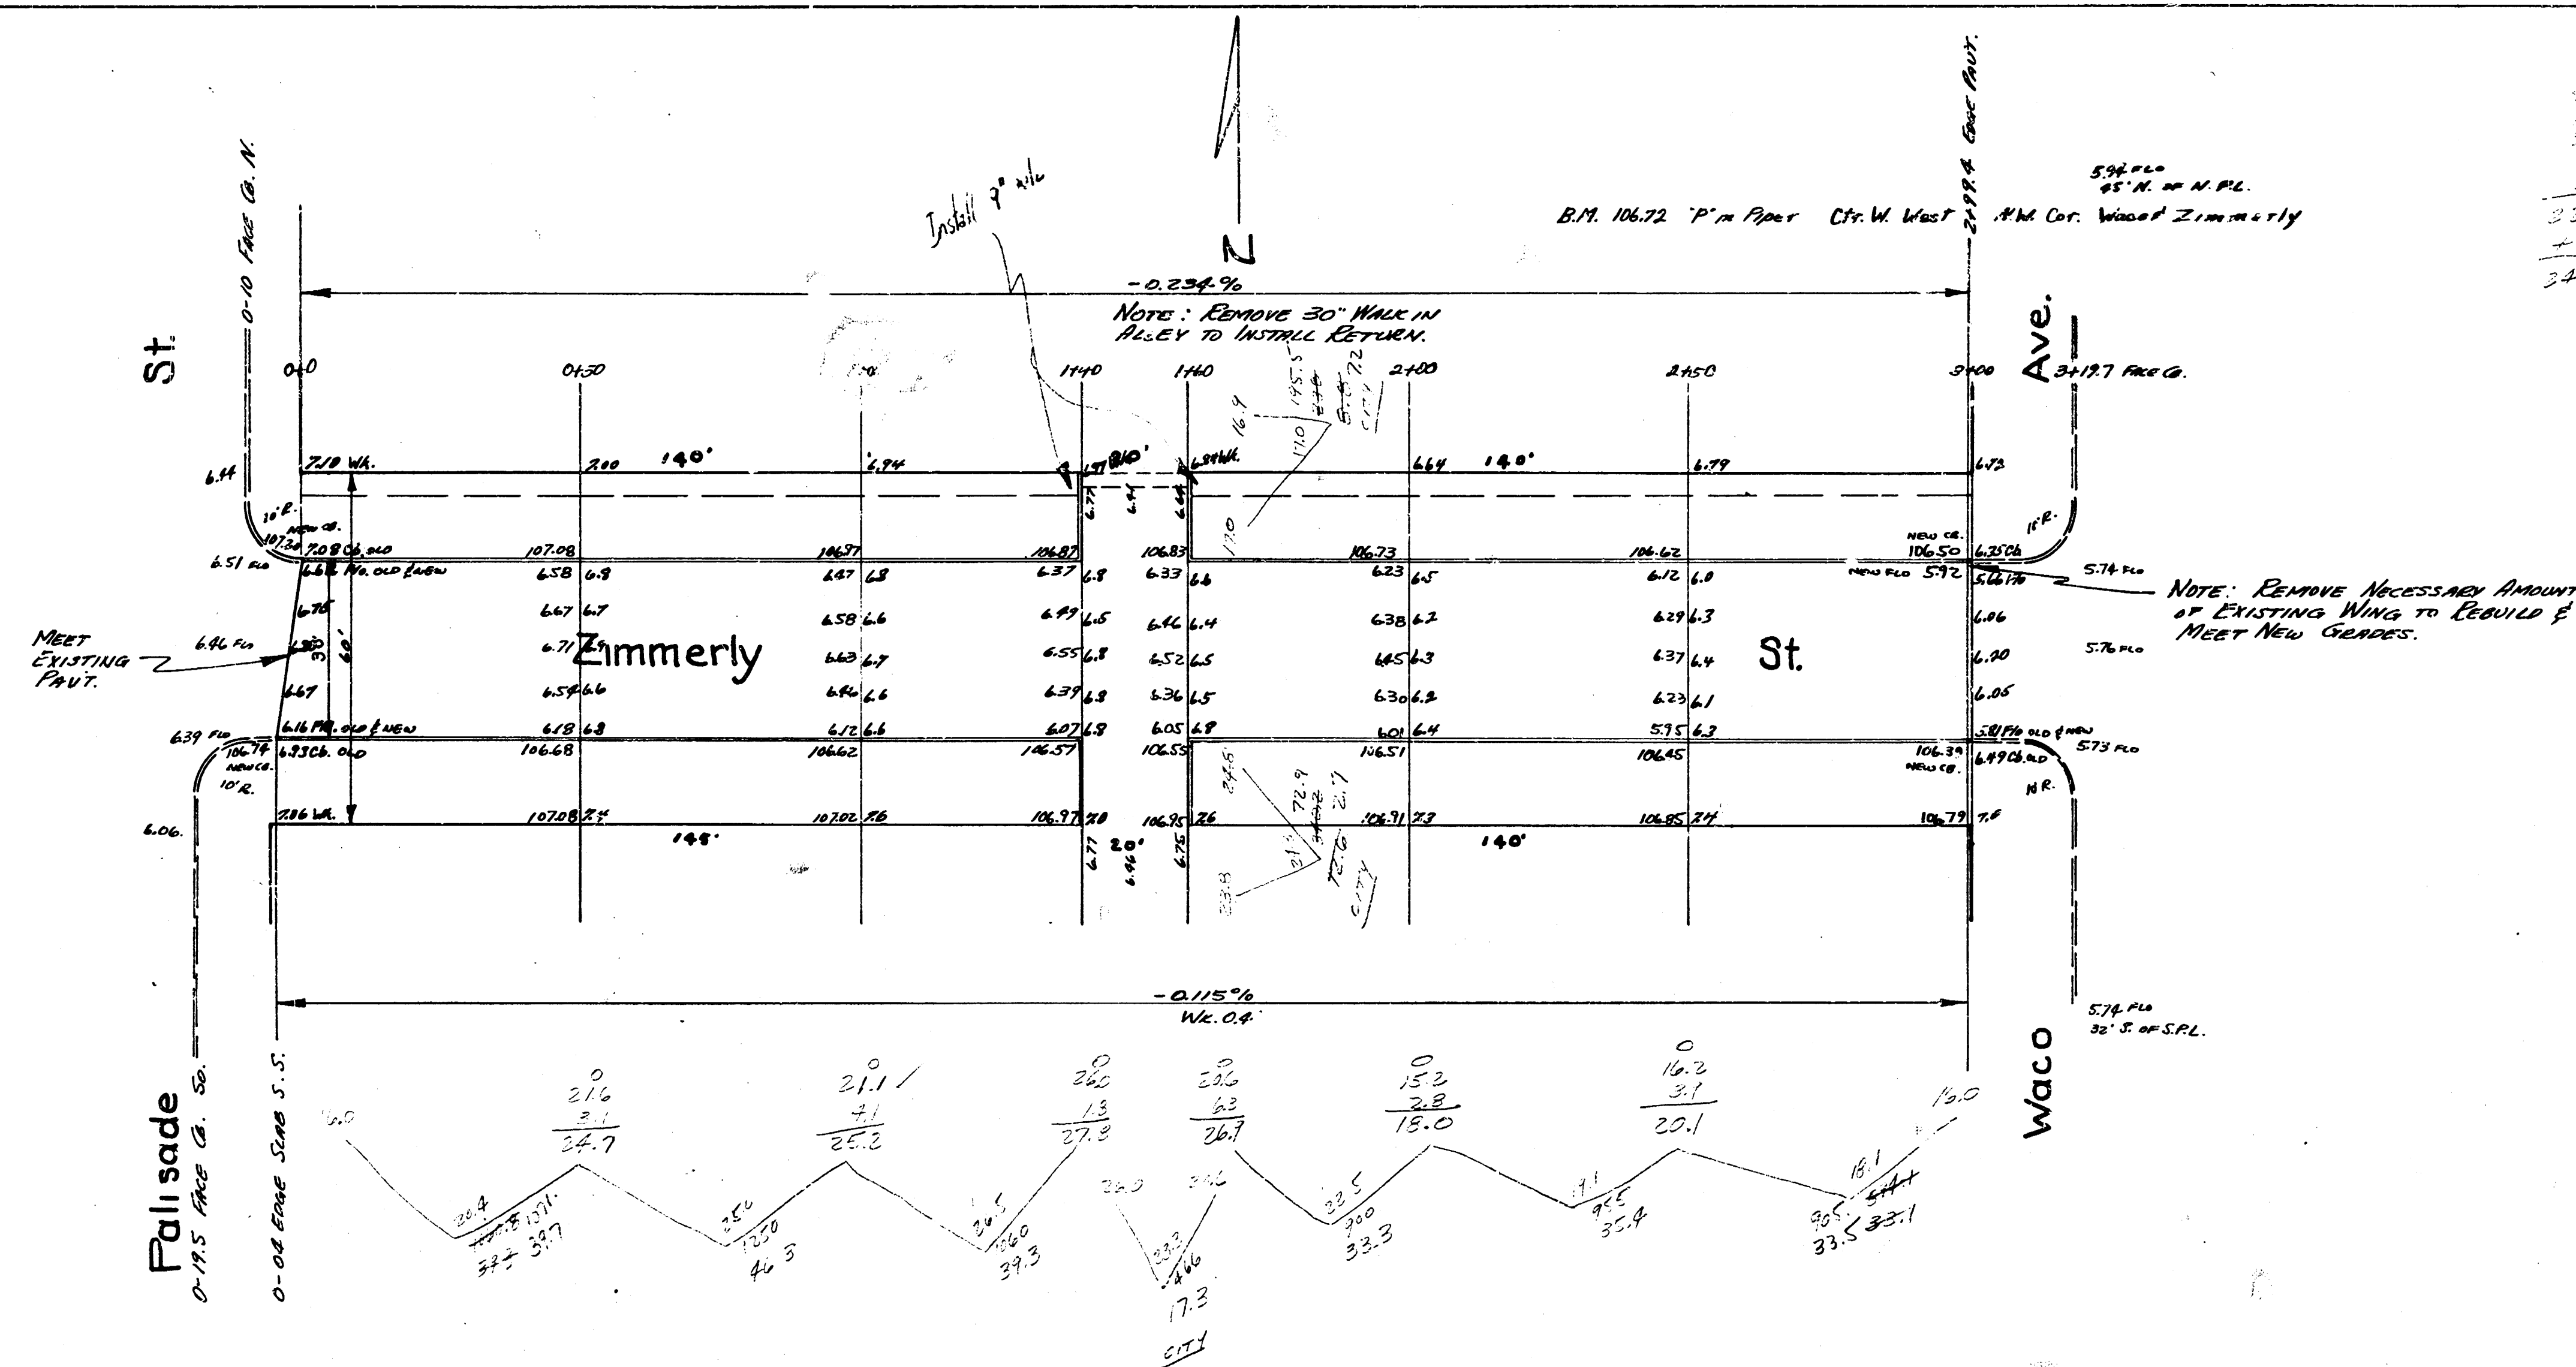

Zimmerly St.
 E.L. Palisade ~ W.L. Waco
 30' Conc. & Cb.
 City of Wichita, Kansas
 L.K. White ~ City Engineer
 April 1949 Proj. *C-19-40