


**B SECTION**  
1/4" = 1'-0"


**2 SECTION B-B**  
1/4" = 1'-0"

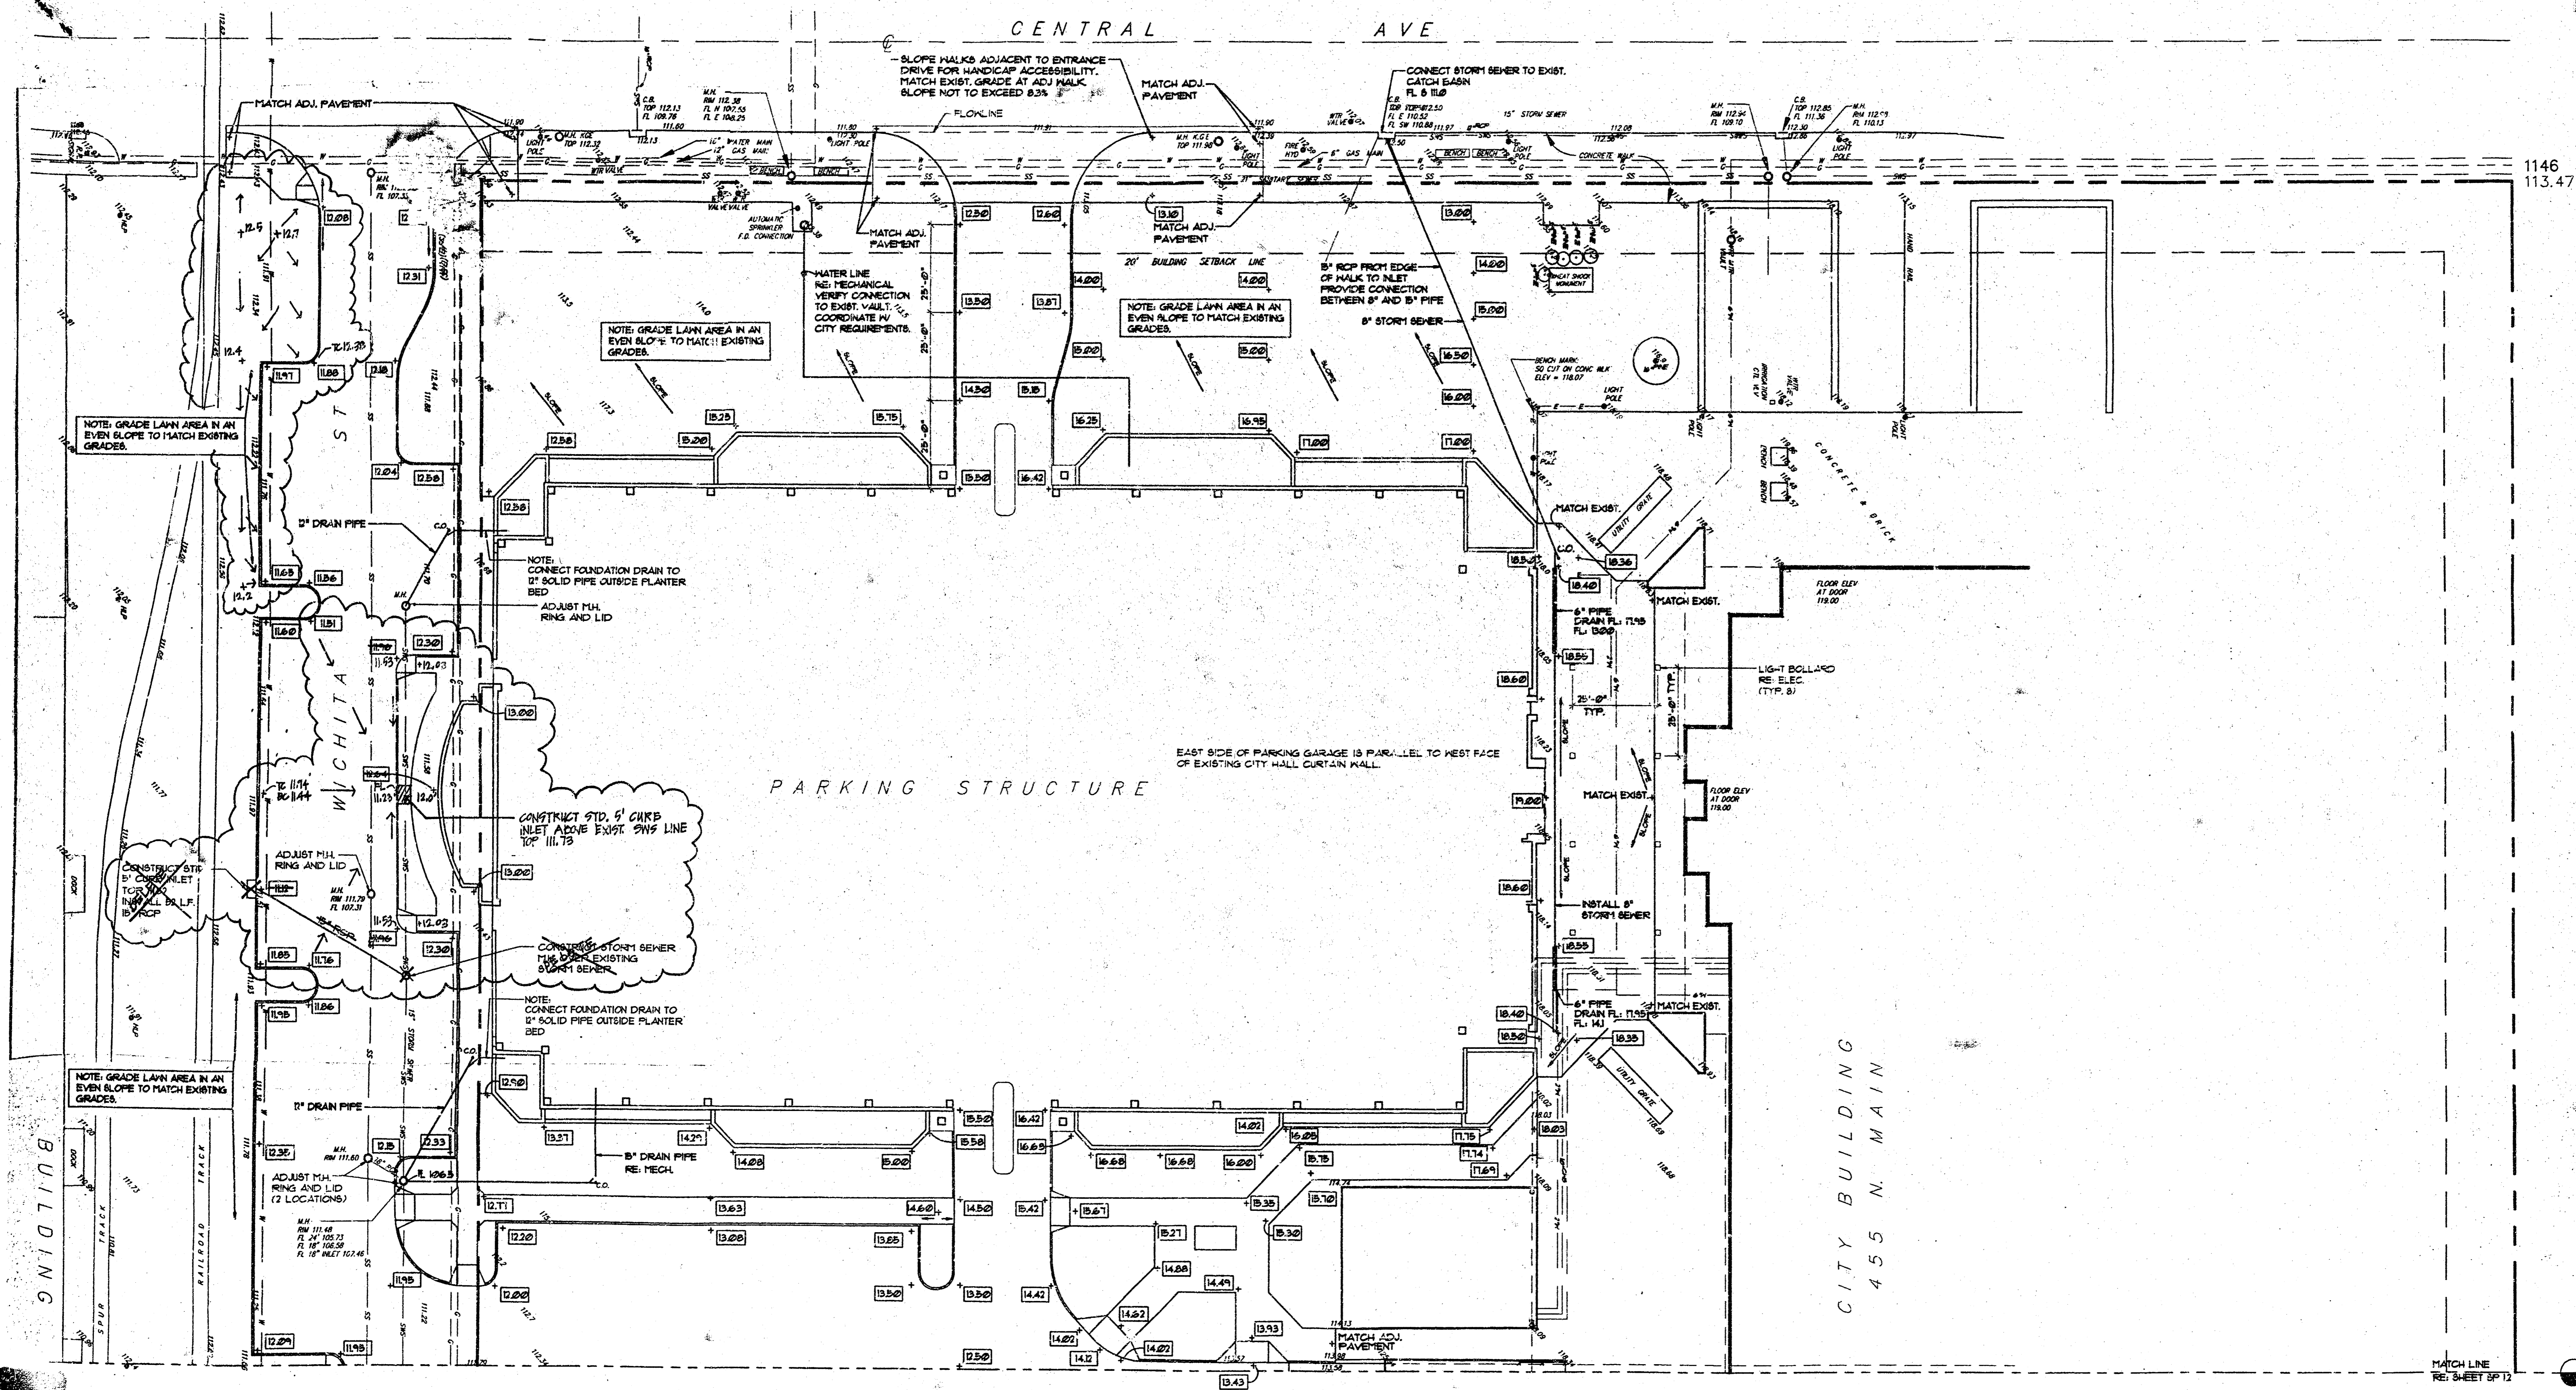

**A UTILITY/GRADING PLAN**  
1/4" = 1'-0"

**OBLINGER MASON McCLURGAGE & VAN SICKLE CORPORATION**  
Architects Engineers Landscape Architects  
P.O. Box 35448  
1325 S. Westwood  
Wichita, Kansas 67208  
(316) 882-0481  
(316) 882-3488 FAX

**CITY HALL PARKING STRUCTURE**  
CITY OF WICHITA  
WICHITA, KANSAS

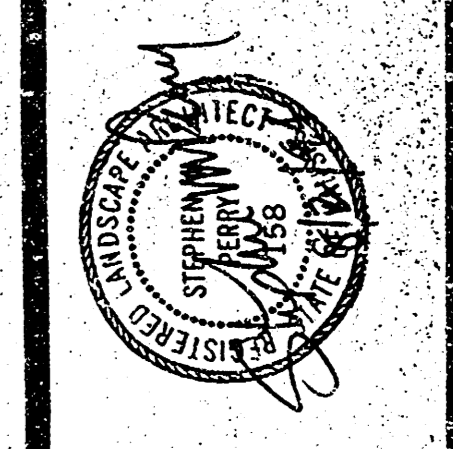

PROJECT NO. 9273  
DATE: AUGUST 2, 1994  
REVISIONS:  
DRAWN: CHECKED:

SHEET  
SP.1  
OF SHEETS

NOTES FROM THE LOCAL AGENCY

