
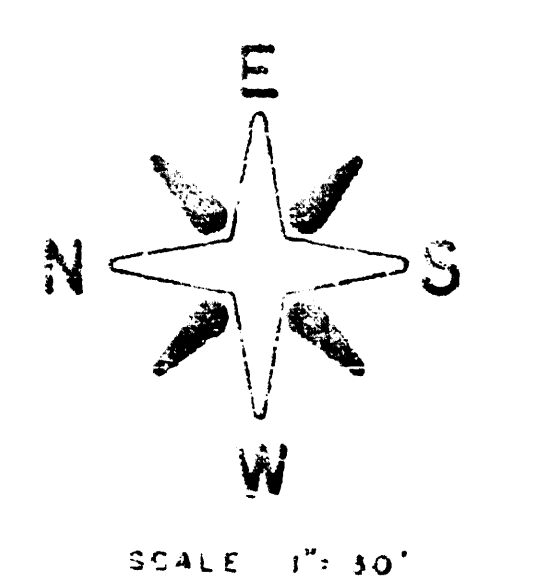


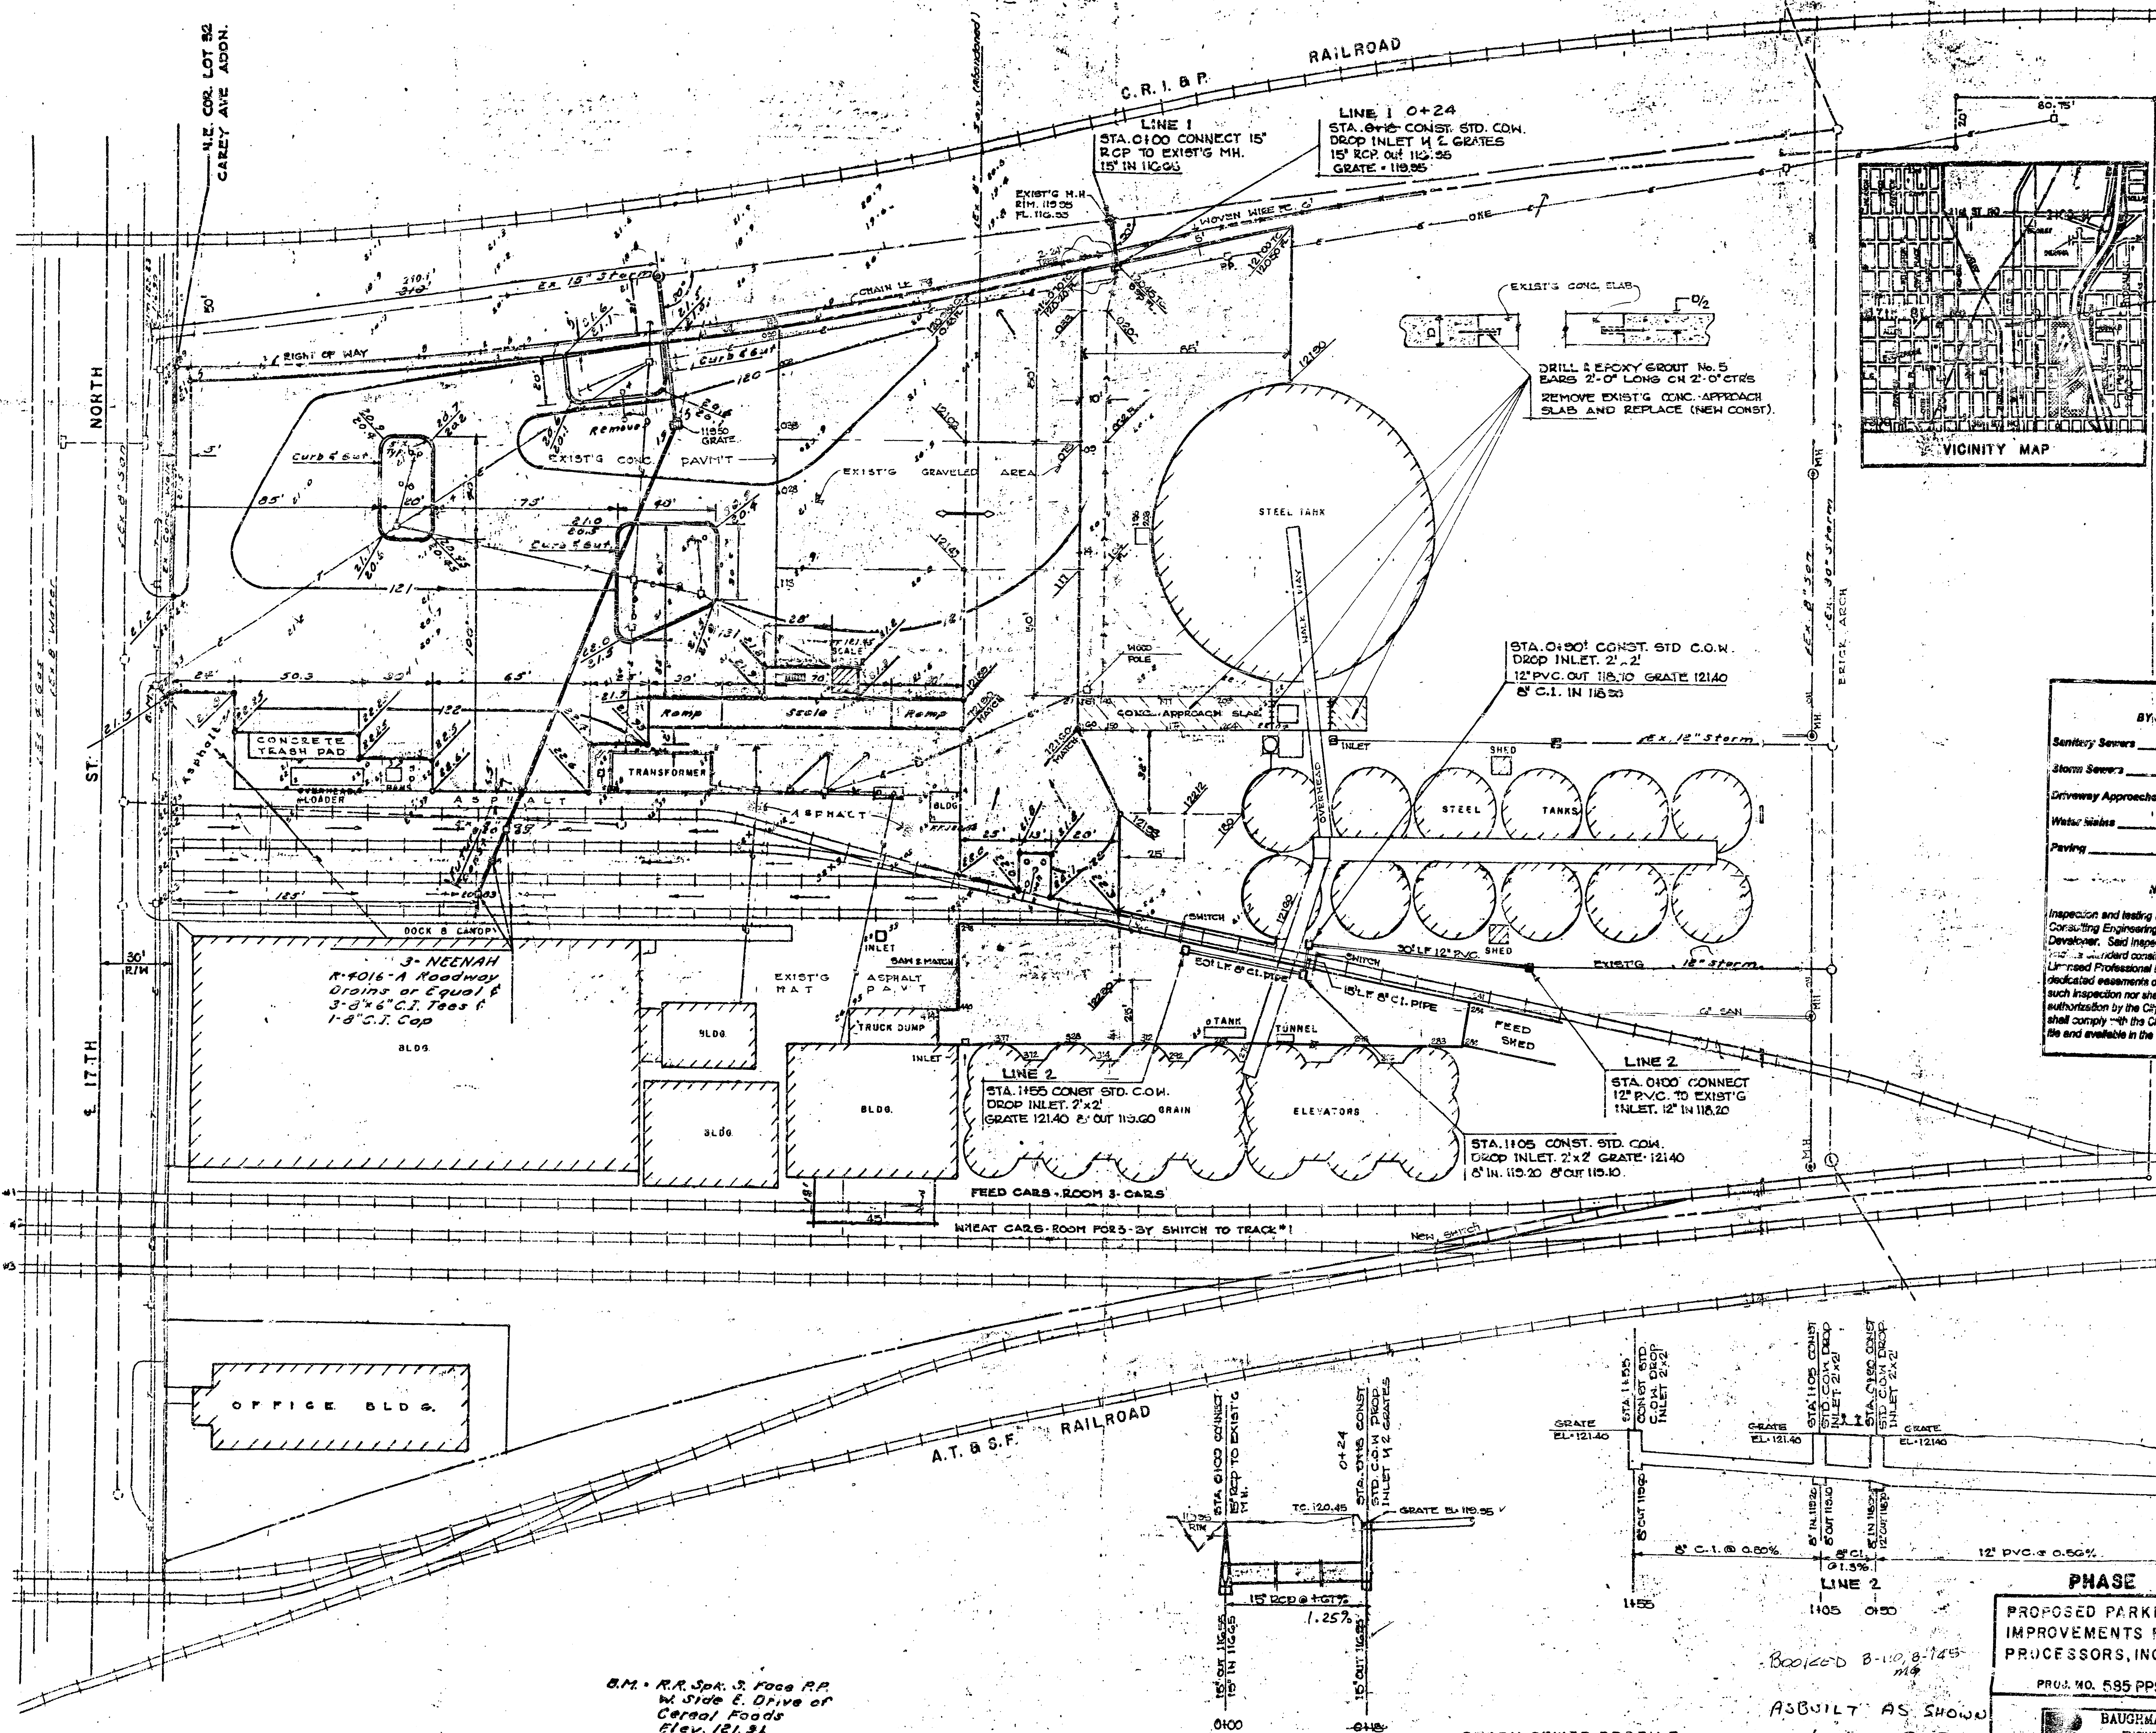


APPROVED AS NOTED

Sanitary Sewers _____
Storm Sewers VRH 9/15/95
Driveway Approaches _____
Water Mains _____
Paving _____

NOTE TO CONTRACTORS



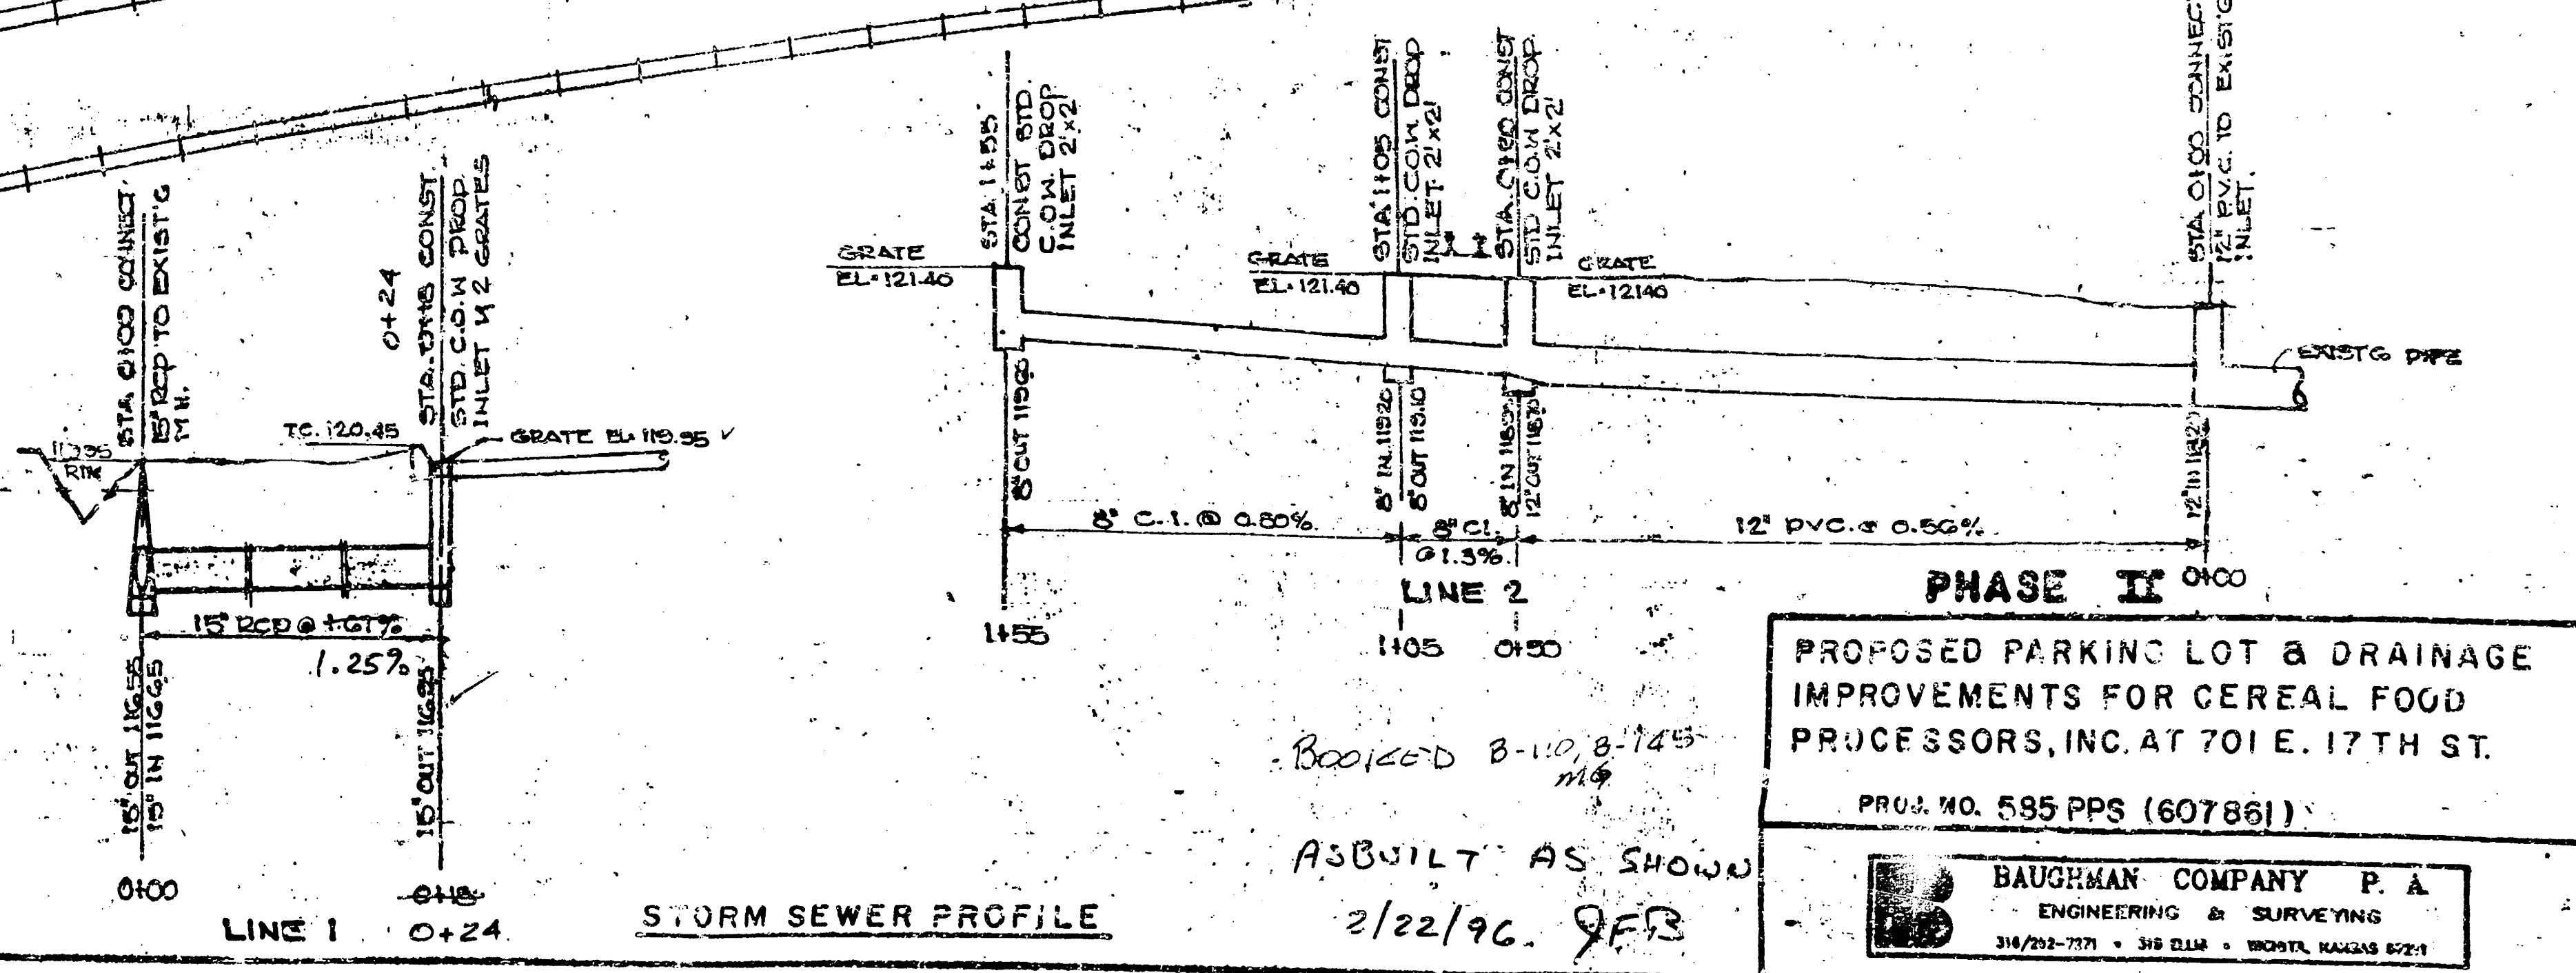

PHASE II

PROPOSED PARKING LOT & DRAINAGE
IMPROVEMENTS FOR CEREAL FOOD
PROCESSORS, INC. AT 701 E. 17TH ST.

PROJ. NO. 585 PPS (607861)

BAUGHMAN COMPANY P.A.
ENGINEERING & SURVEYING

2/22/96 JFB

C.M. R.R. Sp. 3. Foss R.R.
W. Side E. Drive of
Cereal Foods
Elev. 121.51