

Benchmark

City of Wichita Benchmark Disc, Center of U.S. 54 Pavements and 44' West of Centerline of Dugan.
Elev. = 121.65 (City Datum)

"□" Cut Top of Curb on the East End of the Return at the S.E. Corner of Dugan and Taft.
Elev. = 118.61 (City Datum)

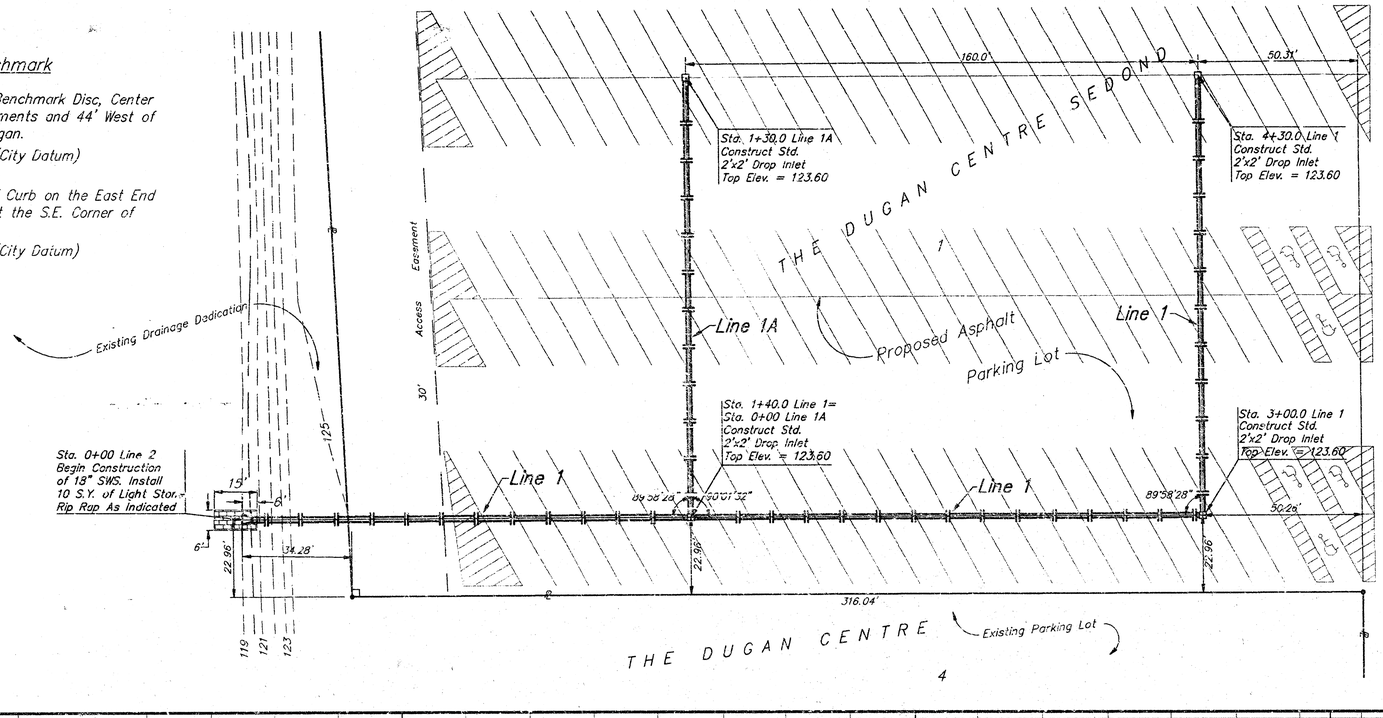

4

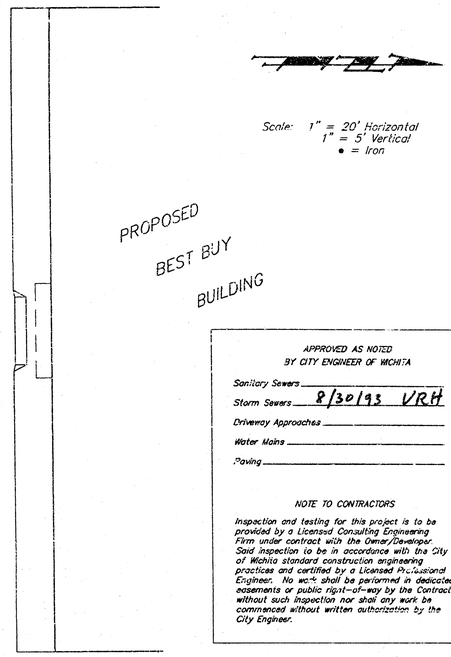


Scale: 1" = 20' Horizontal
1" = 5' Vertical
● = Iron

APPROVED AS NOTED
BY CITY ENGINEER OF WICHITA

Sanitary Sewers _____
Storm Sewers 8/30/93 VRH
Driveway Approaches _____
Water Mains _____
Paving _____

NOTE TO CONTRACTORS

Inspection and testing for this project is to be provided by a Licensed Consulting Engineering Firm under contract with the Owner/Developer. Said inspection to be in accordance with the City of Wichita standard construction engineering practices and certified by a Licensed Professional Engineer. No work shall be performed in dedicated easements or public right-of-way by the Contractor without such inspection nor shall any work be commenced without written authorization by the City Engineer.

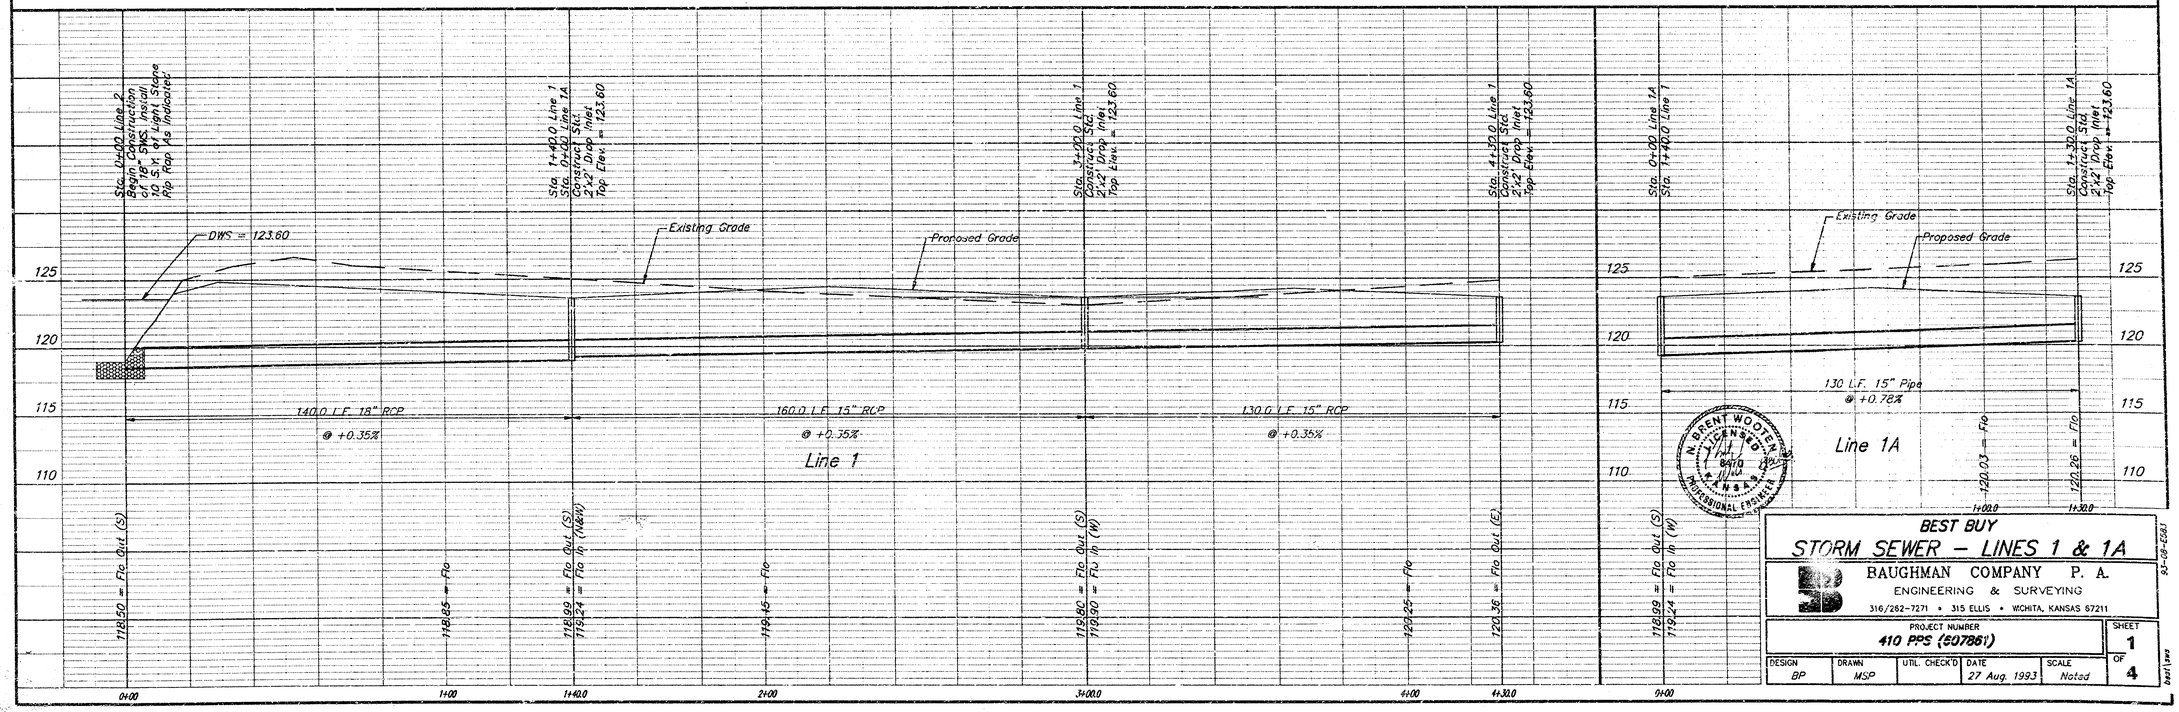

N. BRENT WOOTEN
LICENSED
11/14/94
KANSAS
PROFESSIONAL ENGINEER

BEST BUY
STORM SEWER – LINES 1 & 1A

BAUGHMAN COMPANY P. A.
ENGINEERING & SURVEYING
316/262-7271 • 315 ELLIS • WICHITA, KANSAS 67211

PROJECT NUMBER	SHEET
410 PPS (50786')	1 OF 4


DESIGN	DRAWN	UTIL. CHECK'D	DATE	SCALE
BP	MSP		27 Aug. 1993	Noted

93-09-E581
bestlaws


Benchmark

City of Wichita Benchmark Disc, Center of U.S. 54 Pavements and 44' West of Centerline of Dugan.
Elev. = 121.65 (City Datum)

"□" Cut Top of Curb on the East End of the Return at the S.E. Corner of Dugan and Taft.
Elev. = 118.61 (City Datum)

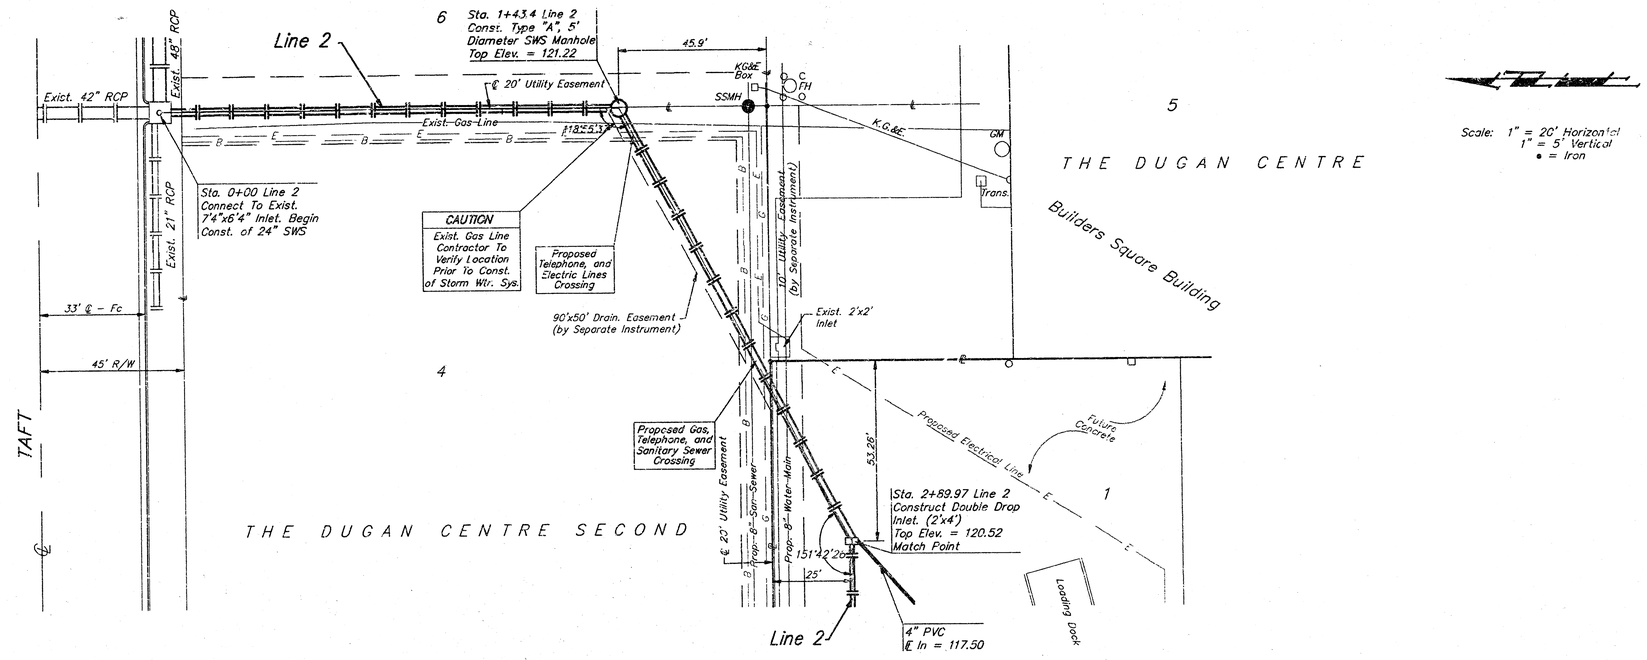

Scale: 1" = 20' Horizontal
1" = 5' Vertical
• = Iron

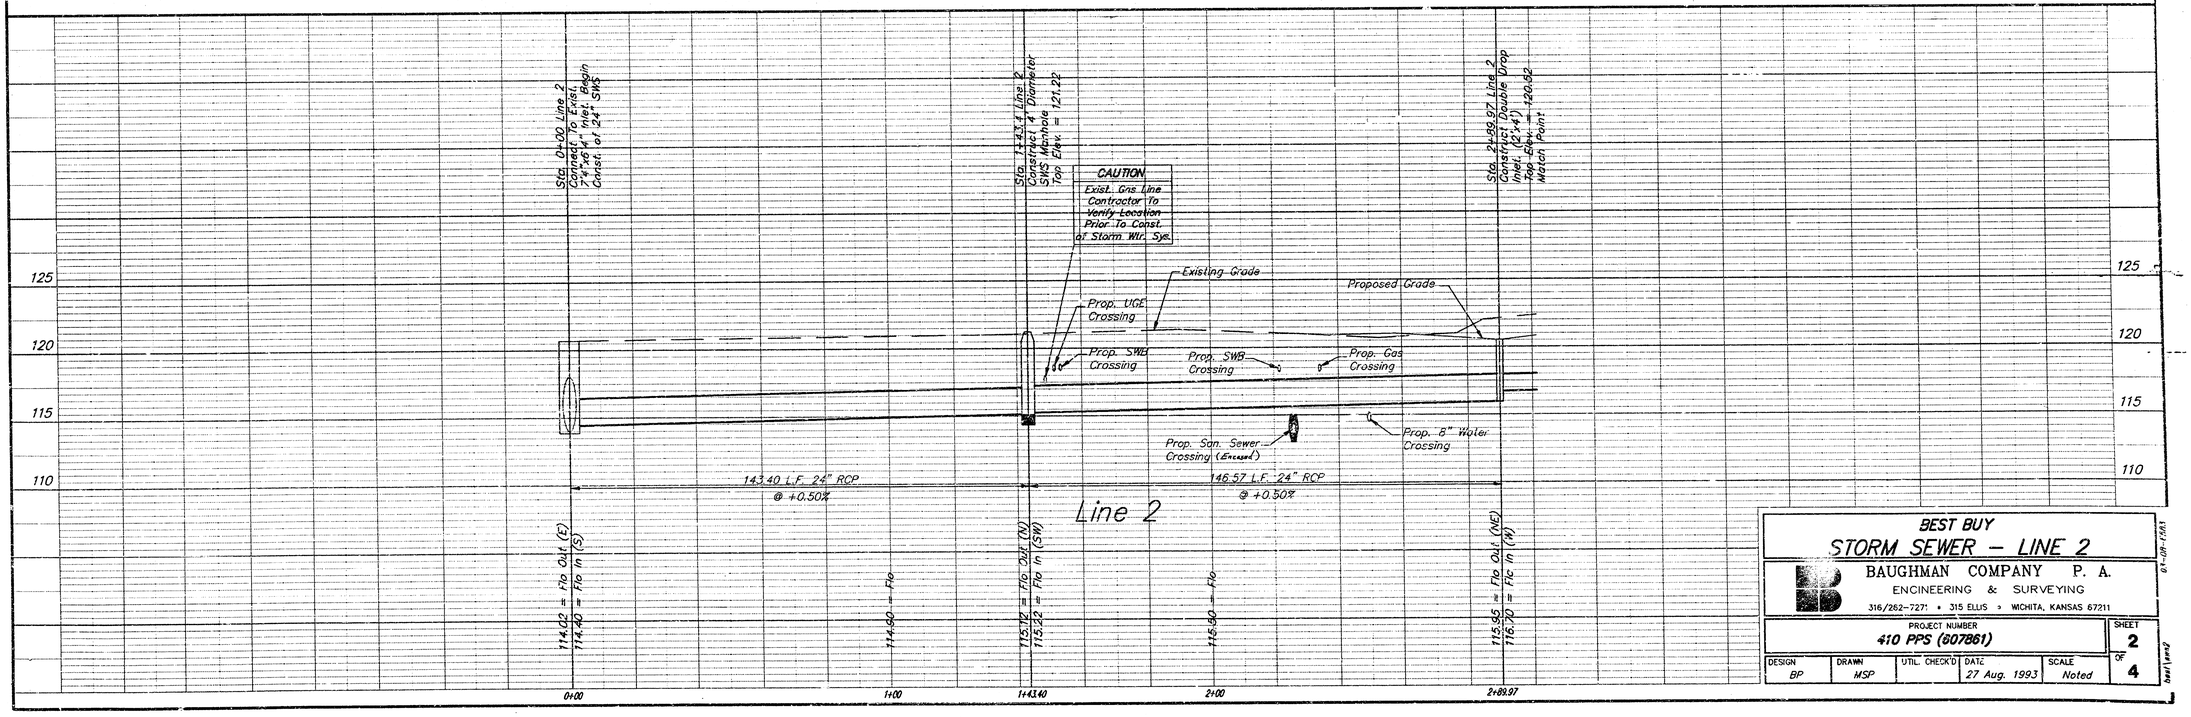

BEST BUY
STORM SEWER – LINE 2

BAUGHMAN COMPANY P. A.
ENGINEERING & SURVEYING
316/262-7271 • 315 ELLIS • WICHITA, KANSAS 67211

PROJECT NUMBER	SHEET
410 PPS (807861)	2 OF 4


DESIGN	DRAWN	UTIL. CHECK'D	DATE	SCALE
BP	MSP		27 Aug. 1993	Noted

01-09-1561


Benchmark

City of Wichita Benchmark Disc, Center of U.S. 54 Pavements and 44' West of Centerline of Dugan.
Elev. = 121.65 (City Datum)

"□" Cut Top of Curb on the East End of the Return at the S.E. Corner of Dugan and Toft.
Elev. = 118.61 (City Datum)

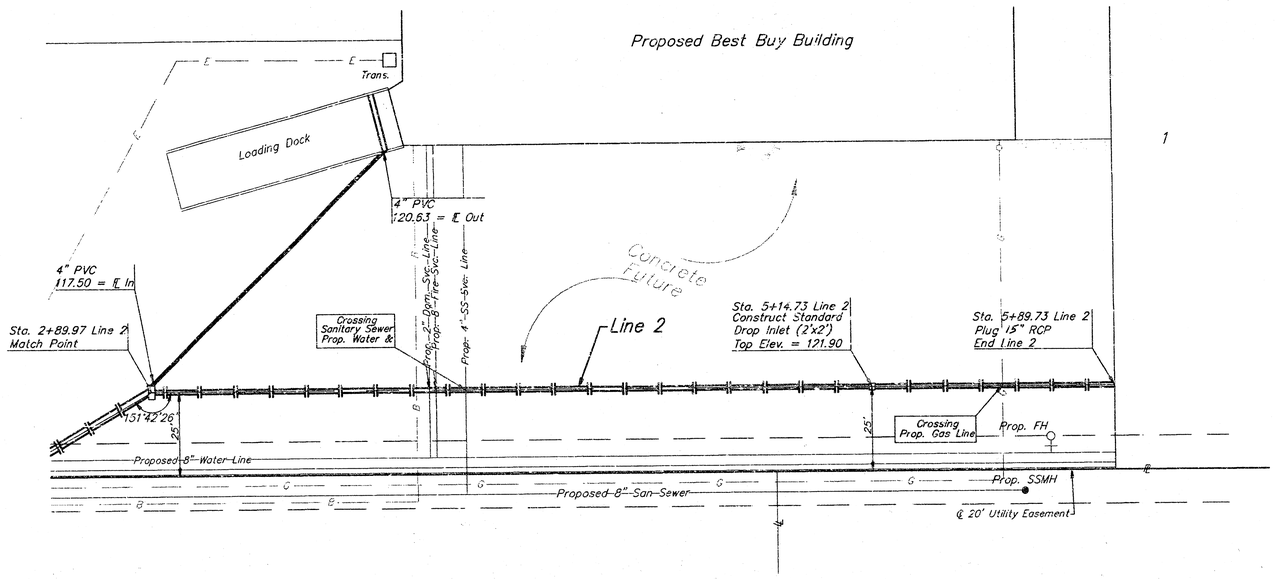

Scale: 1" = 20' Horizontal
1" = 5' Vertical
• = Iron

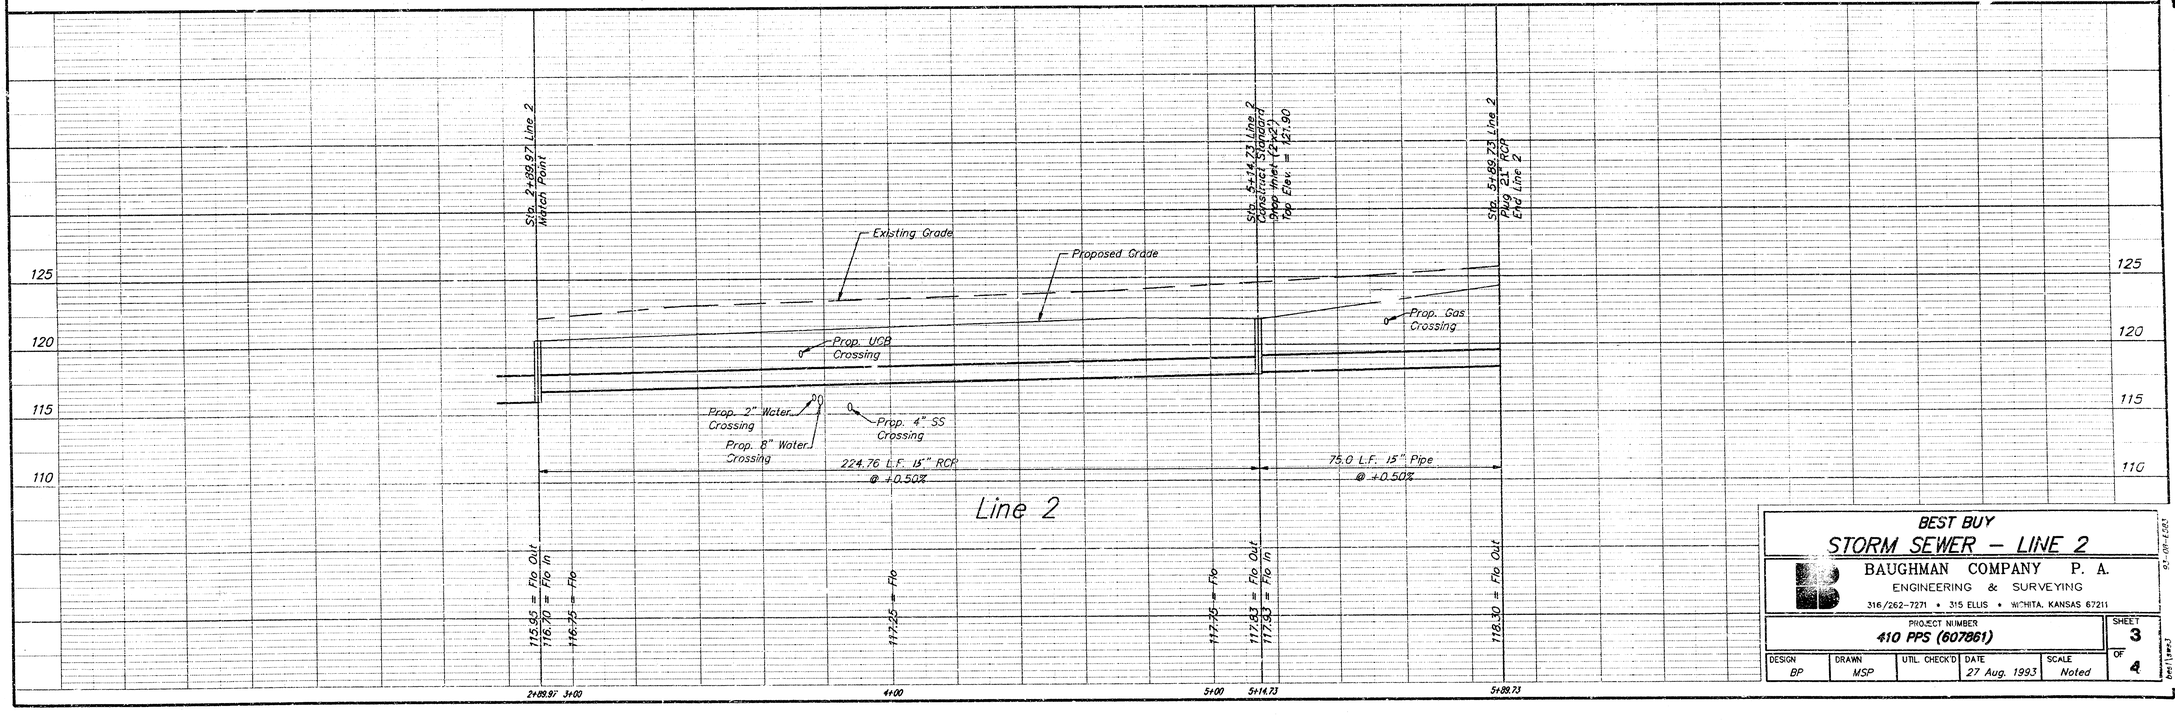



BEST BUY
STORM SEWER – LINE 2


BAUGHMAN COMPANY P. A.
ENGINEERING & SURVEYING
316/262-7271 • 315 ELLIS • WICHITA, KANSAS 67211

PROJECT NUMBER	SHEET
410 PPS (607861)	3 OF 4


DESIGN	DRAWN	UTIL. CHECK'D	DATE	SCALE
BP	MSP		27 Aug. 1993	Noted

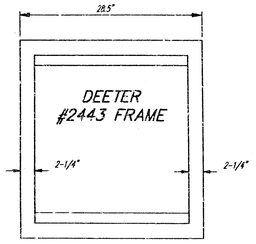

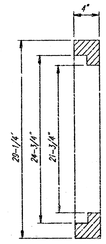

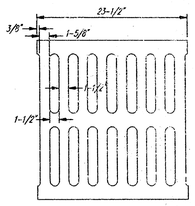



DEETER #2433 GRATE

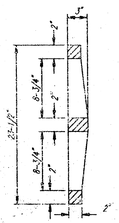


NOTE: Grates shall be imprinted on the top surface with "CITY OF WICHITA" using letters at least 1" in height. Other marking methods may be approved by the engineer.


24" x 24" Frame and Grate Detail

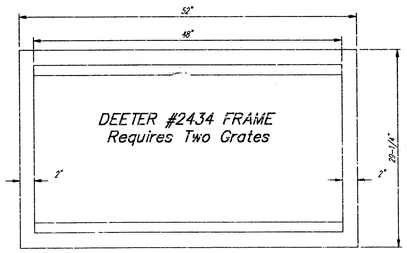


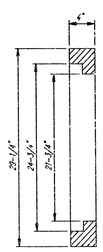

Double 24" x 24" Frame Detail

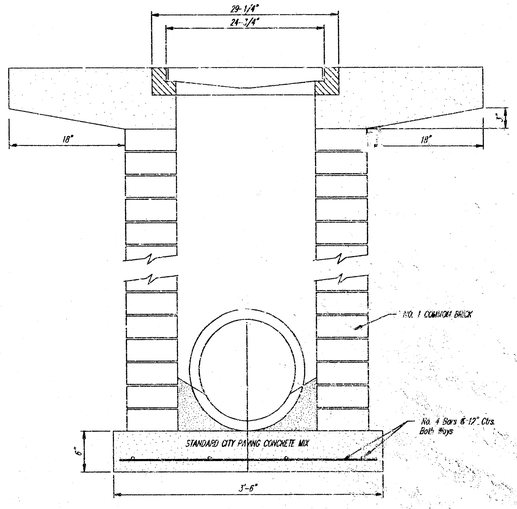

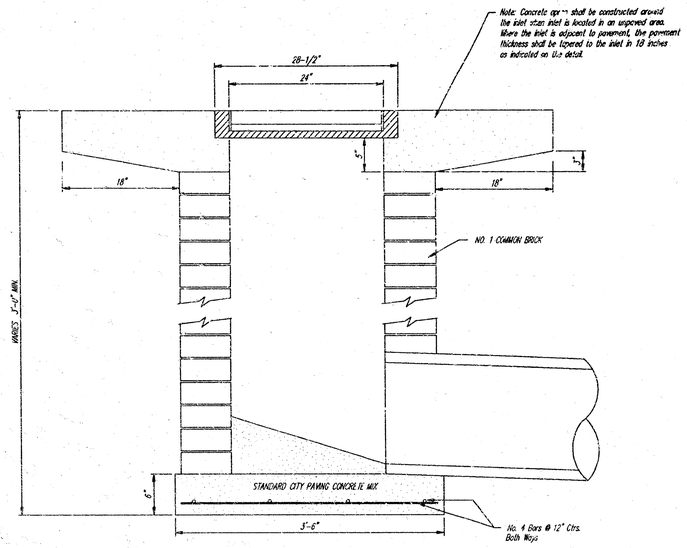

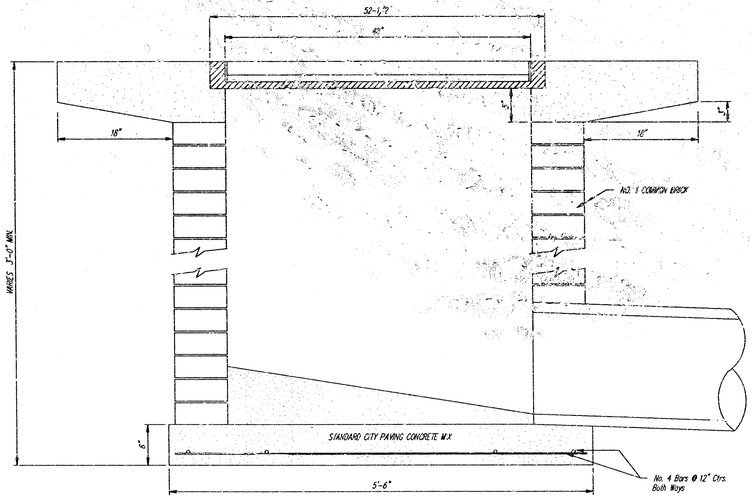

DROP INLET DETAILS


M.E. Lindebak, City Engineer
City of Wichita, Kansas

Project Number	4
410 PPS (607861)	4

Benchmark

City of Wichita Benchmark Disc, Center of U.S. 54 Pavements and 44' West of Centerline of Dugan.
Elev. = 121.65 (City Datum)

"□" Cut Top of Curb on the East End of the Return at the S.E. Corner of Dugan and Taft.
Elev. = 118.61 (City Datum)

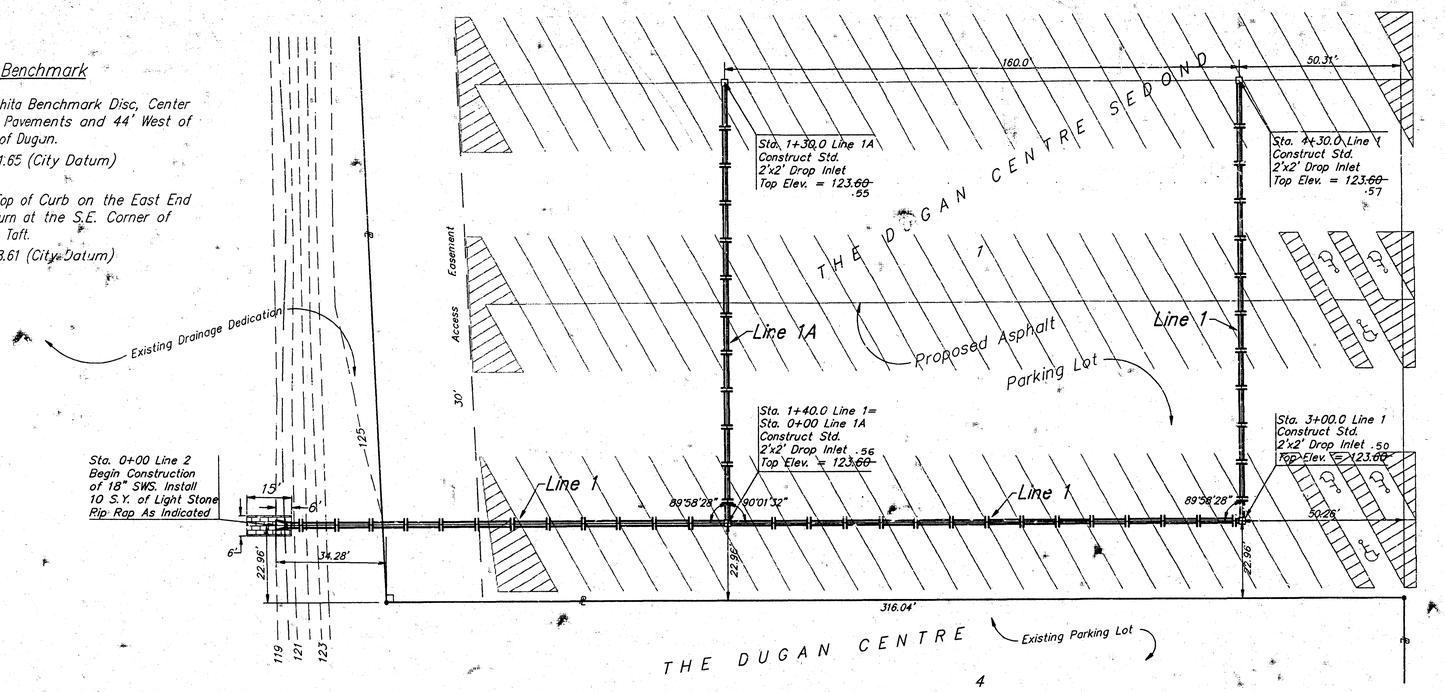

Scale: 1" = 20' Horizontal
1" = 5' Vertical
• = Iron


PROPOSED
BEST BUY
BUILDING

APPROVED AS NOTED
BY CITY ENGINEER OF WICHITA

Sanitary Sewers _____
Storm Sewers 8/30/93 VRH
Driveway Approaches _____
Water Mains _____
Paving _____

NOTE TO CONTRACTORS

Inspection and testing of this project is to be provided by a Licensed Consulting Engineering Firm under contract with the Owner/Developer. Said inspection to be in accordance with the City of Wichita standard construction engineering practices and certified by a Licensed Professional Engineer. No work shall be performed in dedicated easements or public right-of-way by the Contractor without such inspection nor shall any work be commenced without written authorization by the City Engineer.

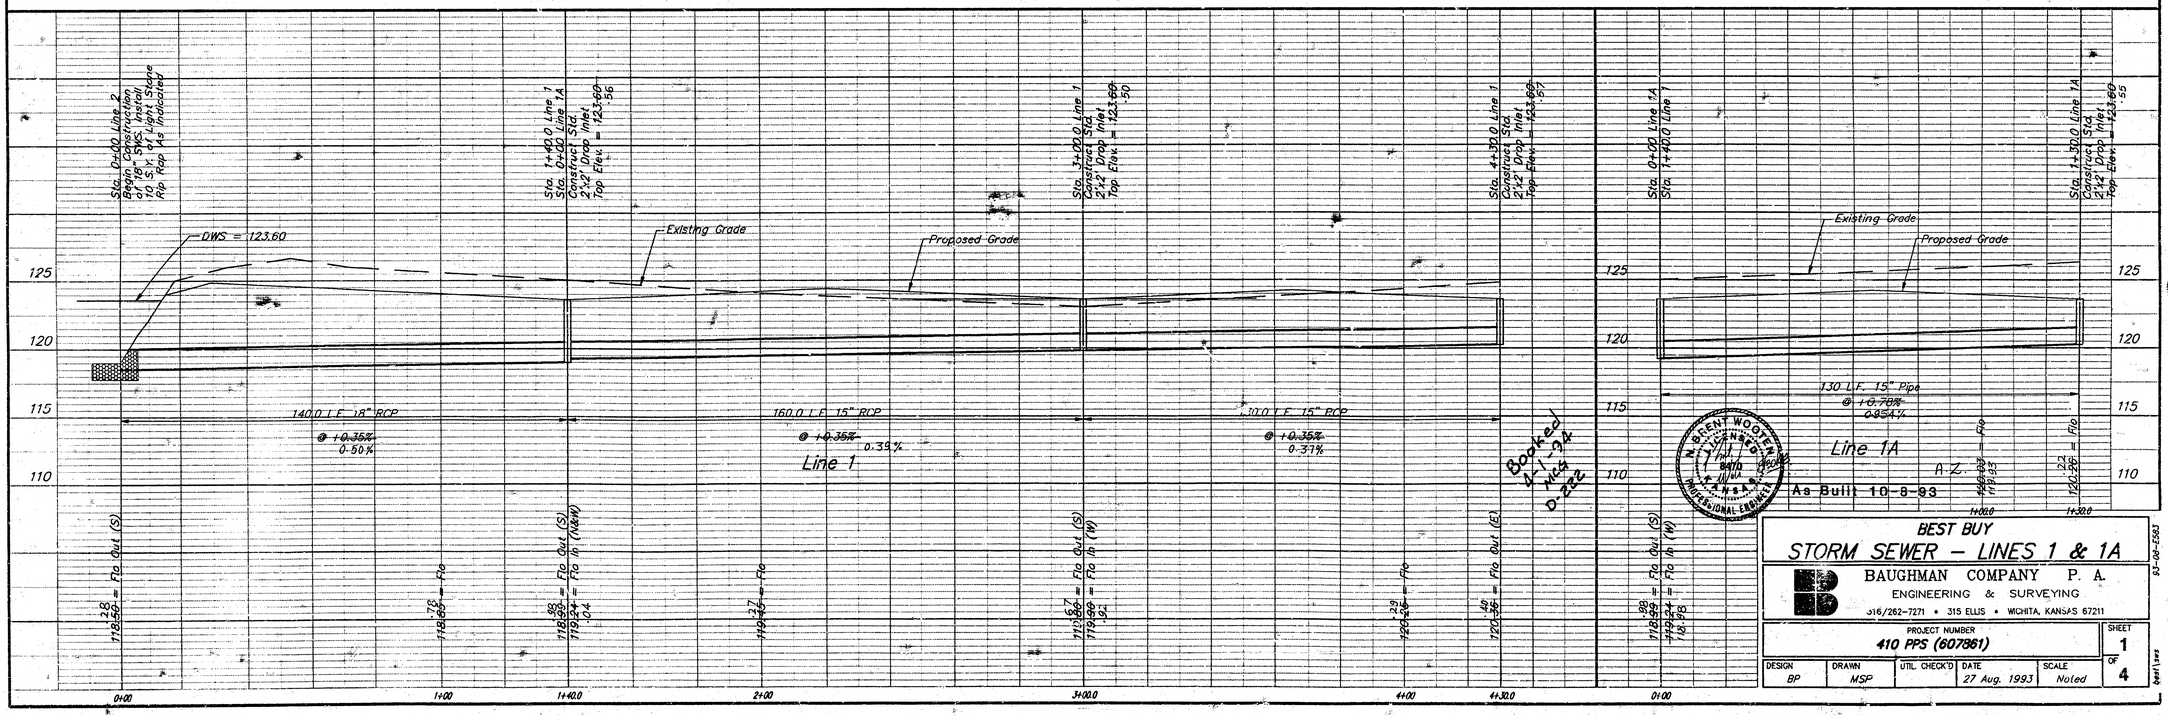

N. BRENT WOOTEN
LICENSED
No. 8470
PROFESSIONAL ENGINEER

BEST BUY
STORM SEWER – LINES 1 & 1A

BAUGHMAN COMPANY P. A.
ENGINEERING & SURVEYING
316/262-7271 • 315 ELLIS • WICHITA, KANSAS 67211

PROJECT NUMBER					SHEET
410 PPS (607861)					1 OF 4
DESIGN	DRAWN	UTIL. CHECK'D	DATE	SCALE	
BP	MSP		27 Aug. 1993	Noted	


93-08-E583

dwg\1.wrs


Benchmark

City of Wichita Benchmark Disc, Center of U.S. 54 Pavements and 44' West of Centerline of Dugan.
Elev. = 121.65 (City Datum)

"□" Cut Top of Curb on the East End of the Return at the S.E. Corner of Dugan and Taft.
Elev. = 118.61 (City Datum)

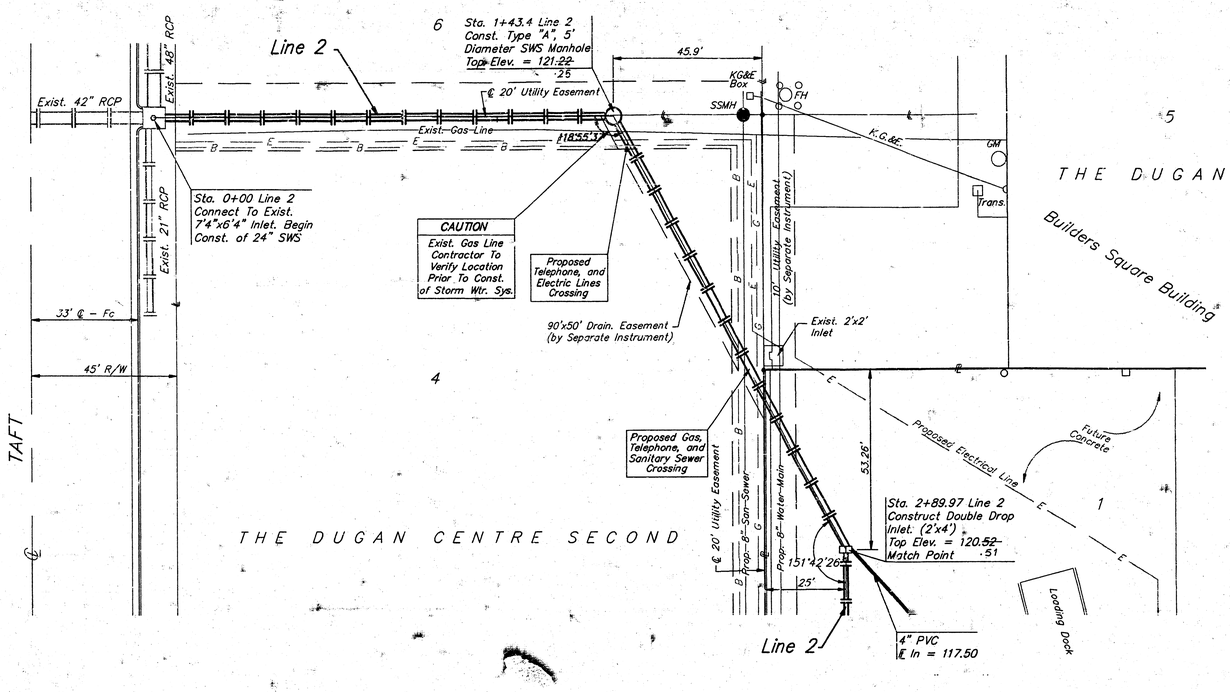

Scale: 1" = 20' Horizontal
1" = 5' Vertical
• = Iron

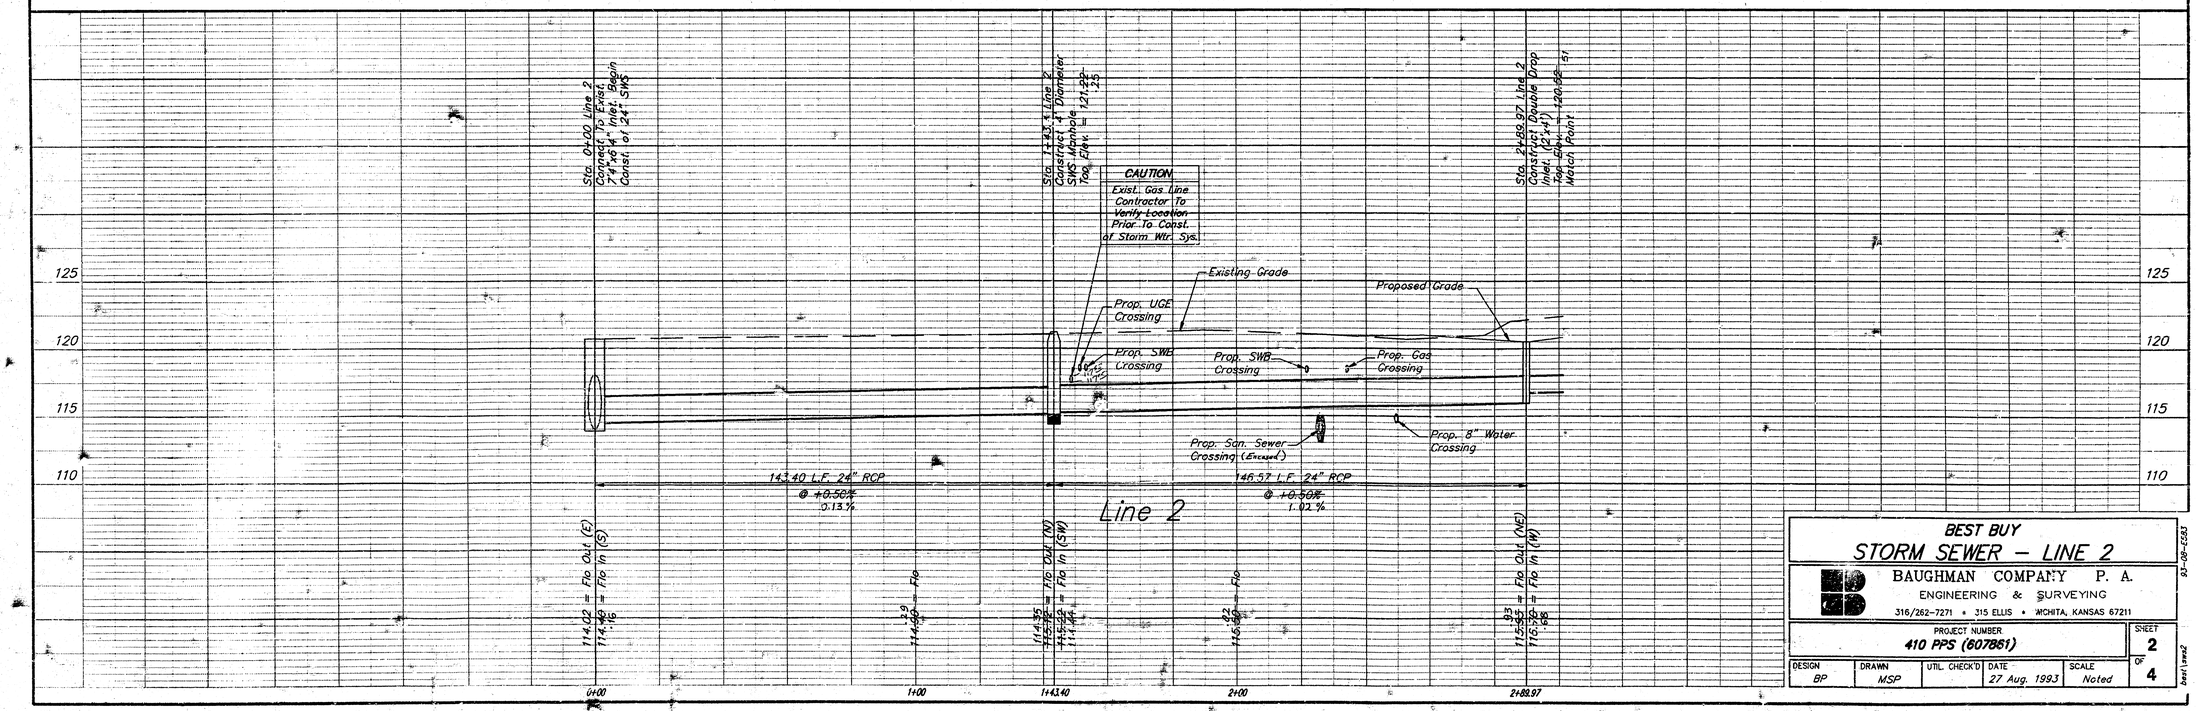

BEST BUY
STORM SEWER – LINE 2

BAUGHMAN COMPANY P. A.
ENGINEERING & SURVEYING
316/262-7271 • 315 ELLIS • WICHITA, KANSAS 67211

PROJECT NUMBER 410 PPS (607881)

SHEET 2 OF 4


DESIGN	DRAWN	UTIL. CHECK'D	DATE	SCALE
BP	MSP		27 Aug. 1993	Noted

93-08-E585
Sheet 2 of 4

Benchmark


City of Wichita Benchmark Disc, Center of U.S. 54 Pavements and 44' West of Centerline of Dugan.
Elev. = 121.65 (City Datum)

"□" Cut Top of Curb on the East End of the Return at the S.E. Corner of Dugan and Taft.
Elev. = 118.61 (City Datum)

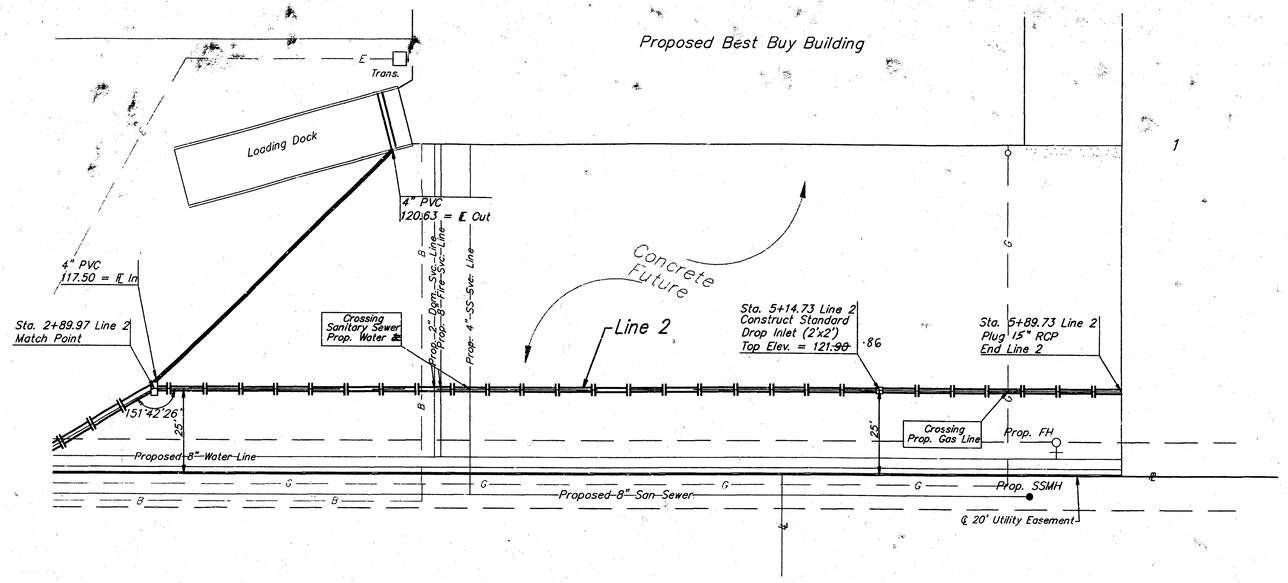

Scale: 1" = 20' Horizontal
1" = 5' Vertical
• = Iron

THE DUGAN CENTRE SECOND

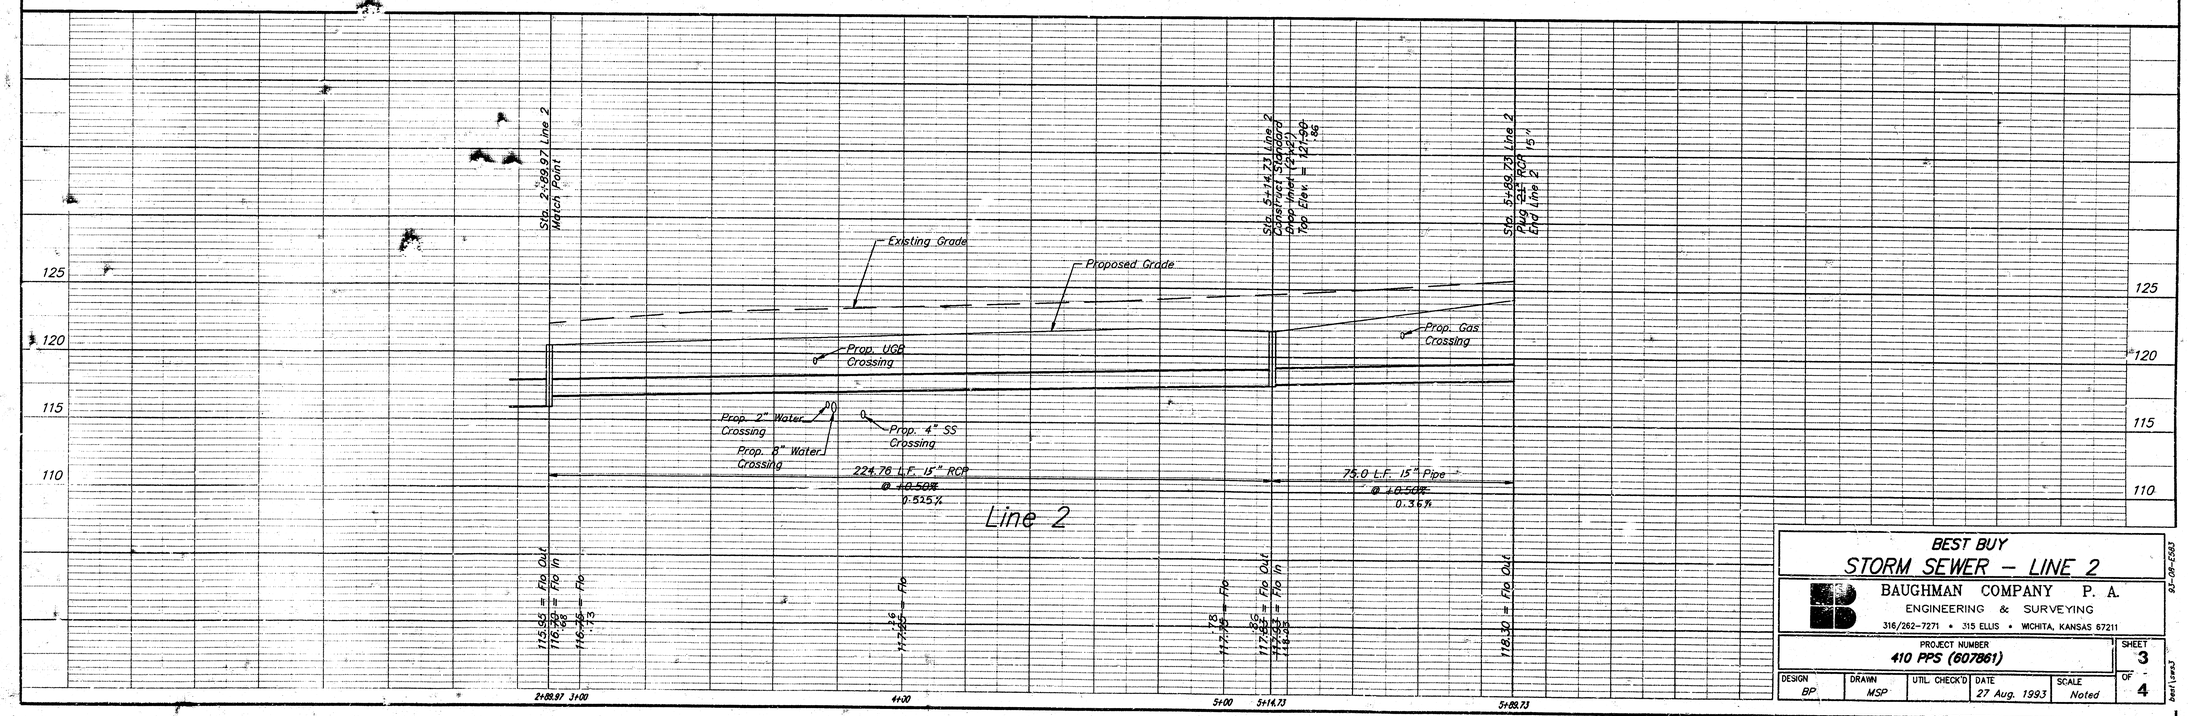

BEST BUY	
STORM SEWER – LINE 2	
BAUGHMAN COMPANY P. A.	
ENGINEERING & SURVEYING	
316/262-7271 • 315 ELLIS • WICHITA, KANSAS 67211	
PROJECT NUMBER 410 PPS (607861)	SHEET 3 OF 4
DESIGN BP / DRAWN MSP / UTIL. CHECK'D / DATE 27 Aug. 1993 / SCALE Noted	

bestline3