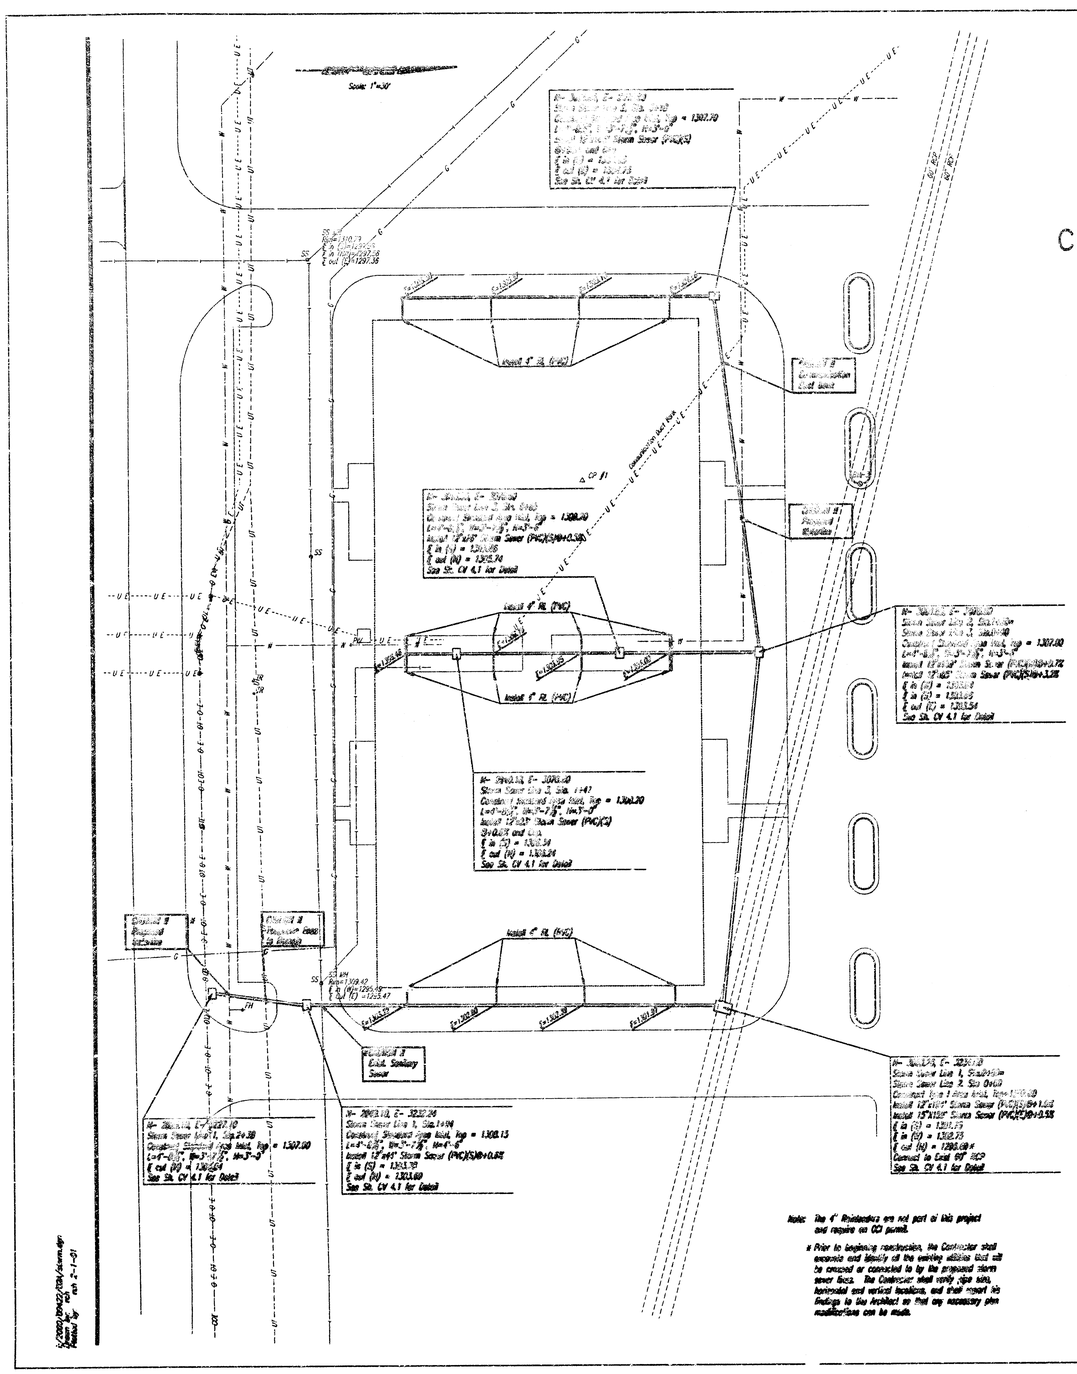

CONSTRUCTION PLANS FOR

STORM WATER SEWER
CESSNA AIRCRAFT COMPLETION CENTER
2617 SOUTH HOOVER ROAD

THE CITY OF WICHITA, KANSAS

MICHAEL E. LINDEBAK, P.E. - CITY ENGINEER

1098 PPS (607861)

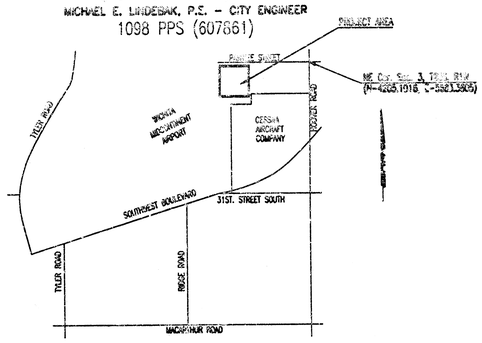

LOCATION MAP

HORIZONTAL CONTROL POINT NO. 1
N-3,000.0000, E-1,000.0000, 1/2" IRON BAR
HORIZONTAL CONTROL POINT NO. 2
N-4,000.3700, E-1,000.0000, 1/2" IRON BAR

BENCH MARK:
CITY OF WICHITA DISK
SE CORNERNAT OF INTERSECTION
OF PARNELL AND HOOVER
CENTER OF INTERSECTION
ELEVATION: 1295.56 (NAVD29)

RECORD DRAWING
13 APRIL 2001

Booked
E-9
12/31/03
RDL

APPROVED AS NOTED
By CITY ENGINEER OF WICHITA

Storm Sewers 3/21/01

INSPECTION AND TESTING FOR THIS PROJECT IS TO BE PROVIDED BY A LICENSED CONSULTING ENGINEERING FIRM CONTRACTED BY THE OWNER/DEVELOPER. SAID INSPECTION TO BE IN ACCORDANCE WITH THE CITY OF WICHITA STANDARD CONSTRUCTION ENGINEERING PRACTICES AND CERTIFIED BY A LICENSED PROFESSIONAL ENGINEER. NO WORK SHALL BE PERFORMED IN DEDICATED EASEMENTS OR THE PUBLIC RIGHT-OF-WAY BY THE CONTRACTOR WITHOUT SUCH INSPECTION NOR SHALL ANY WORK BE COMMENCED IN DEDICATED EASEMENTS OR PUBLIC RIGHT-OF-WAY WITHOUT WRITTEN AUTHORIZATION BY THE CITY ENGINEER.

MCCLOUGHAN WATKINS & FERRARI

CESSNA AIRCRAFT COMPANY
SITE FOR MODULAR OFFICE UNITS
MID-CONTINENT FACILITY
WICHITA, KANSAS

Cessna
A Textron Company

Ryan C. Thomas
3-19-01

PROJECT NO. 20008
DATE FEB 2, 2001
DRAWN

STORM SEWER PLAN

CV1.3