

7


DEPARTMENT OF ENGINEERING

MSA

DATE _____

PROJECT NO. 468-76-245-80172-000-000-000



1. CONTRACTOR SHALL BE RESPONSIBLE FOR OBTAINING HIGHWAY PERMIT FROM KANSAS TURNPIKE AUTHORITY FOR CONSTRUCTION WITHIN K.T.A. RIGHT-OF-WAY.
2. FIELD ENGINEER SHALL TAKE CROSS-SECTIONS BEFORE AND AFTER CONSTRUCTION. THESE SECTIONS WILL BE USED TO DETERMINE FINAL PAY QUANTITIES FOR EARTHWORK.

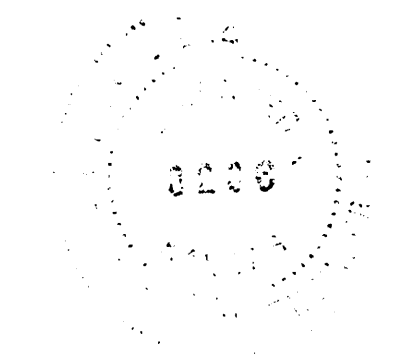


SHEET $\frac{1}{19}$ OF 13



FILMED FROM THE BEST
AVAILABLE COPY

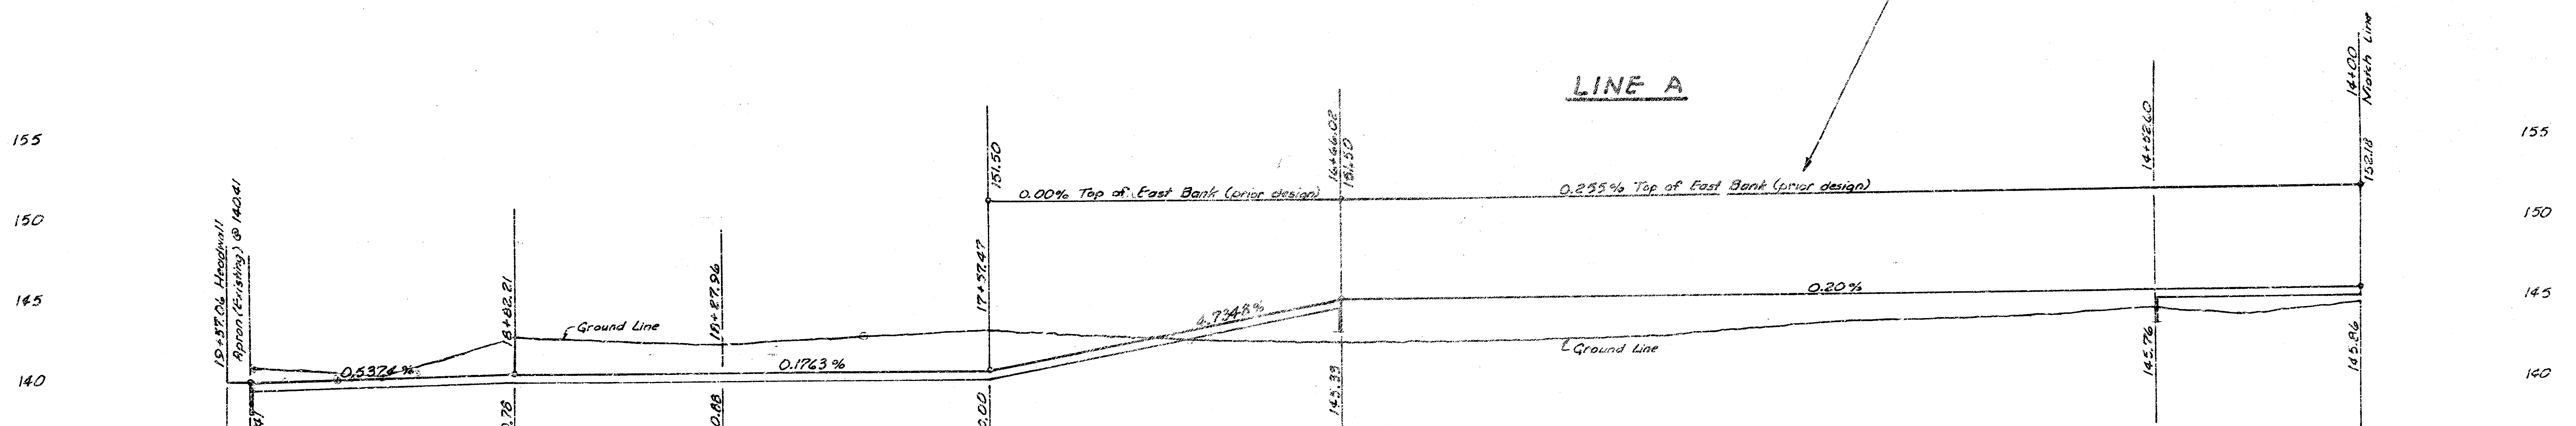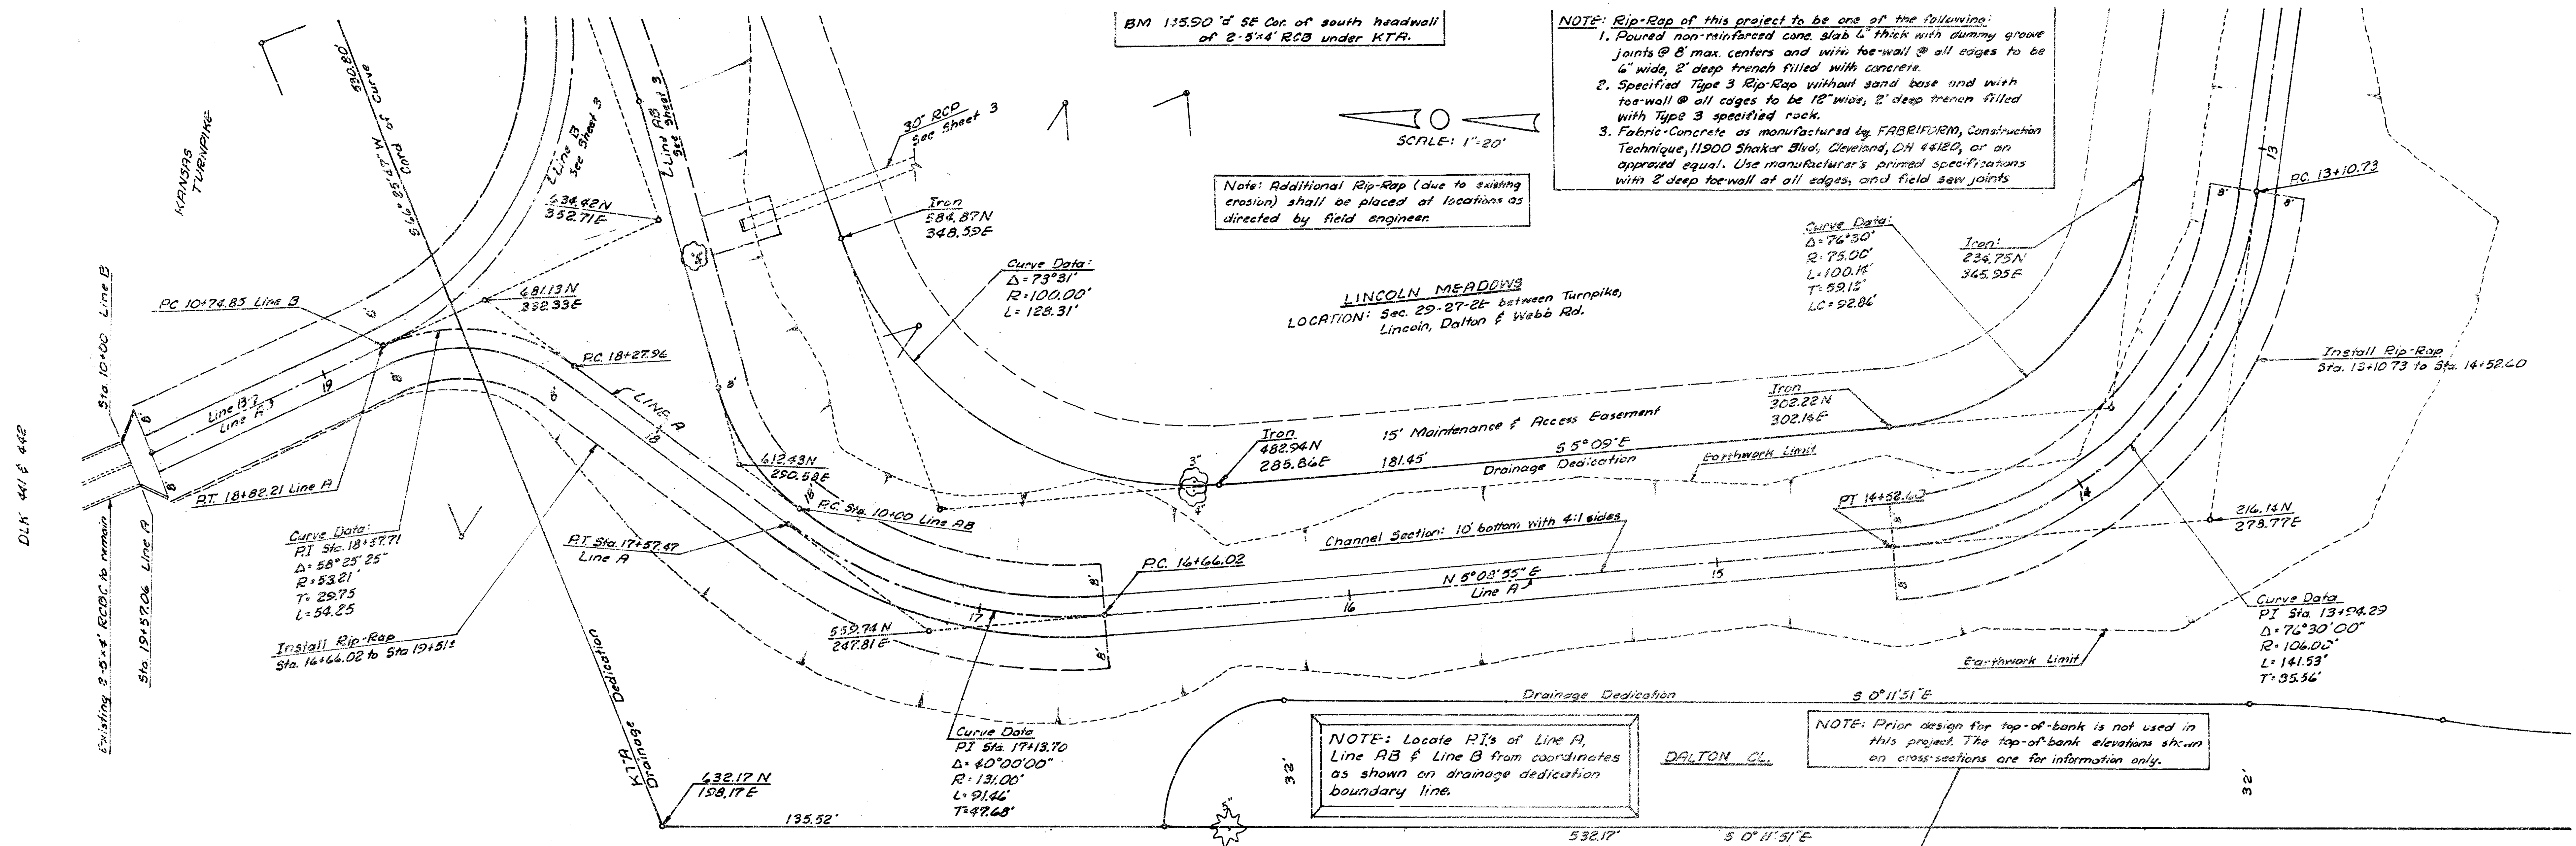

SWD #21
 DEPARTMENT OF ENGINEERING
 CITY OF WICHITA, KANSAS
 R.W. BRUSSEMAN, DIRECTOR OF ENGINEERING/CITY ENGINEER
 DATE: _____
 PROJECT NO. 468-76-245-80172-000-000-000

LINE A
 Sheet 19/13
 SWD #21

FILMED FROM THE BEST
 AVAILABLE COPY

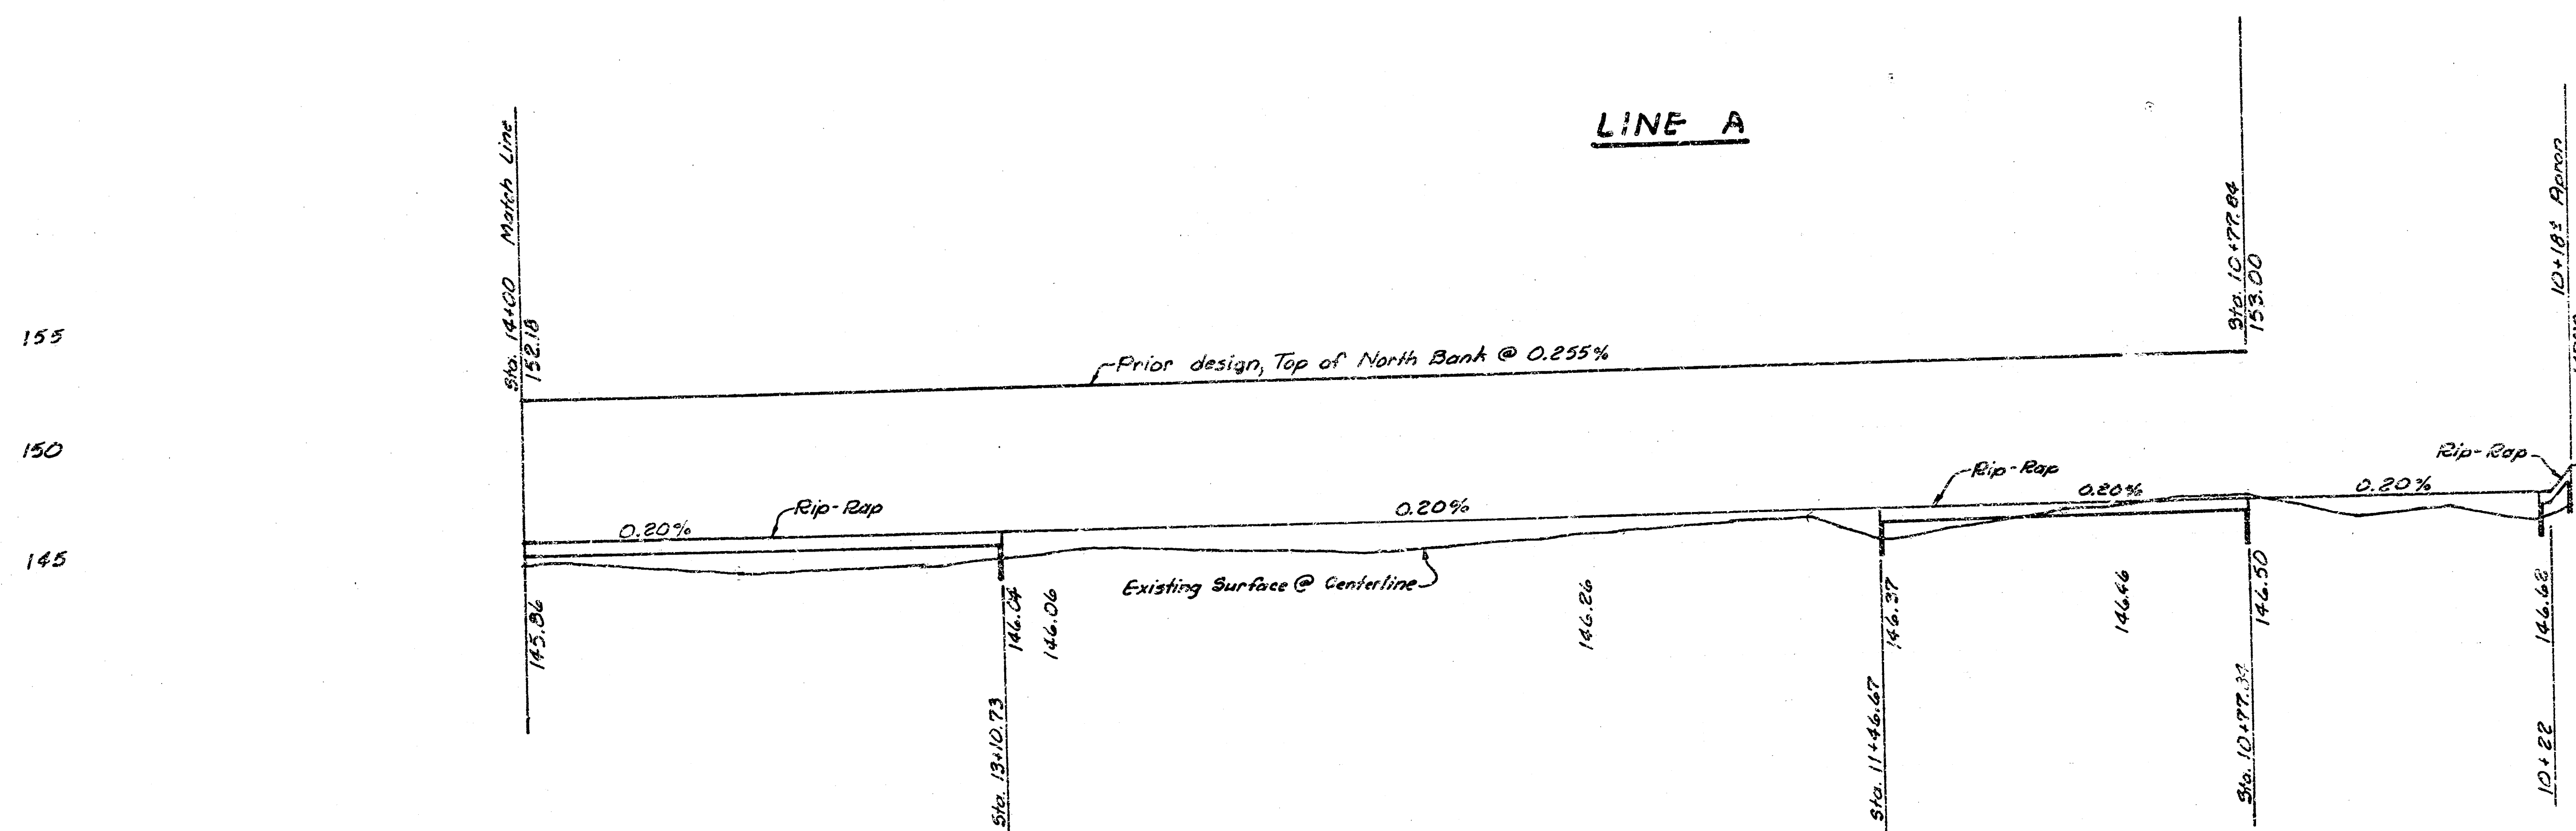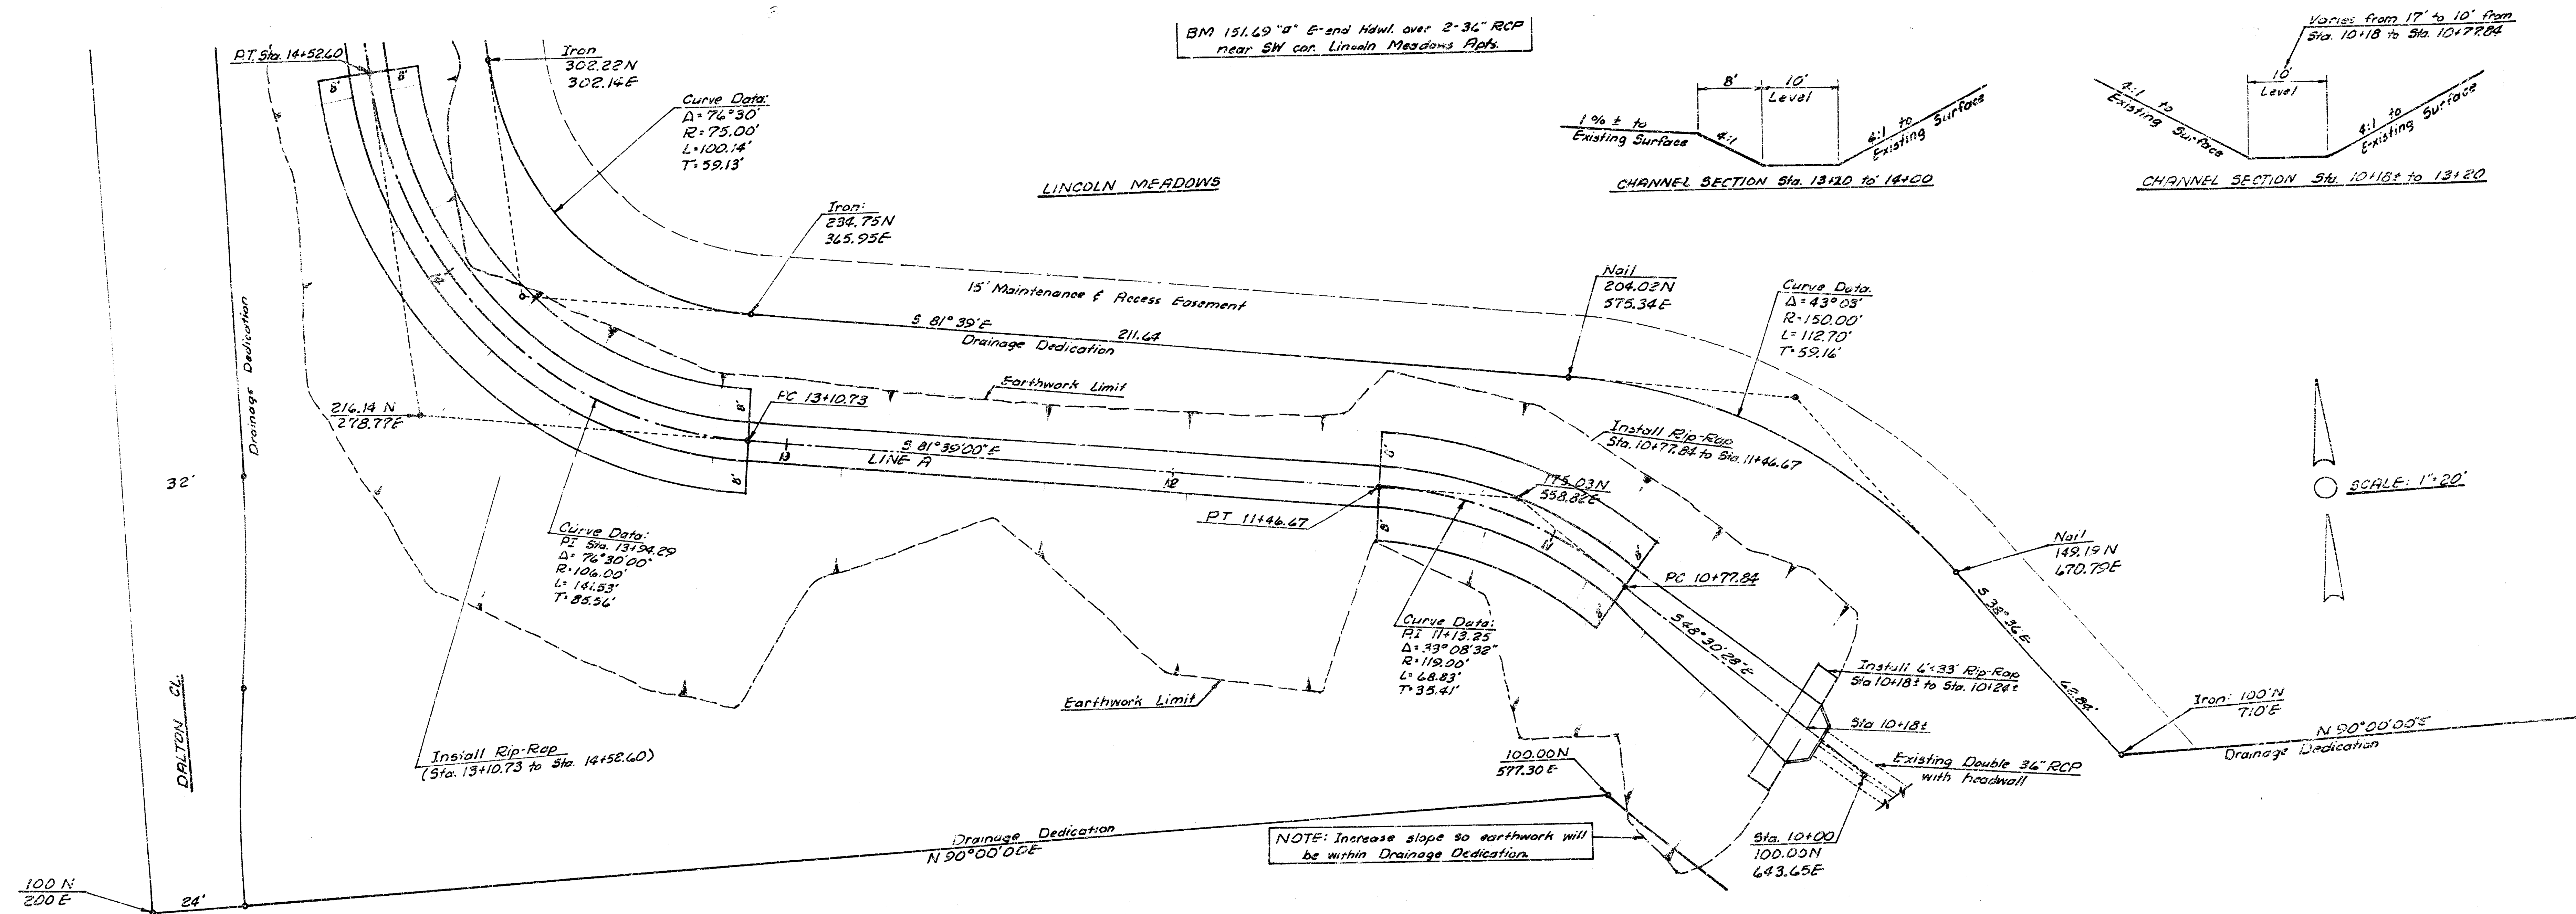


LINE A

SWD #21

Sheet 2/13



FILMED FROM THE BEST AVAILABLE COPY

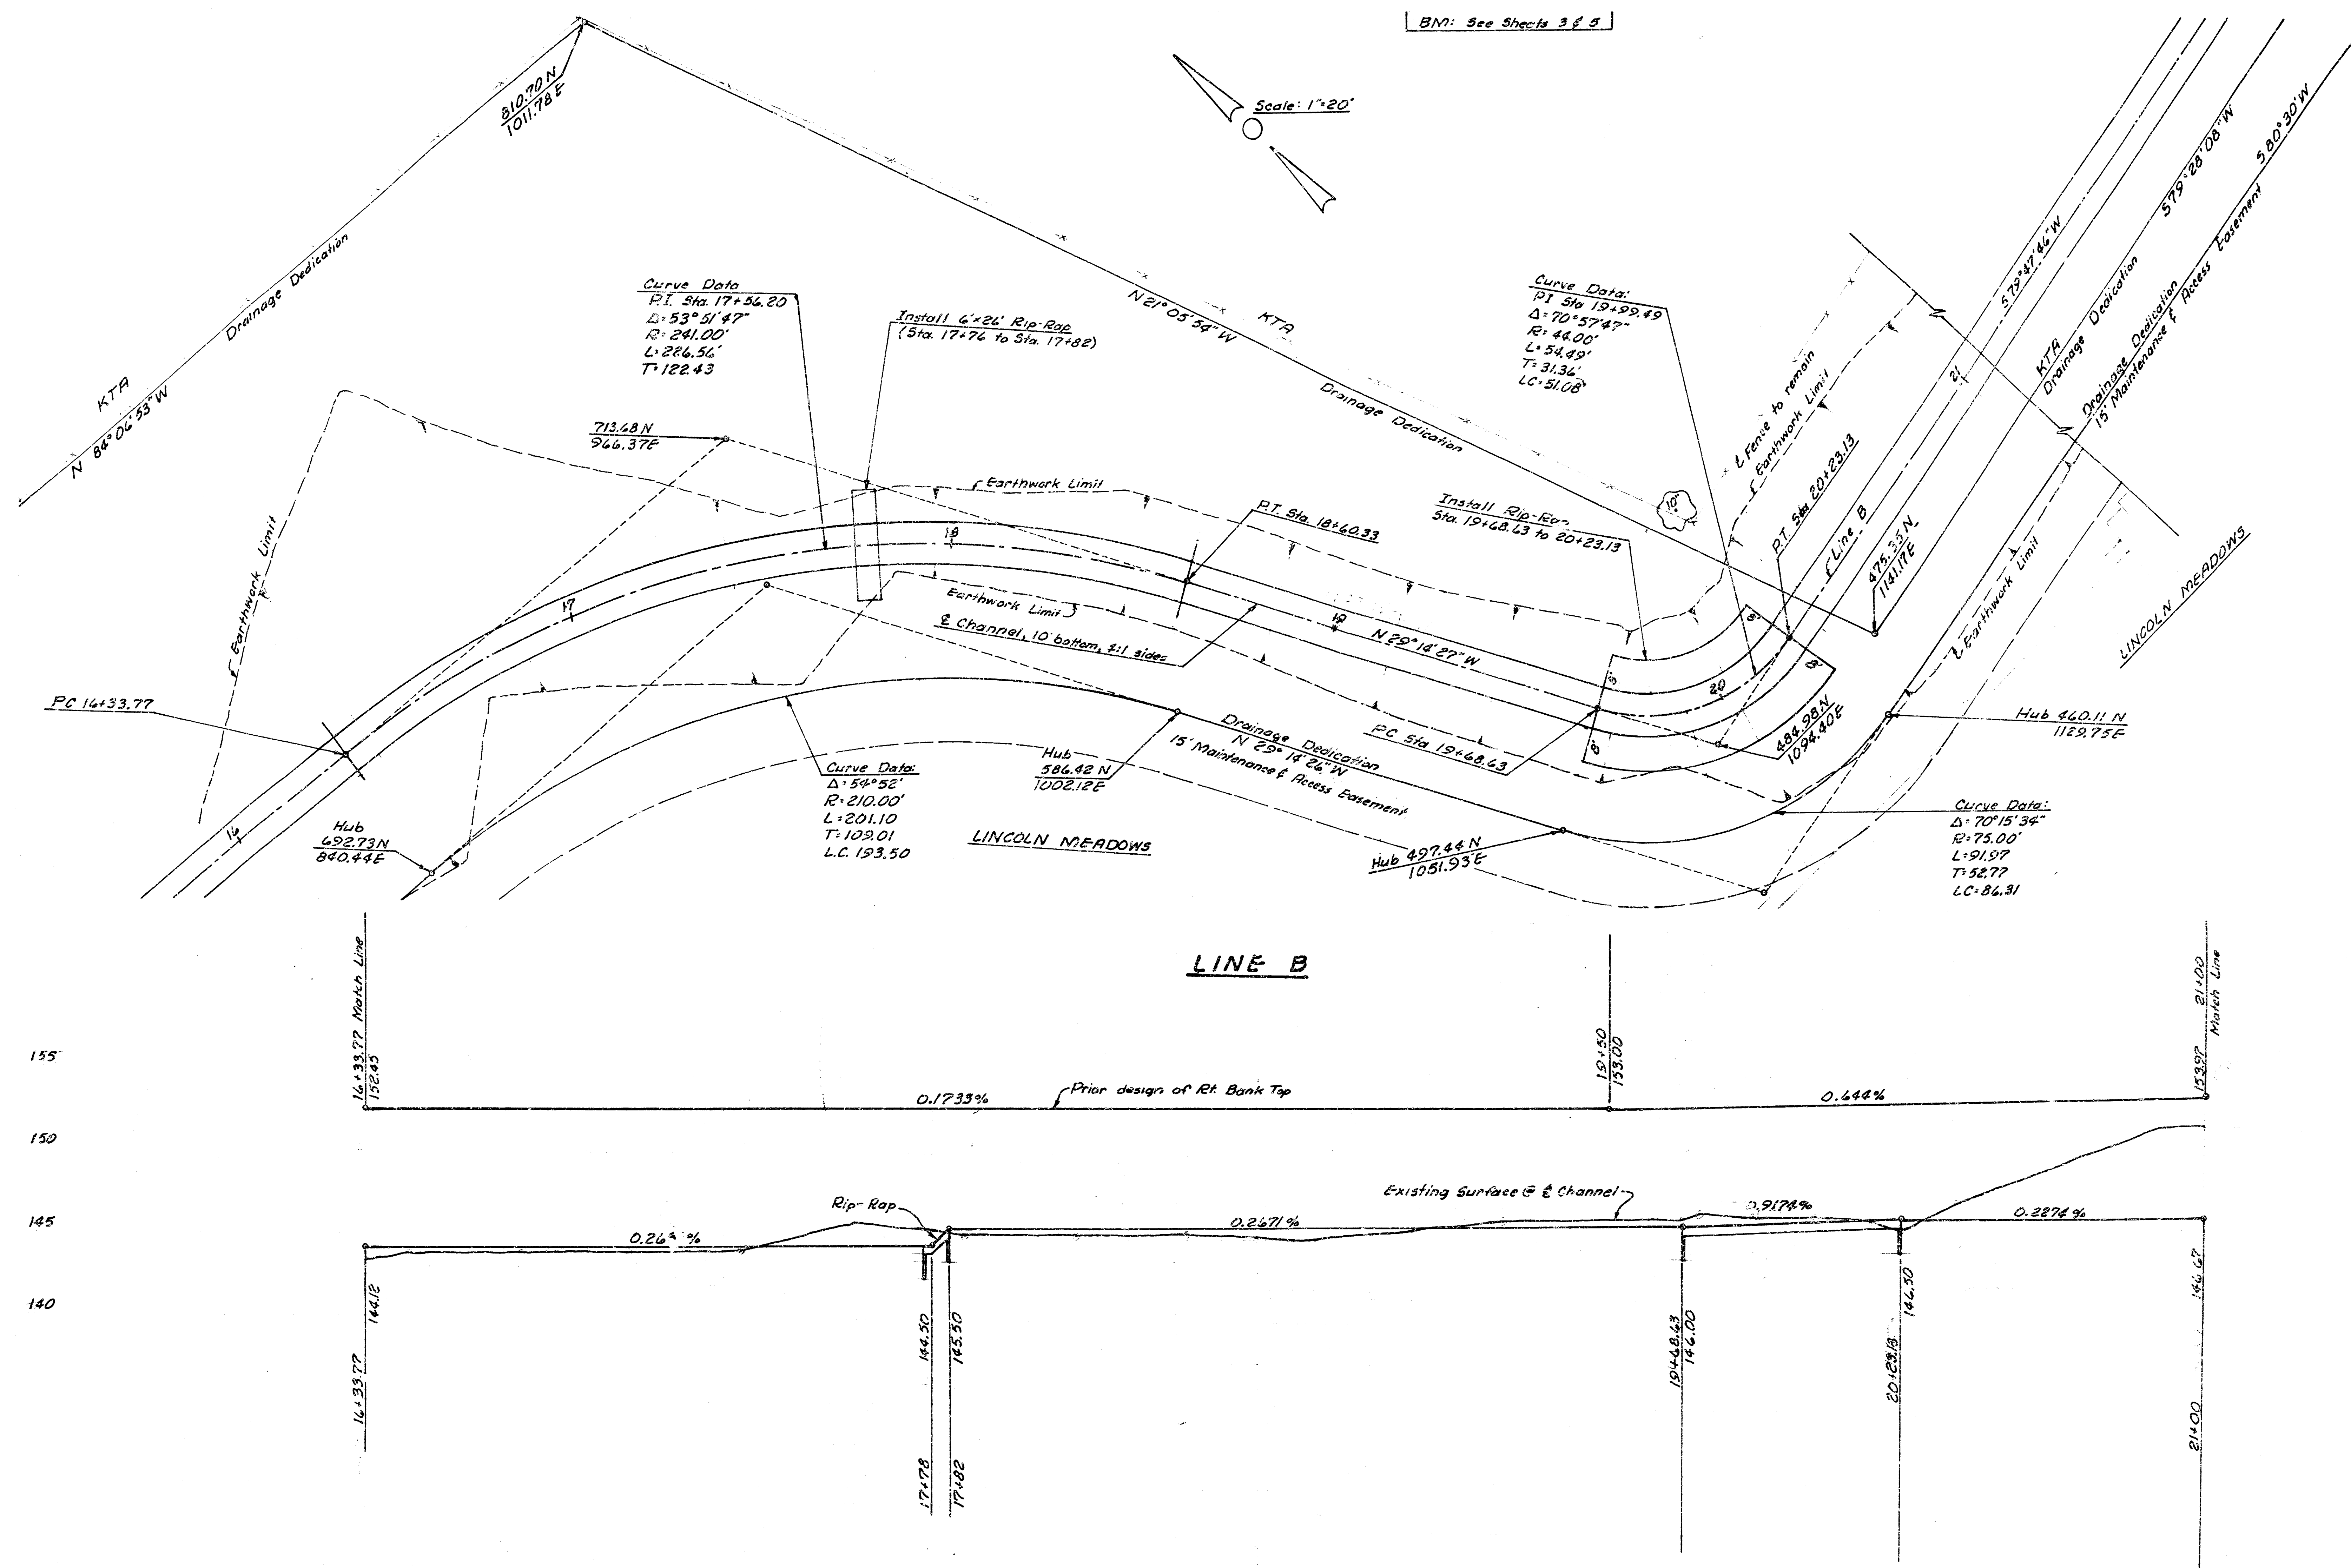


LINE B

SWD #21

Sheet 4 of 9

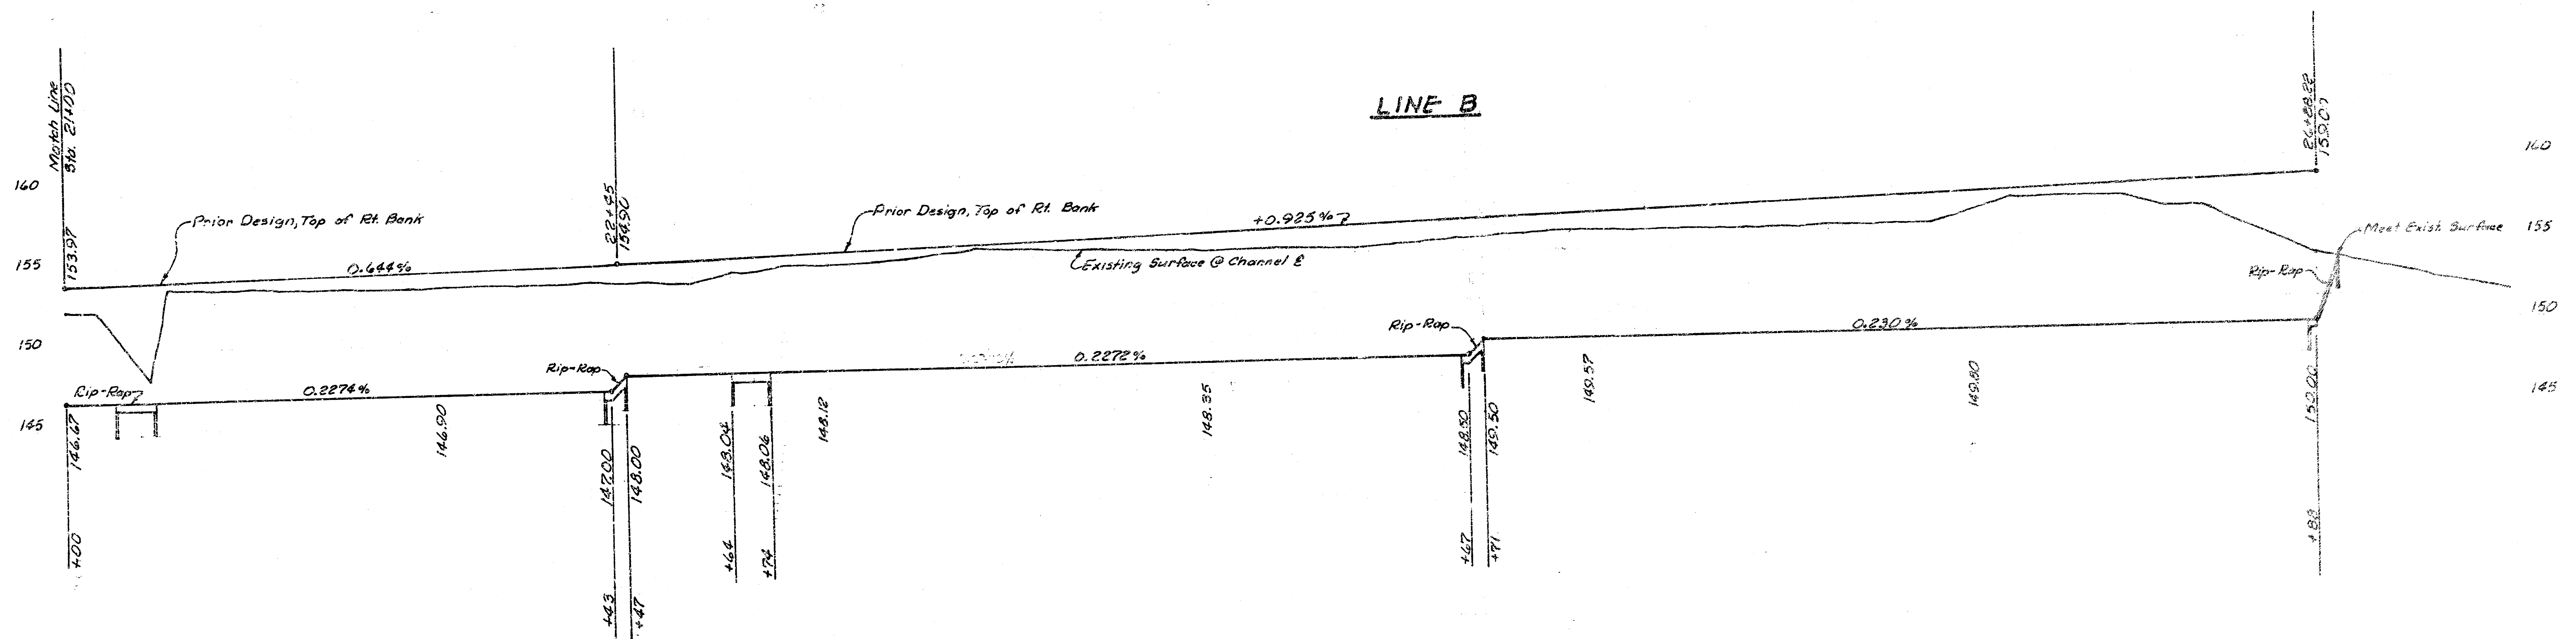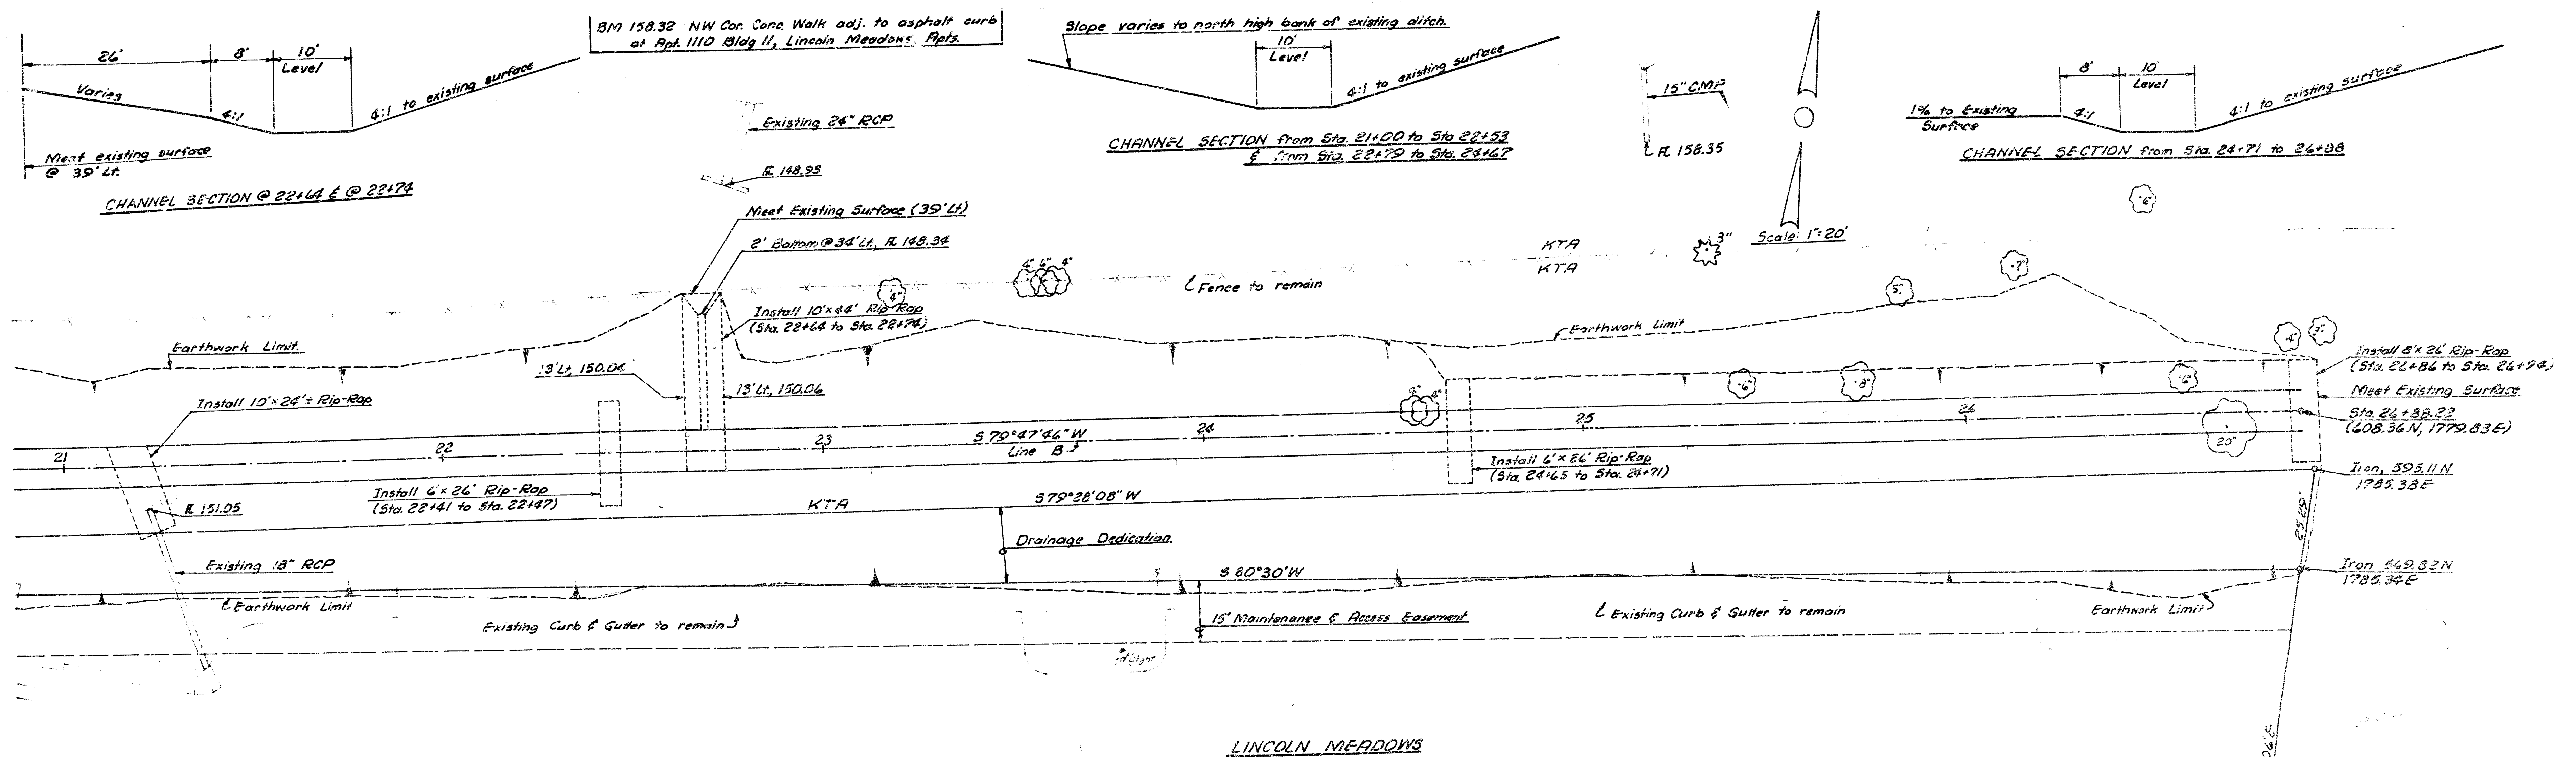

LINE B

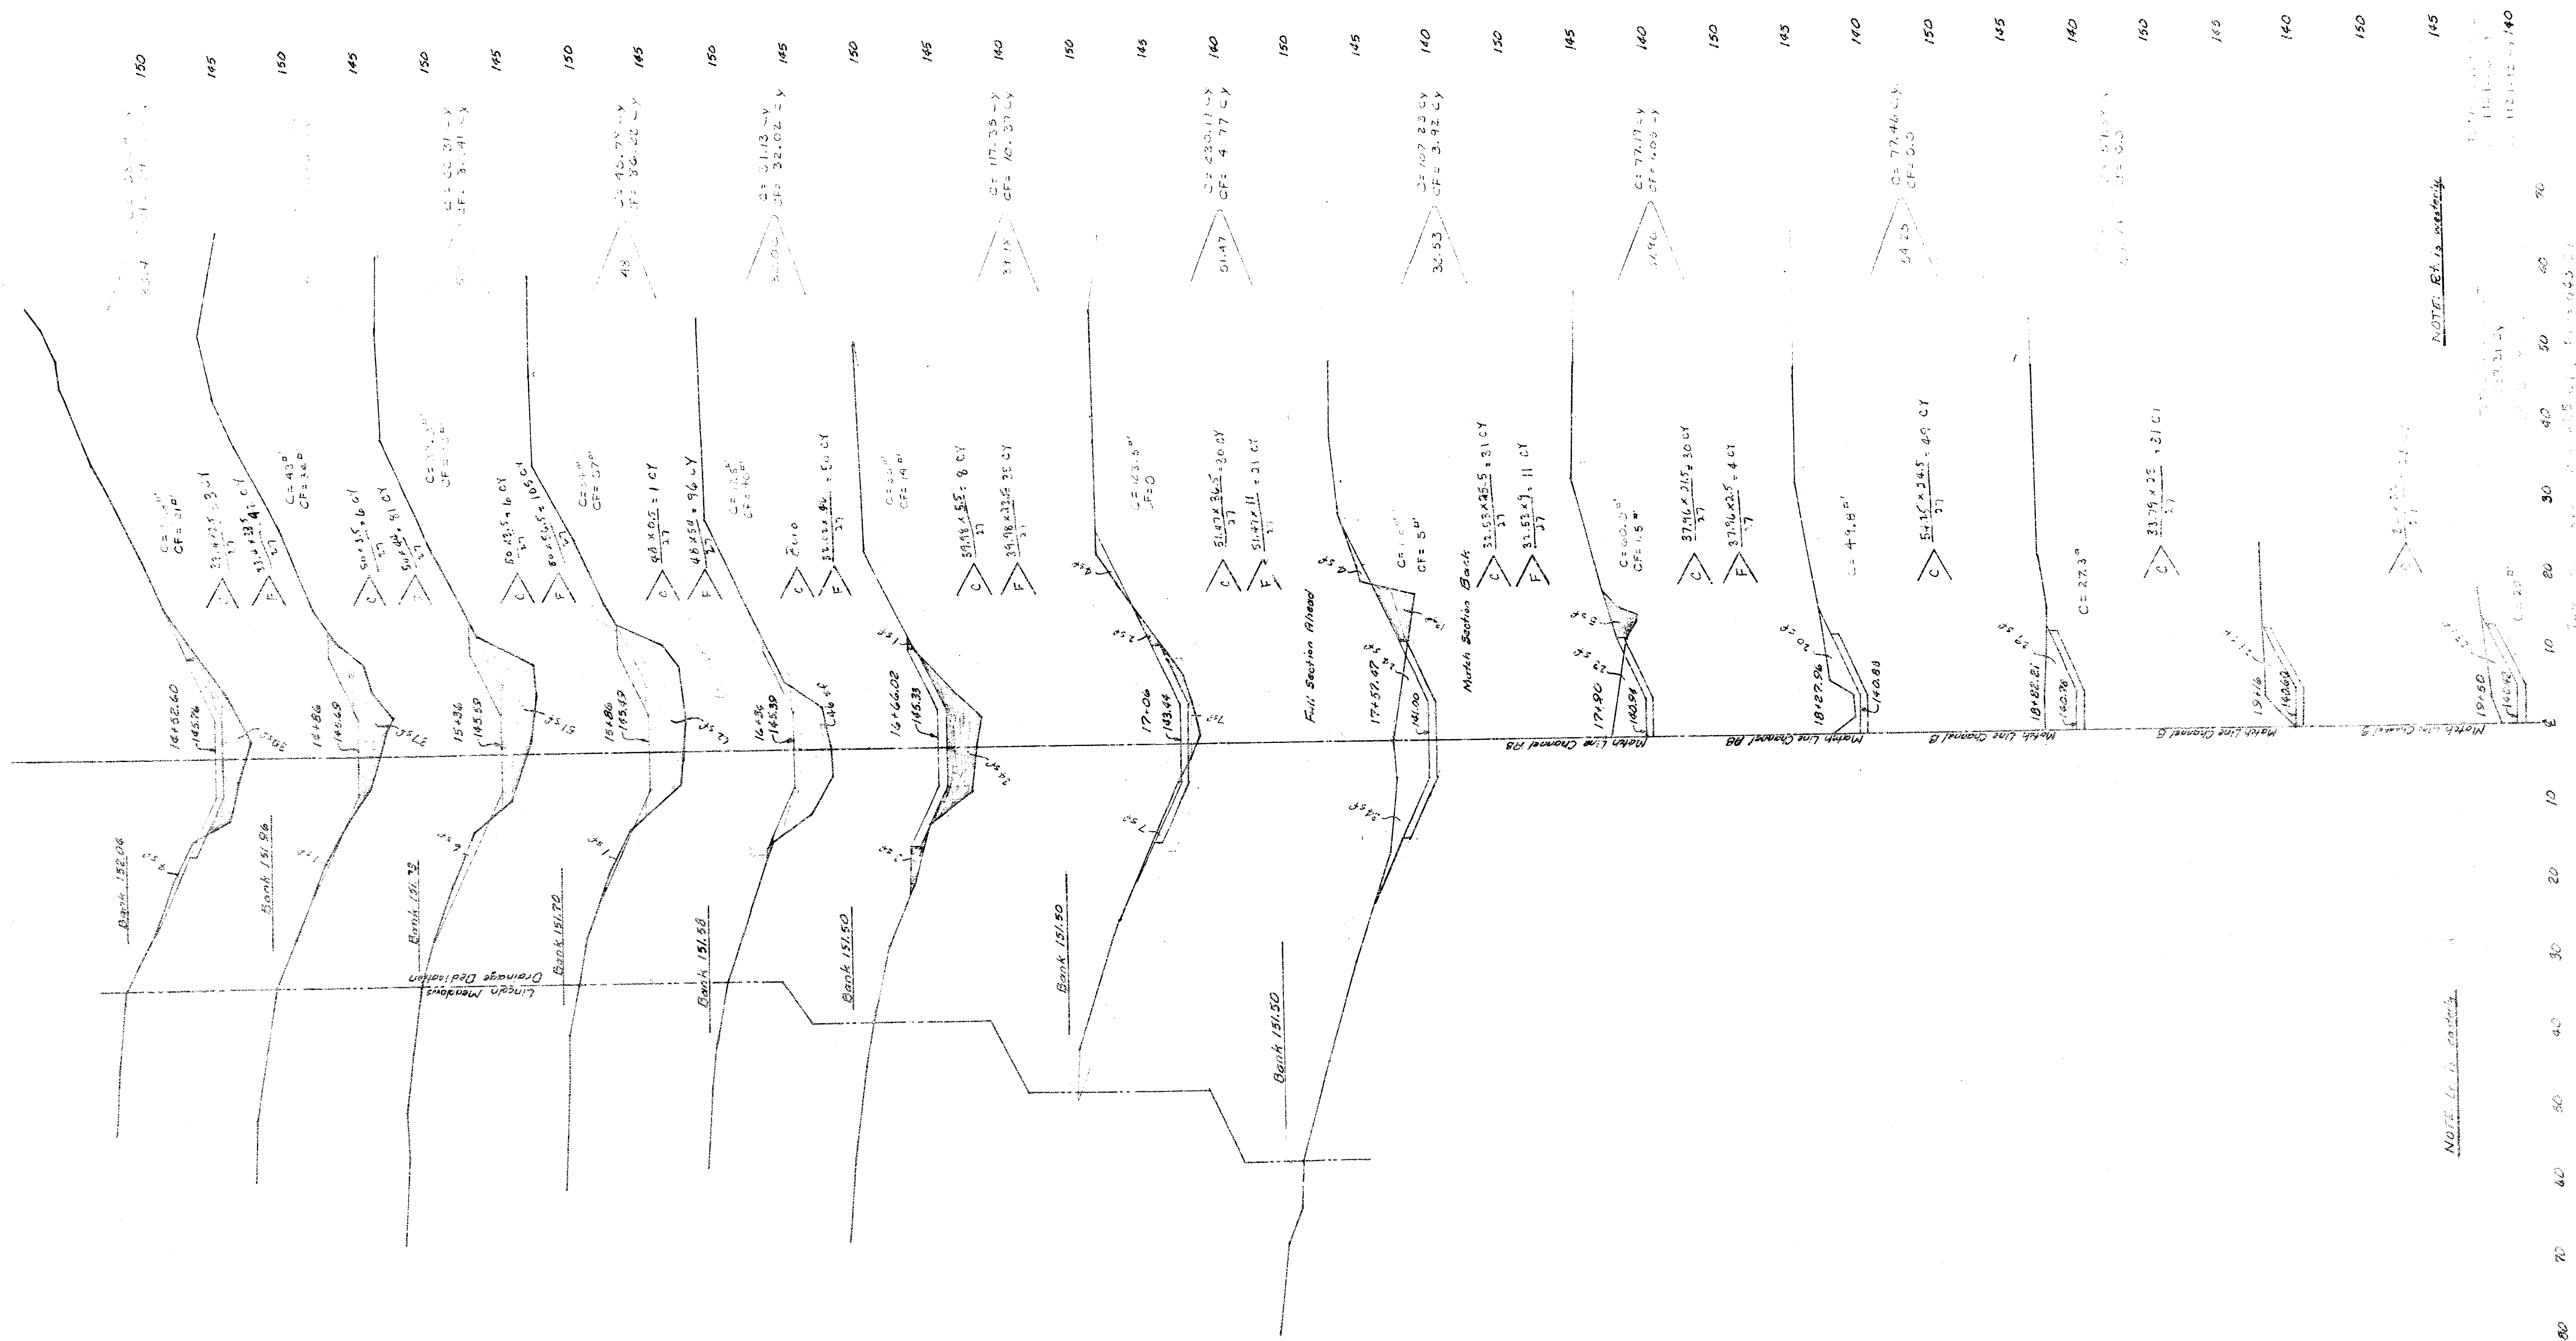


TOTAL ALL SHEETS (CUT 7921 CY) (FILL 1287 CY)

Line A Sta 191.50 to 57.4+52.40
 S.W.D. #21 Sheet 6 of 13


NOTE: R/L is remaining

NOTE: L/L is existing

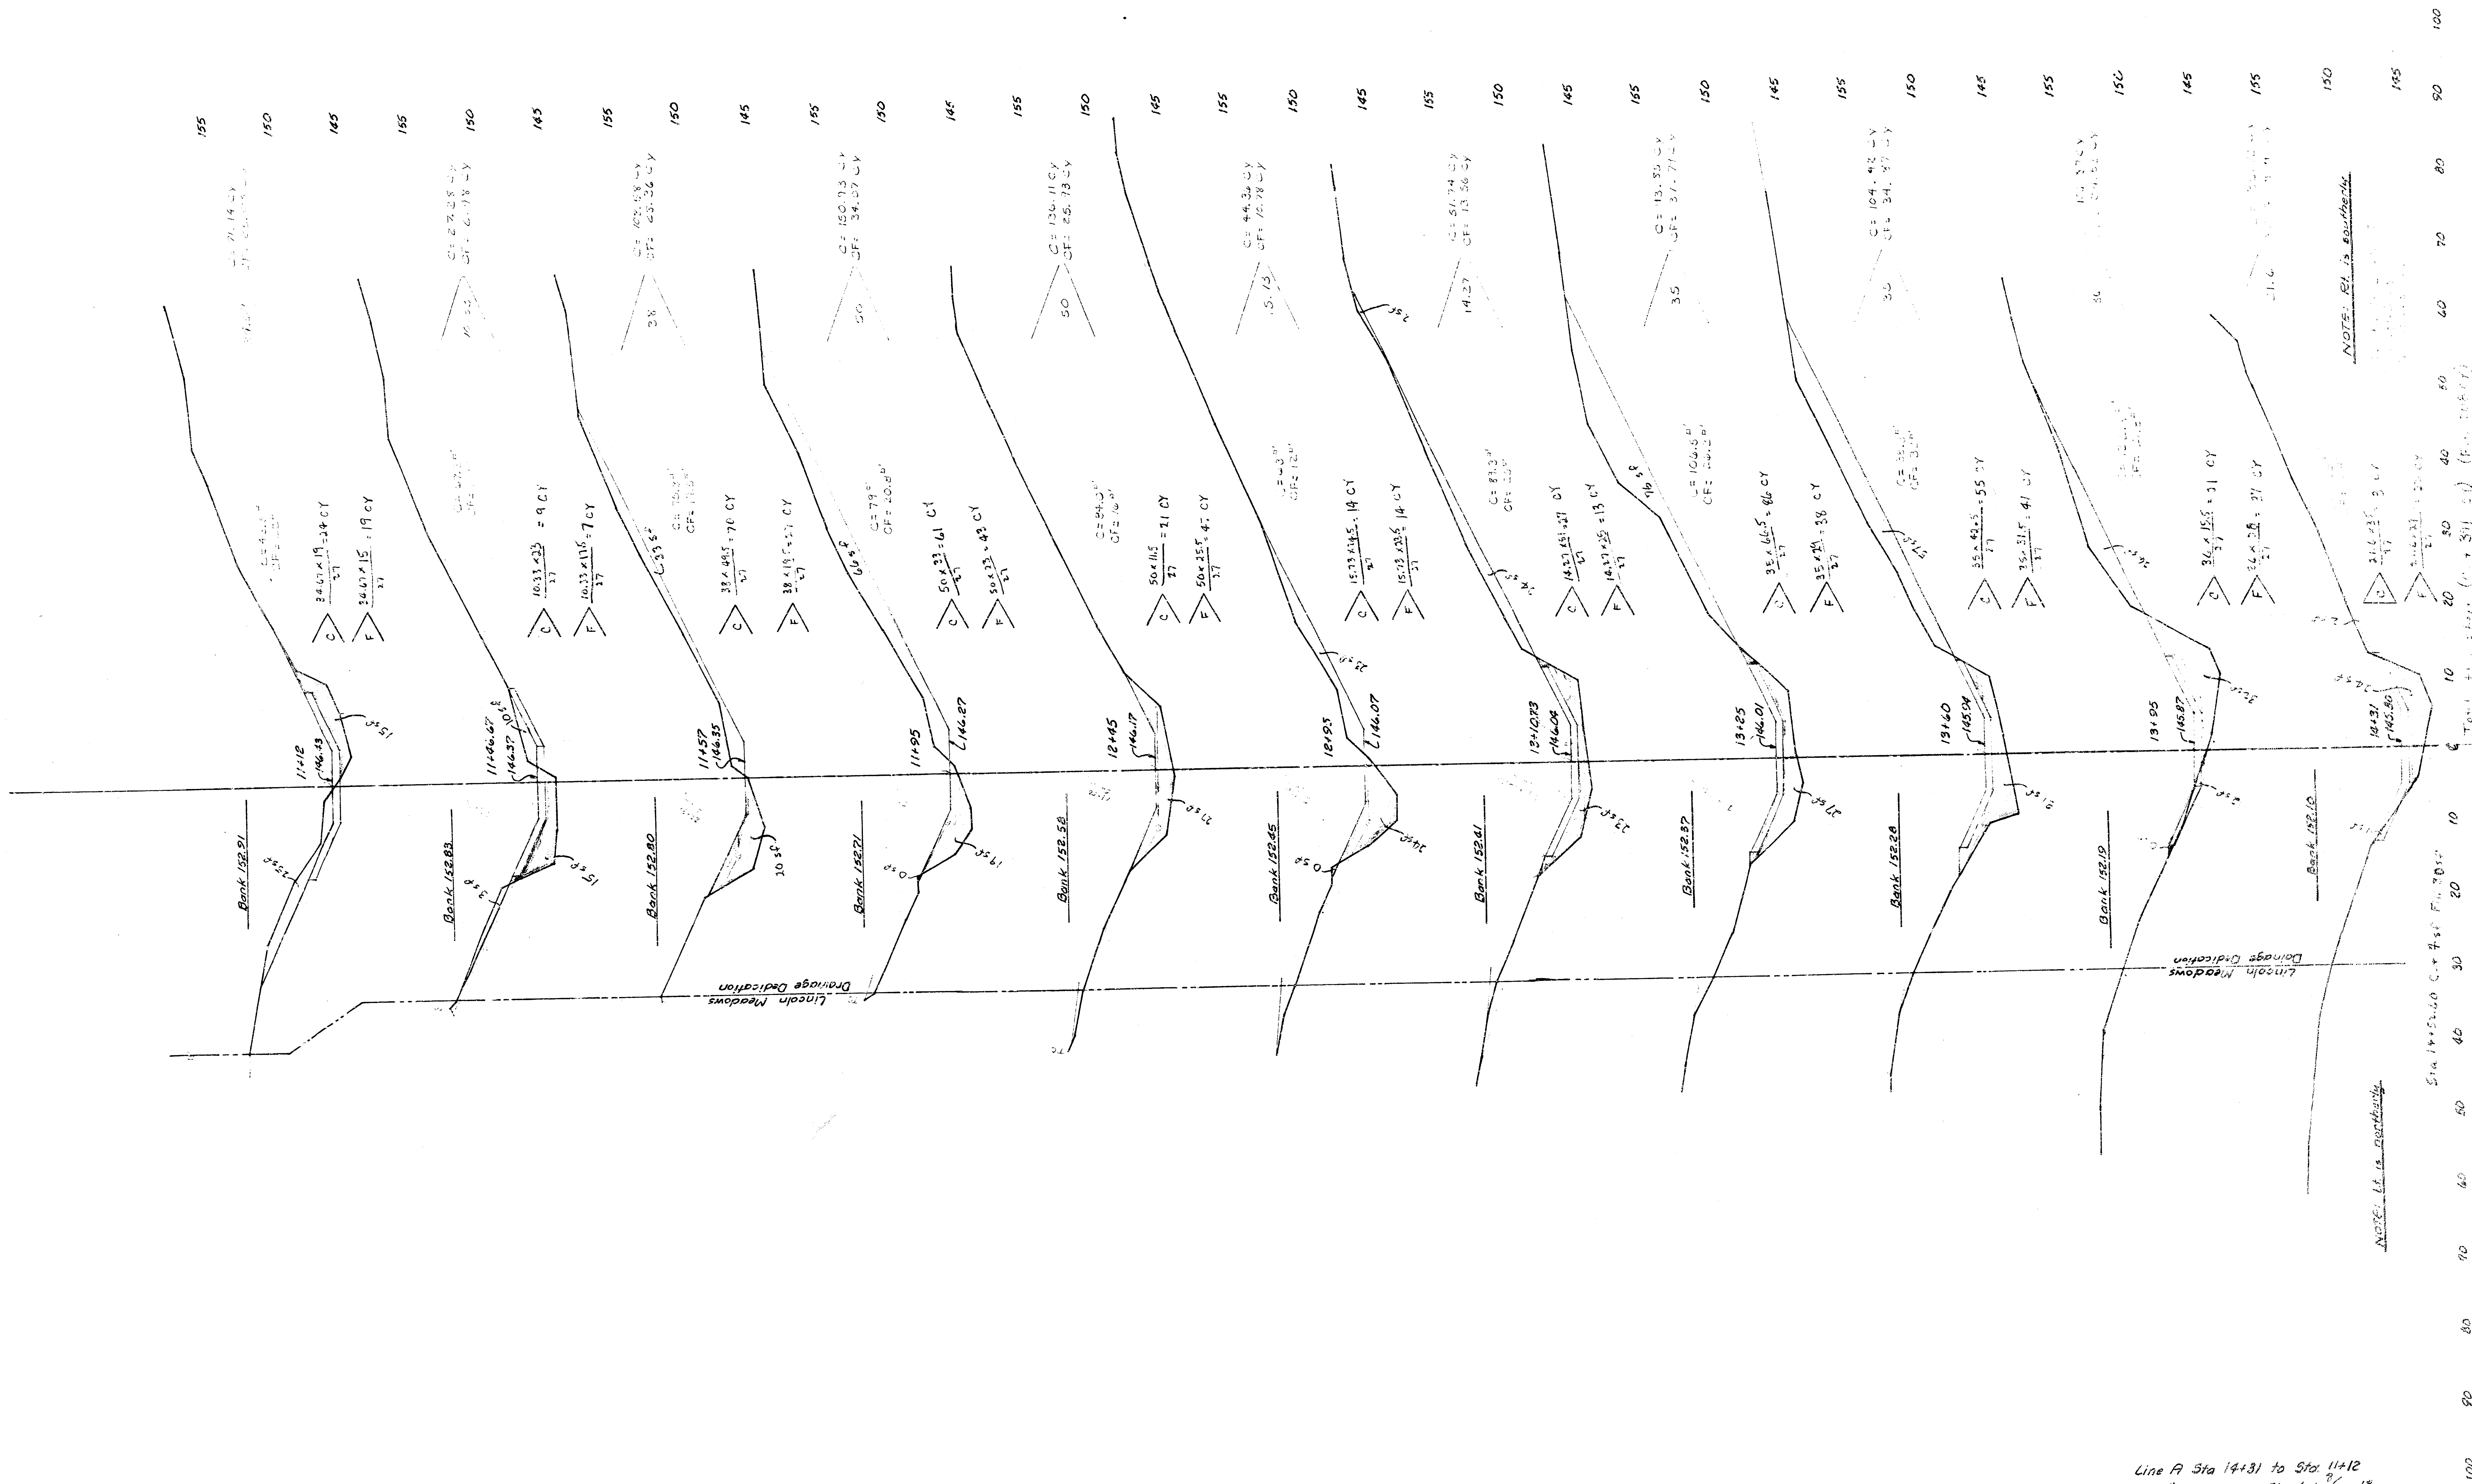




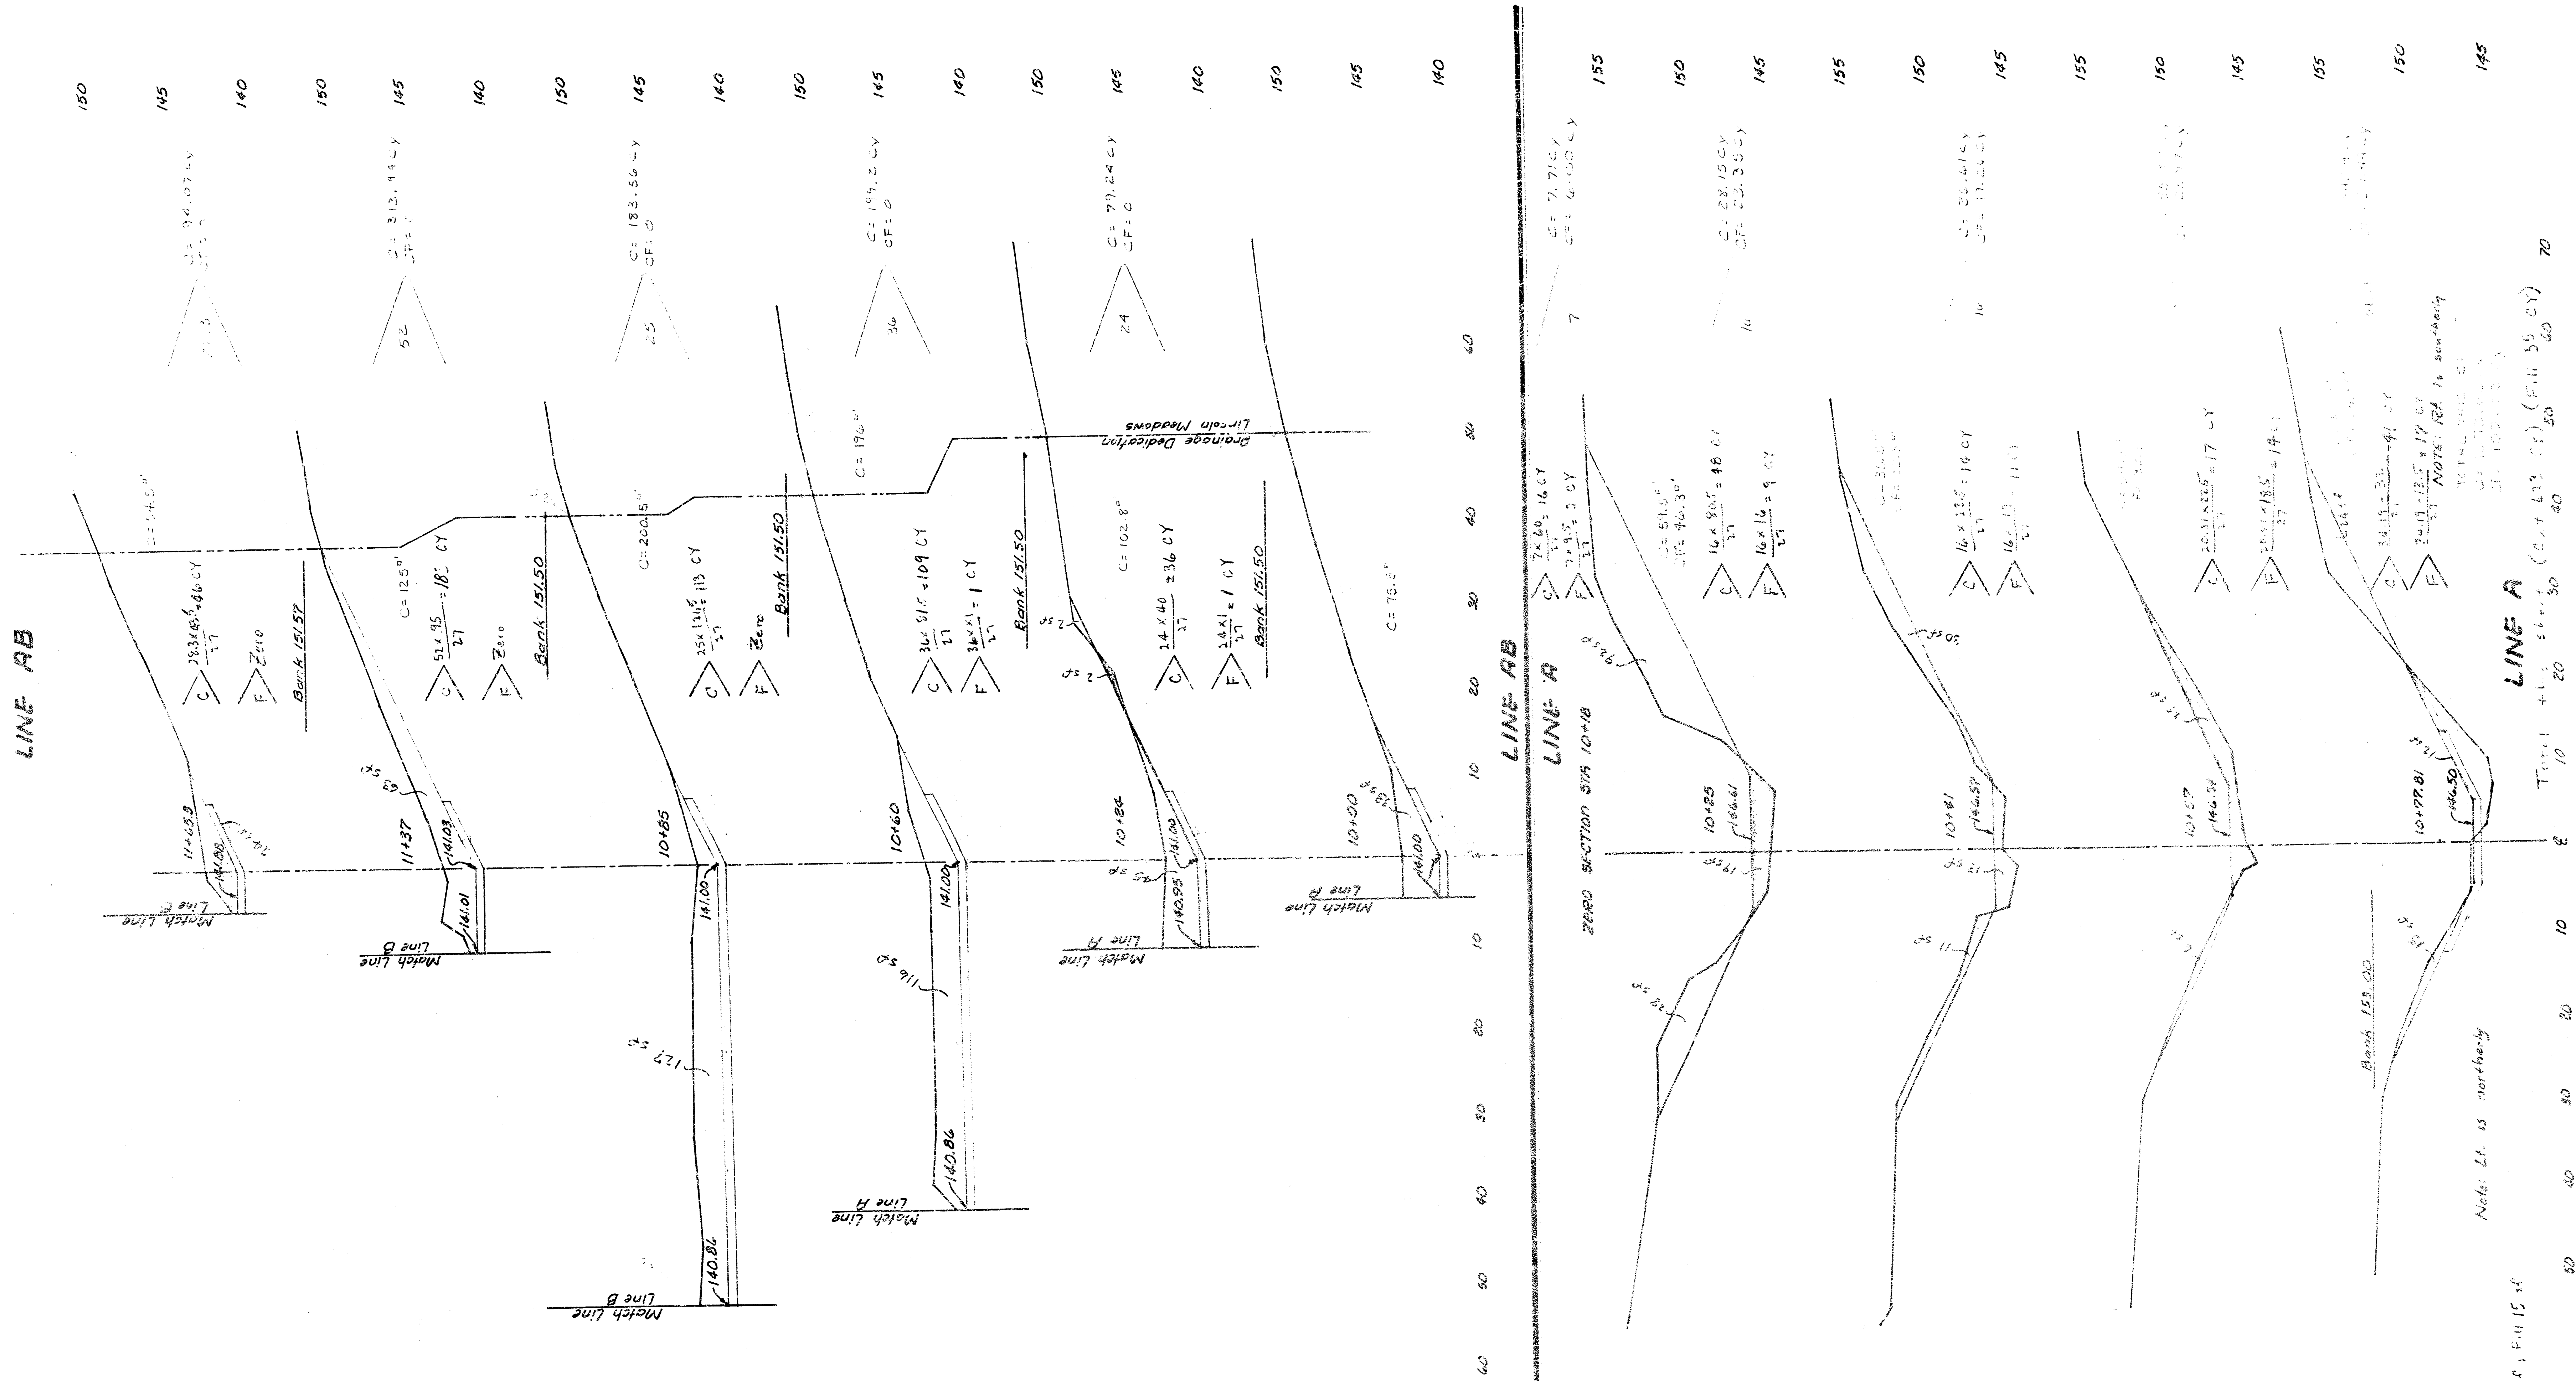


Line A Sta. 10+77.61 to 10+15
 Line B Sta. 10+00 to 10+35.3
 SWD #21 Sheet 19 13


Note: Lt. is northward


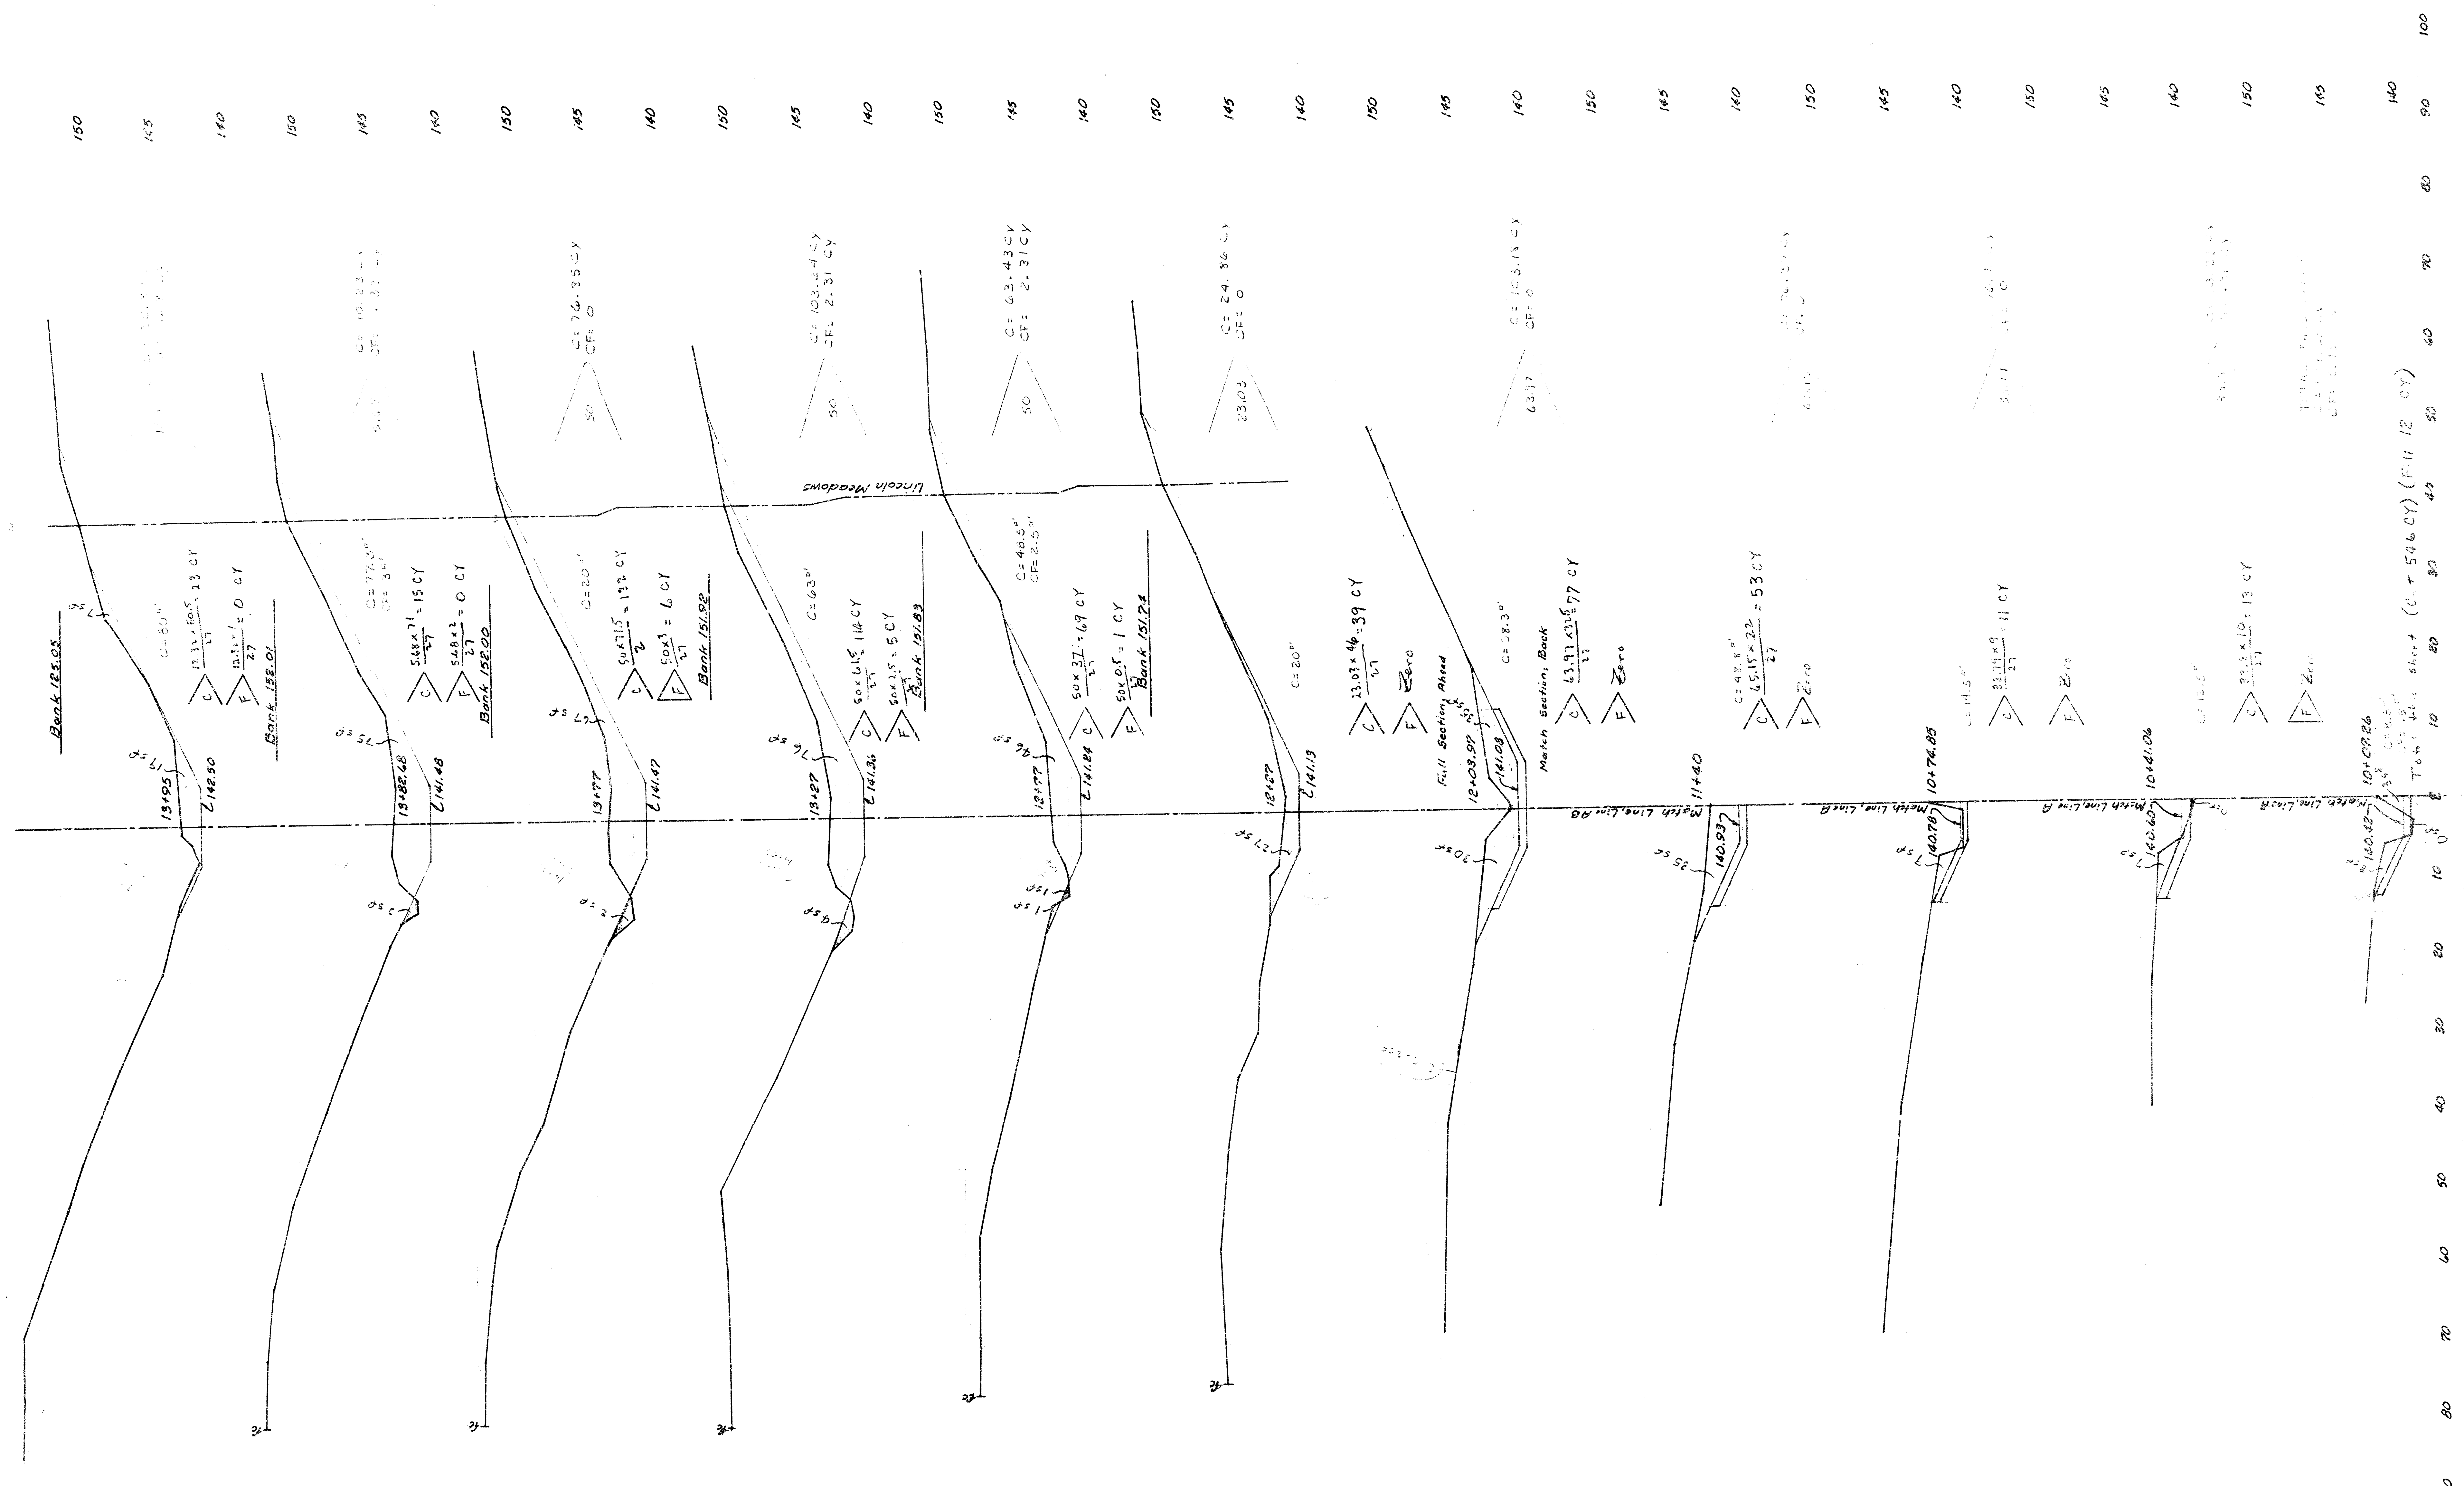

Line B Sta 10+07.25 to 10+95
 SWD #21 Sheet 19.3

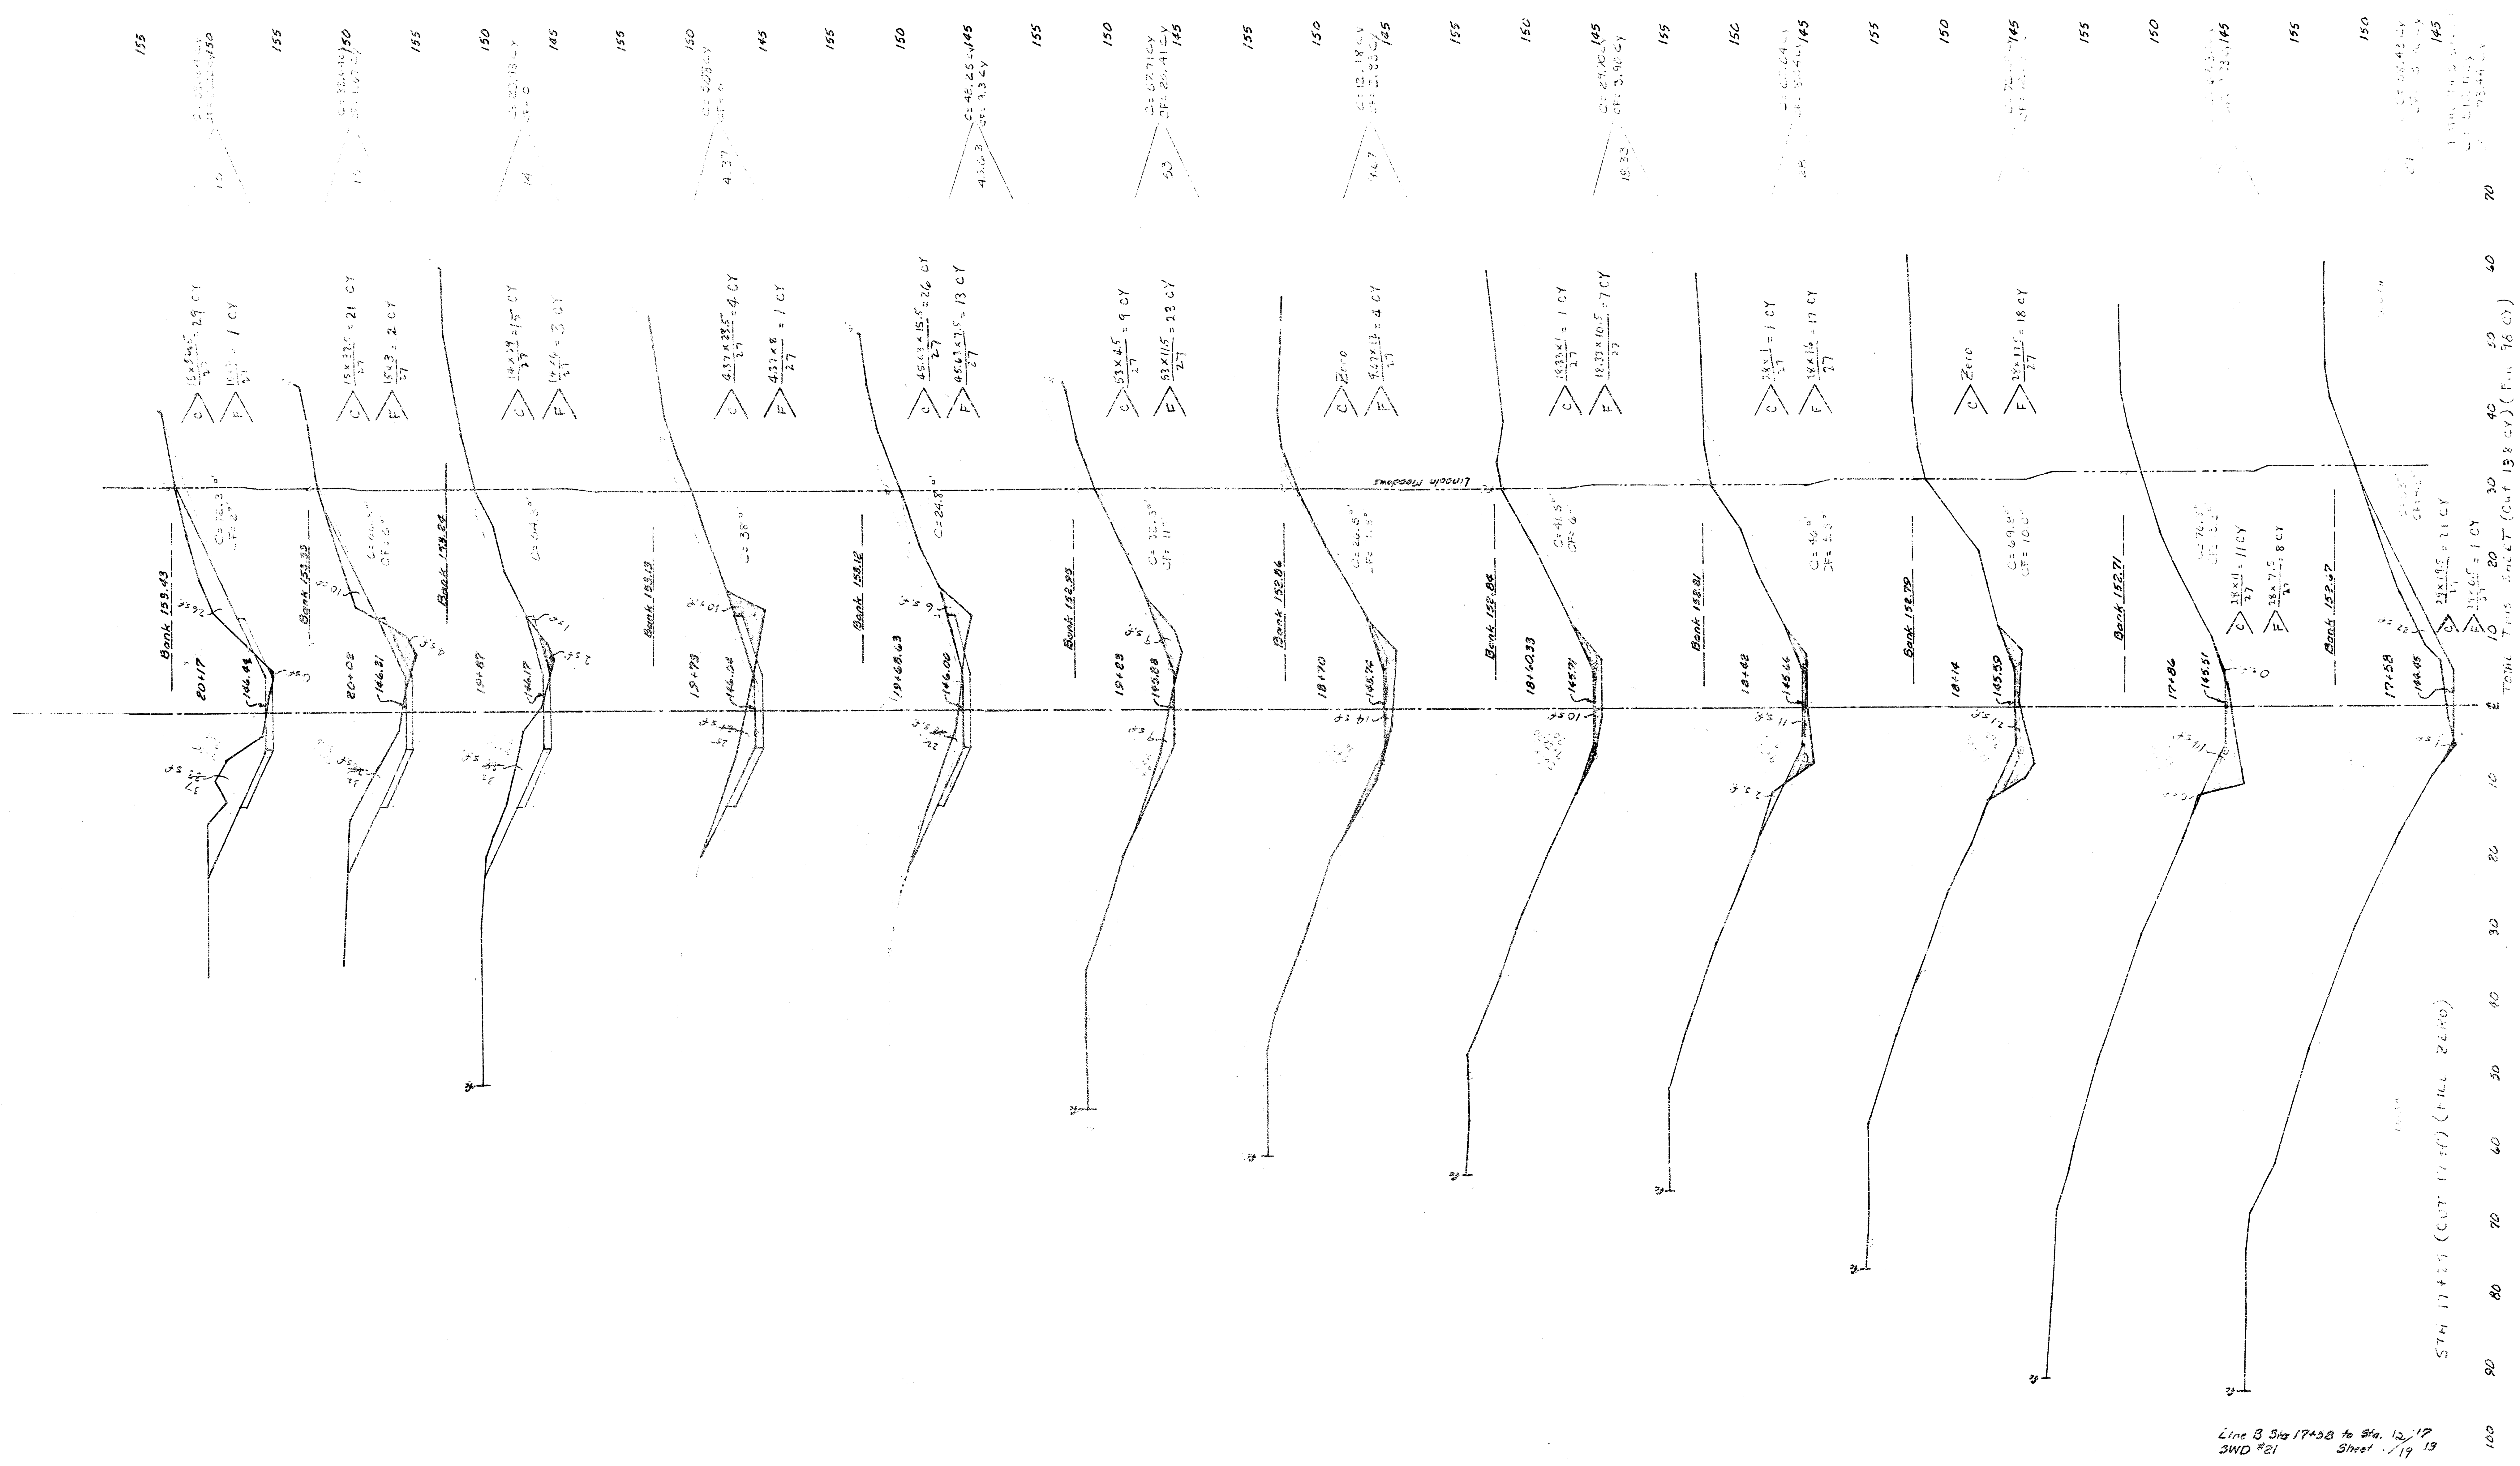

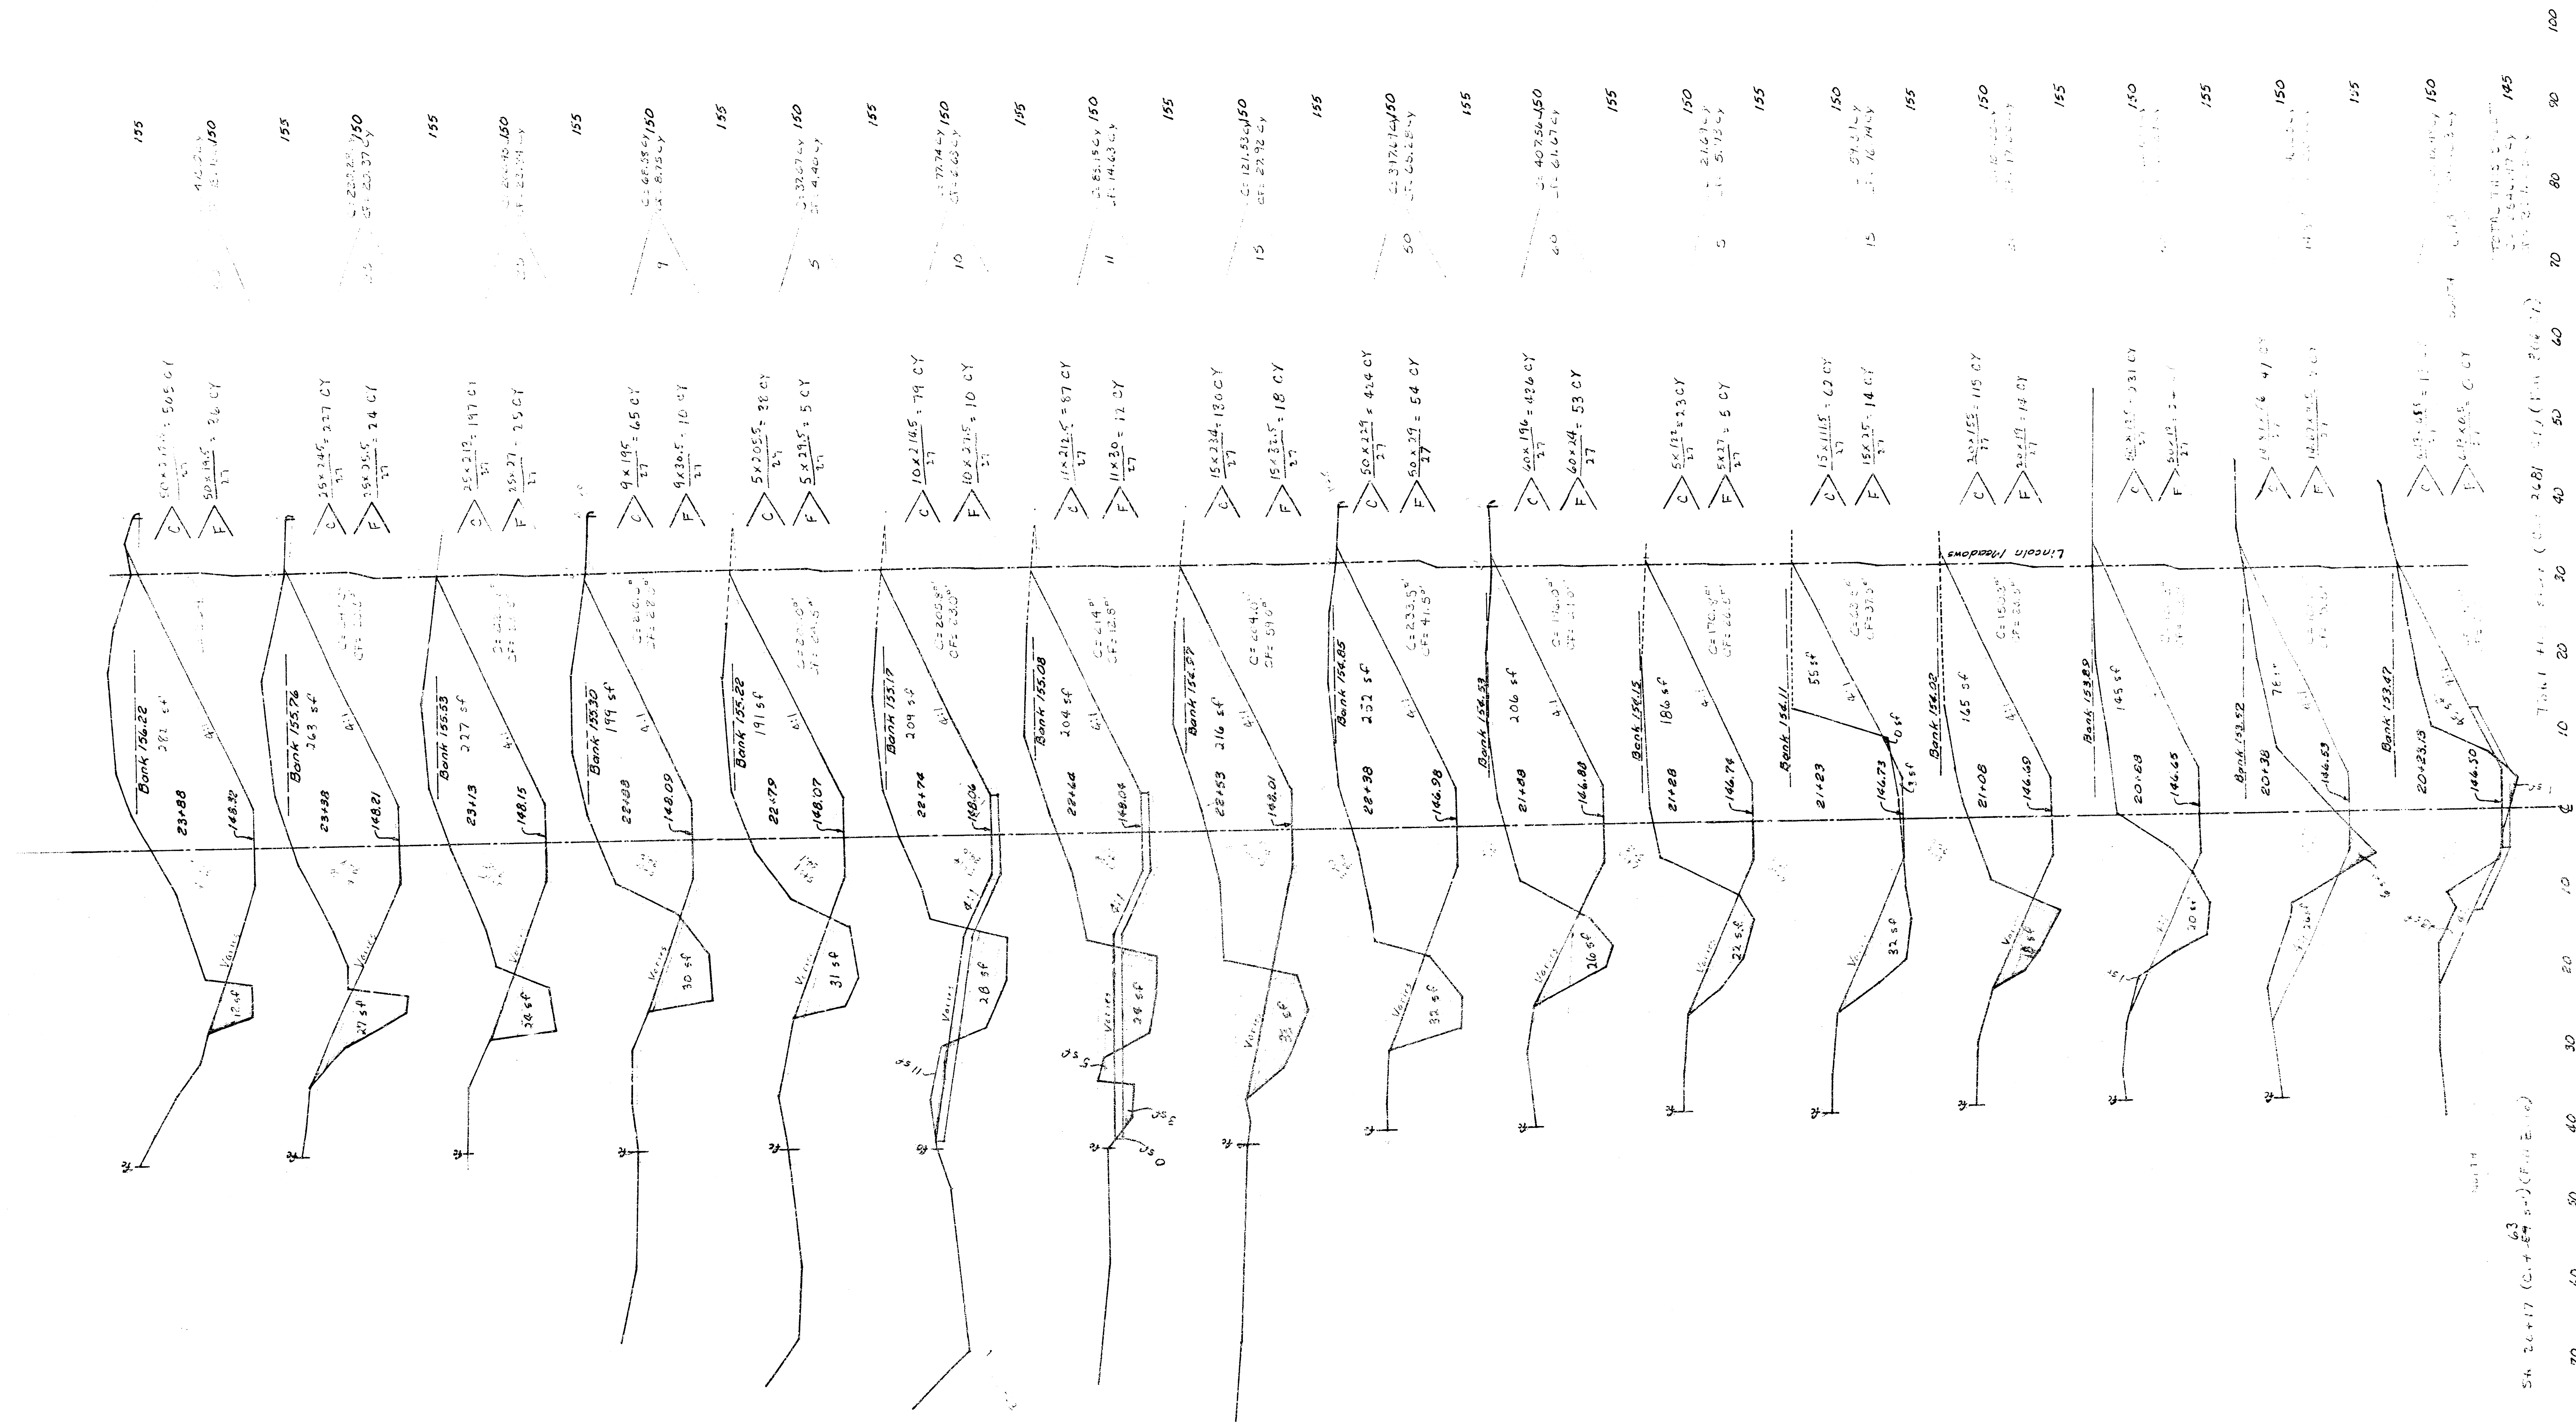

Line B Sta 20+23.13 to Sta 23+21.13
SND #21 Sheet 16/19 13

160

155

150


145

160

155

150

145

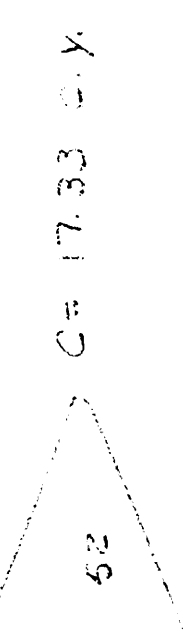


14+00

155

150

145

140

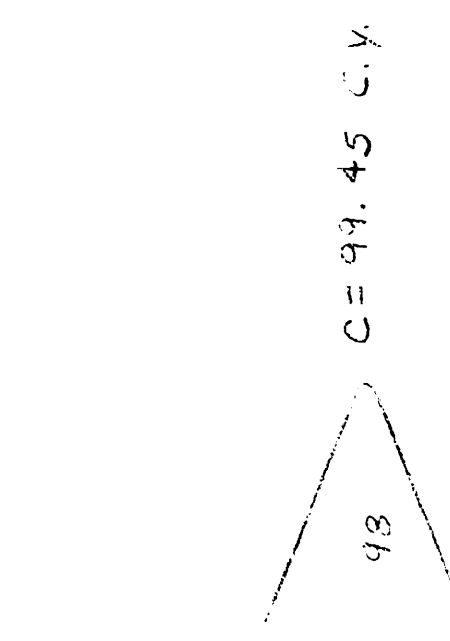

14+52 P.T.

155

150

145




15+50

140

150

145

140

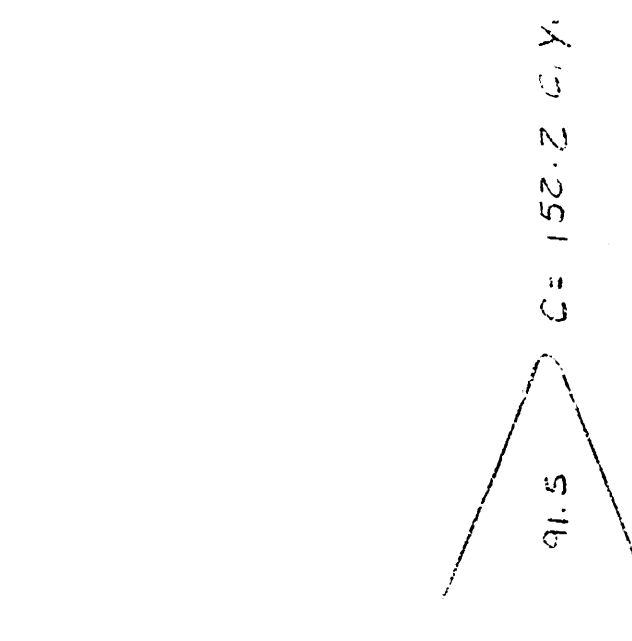


16+44 P.C.

150

145

140

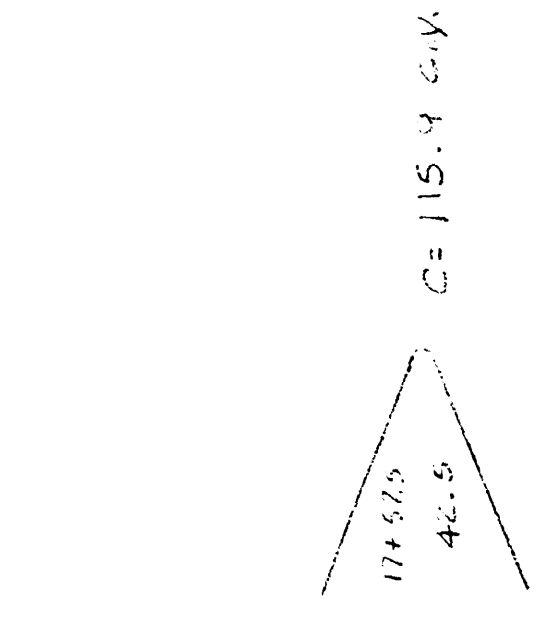


18+00

150

145


140

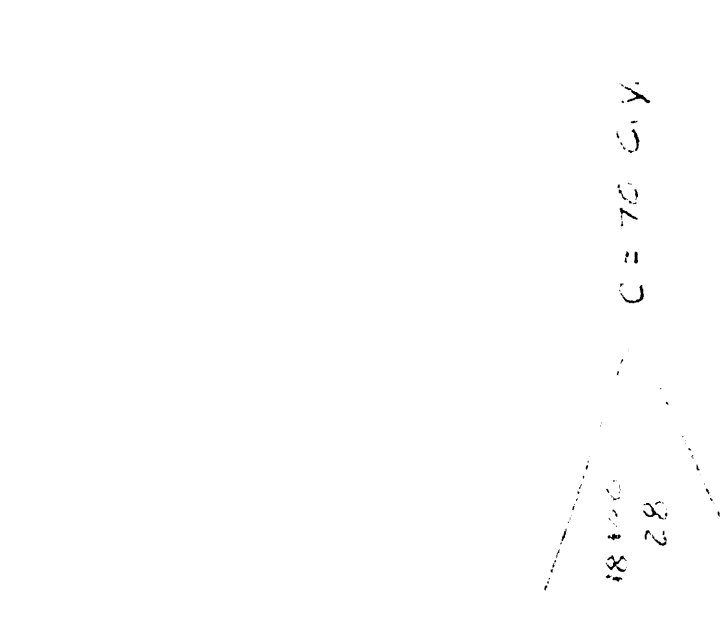

17+57.5 P.T.

145


140

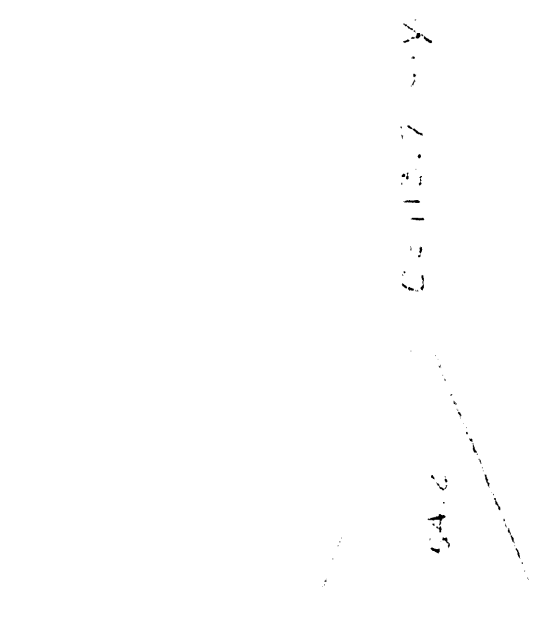

18+28 P.C.

145







140

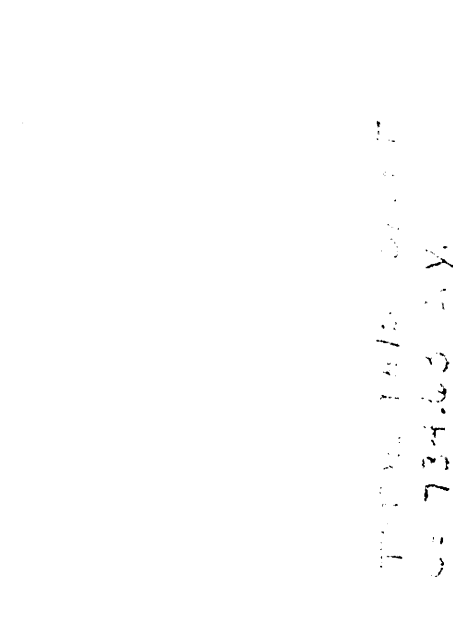















18+82.2

LINE A STA. 18+82.2 TO 14+00

TOTAL CUT 466.4 C.Y.

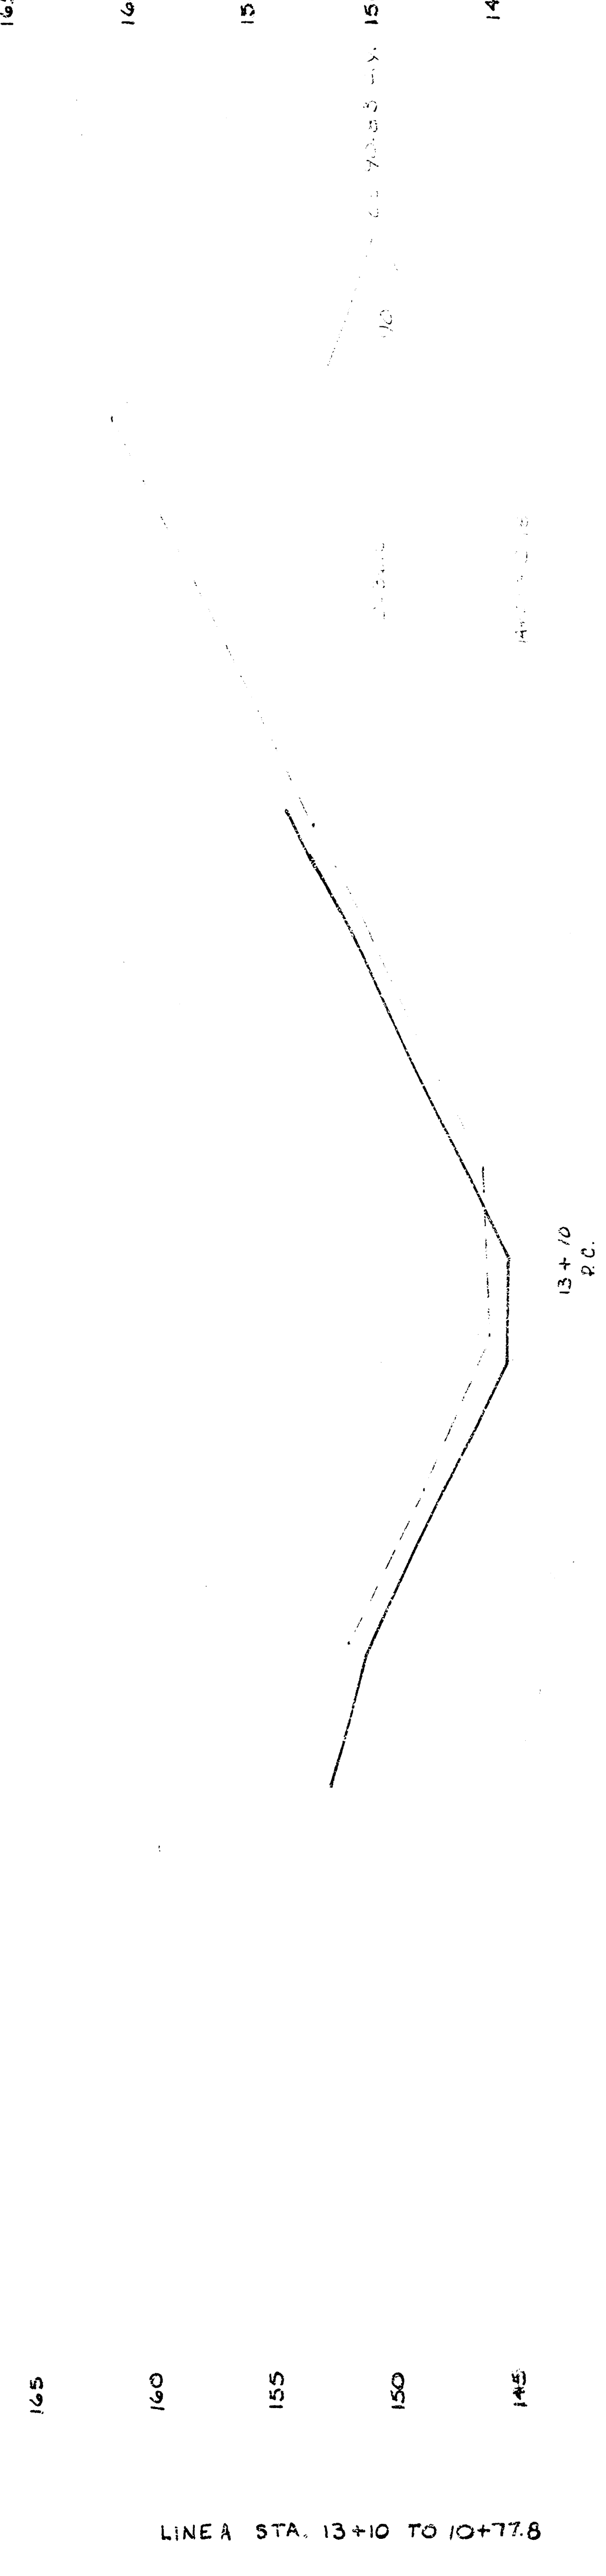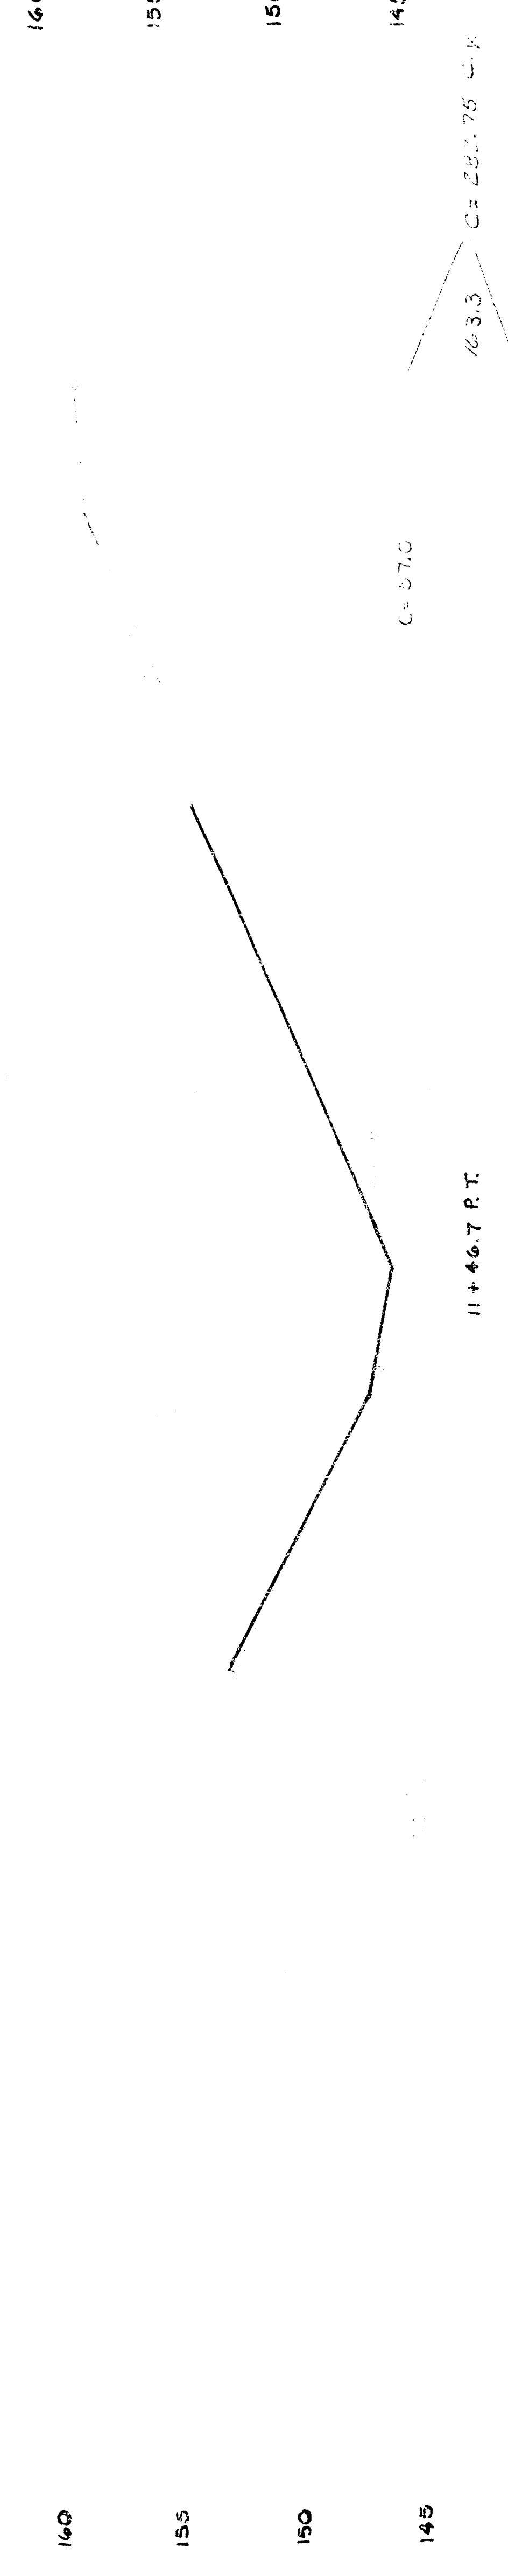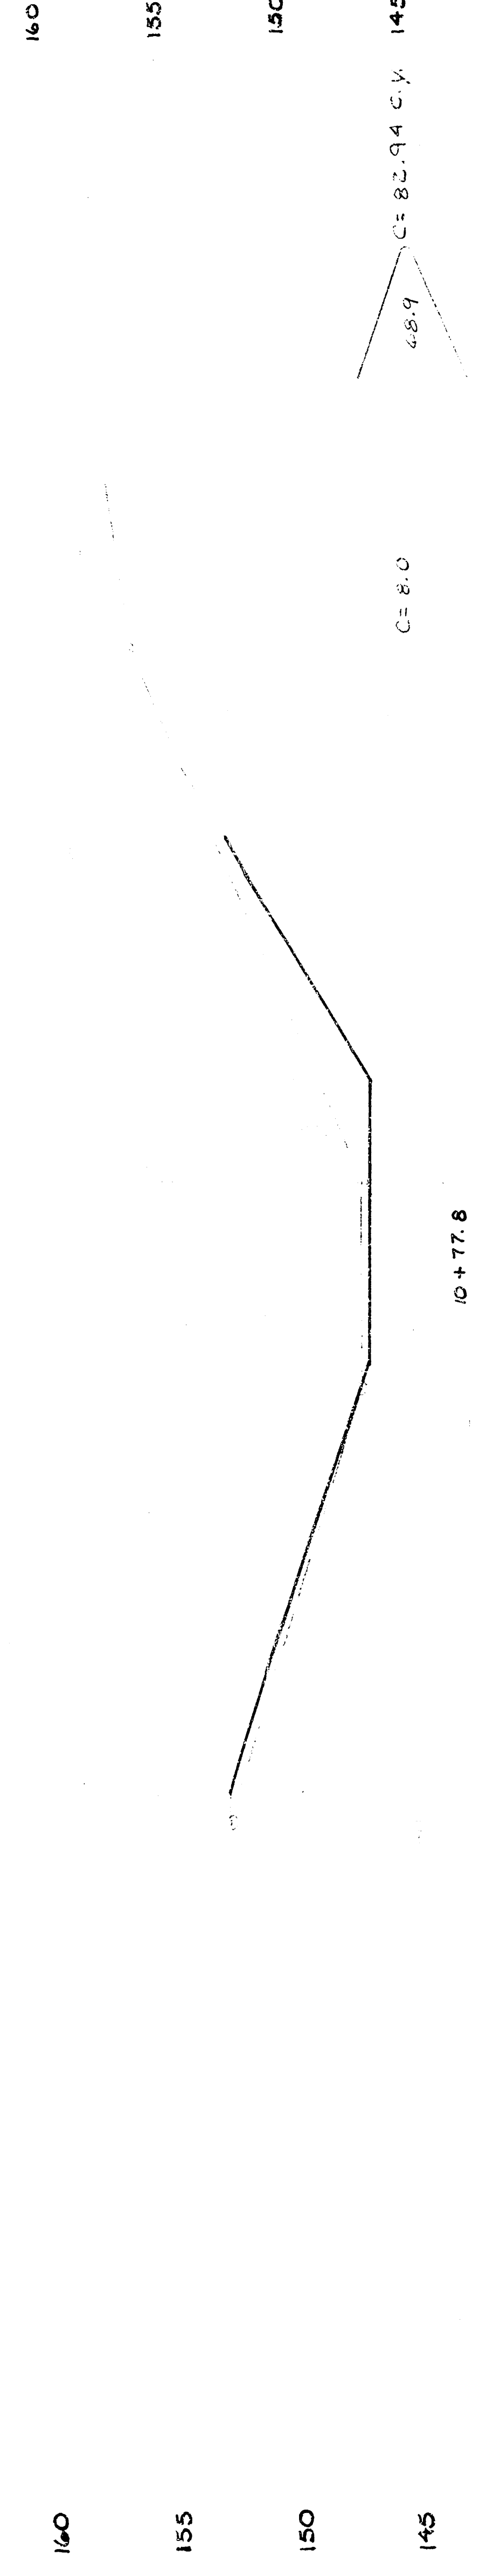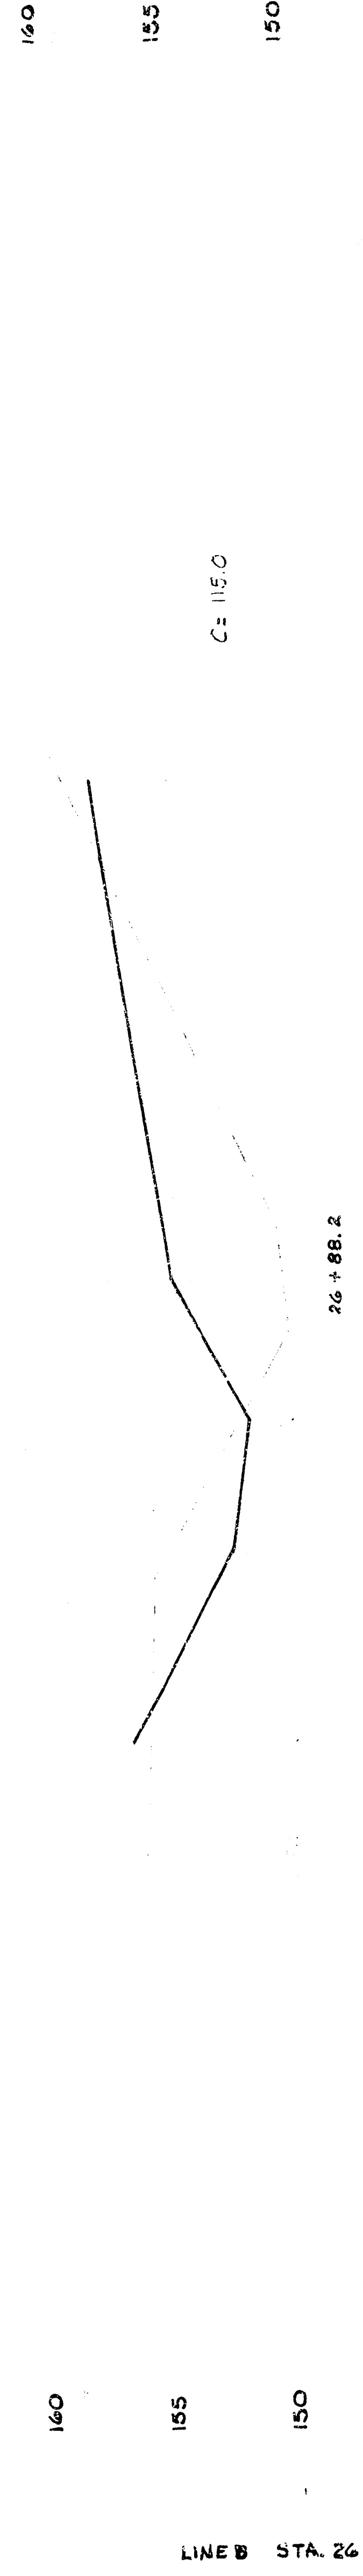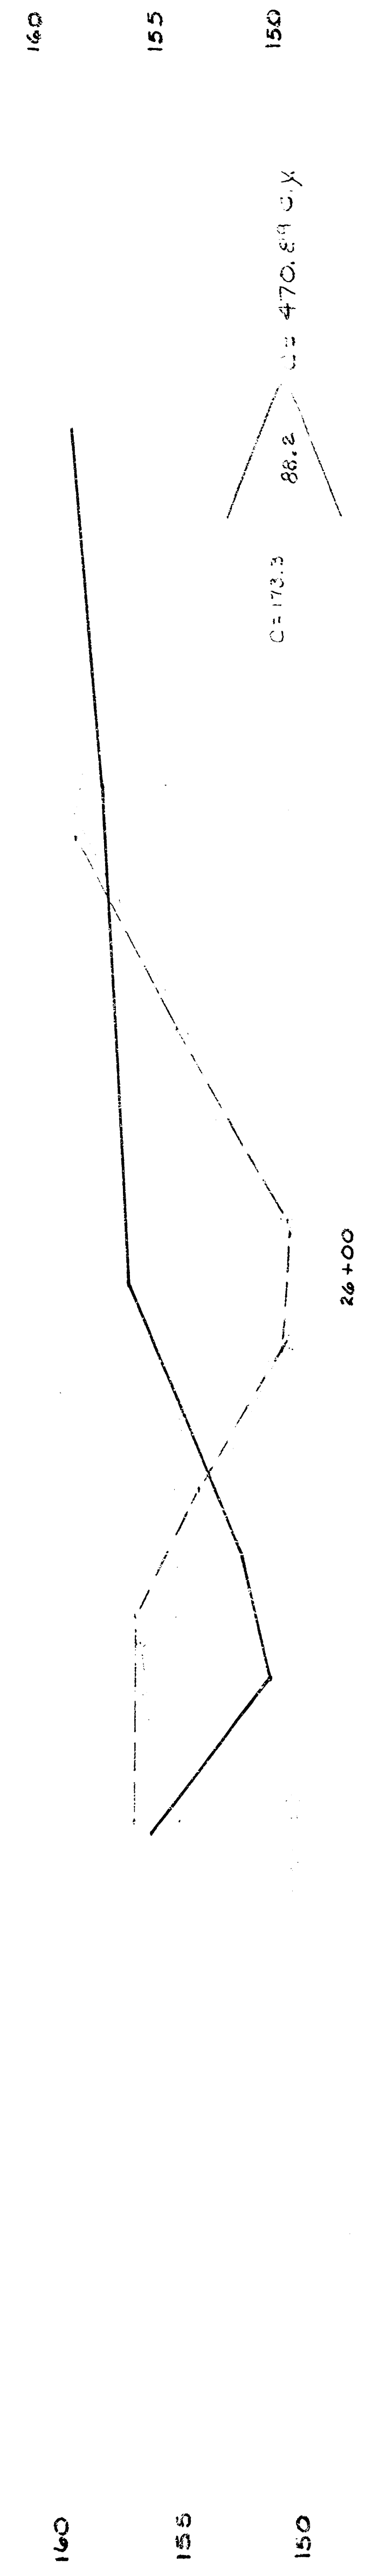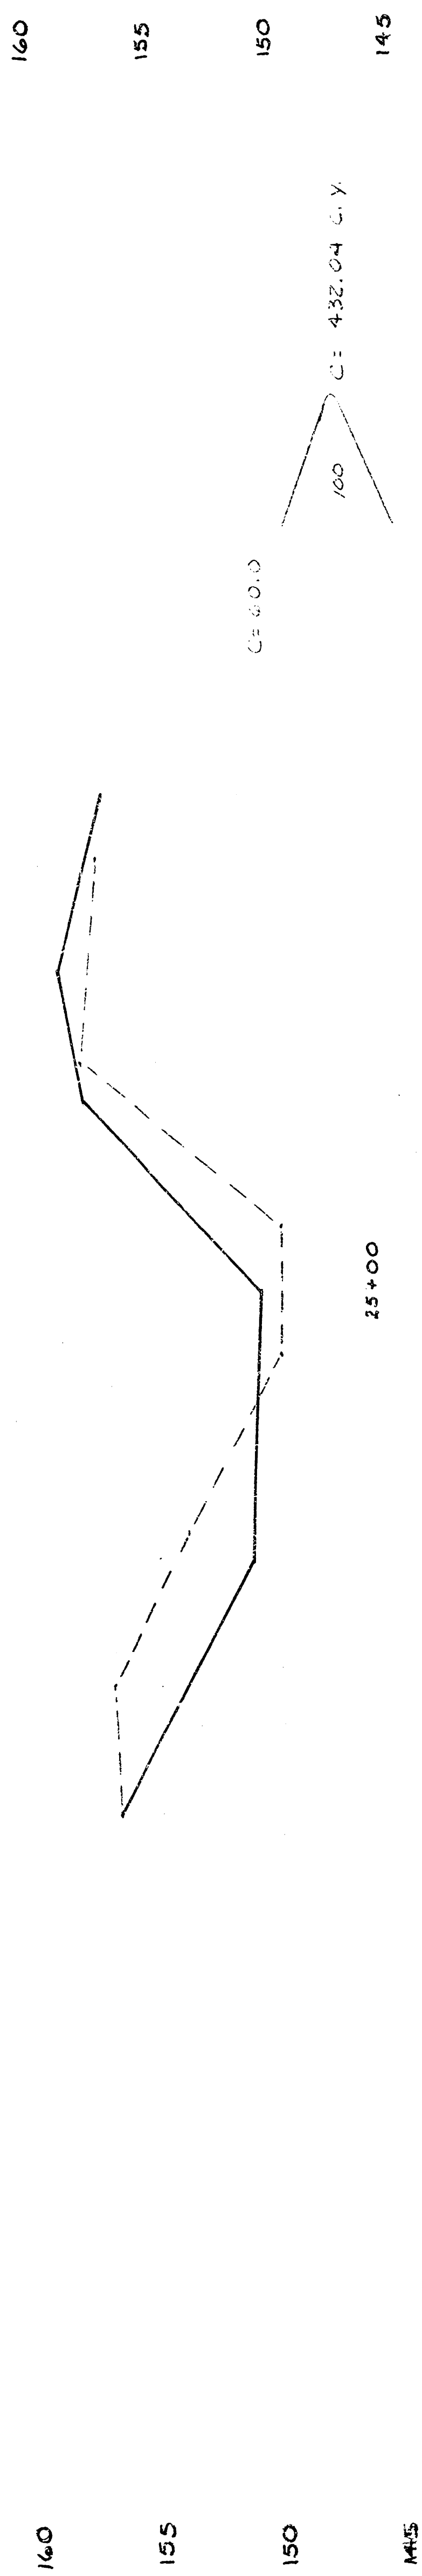






TOTAL THIS SHEET
C = 1537.45 C.Y.

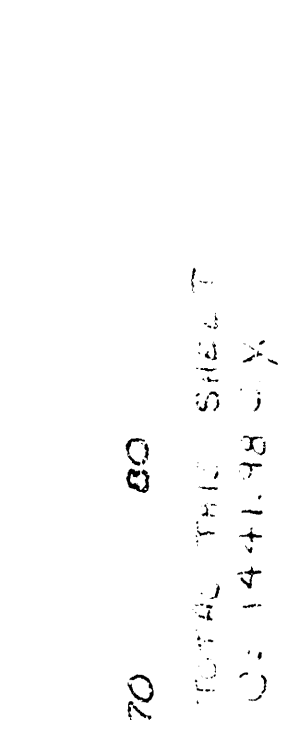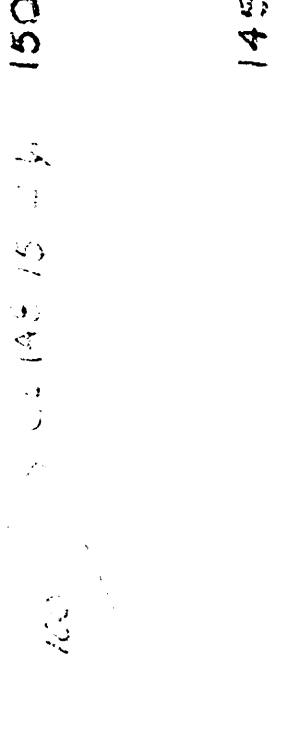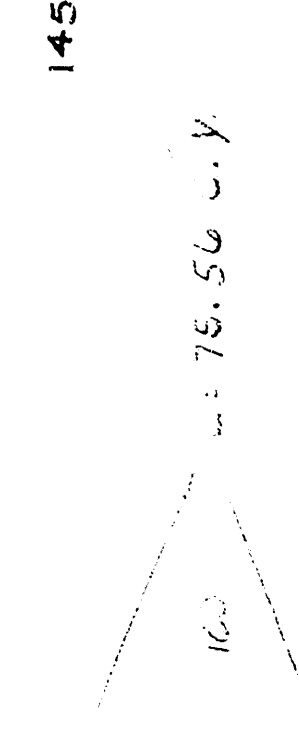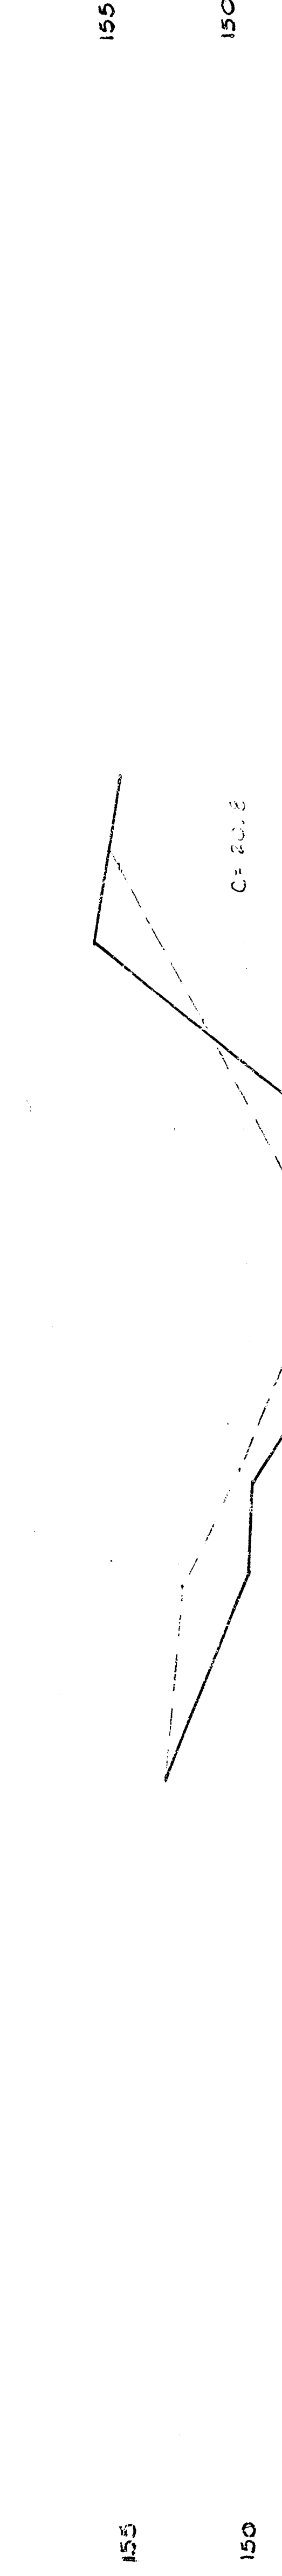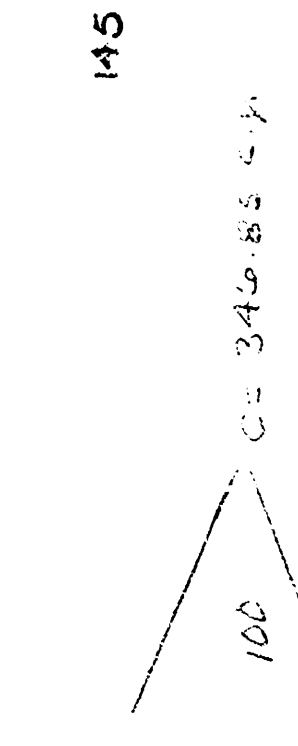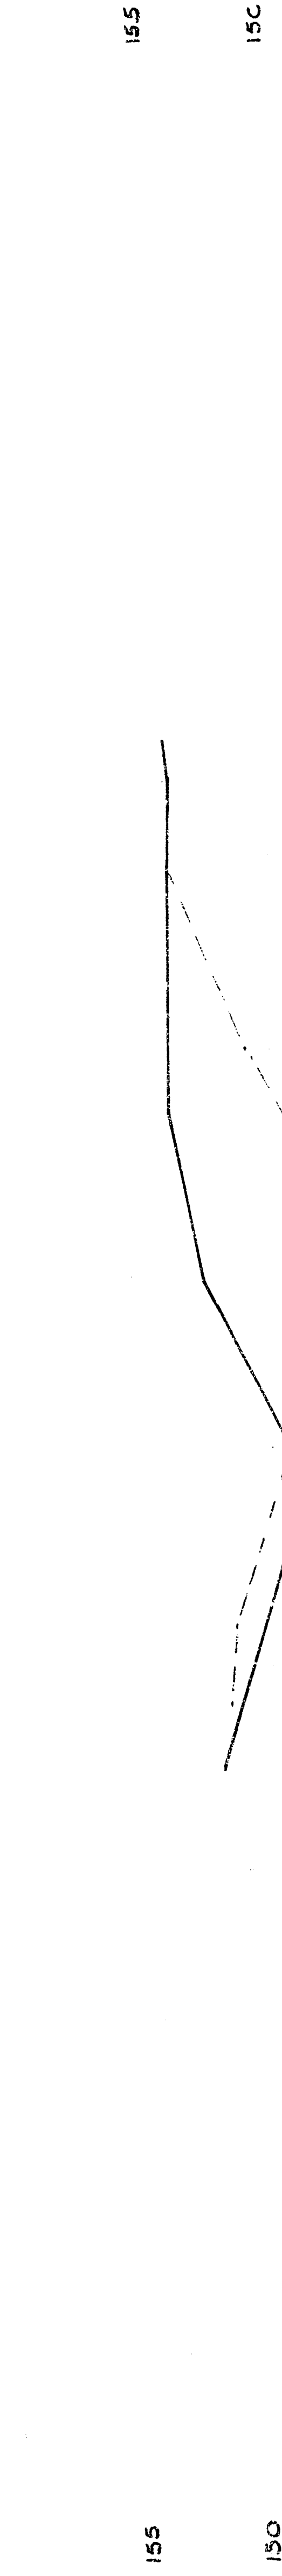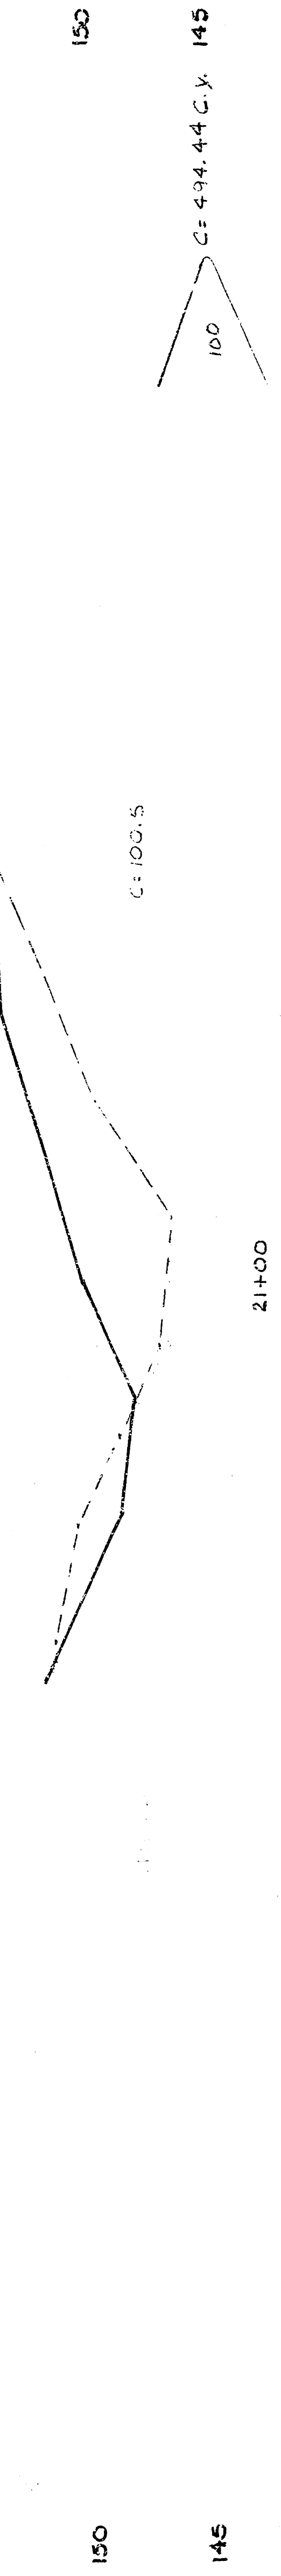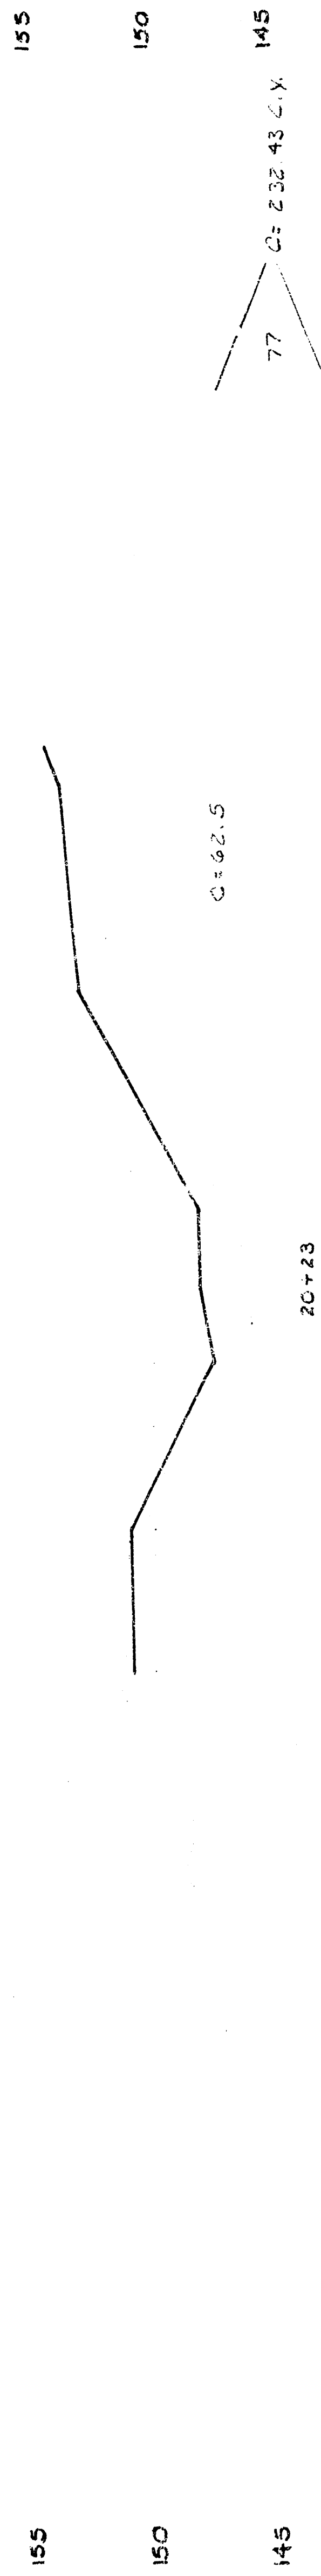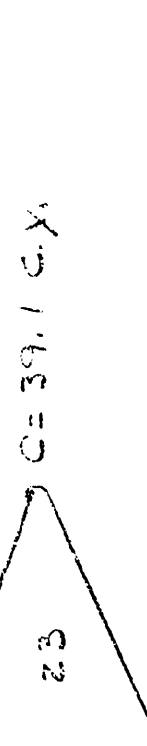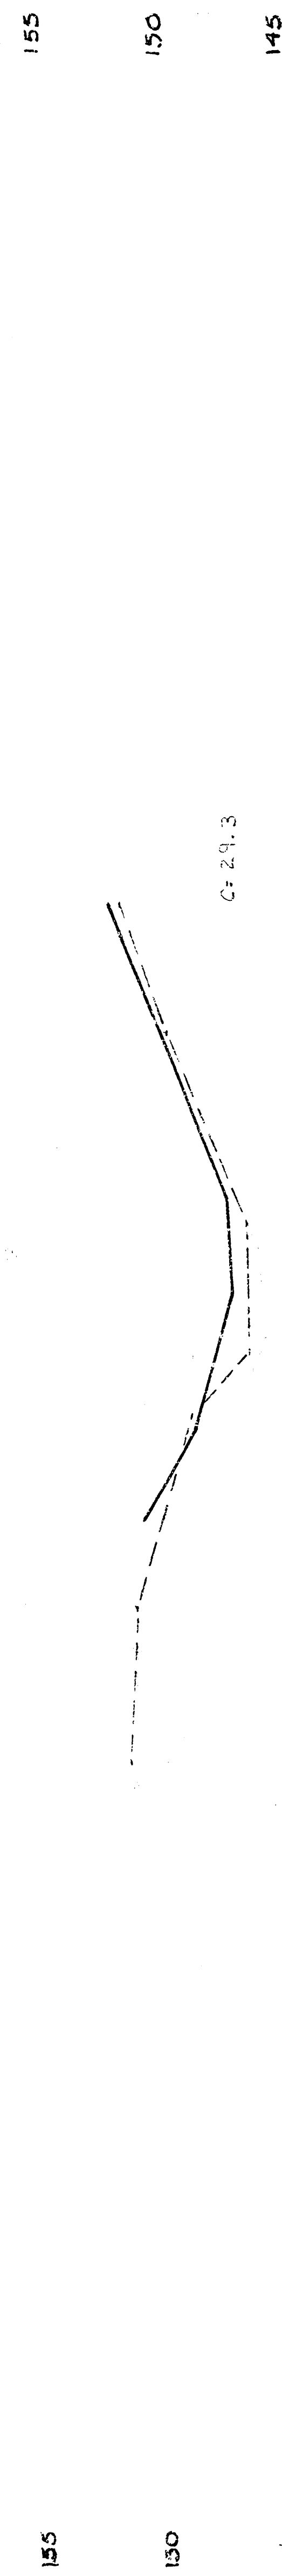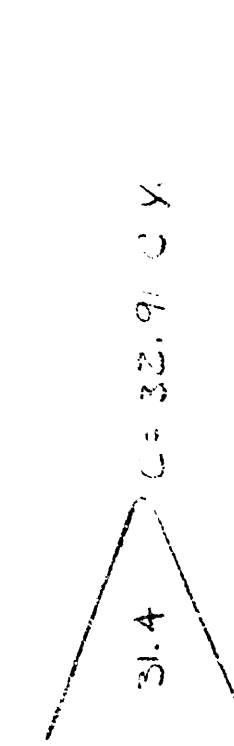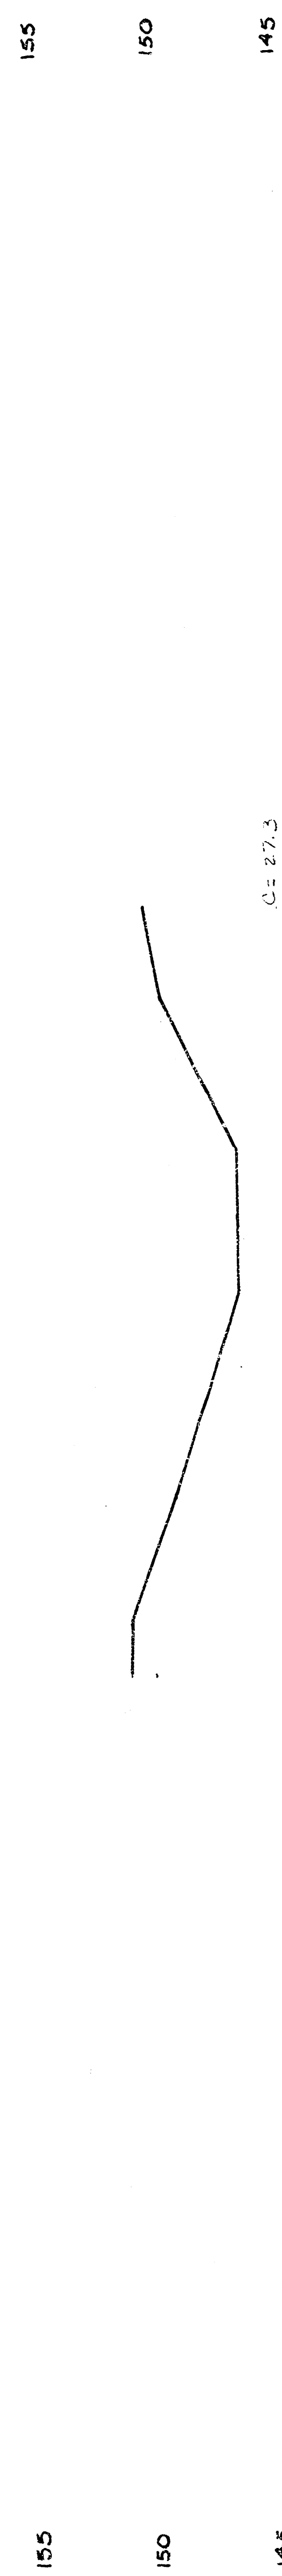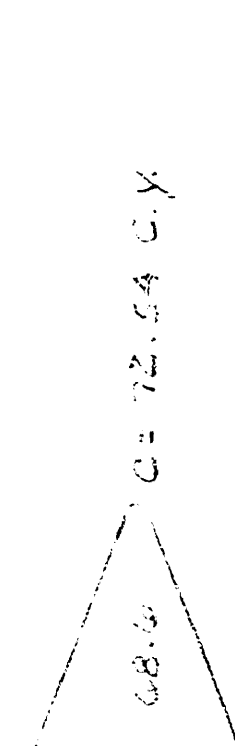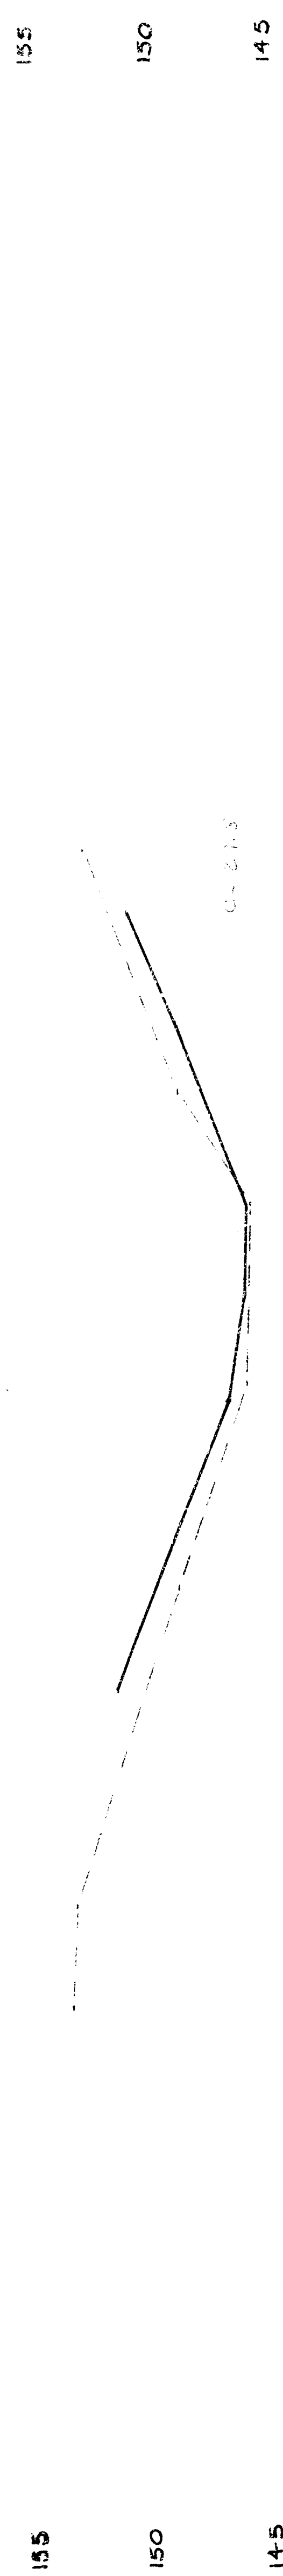

LINE B STA. 24+00 TO STA. 19+00

17/19

FILMED FROM THE BEST

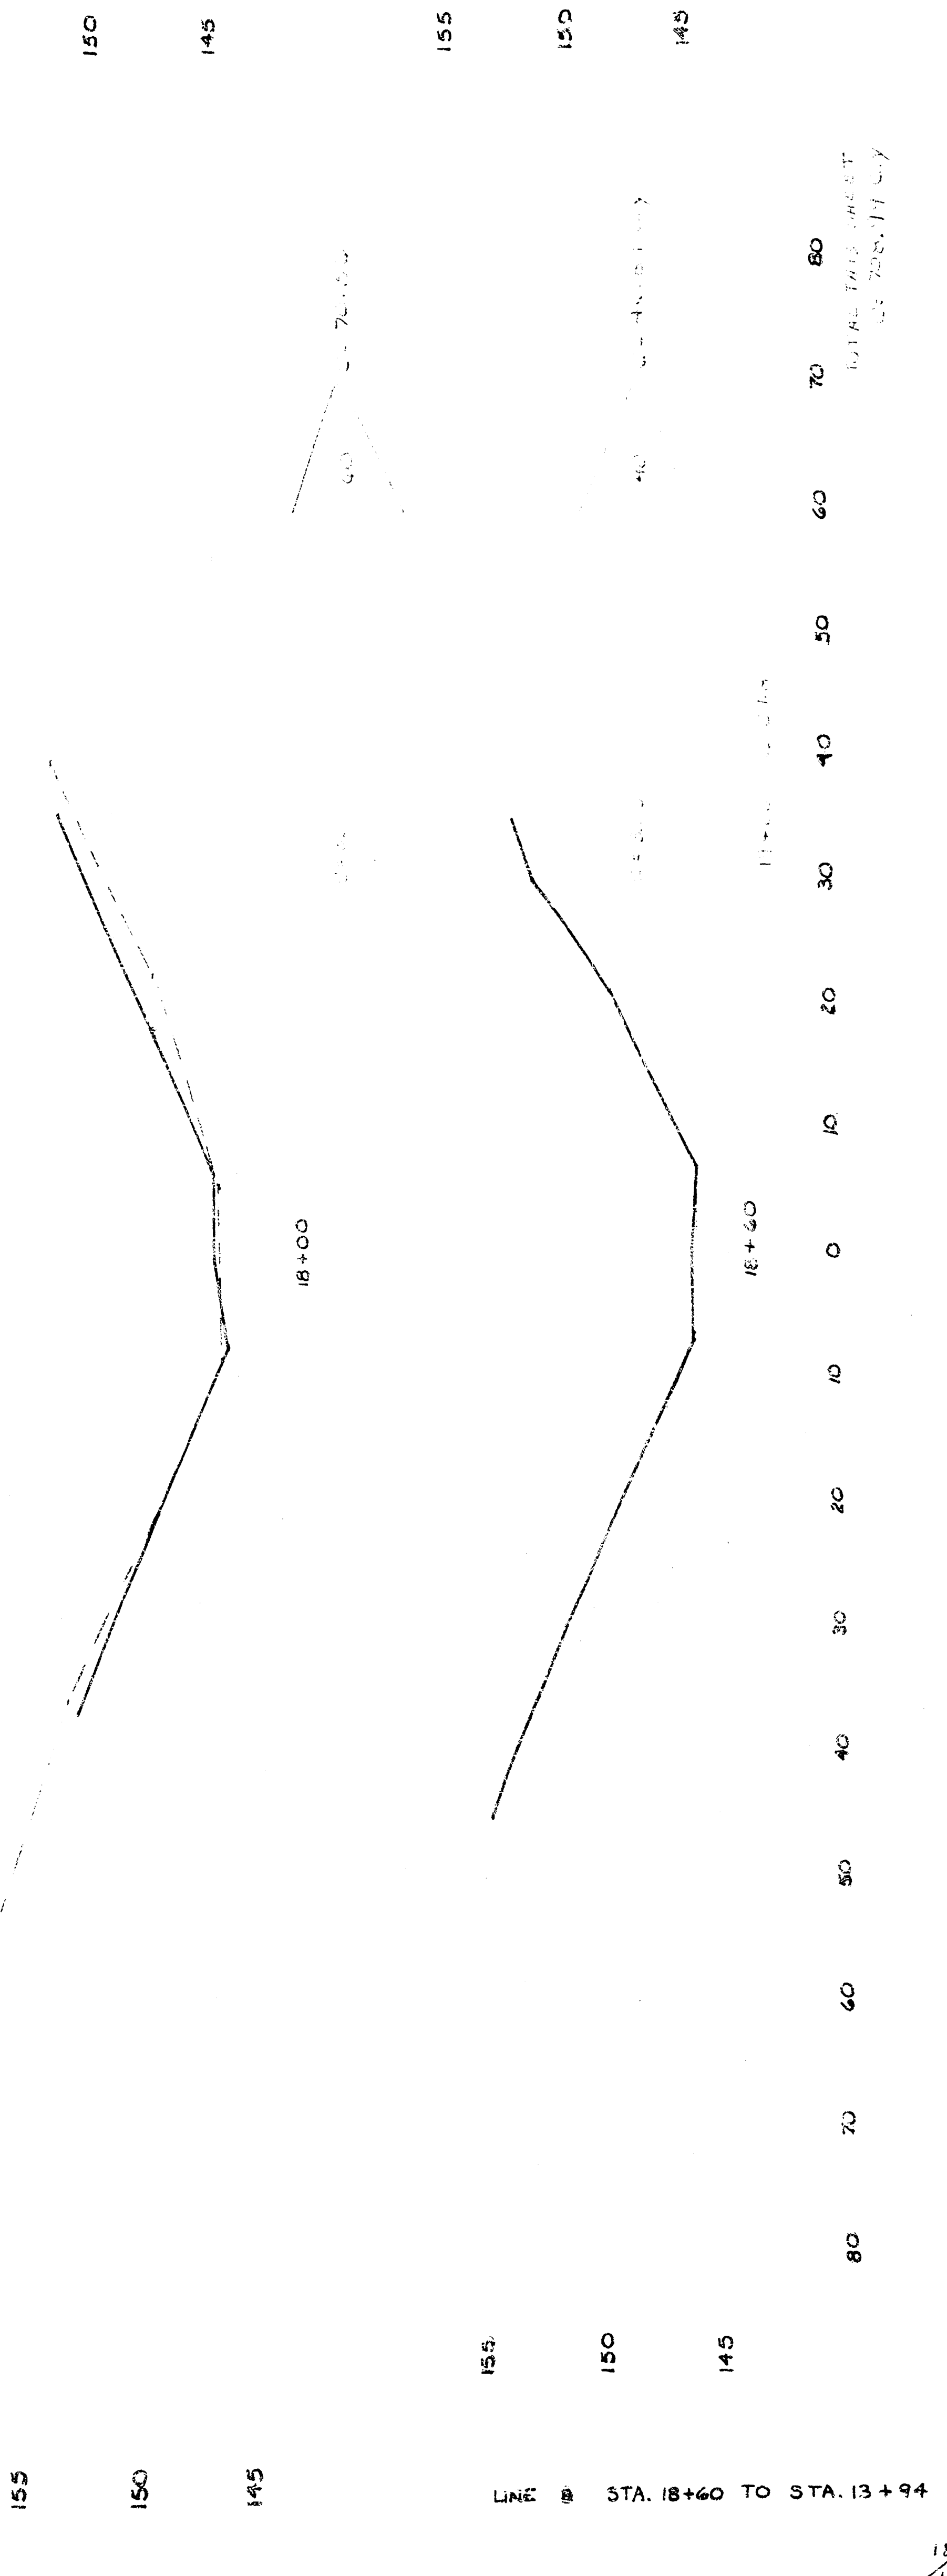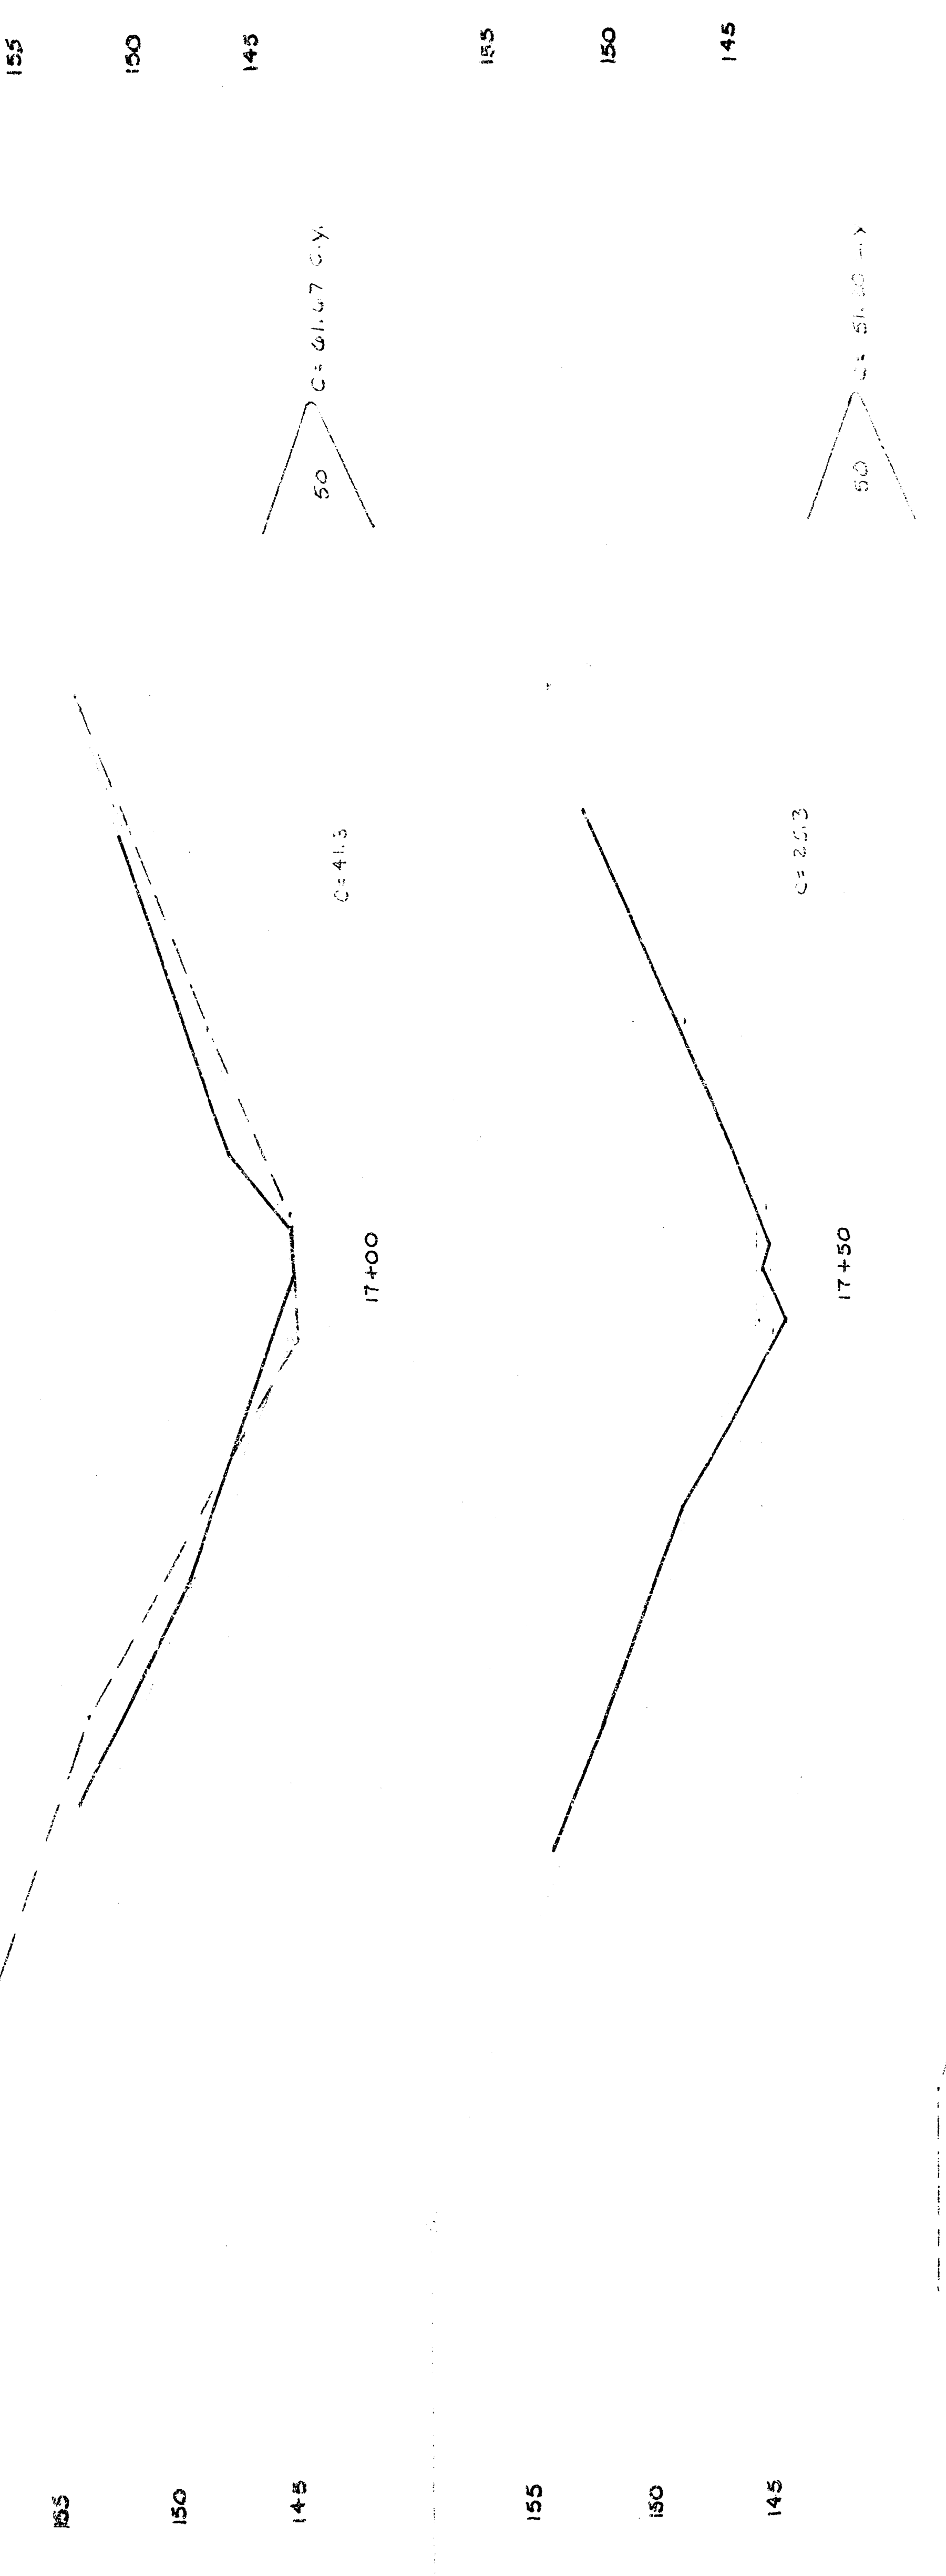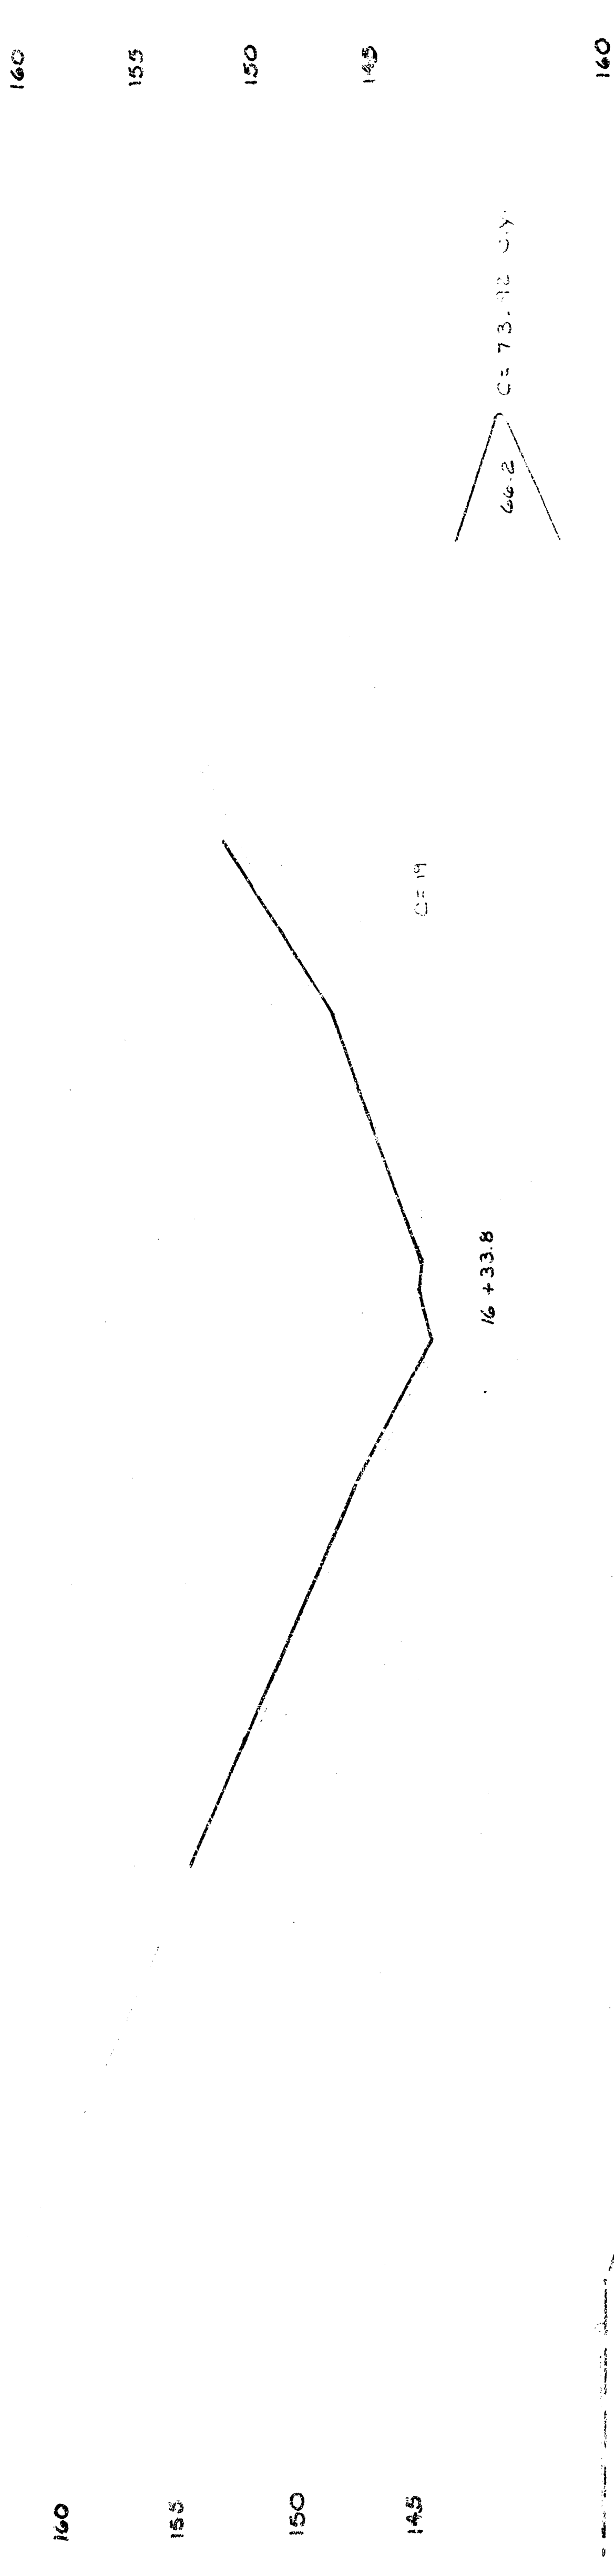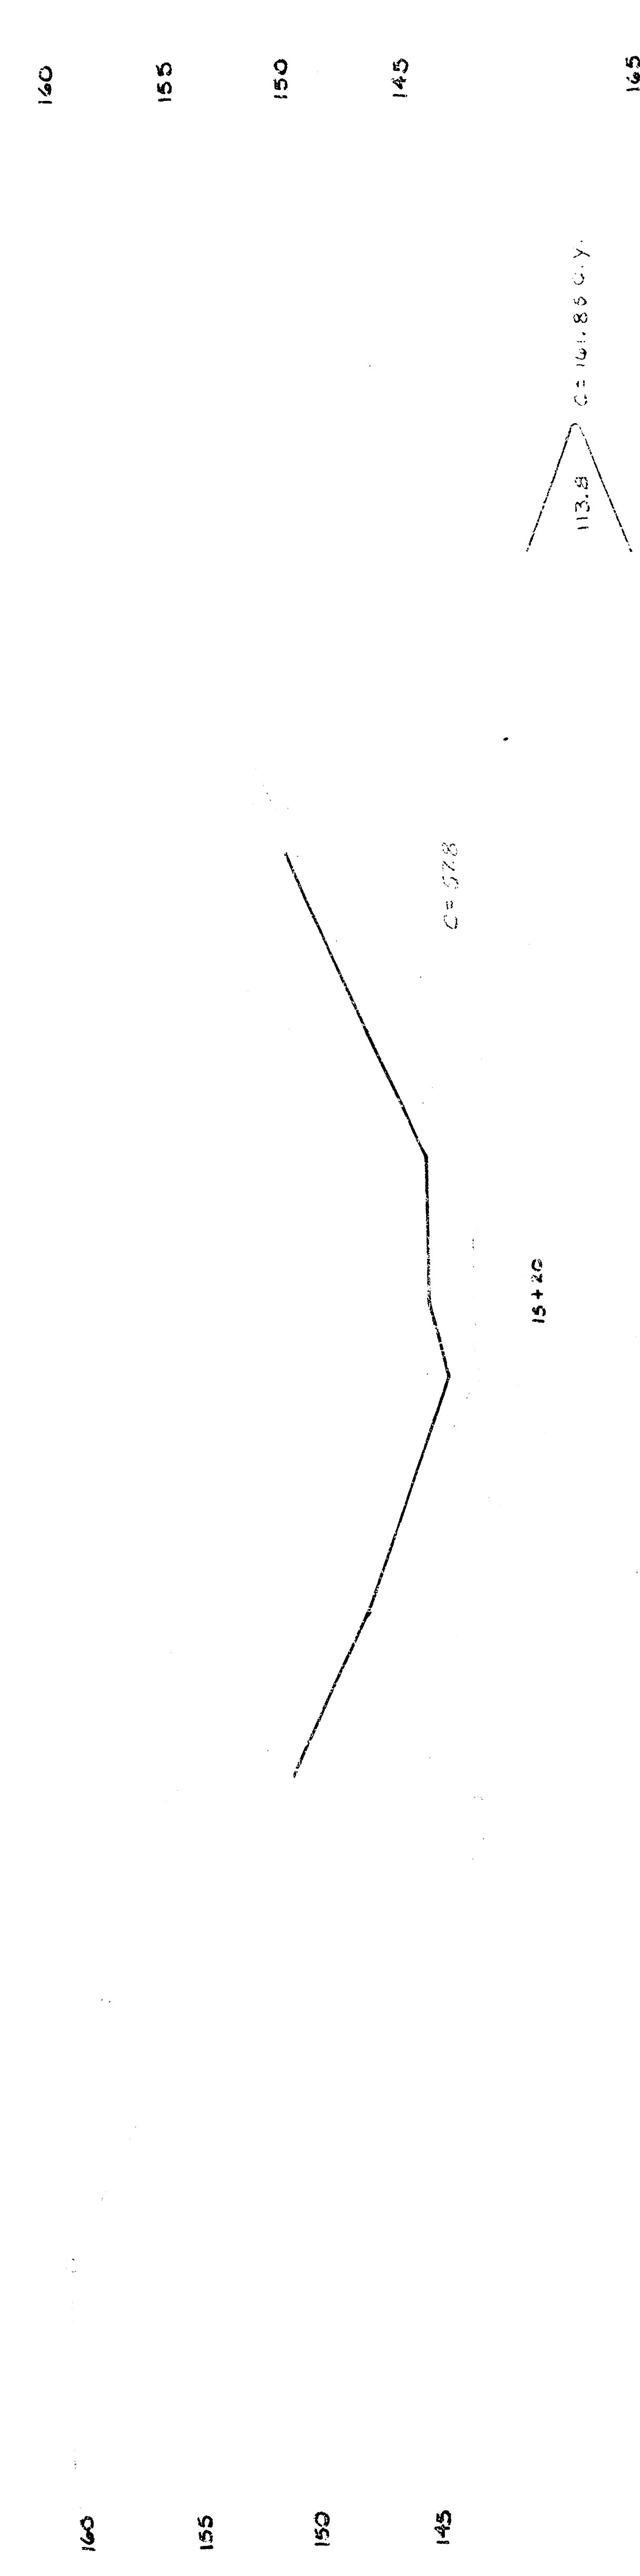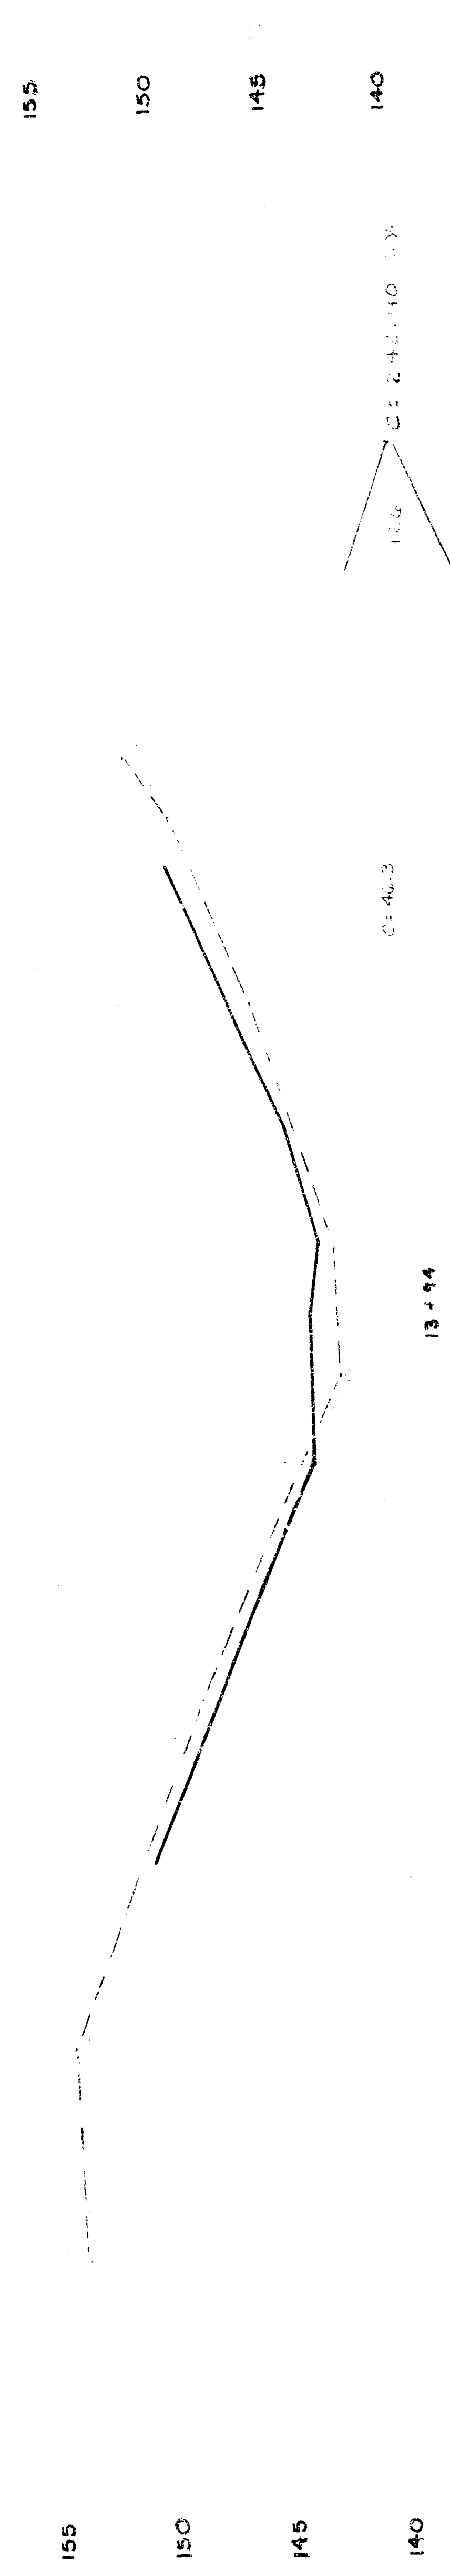

LINE B STA. 18+60 TO STA. 13+94


