

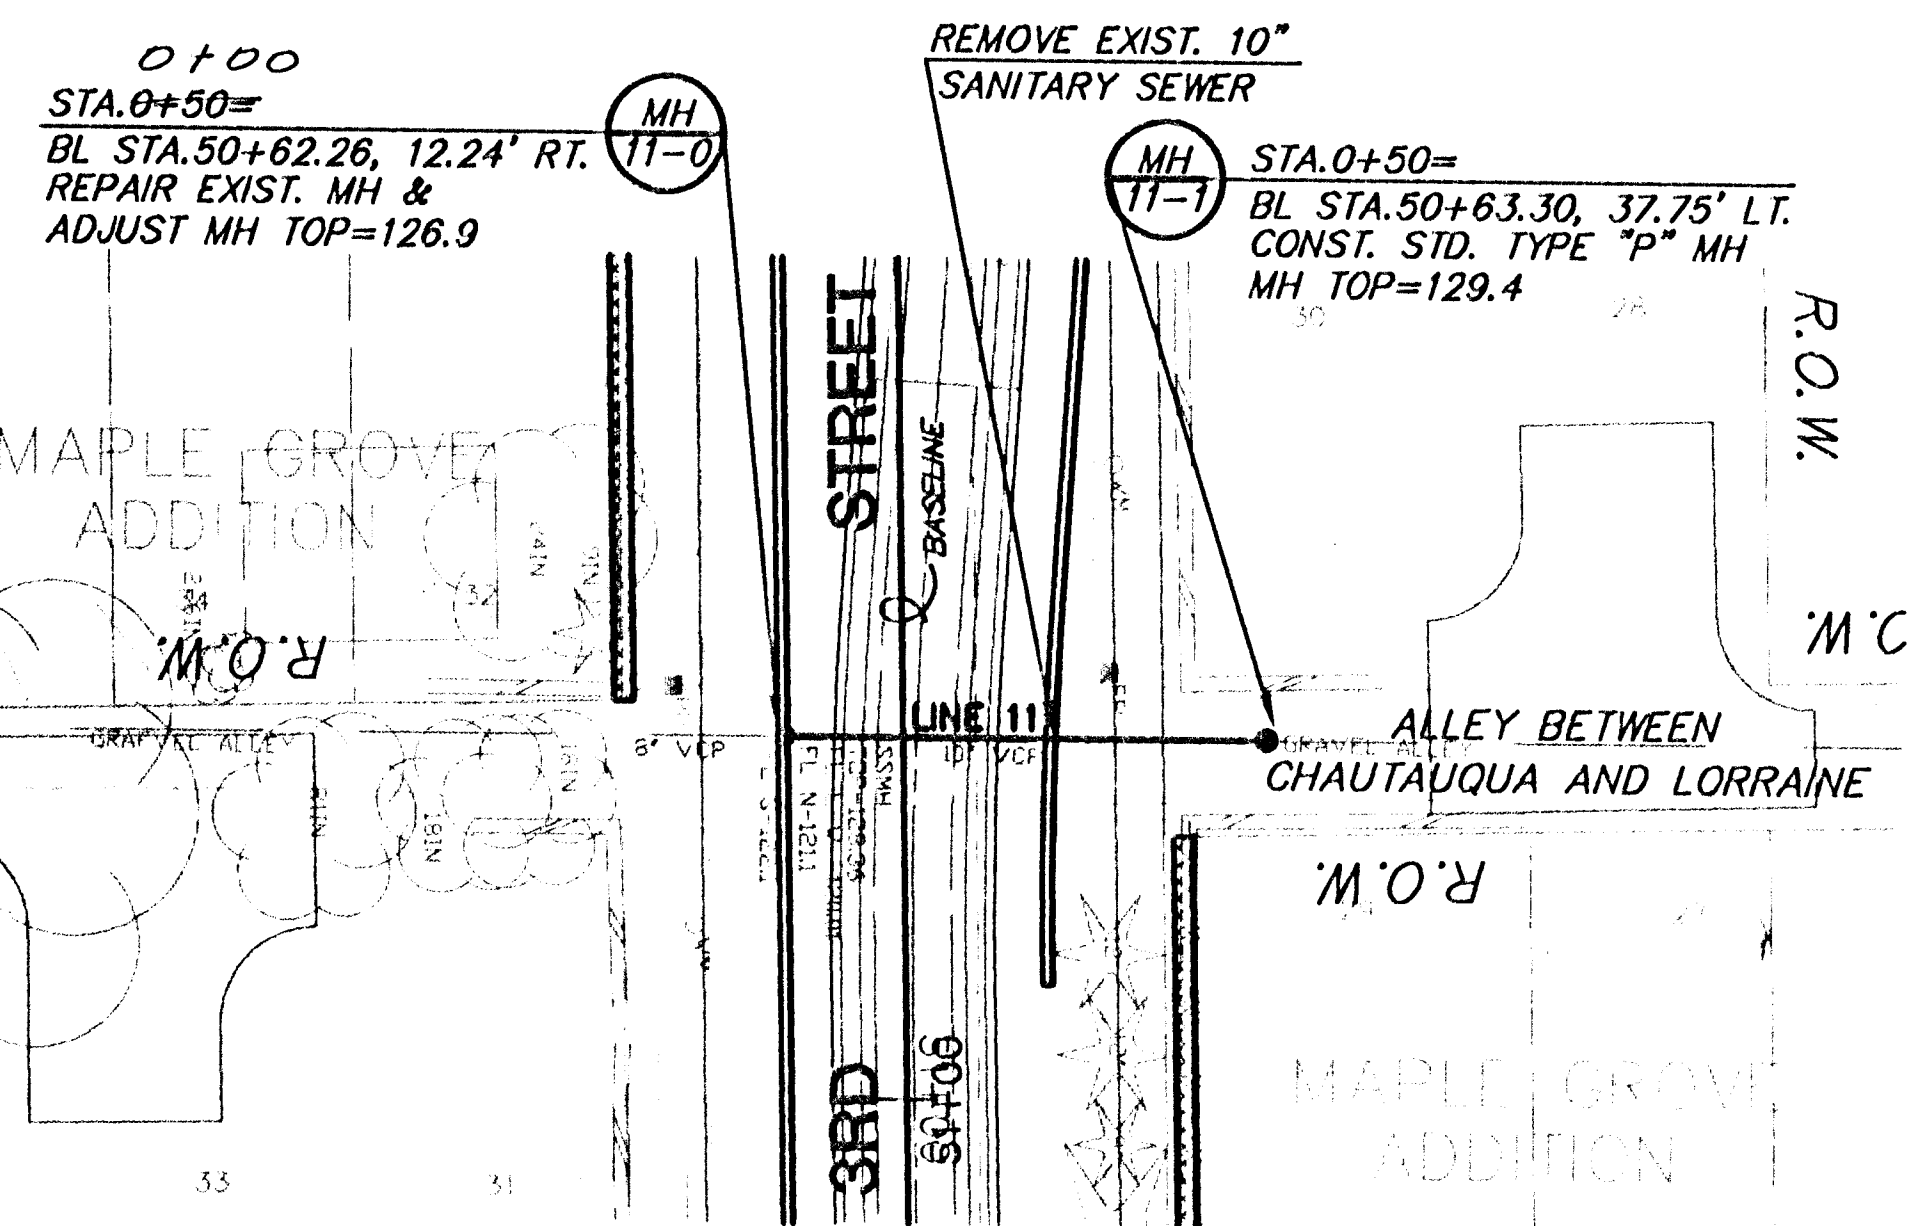


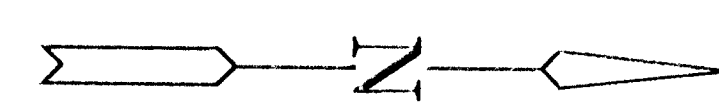


PLAN LINE 11

SCALE: 1"=20'

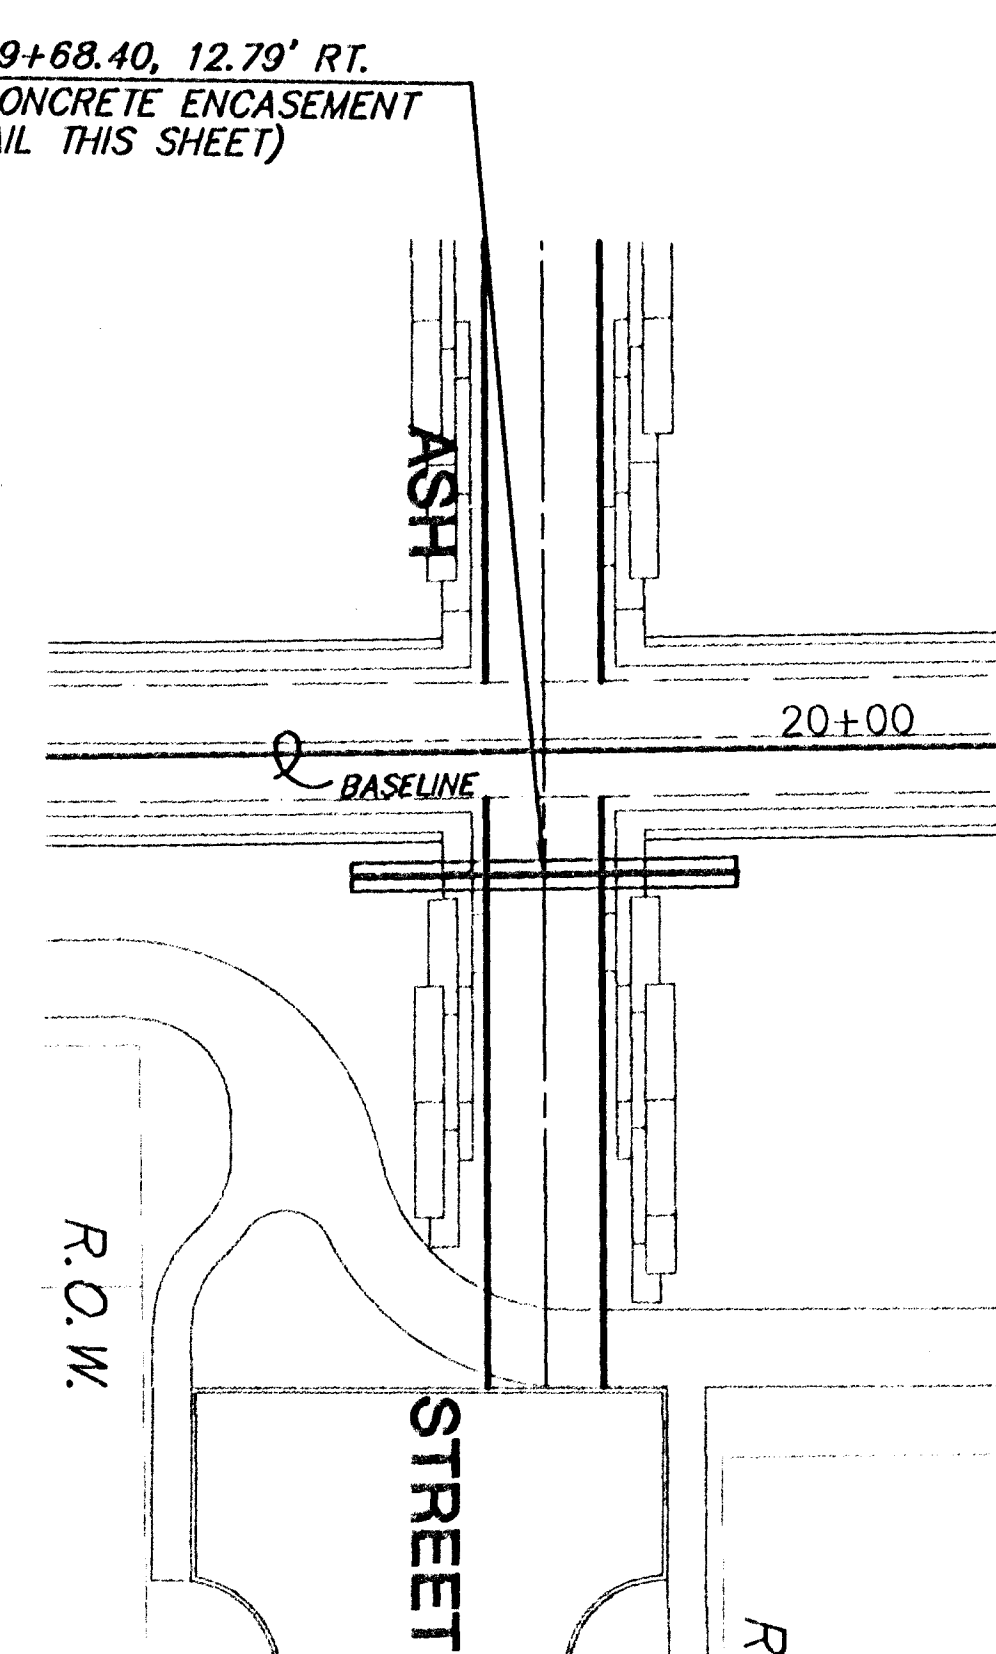


PLAN 24" MAIN

ASH ST. ACCESS CROSSING

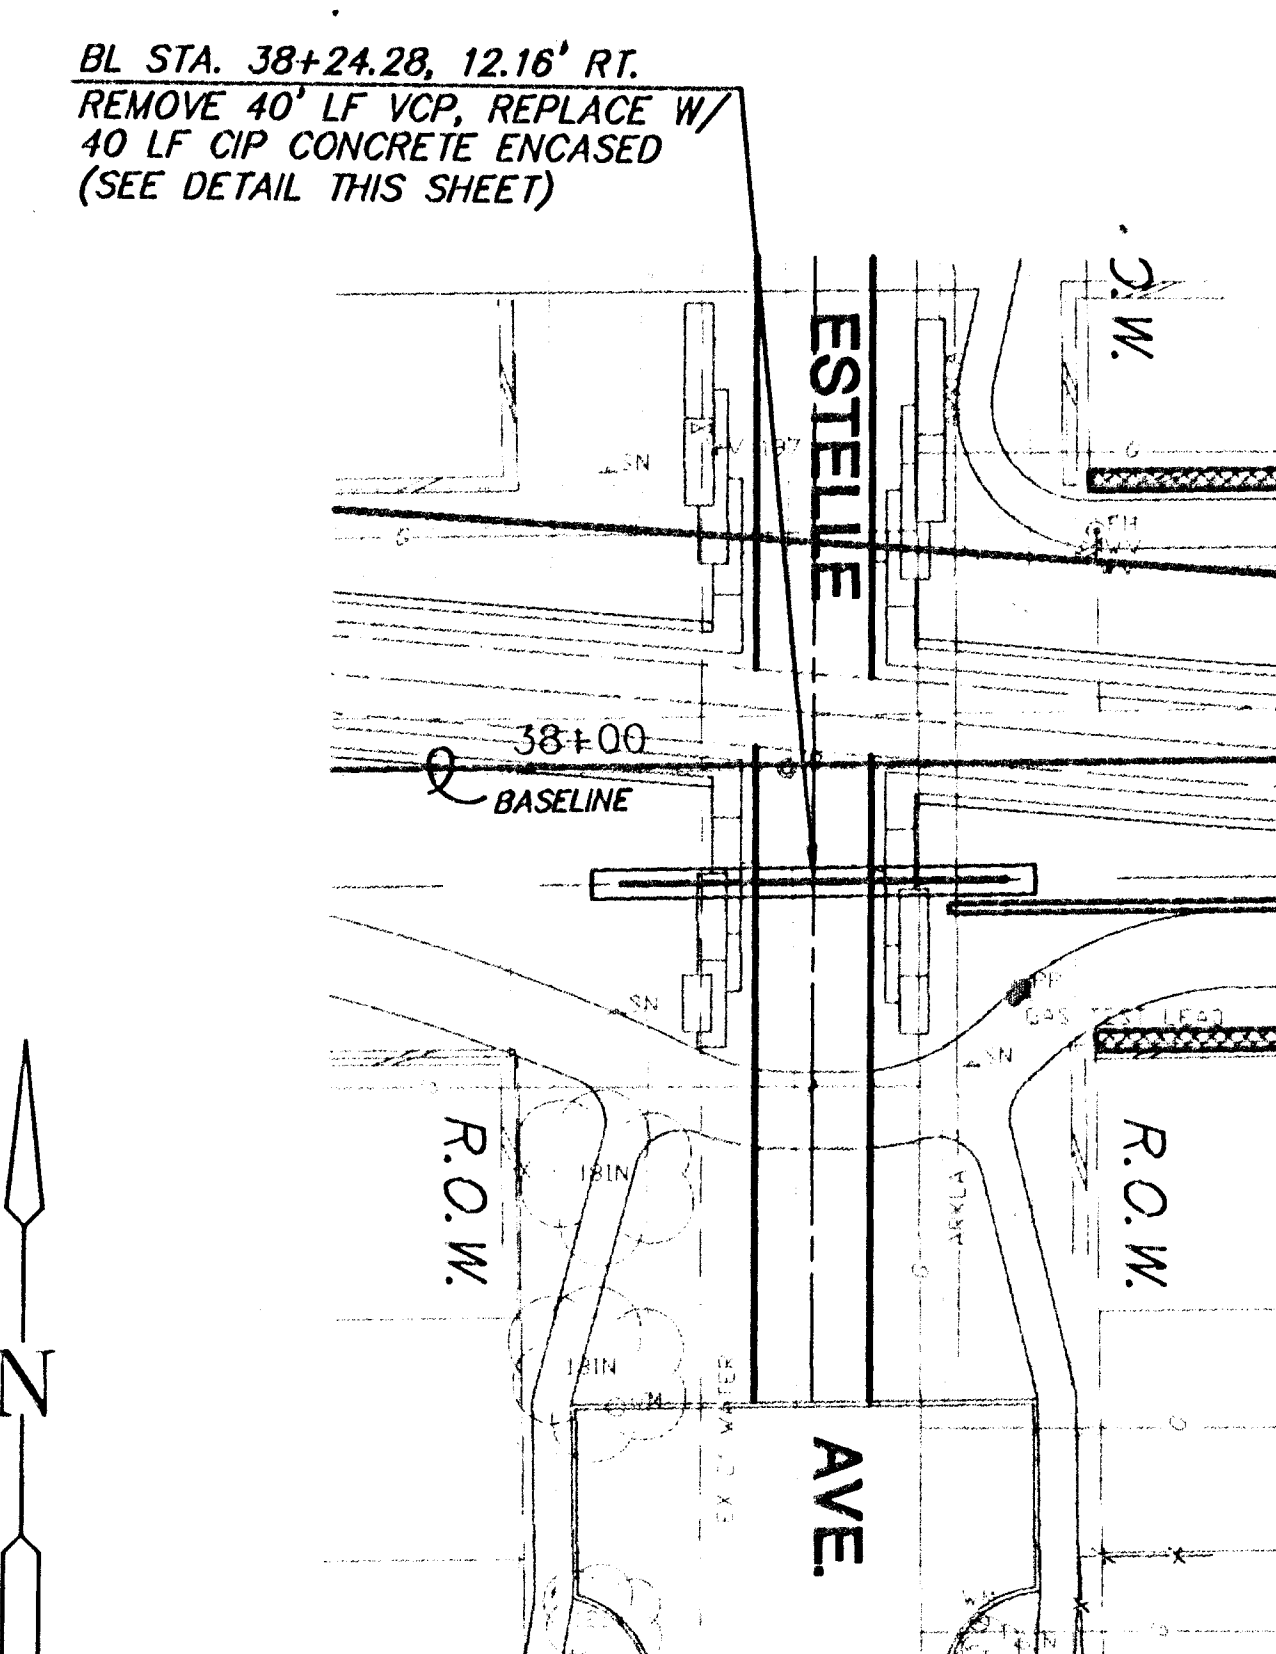


PLAN 24" MAIN

ESTELLE AVE. ACCESS CROSSING

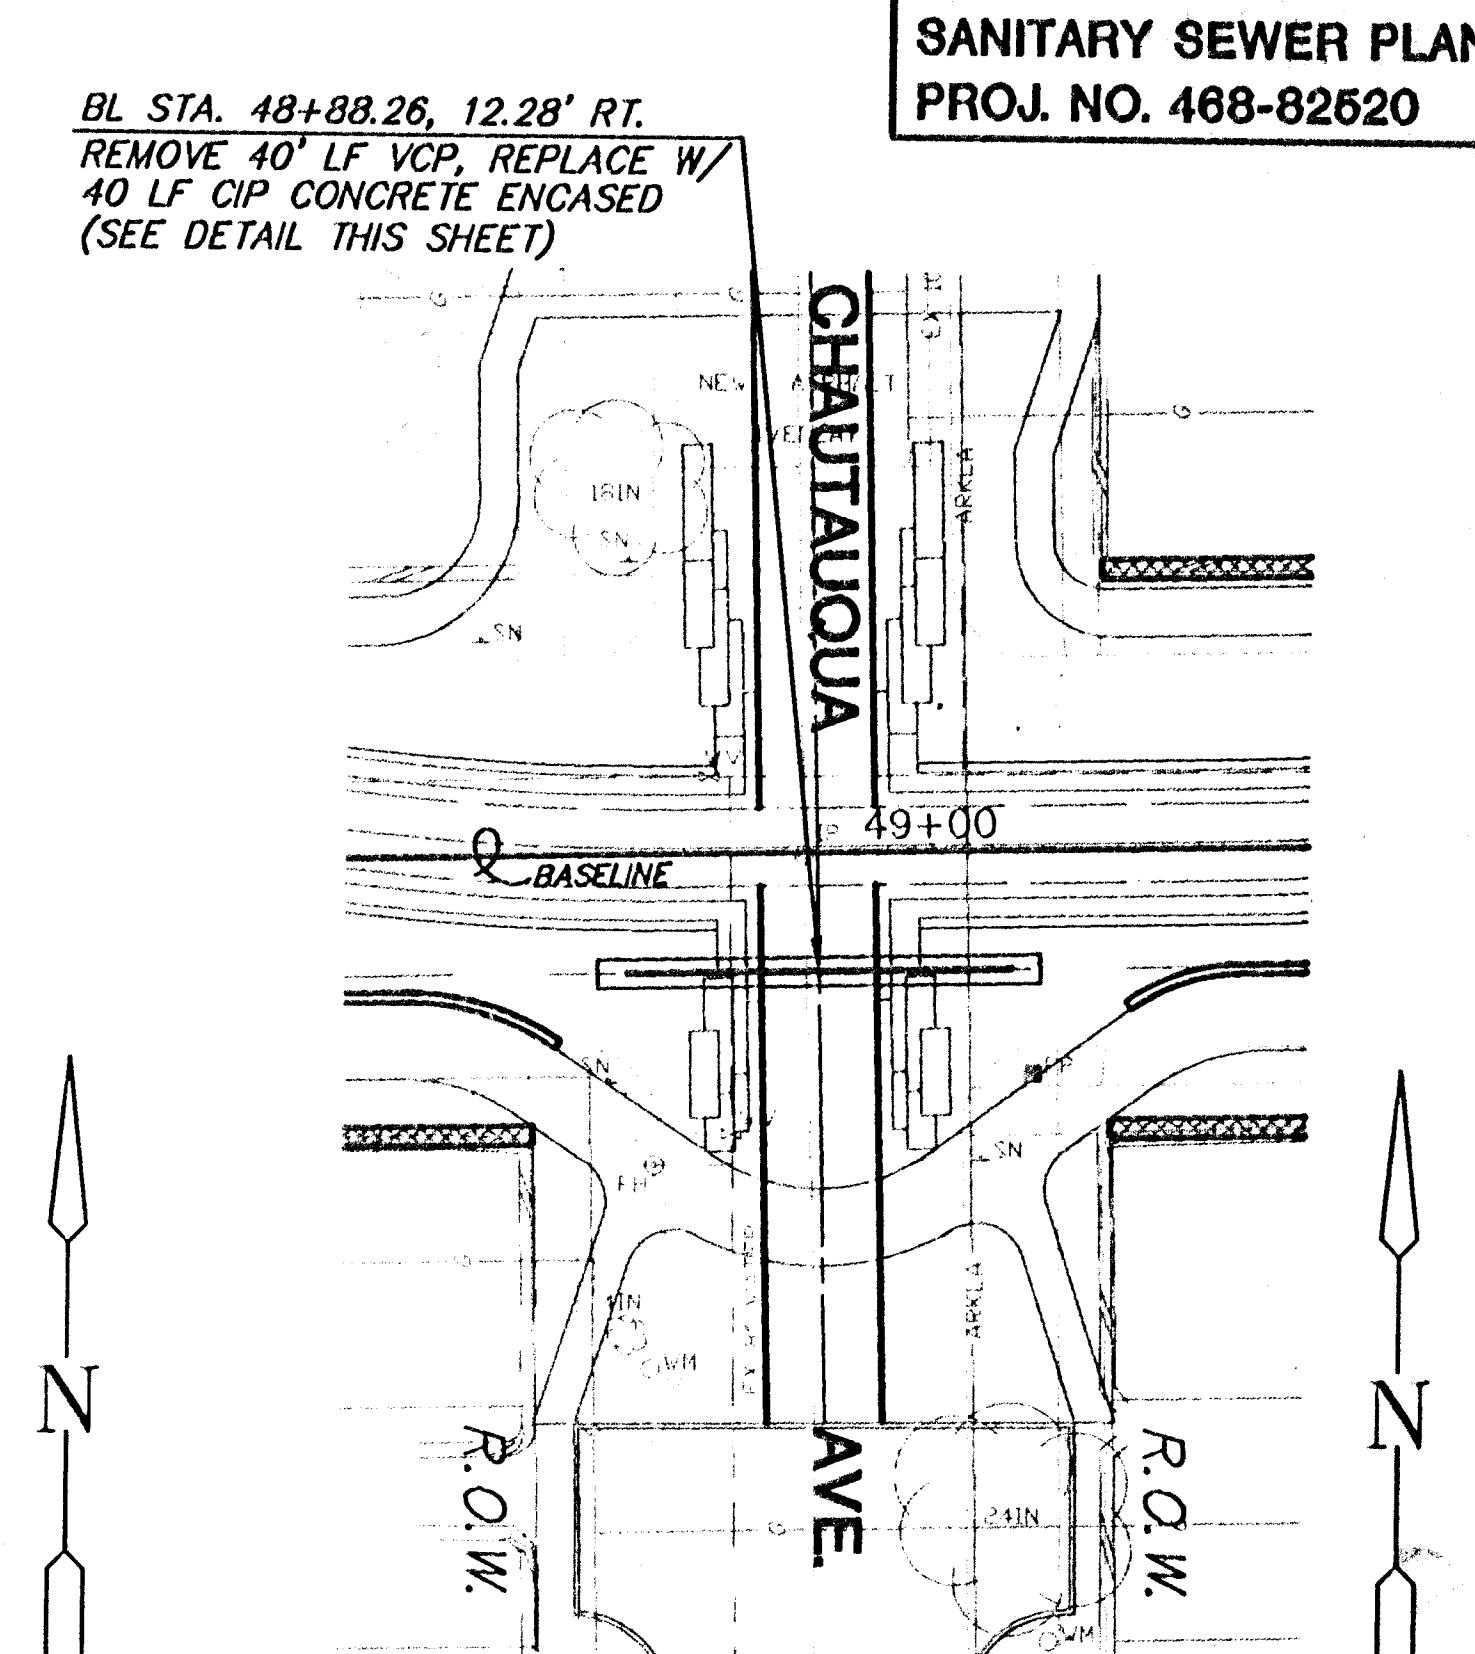


PLAN 24" MAIN

CHAUTAUQUA AVE. ACCESS CROSSING

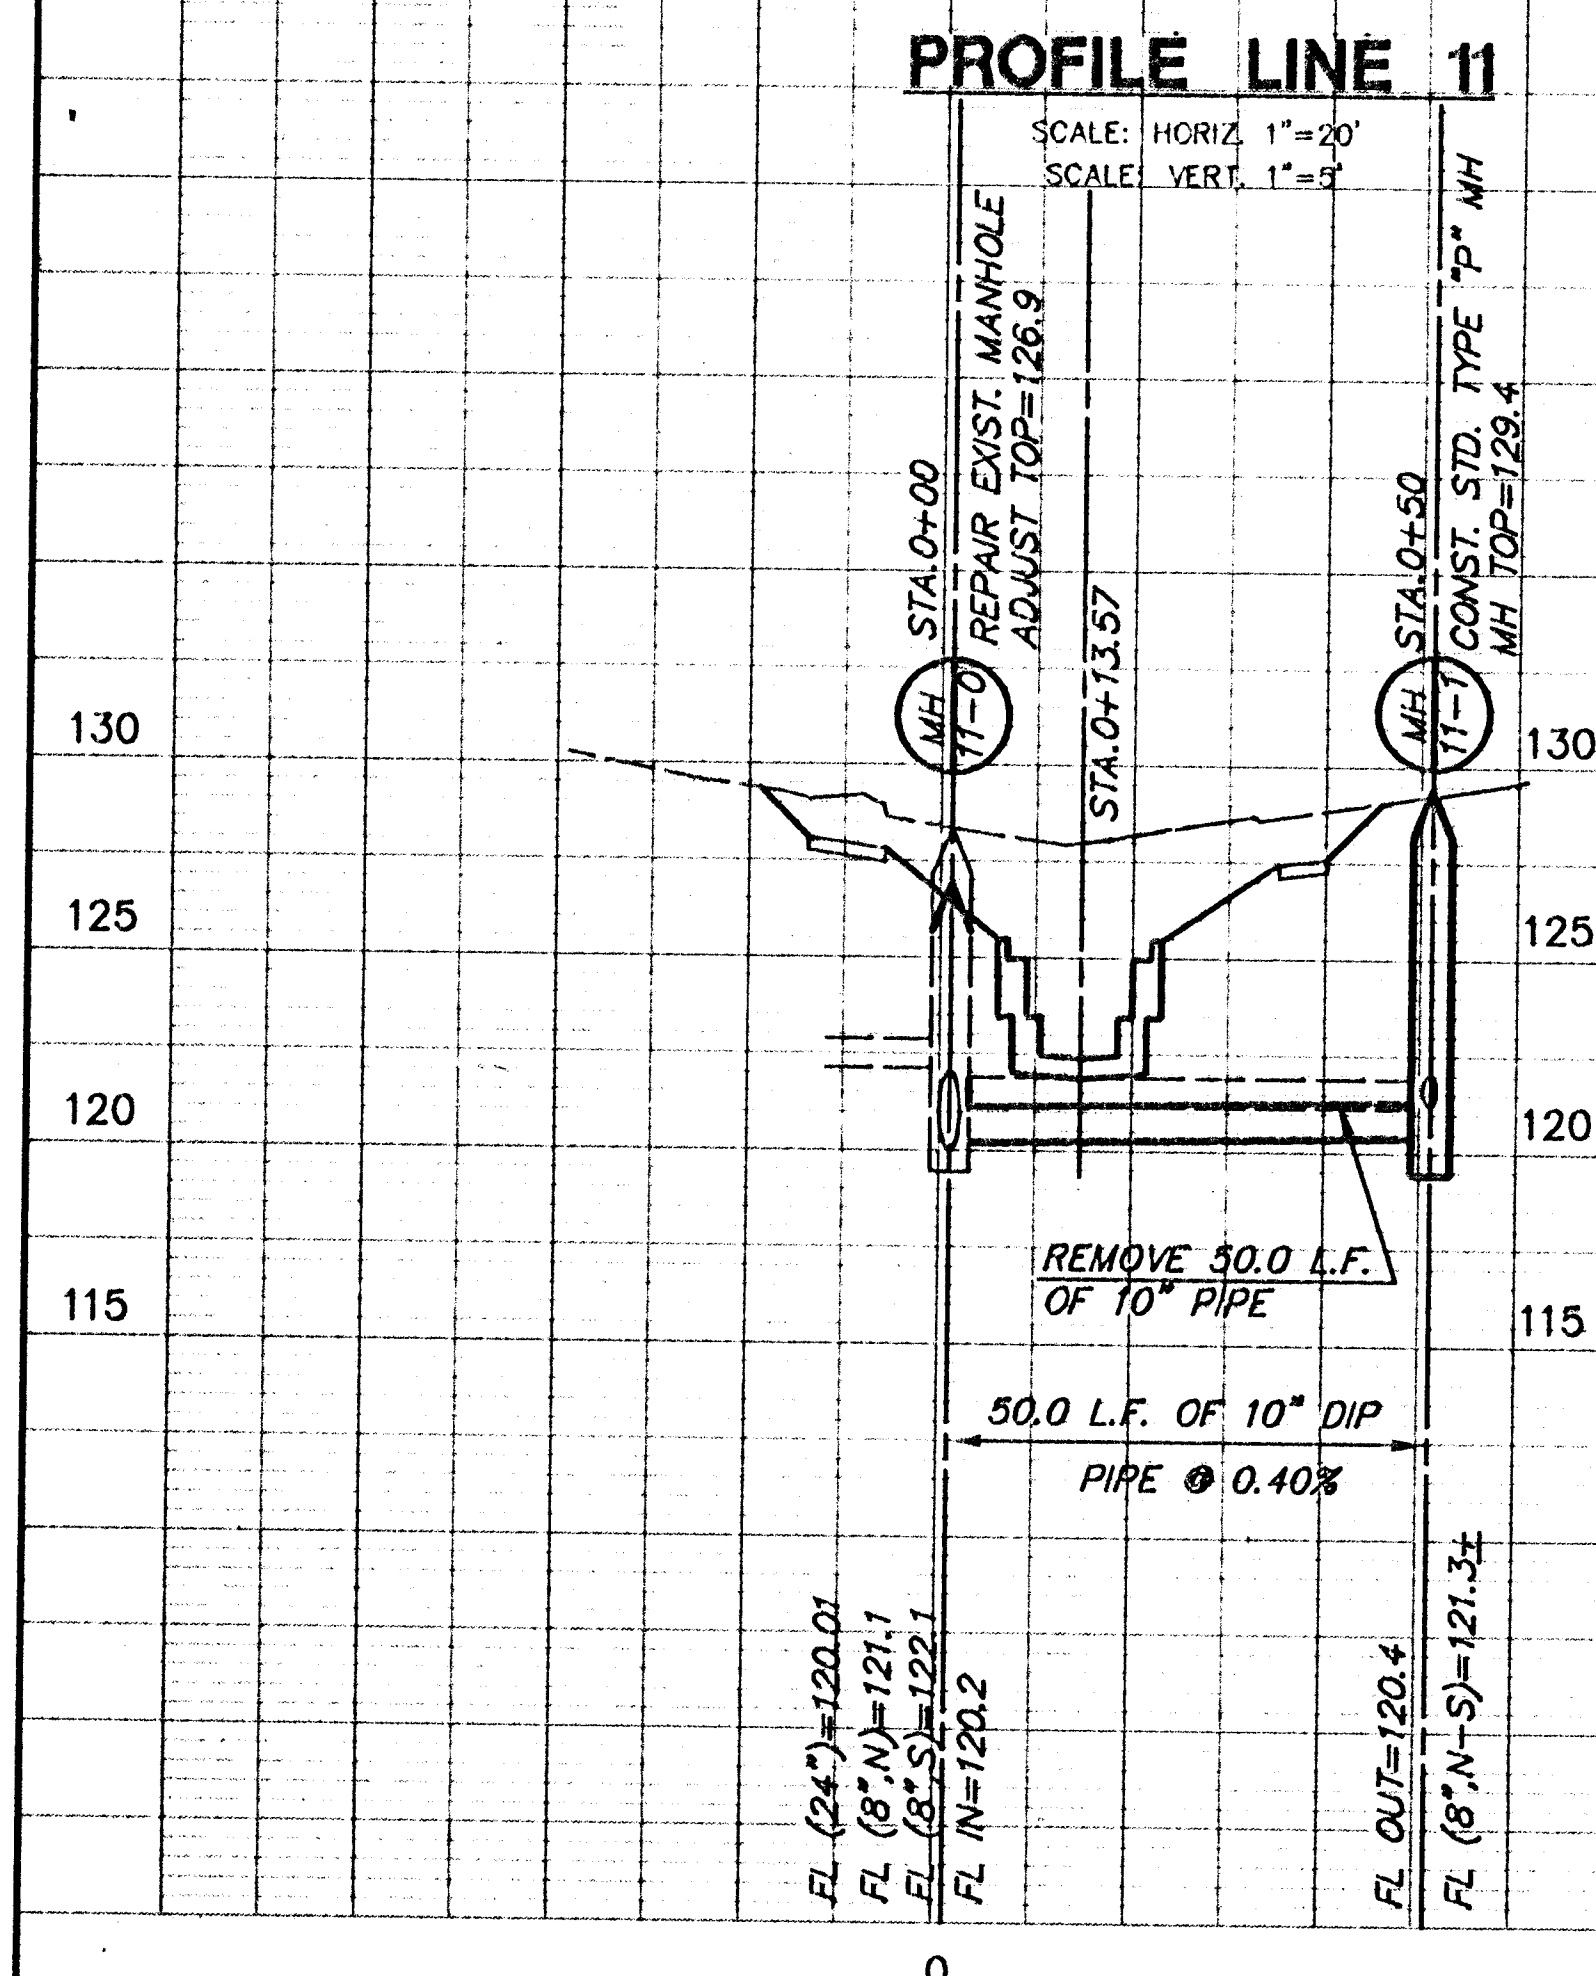


PROFILE LINE 11

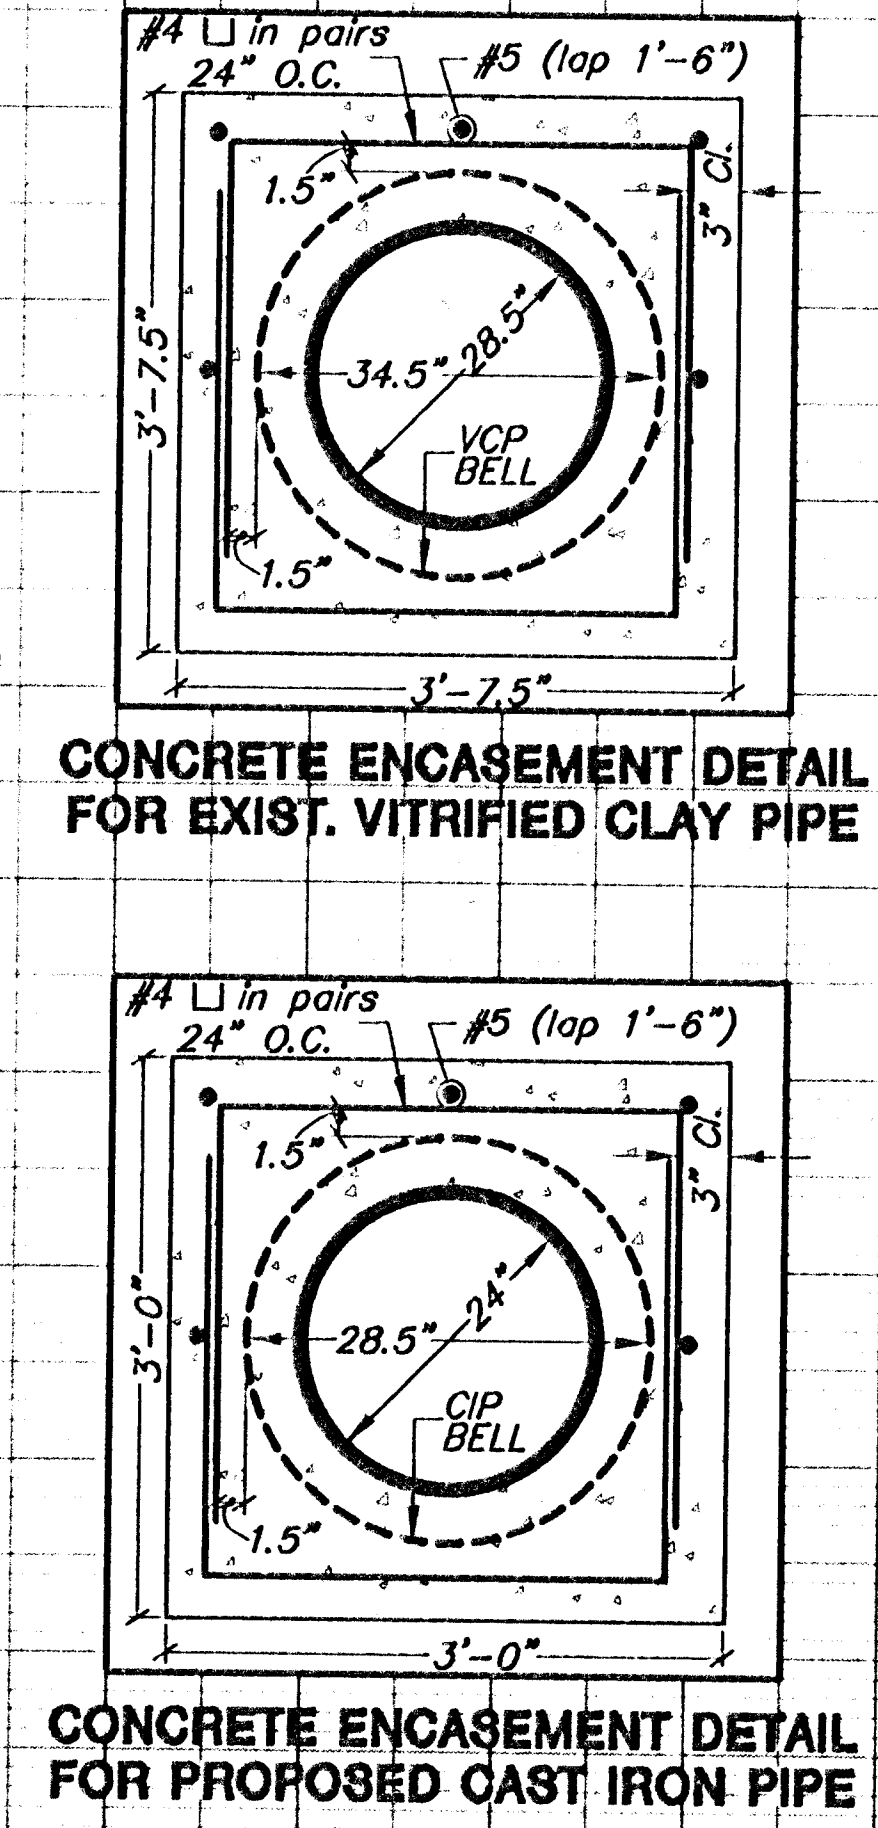


PROFILE 24" MAIN

SCALE: HORIZ. 1"=20'
SCALE: VERT. 1"=5'

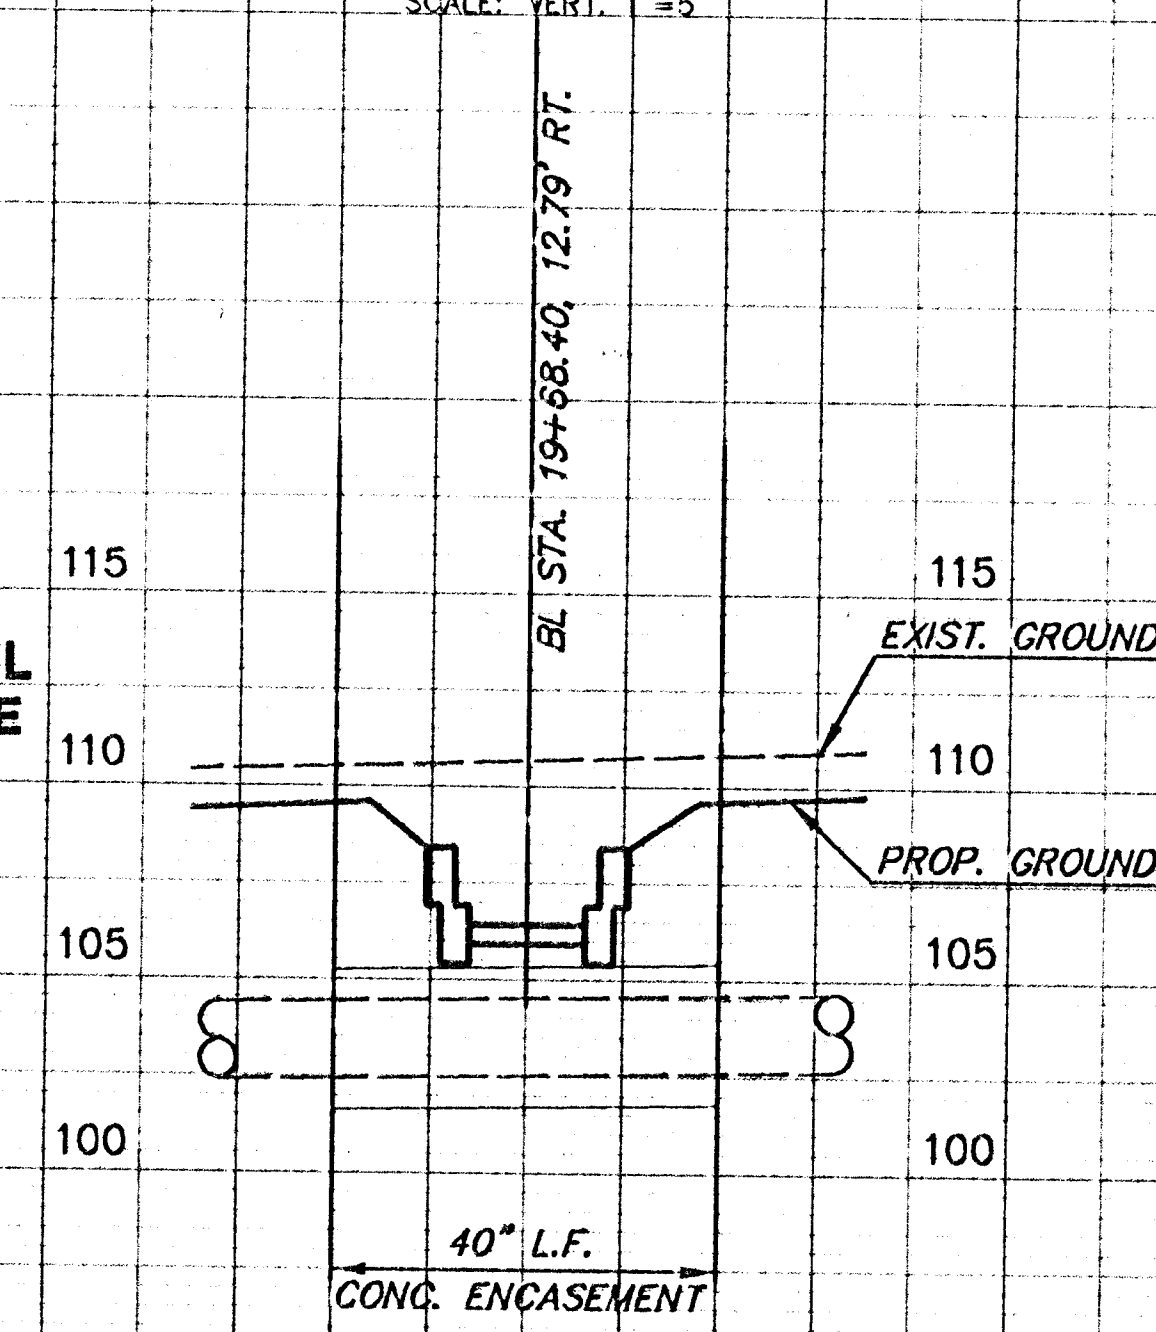


PROFILE 24" MAIN

SCALE: HORIZ. 1"=20'
SCALE: VERT. 1"=5'

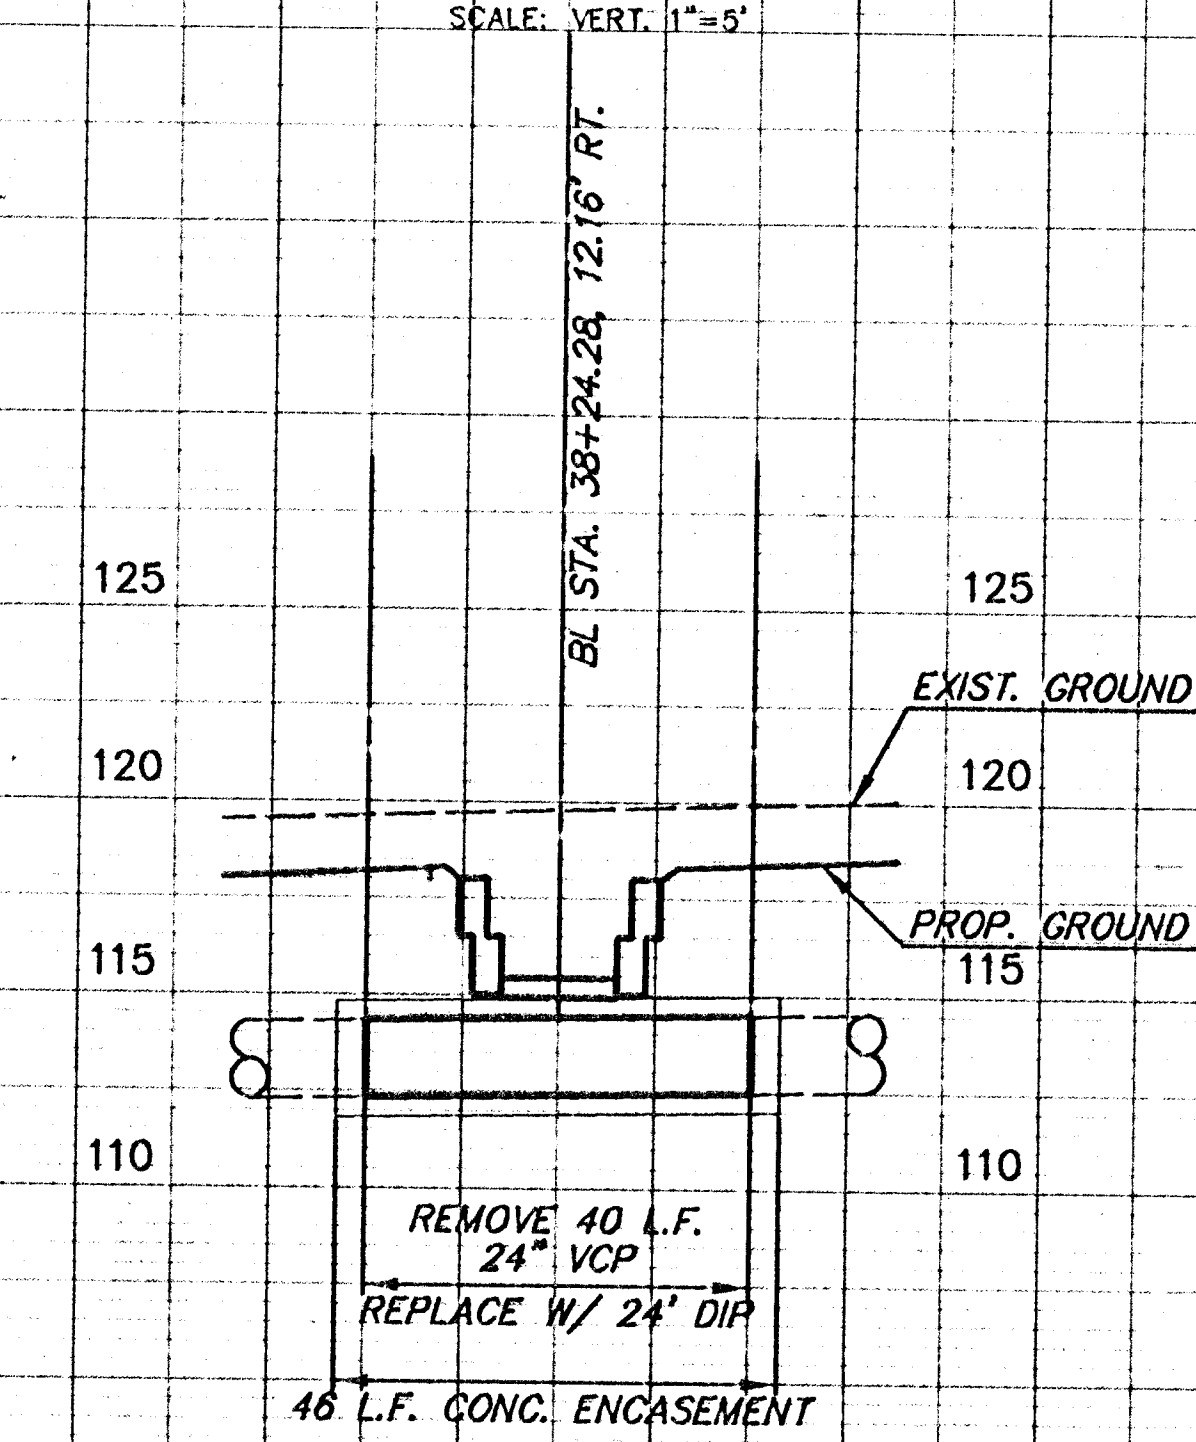

PROFILE 24" MAIN

SCALE: HORIZ. 1"=20'
SCALE: VERT. 1"=5'

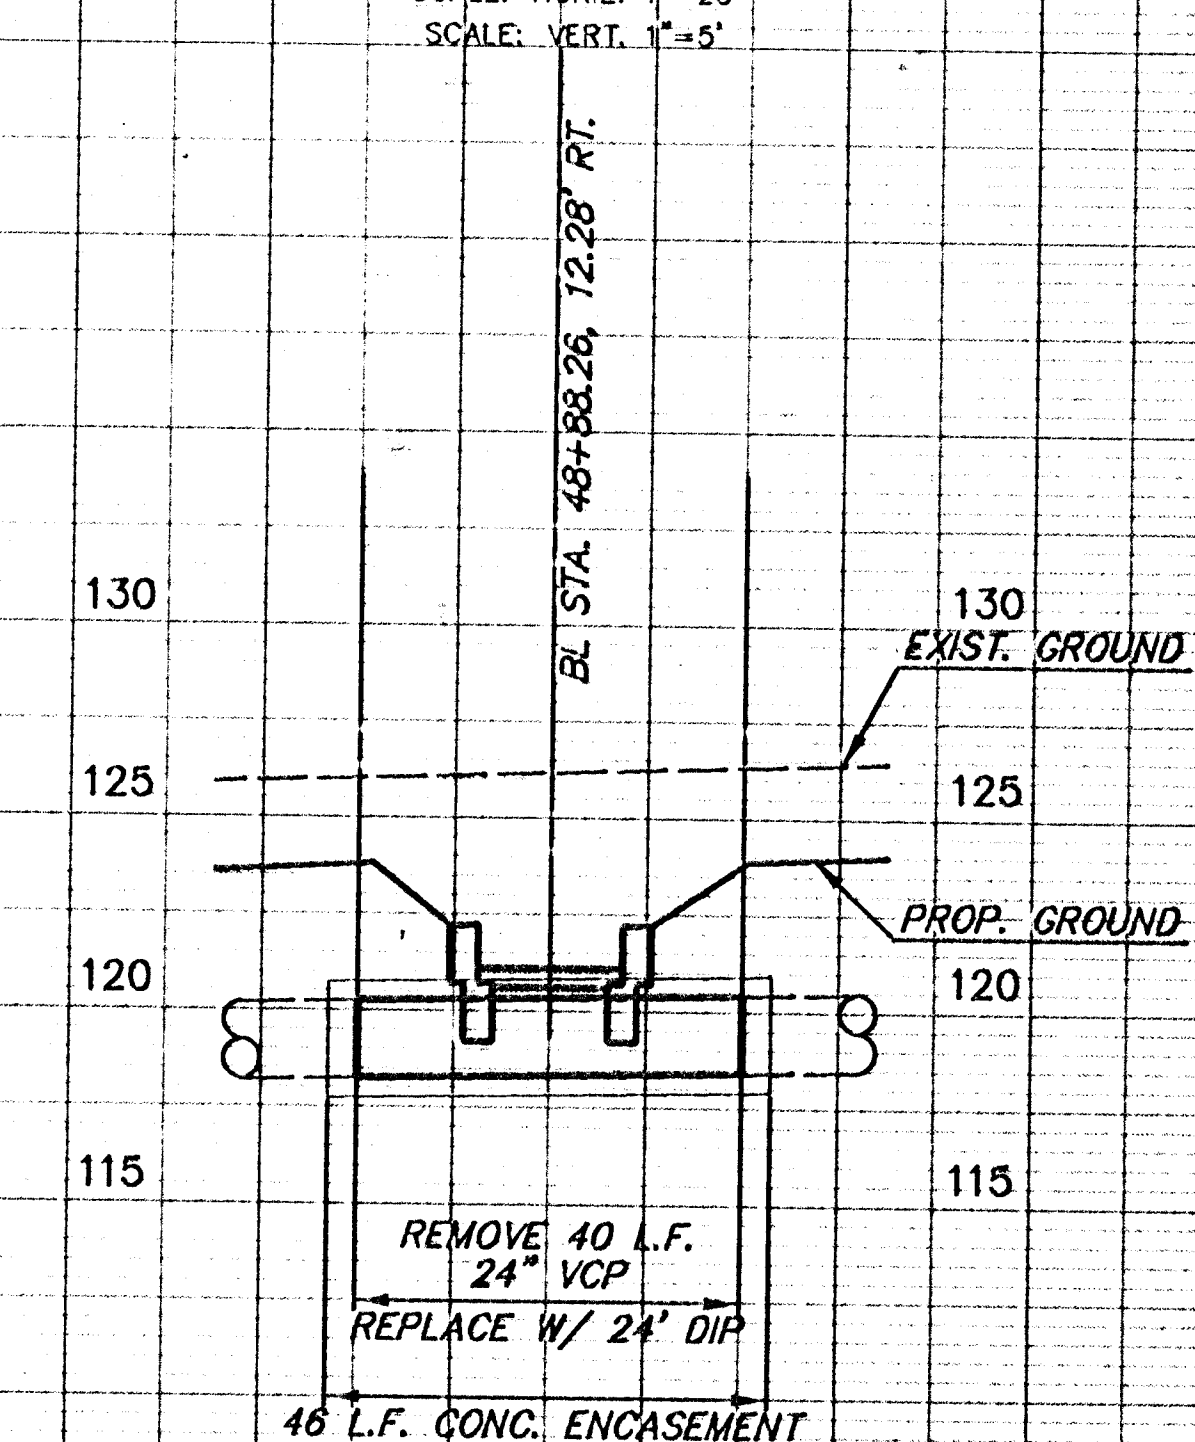

NOTE: CONC. ENCASEMENT CONFLICTS WITH GABIONS. SHAPE GABION CAGES AROUND CONC. ENCASEMENT. USE PIPE ADAPTER AS REQUIRED TO MAKE JOINTS AT VITRIFIED CLAY TO CAST IRON PIPE JUNCTION.

NOTE: CONC. ENCASEMENT CONFLICTS WITH PAVEMENT. TOP OF ENCASEMENT & PAVEMENT SHALL BE INTEGRAL. CONC. ENCASEMENT CONFLICTS WITH GABIONS. SHAPE GABION CAGES AROUND CONC. ENCASEMENT. USE PIPE ADAPTER AS REQUIRED TO MAKE JOINTS AT VITRIFIED CLAY TO CAST IRON PIPE JUNCTION.