


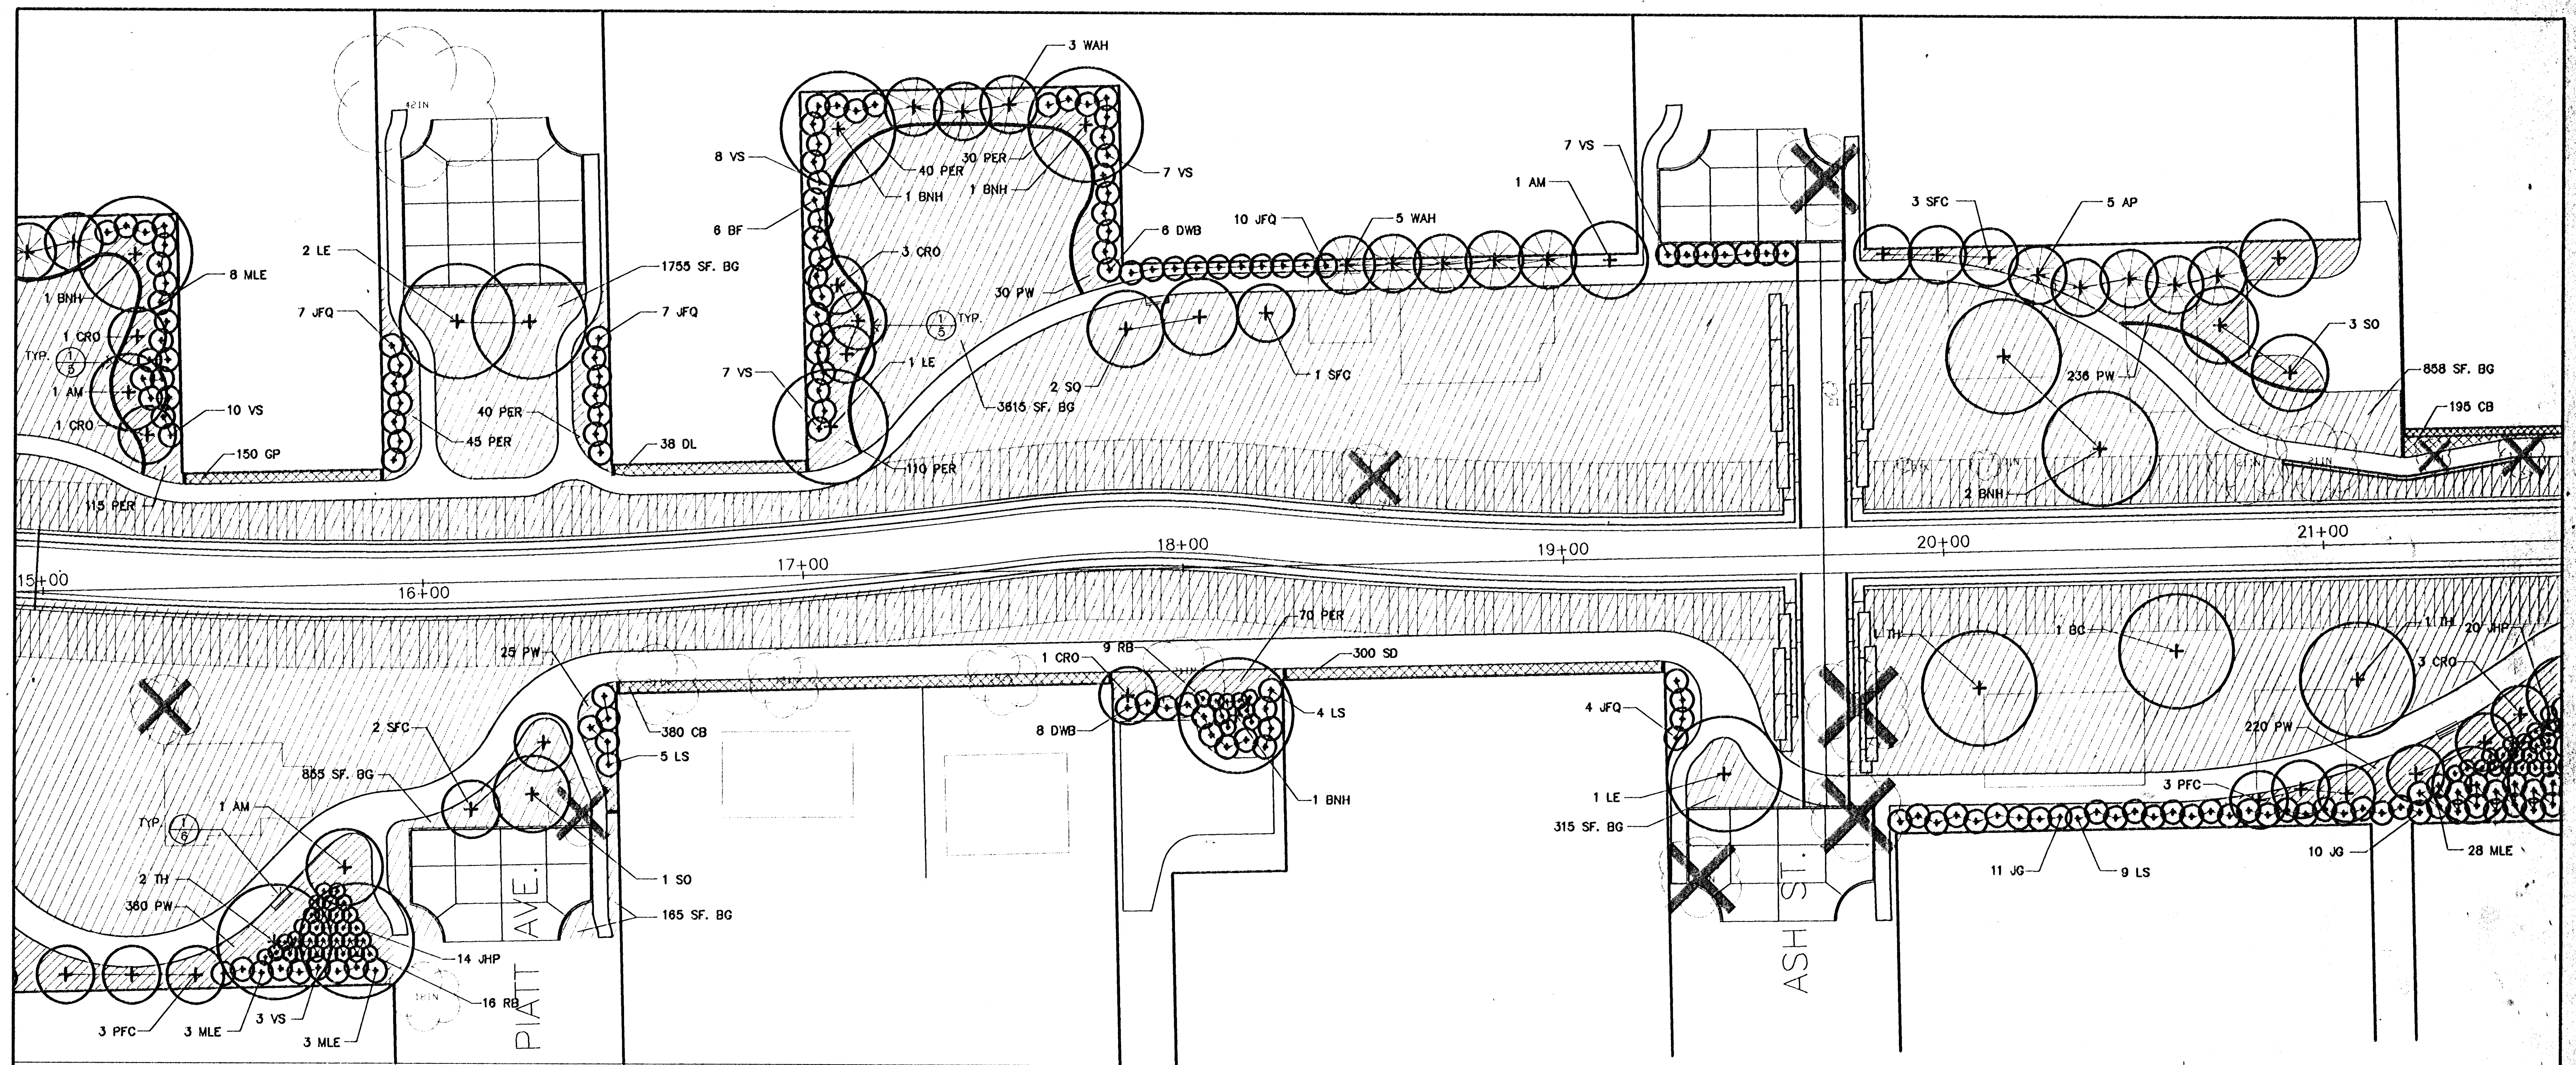

A STATION 15+00.00 TO STATION 21+00.00


PLANT LIST FOR THIS SHEET

KEY	QTY.	COMMON NAME	BOTANICAL NAME	SIZE	CONDITION
LARGE DECIDUOUS TREES					
BNH	6	RIVER BIRCH	<i>Betula nigra</i> 'Heritage'	2" to 2 1/2" cal.	Balled-in-Burlap
TH	4	THORNLESS HONEYLOCUST	<i>Gleditsia triacanthos</i> 'Shademaster'	2" to 2 1/2" cal.	Balled-in-Burlap
LE	4	LACEBARK ELM	<i>Ulmus parvifolia</i>	2" to 2 1/2" cal.	Balled-in-Burlap
BC	1	BALD CYPRESS	<i>Taxodium distichum</i>	2" to 2 1/2" cal.	Balled-in-Burlap
SMALL TO MEDIUM DECIDUOUS TREES					
AM	3	AMUR MAPLE	<i>Acer glabrum</i> 'Flame'	2" to 2 1/2" cal.	Balled-in-Burlap
CRO	9	OKLAHOMA REDBUD	<i>Cercis reniformis</i> 'Oklahoma'	2" to 2 1/2" cal.	Balled-in-Burlap
WAH	8	WASHINGTON HAWTHORN	<i>Crataegus phaenopyrum</i> 'Select'	2" to 2 1/2" cal.	Balled-in-Burlap
PFC	6	FLOWERING CRABAPPLE	<i>Malus spp.</i> 'Prairiefire'	2" to 2 1/2" cal.	Balled-in-Burlap
SFC	6	FLOWERING CRABAPPLE	<i>Malus spp.</i> 'Spring Snow'	2" to 2 1/2" cal.	Balled-in-Burlap
SO	6	SAWTOOTH OAK	<i>Quercus acutissima</i>	2" to 2 1/2" cal.	Balled-in-Burlap
SMALL TO MEDIUM BROADLEAF EVERGREEN TREES					
AP	5	AUSTRIAN PINE	<i>Pinus nigra</i>	2" to 2 1/2" cal.	Balled-in-Burlap
MEDIUM TO LARGE DECIDUOUS SHRUBS					

RB	25	REDFEAF BARBERRY	<i>Berberis thunbergii</i> 'atropurpurea'	5 gal.	Container
JFQ	28	JAPANESE FLOWERING QUINCE	<i>Chaenomeles japonica</i>	5 gal.	Container
DWB	14	DWARF WINGED BURNING BUSH	<i>Euonymus alatus</i> 'compacta'	5 gal.	Container
MLE	42	MEDIUM LEAF EUONYMUS	<i>Euonymus kiautschovicus</i>	5 gal.	Container
BF	8	BORDER FORSYTHIA	<i>Forsythia x intermedia</i>	5 gal.	Container
LS	25	LILAC	<i>Lilac Syringe</i>	5 gal.	Container
VS	42	VANHOUTT SPIREA	<i>Spiraea x vanhouttei</i>	5 gal.	Container
EVERGREEN SHRUB					
JHP	34	ANDORRA JUNIPER	<i>Juniperus horizontalis</i> 'Plumosa'	2 gal.	Container
JG	21	JAPANESE GARDEN JUNIPER	<i>Juniperus procumbens</i>	5 gal.	Container
GROUNDCOVERS					
PW	871	PURPLELEAF WINTERCREEPER	<i>Euonymus fortunei</i> 'coloratus'	1 gal., 24" O.C.	Container
PER	450	PERIWINKLE	<i>Vinca minor</i>	1 gal., 24" O.C.	Container
PERENNIALS					
DL	38	DAYLILY	<i>Hemerocallis hybrids</i>	1 gal., 24" O.C.	Container
CB	575	COREL BELLS	<i>Heuchera sanguinea</i>	2 1/4" pot, 18" O.C.	Container
SD	300	SHASTA DAISY	<i>Chrysanthemum superbum</i>	2 1/4" pot, 18" O.C.	Container
GP	150	GARDEN PHLOX	<i>Phlox paniculata</i>	4" pot, 18" O.C.	Container
GRASS					
BG	7583 SF.	COMMON BERMUDA GRASS	<i>Cynodon dactylon</i>	Seed	Drilled

NOTE

- CONSTRUCTION OF SANITARY SEWER SEE SHEET 4-10
- CONSTRUCTION OF STORM WATER SEWER SEE SHEET 11-15
- CONSTRUCTION OF PAVED CHANNEL SEE SHEET 16-23
- CONSTRUCTION OF PAVED CUL-DE-SACS SEE SHEET 24-33
- CONSTRUCTION OF PEDESTRIAN BRIDGE SEE SHEET 41-42
- CONSTRUCTION OF SIDEWALK/PATHWAY SEE SHEET 34-40

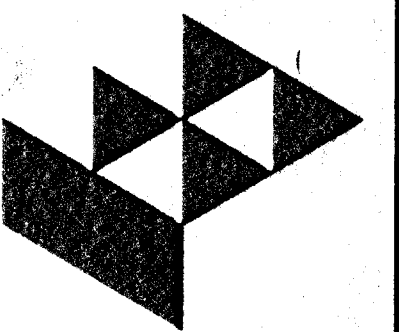

GessonLivingston

Architectural
Landscape
Plans
