



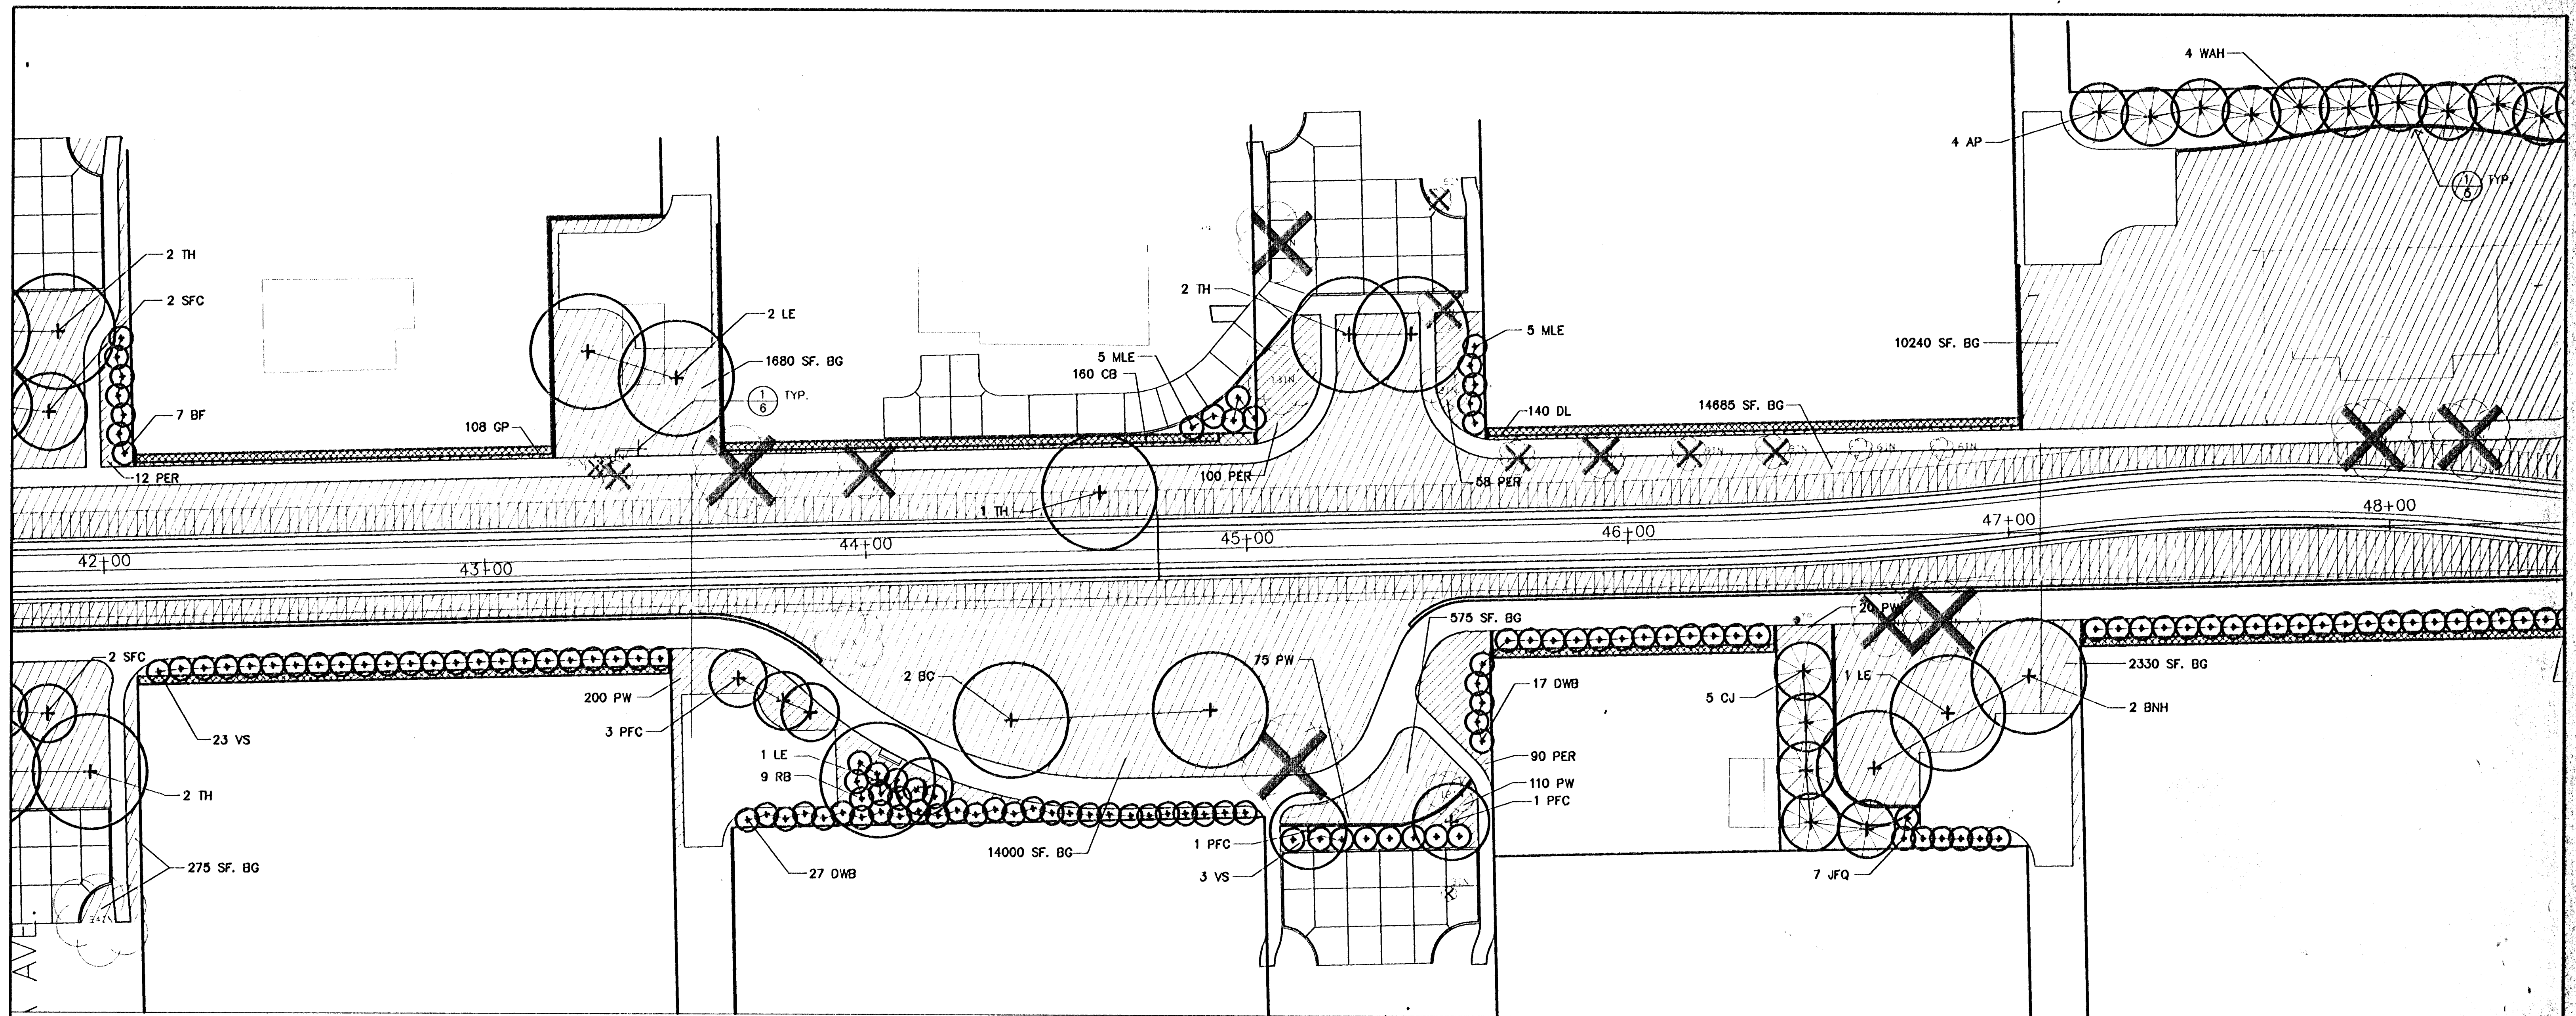

A STATION 41+00.00 TO STATION 48+00.00

0' 10' 20' 1"=20'-0"

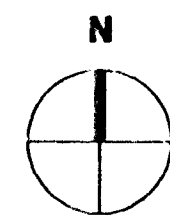


PLANT LIST FOR THIS SHEET

KEY	QTY.	COMMON NAME	BOTANICAL NAME	SIZE	CONDITION
LARGE DECIDUOUS TREES					
BNH	2	RIVER BIRCH	<i>Betula nigra</i> 'Heritage'	2" to 2 1/2" cal.	Balled-in-Burlap
TH	7	THORNLESS HONEYLOCUST	<i>Gleditsia triacanthos</i> 'Shademaster'	2" to 2 1/2" cal.	Balled-in-Burlap
LE	4	LACEBARK ELM	<i>Ulmus parvifolia</i>	2" to 2 1/2" cal.	Balled-in-Burlap
BC	2	BALD CYPRESS	<i>Taxodium distichum</i>	2" to 2 1/2" cal.	Balled-in-Burlap
SMALL TO MEDIUM DECIDUOUS TREES					
WAH	4	WASHINGTON HAWTHORN	<i>Crataegus phaenopyrum</i> 'Select'	2" to 2 1/2" cal.	Balled-in-Burlap
PFC	5	FLOWERING CRABAPPLE	<i>Malus spp.</i> 'Prairifire'	2" to 2 1/2" cal.	Balled-in-Burlap
SFC	4	FLOWERING CRABAPPLE	<i>Malus spp.</i> 'Spring Snow'	2" to 2 1/2" cal.	Balled-in-Burlap
SMALL TO MEDIUM BROADLEAF EVERGREEN TREES					
CJ	5	CANAERT JUNIPER	<i>Juniperus virginiana</i> 'Canaertii'	2" to 2 1/2" cal.	Balled-in-Burlap
AP	4	AUSTRIAN PINE	<i>Pinus nigra</i>	2" to 2 1/2" cal.	Balled-in-Burlap
MEDIUM TO LARGE DECIDUOUS SHRUBS					
RB	9	REDFEAF BARBERRY	<i>Berberis thunbergii</i> 'atropurpurea'	5 gal.	Container


JFQ	7	JAPANESE FLOWERING QUINCE	<i>Chaenomeles japonica</i>	5 gal.	Container
DWB	44	DWARF WINGED BURNING BUSH	<i>Euonymus alatus</i> 'compacta'	5 gal.	Container
MLE	10	MEDIUM LEAF EUONYMUS	<i>Euonymus klatschovicus</i>	5 gal.	Container
BF	7	BORDER FORSYTHIA	<i>Forsythia x intermedia</i>	5 gal.	Container
VS	26	VANHOUTT SPIREA	<i>Spiraea x vanhouttei</i>	5 gal.	Container
GROUNDCOVERS					
PW	405	PURPLELEAF WINTERCREEPER	<i>Euonymus fortunei</i> 'coloratus'	1 gal., 24" O.C.	Container
PER	280	PERIWINKLE	<i>Vinca minor</i>	1 gal., 24" O.C.	Container
PERENNIALS					
GG	45	BLANKET FLOWER	<i>Gaillardia grandiflora</i>	2 1/4" pot, 18" O.C.	Container
CB	180	COREL BELLS	<i>Heuchera sanguinea</i>	2 1/4" pot, 18" O.C.	Container
GP	108	GARDEN PHLOX	<i>Phlox paniculata</i>	4" pot, 18" O.C.	Container
GRASS					
BG	43785 SF.	COMMON BERMUDA GRASS	<i>Cynodon dactylon</i>	Seed	Drilled

NOTE

- CONSTRUCTION OF SANITARY SEWER SEE SHEET 4-10
- CONSTRUCTION OF STORM WATER SEWER SEE SHEET 11-15
- CONSTRUCTION OF PAVED CHANNEL SEE SHEET 16-23
- CONSTRUCTION OF PAVED CUL-DE-SACS SEE SHEET 24-33
- CONSTRUCTION OF PEDESTRIAN BRIDGE SEE SHEET 41-42
- CONSTRUCTION OF SIDEWALK/PATHWAY SEE SHEET 34-40

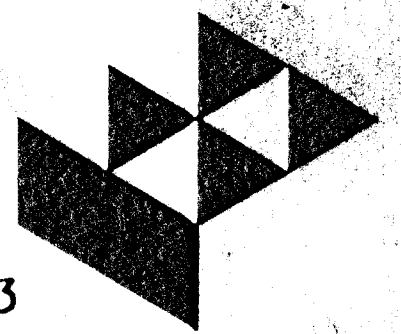

GosselinLivingston
Architectural
312 South 10th
Wichita, KS 67202
Tel: 316-261-1100
Fax: 316-261-1101

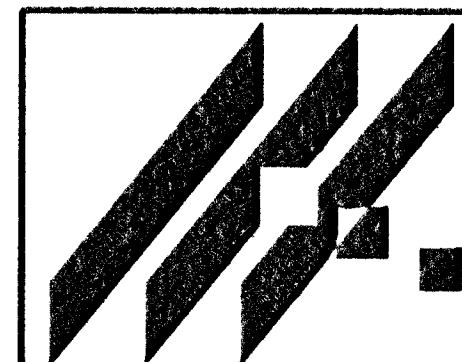

MID-KANSAS ENGINEERING
CONSULTANTS, INC.
411 N. WEBB ROAD
WICHITA, KS. 67206
316-684-9600

AREA "K" 3RD. STREET CHANNEL

PROJECT NAME

LANDSCAPE PLAN

SHEET TITLE

TDM, JRS
DESIGN BY:

TDM, JRS
DRAWN BY:

CHECKED BY:

JUNE 96
DATE

9331_B6
JOB NO.

48 / 77
SHEET/OF