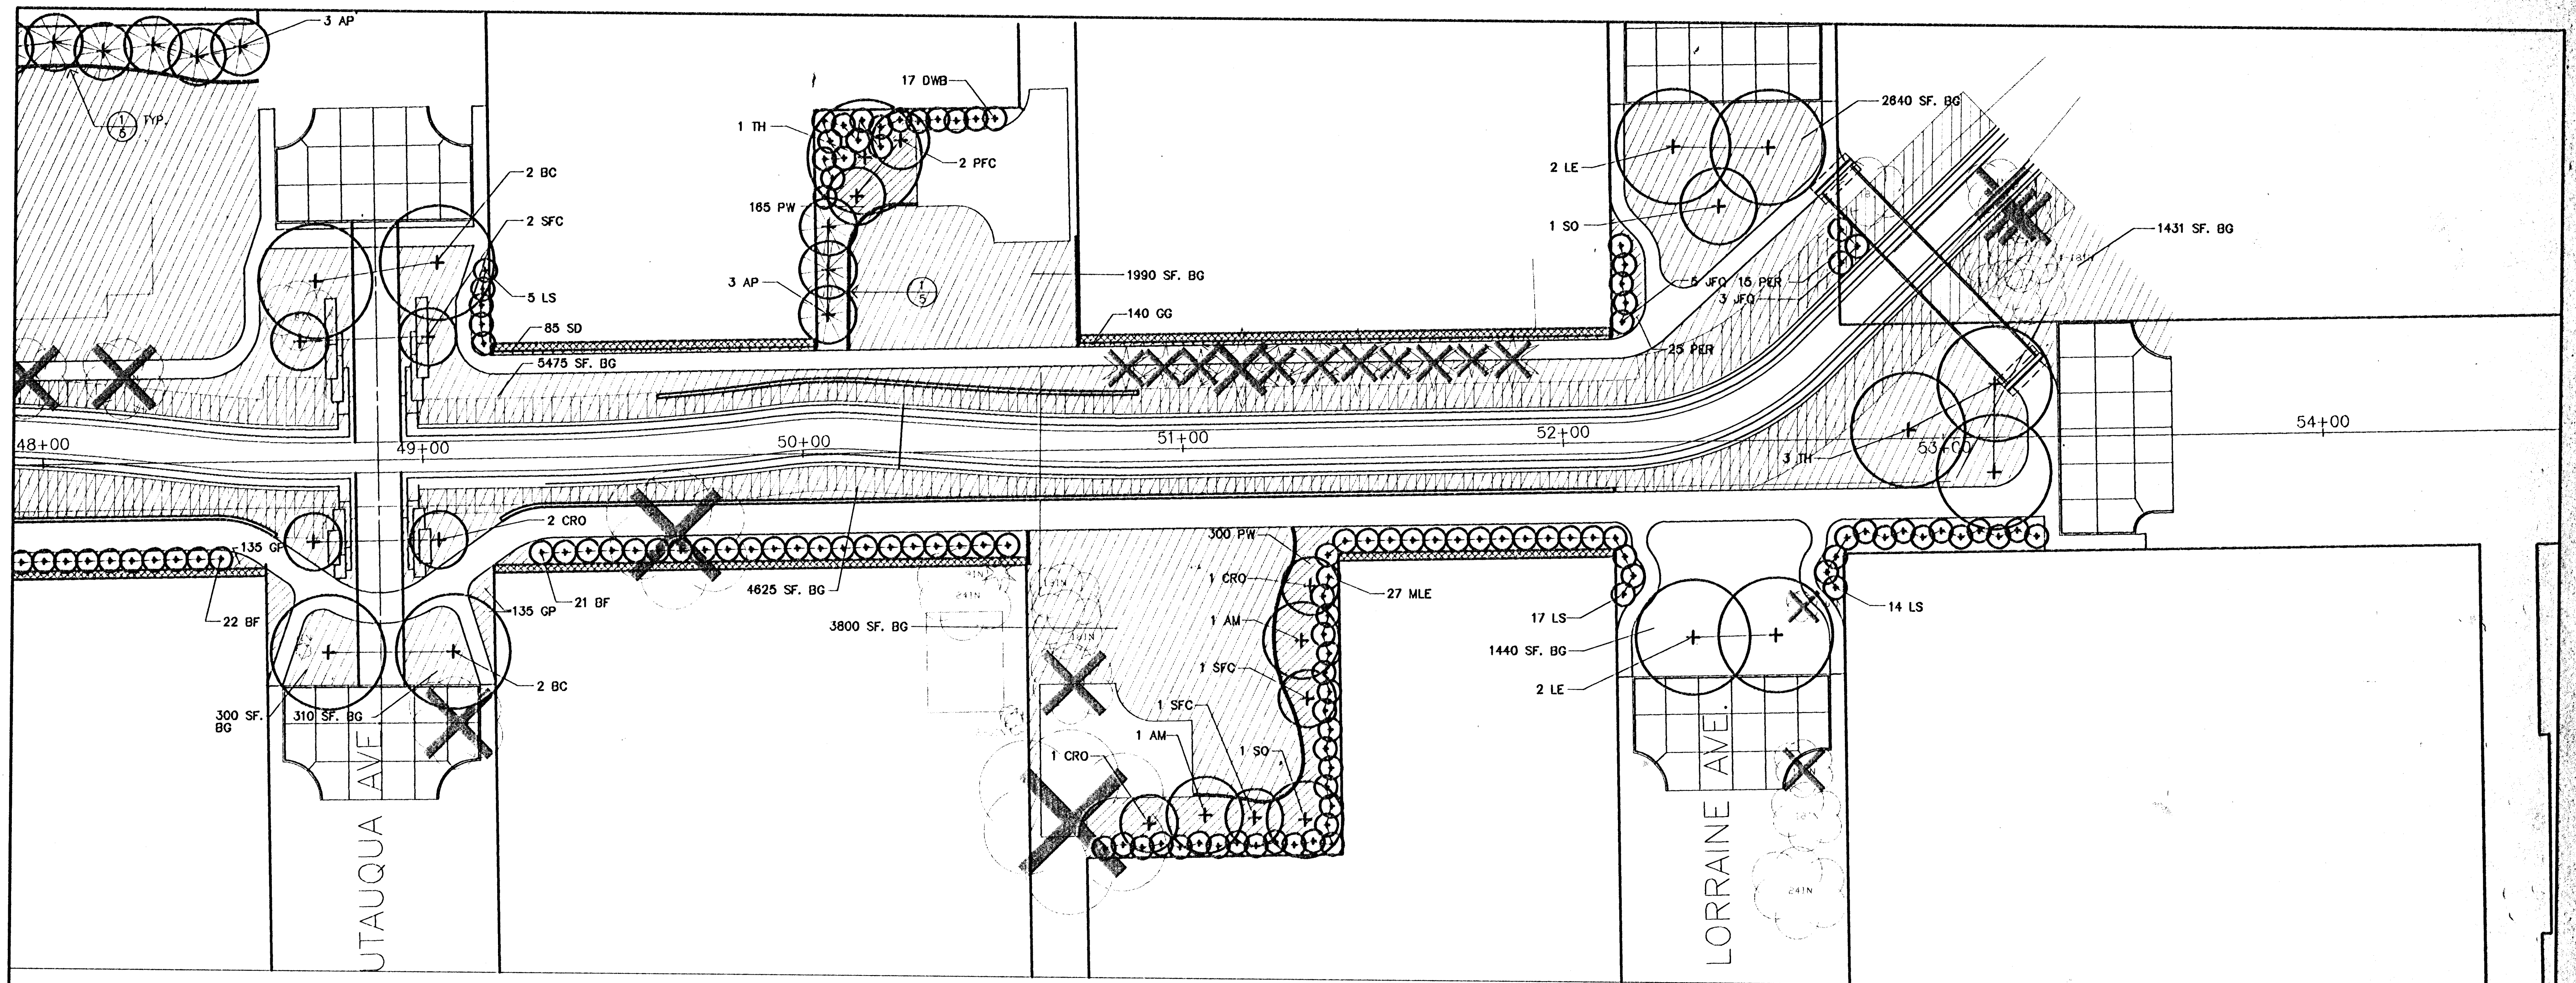



PLANT LIST FOR THIS SHEET

KEY	QTY.	COMMON NAME	BOTANICAL NAME	SIZE	CONDITION
LARGE DECIDUOUS TREES					
TH	4	THORNLESS HONEYLOCUST	Gleditsia triacanthos 'Shademaster'	2" to 2 1/2" cal.	Balled-in-Burlap
LE	4	LACEBARK ELM	Ulmus parvifolia	2" to 2 1/2" cal.	Balled-in-Burlap
BC	4	BALD CYPRESS	Taxodium distichum	2" to 2 1/2" cal.	Balled-in-Burlap
SMALL TO MEDIUM DECIDUOUS TREES					
AM	2	AMUR MAPLE	Acer ginnala 'Flame'	2" to 2 1/2" cal.	Balled-in-Burlap
CRO	4	OKLAHOMA REDBUD	Cercis reniformis 'Oklahoma'	2" to 2 1/2" cal.	Balled-in-Burlap
PFC	2	FLOWERING CRABAPPLE	Malus spp. 'Prairifire'	2" to 2 1/2" cal.	Balled-in-Burlap
SFC	4	FLOWERING CRABAPPLE	Malus spp. 'Spring Snow'	2" to 2 1/2" cal.	Balled-in-Burlap
SO	2	SAWTOOTH OAK	Quercus acutissima	2" to 2 1/2" cal.	Balled-in-Burlap
SMALL TO MEDIUM BROADLEAF EVERGREEN TREES					
AP	6	AUSTRIAN PINE	Pinus nigra	2" to 2 1/2" cal.	Balled-in-Burlap
MEDIUM TO LARGE DECIDUOUS SHRUBS					
JFQ	8	JAPANESE FLOWERING QUINCE	Chaenomeles japonica	5 gal.	Container

DWB	17	DWARF WINGED BURNING BUSH	Euonymus alatus 'compacta'	5 gal.	Container
MLE	27	MEDIUM LEAF EUONYMUS	Euonymus kiautschovicus	5 gal.	Container
BF	43	BORDER FORSYTHIA	Forsythia x intermedia	5 gal.	Container
LS	36	LILAC	Lilac Syringe	5 gal.	Container
GROUNDCOVERS					
PW	465	PURPLELEAF WINTERCREEPER	Euonymus fortunei 'coloratus'	1 gal., 24" O.C.	Container
PER	40	PERIWINKLE	Vinca minor	1 gal., 24" O.C.	Container
PERENNIALS					
GG	140	BLANKET FLOWER	Gaillardia grandiflora	2 1/4" pot, 18" O.C.	Container
DL	70	DAYLILY	Hemerocallis hybrids	1 gal., 24" O.C.	Container
SD	85	SHASTA DAISY	Chrysanthemum superbum	2 1/4" pot, 18" O.C.	Container
GP	270	GARDEN PHLOX	Phlox paniculata	4" pot, 18" O.C.	Container
GRASS					
BG	22011 SF.	COMMON BERMUDA GRASS	Cynodon dactylon	Seed	Drilled


NOTE

- CONSTRUCTION OF SANITARY SEWER SEE SHEET 4-10
- CONSTRUCTION OF STORM WATER SEWER SEE SHEET 11-15
- CONSTRUCTION OF PAVED CHANNEL SEE SHEET 16-23
- CONSTRUCTION OF PAVED CUL-DE-SACS SEE SHEET 24-33
- CONSTRUCTION OF PEDESTRIAN BRIDGE SEE SHEET 41-42
- CONSTRUCTION OF SIDEWALK/PATHWAY SEE SHEET 34-40

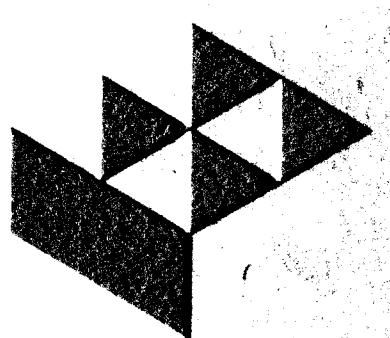

GossesLivingston

Architectural
Engineering
Surveying
16 (24) 36-38

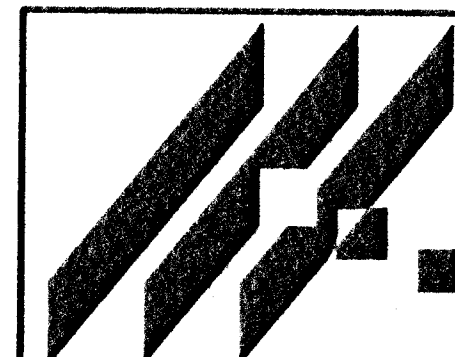

MID-KANSAS ENGINEERING
CONSULTANTS, INC.
611 N. WEBB ROAD
WICHITA, KS. 67206
316-684-9600

AREA "K" 3RD. STREET CHANNEL
PROJECT NAME

LANDSCAPE PLAN
SHEET TITLE

TDM, JRS
DESIGN BY:
JUNE 96
DATE

TDM, JRS
DRAWN BY:
9331_07
JOB NO.

CHECKED BY:
49, 77
SHEET/OF