


INTERSECTION ELM & VASSAR
 BM. ELM 150.40 CB 103.40 NW COR

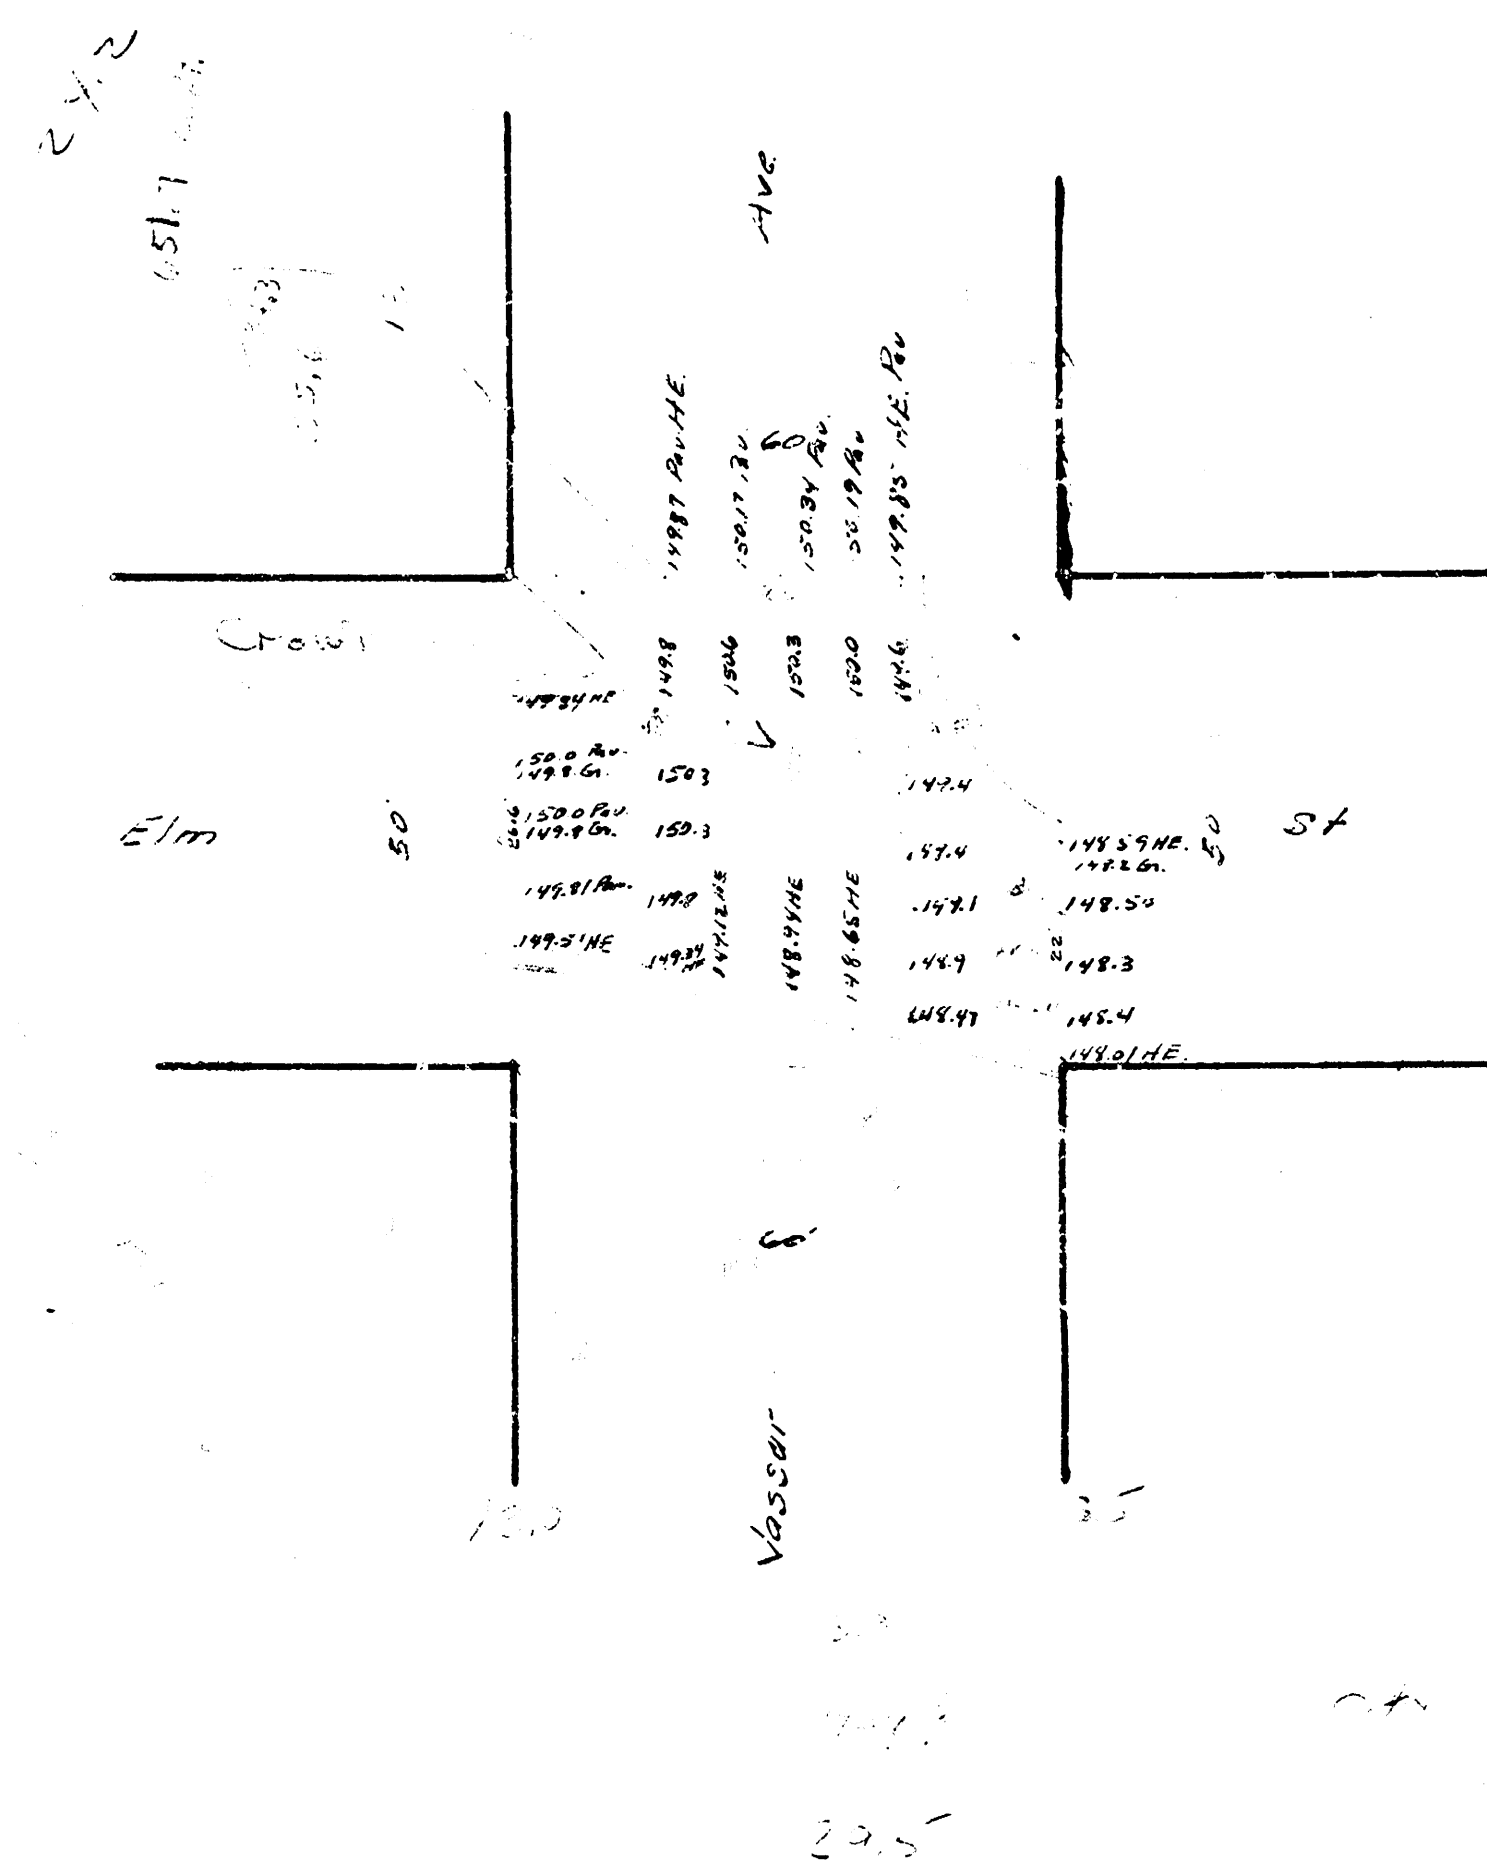

51.7 - 50' - 50' 74

PAVING PLAN
 INTERSECTION
 Elm St
 Vassar Ave.
 1991