


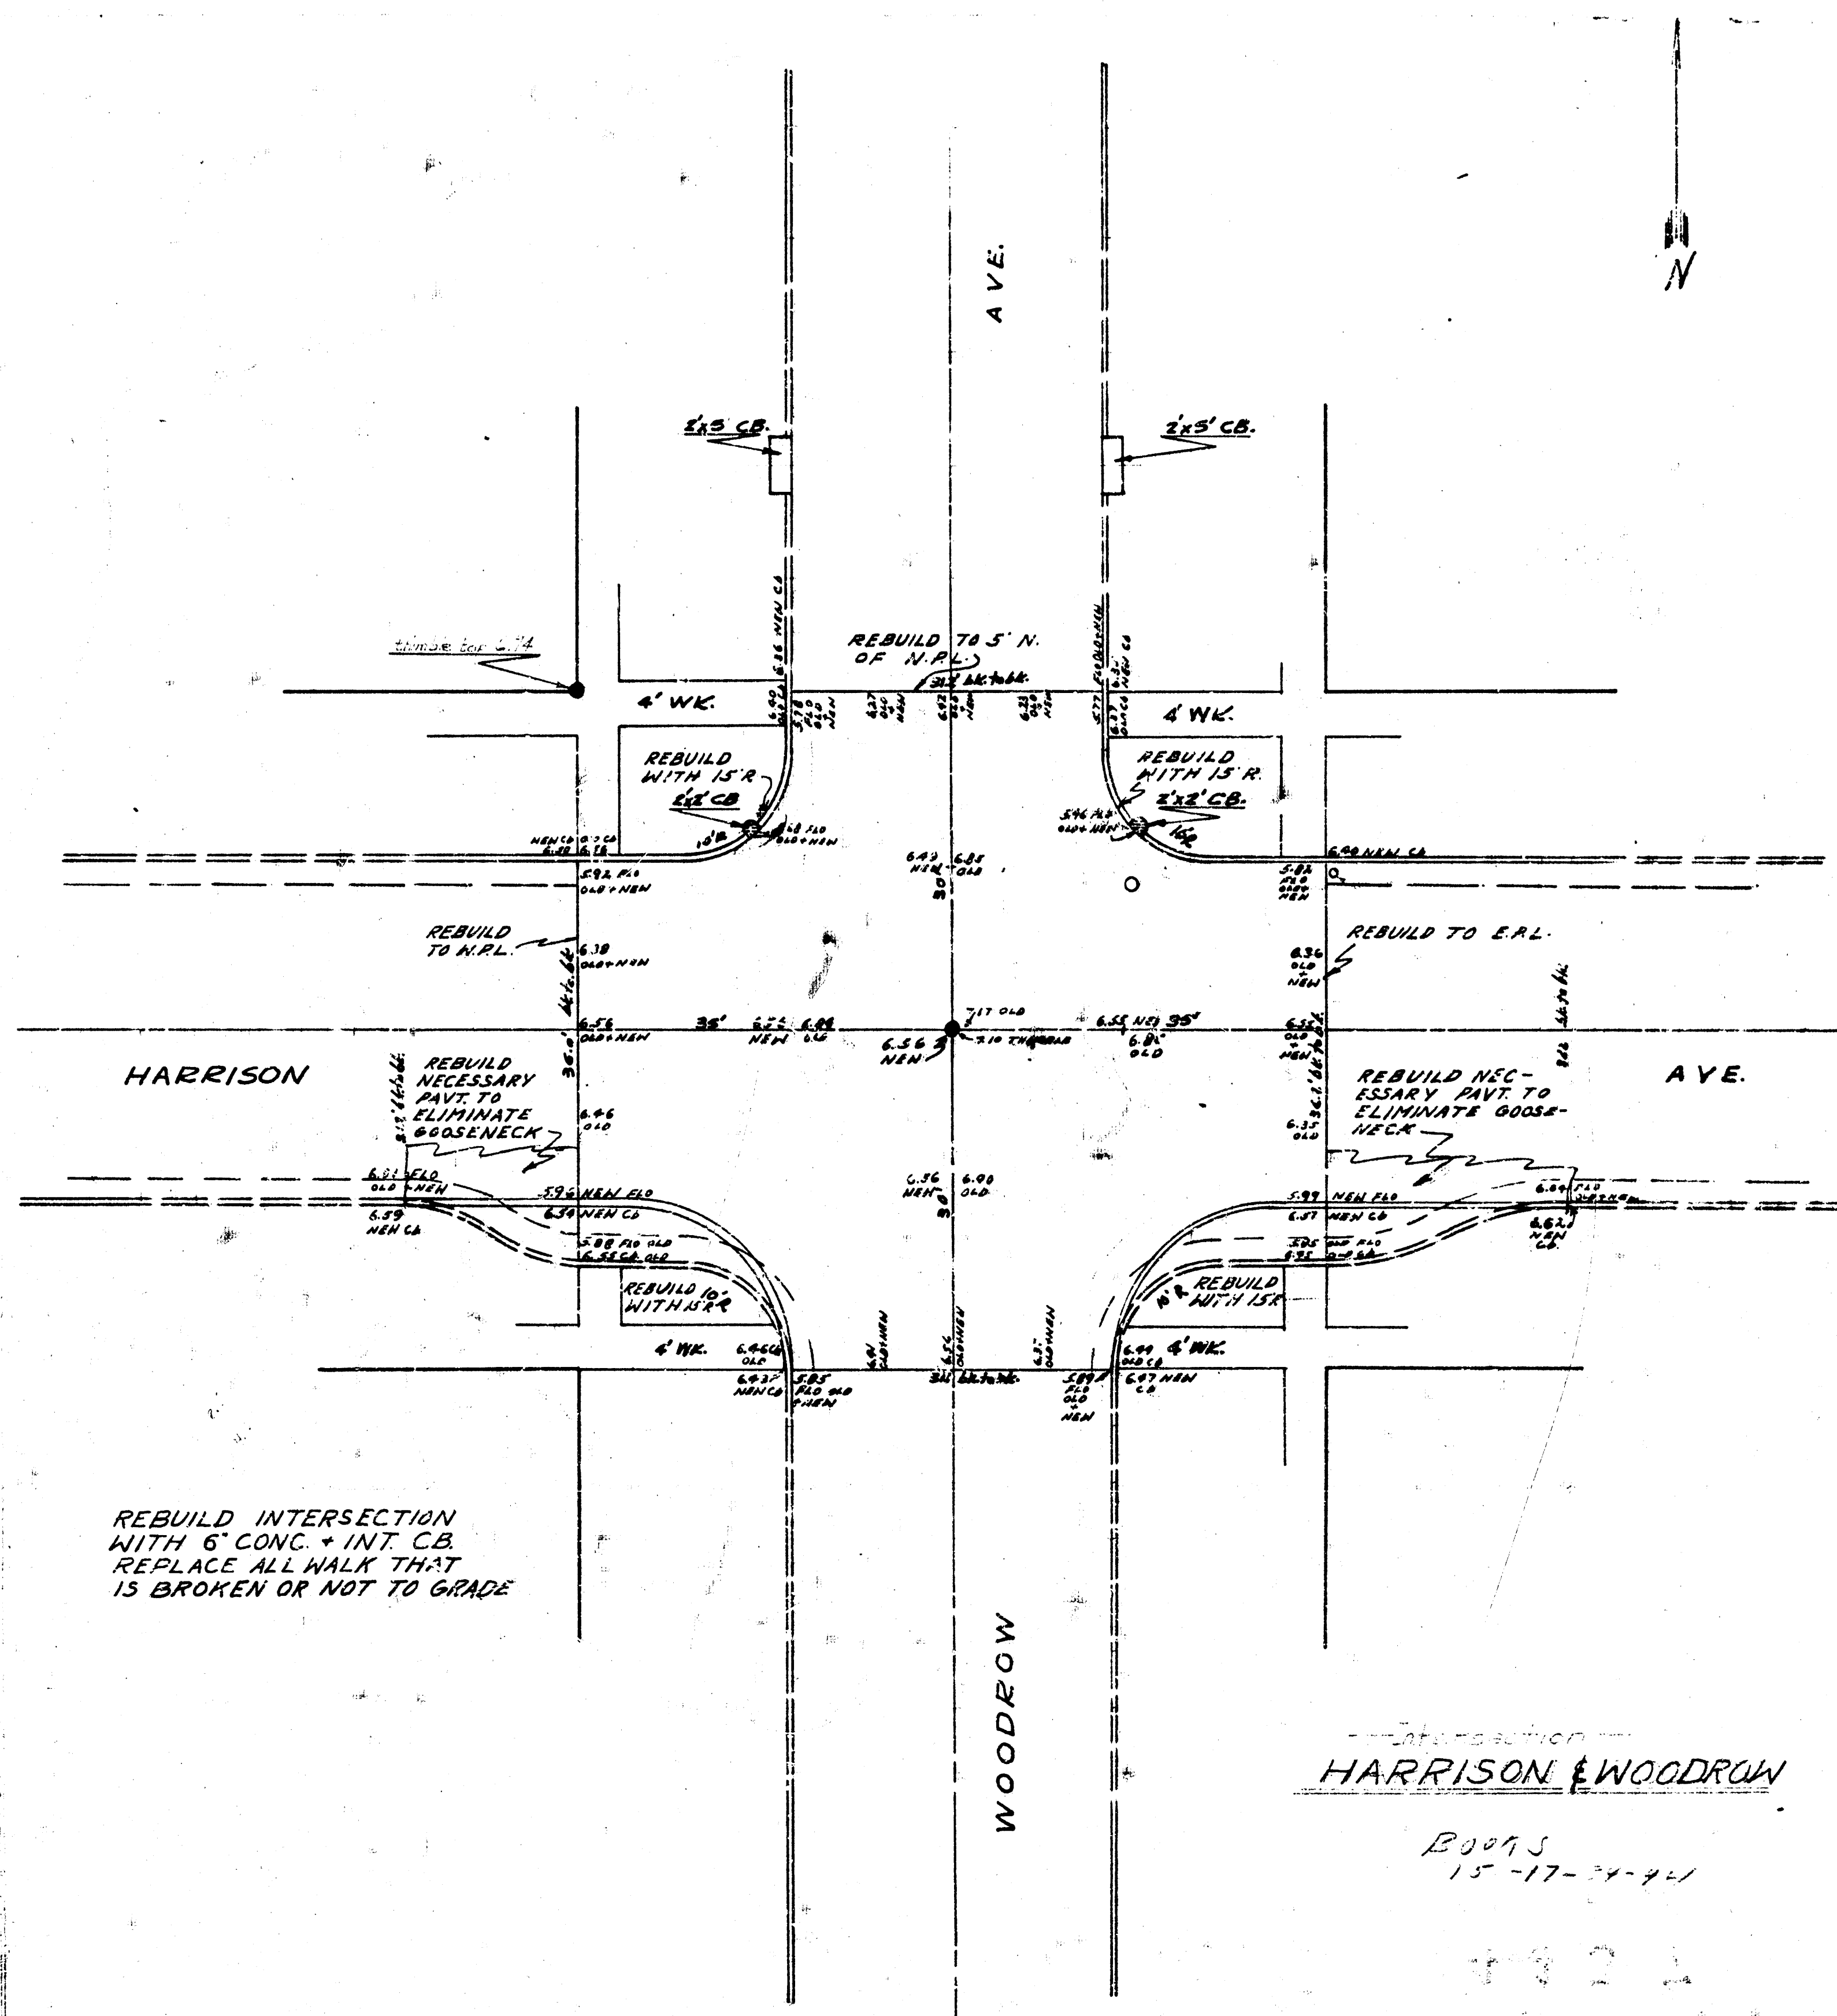

BOOKS
15-17-24-241