



BM #1 112.93 "G" Cut Top Conc Retaining Wall On SW Cor. Broadway & First.
BM #2 112.04 "G" Cut Top Curb SL Allev. 1/2 Blk. N of Douglas, 135' E of EL Marked.

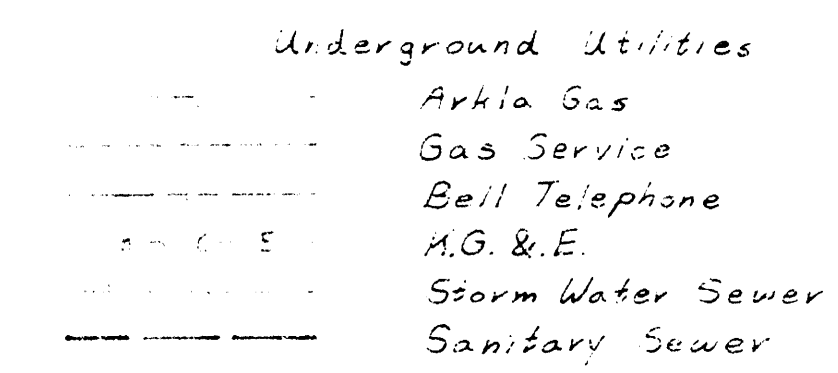

Plan Scale: 1"=10'
Profile Scale: Horizontal: 1"=10'
Vertical: 1"=5'

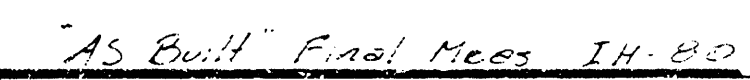

REBUILDING AND RECONSTRUCTION OF PORTION
OF WEST SUBMAIN B, S.S. NO.1, AND PORTION OF
DISTRICT K, STORM WATER SEWER NO.8, IN THE
ALLEY NORTH OF DOUGLAS FROM WEST LINE
OF ALLEY WEST OF BROADWAY W.L. BROADWAY.
CITY OF WICHITA, KANSAS
R.W. LINZI CITY ENGINEER

DATE: *Sept. 1973* SHEET: 1 OF 2
PROJECT NO. DBKL 572019



Sta. 0+00 Const. 3' dia. 5' x 5' M.H. Type "B" on exist. 20" Sanitary Sewer.

Underground Utilities
Arks Gas
Gas Service
Bell Telephone
Storm Water Sewer
Sanitary Sewer
H.G. & E.



17000
10000

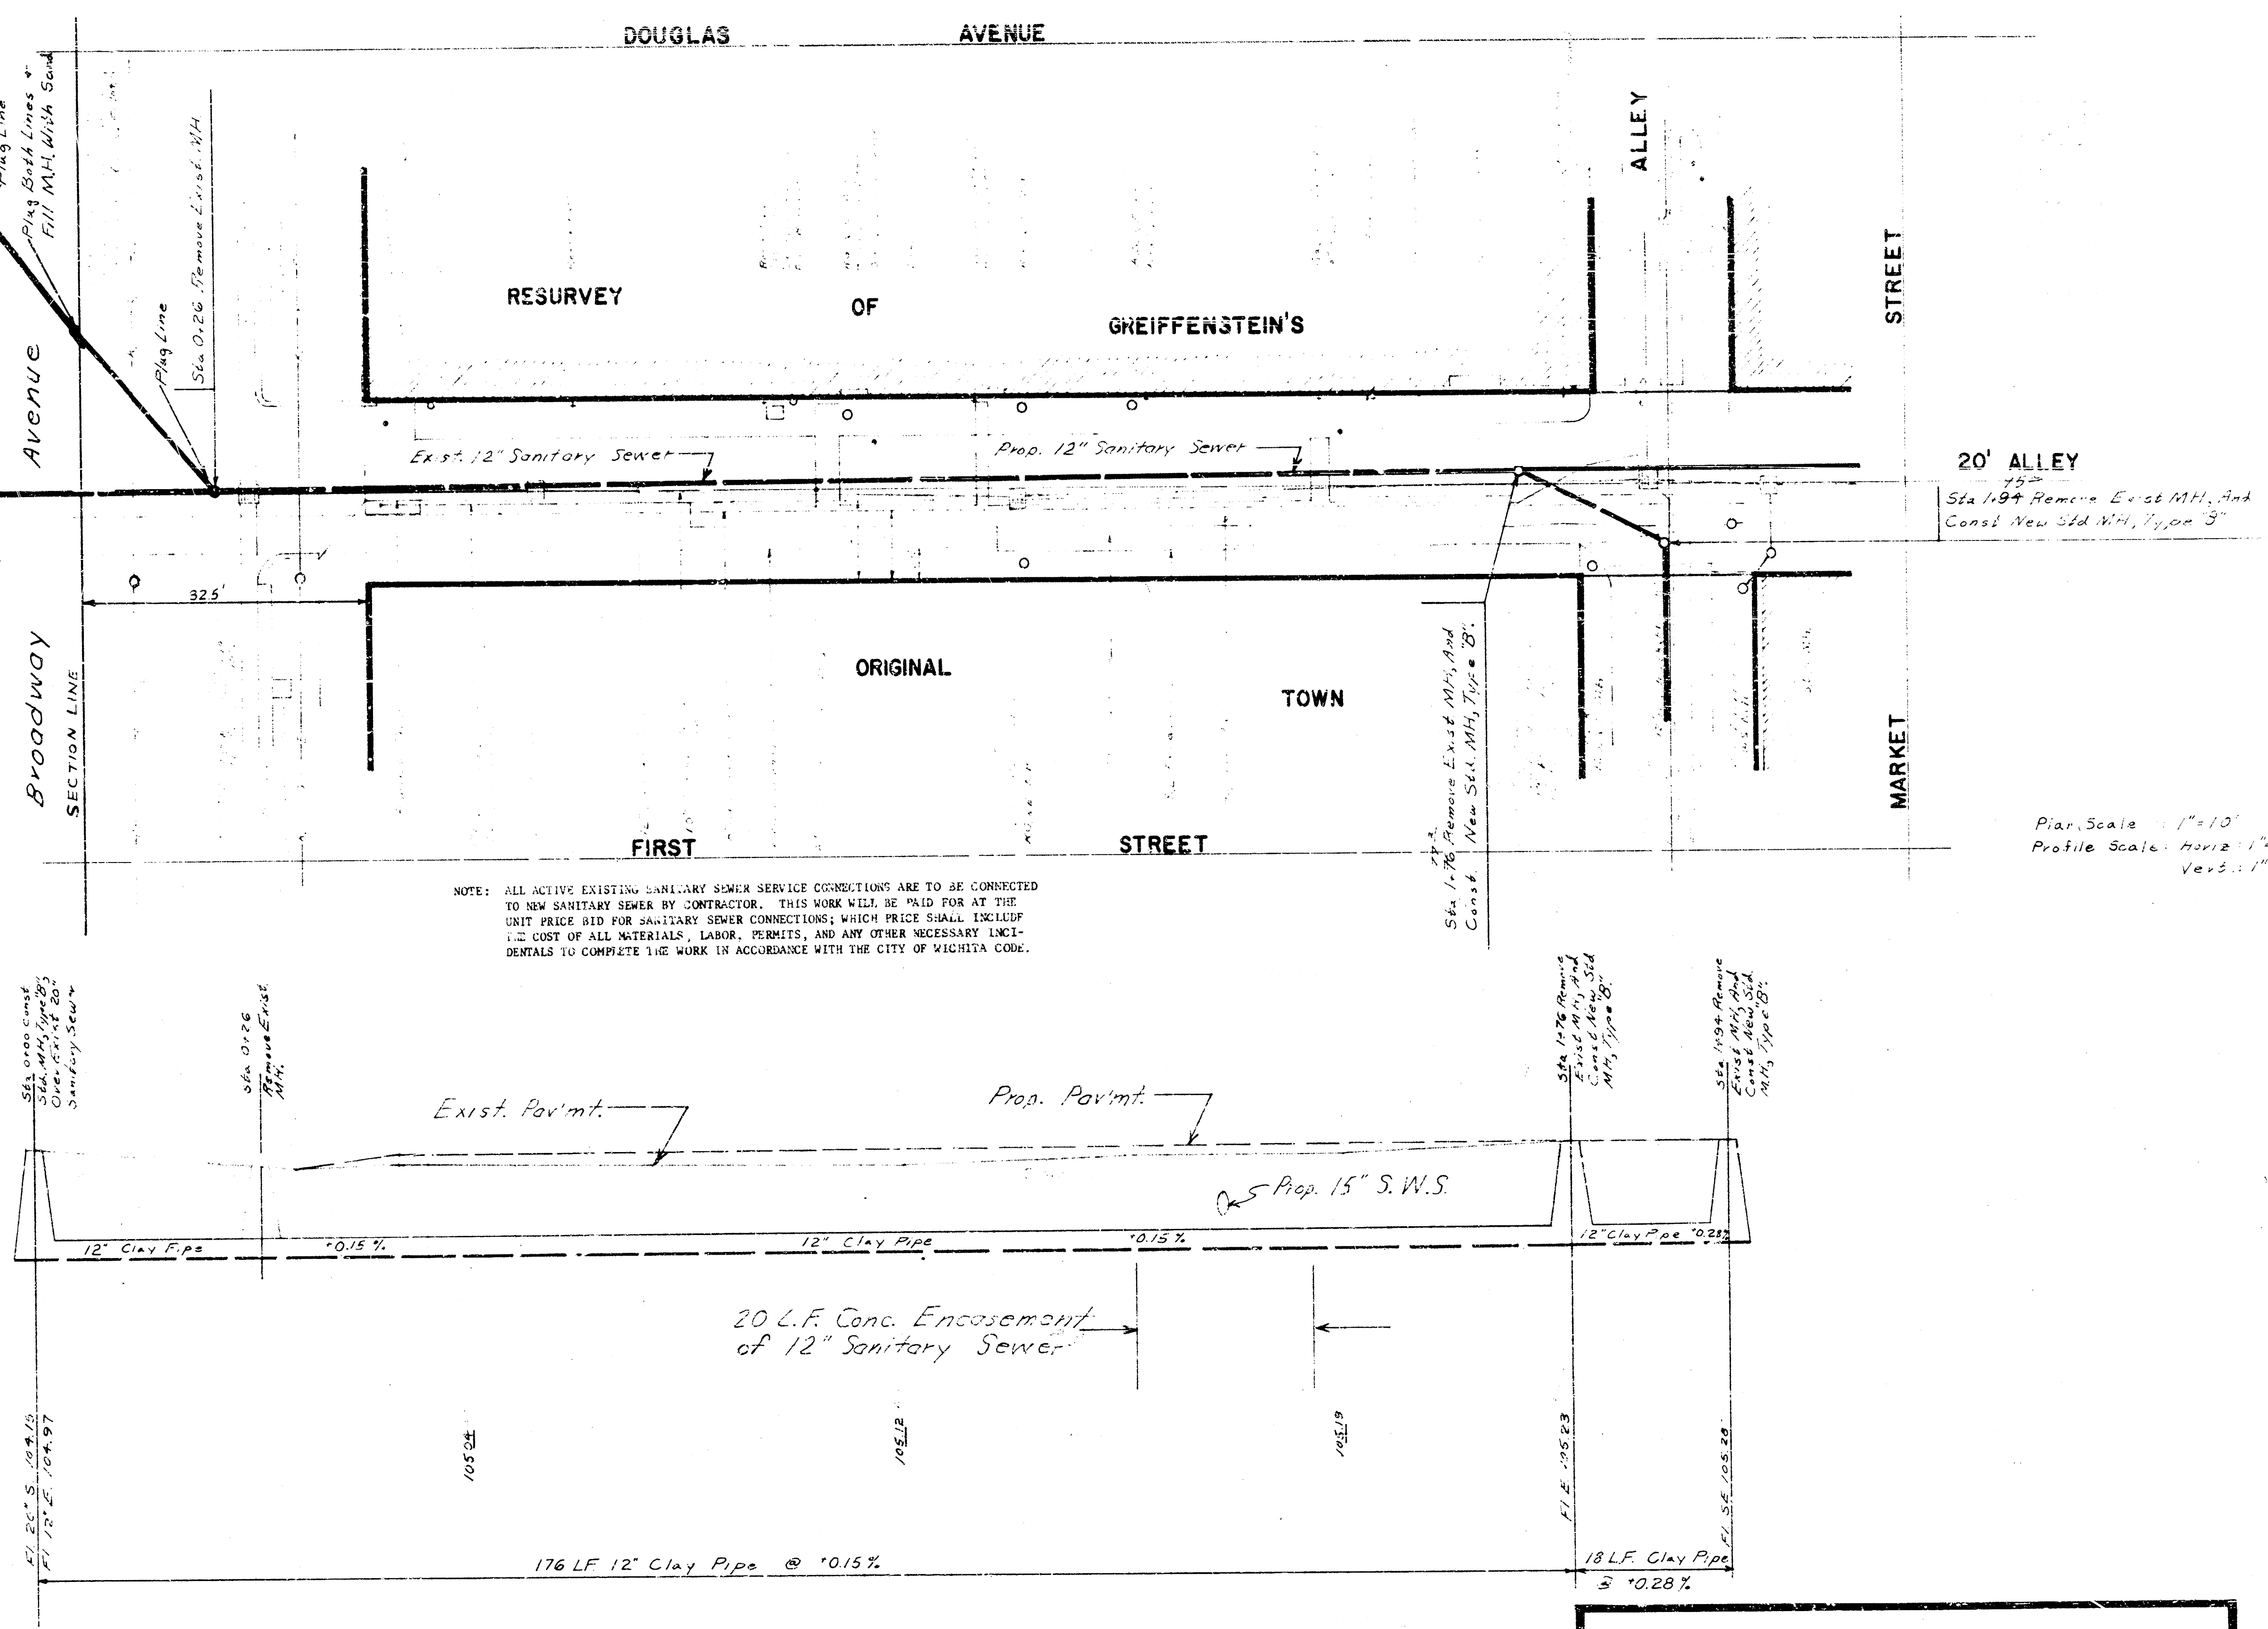


Plan Scale: 1"=10'
Profile Scale: Horiz. 1"=10'
Vert. 1"=5'

DATE: SHEET: 2 OF 2
PROJECT NO. DBKL 572019

14 2 1 2