




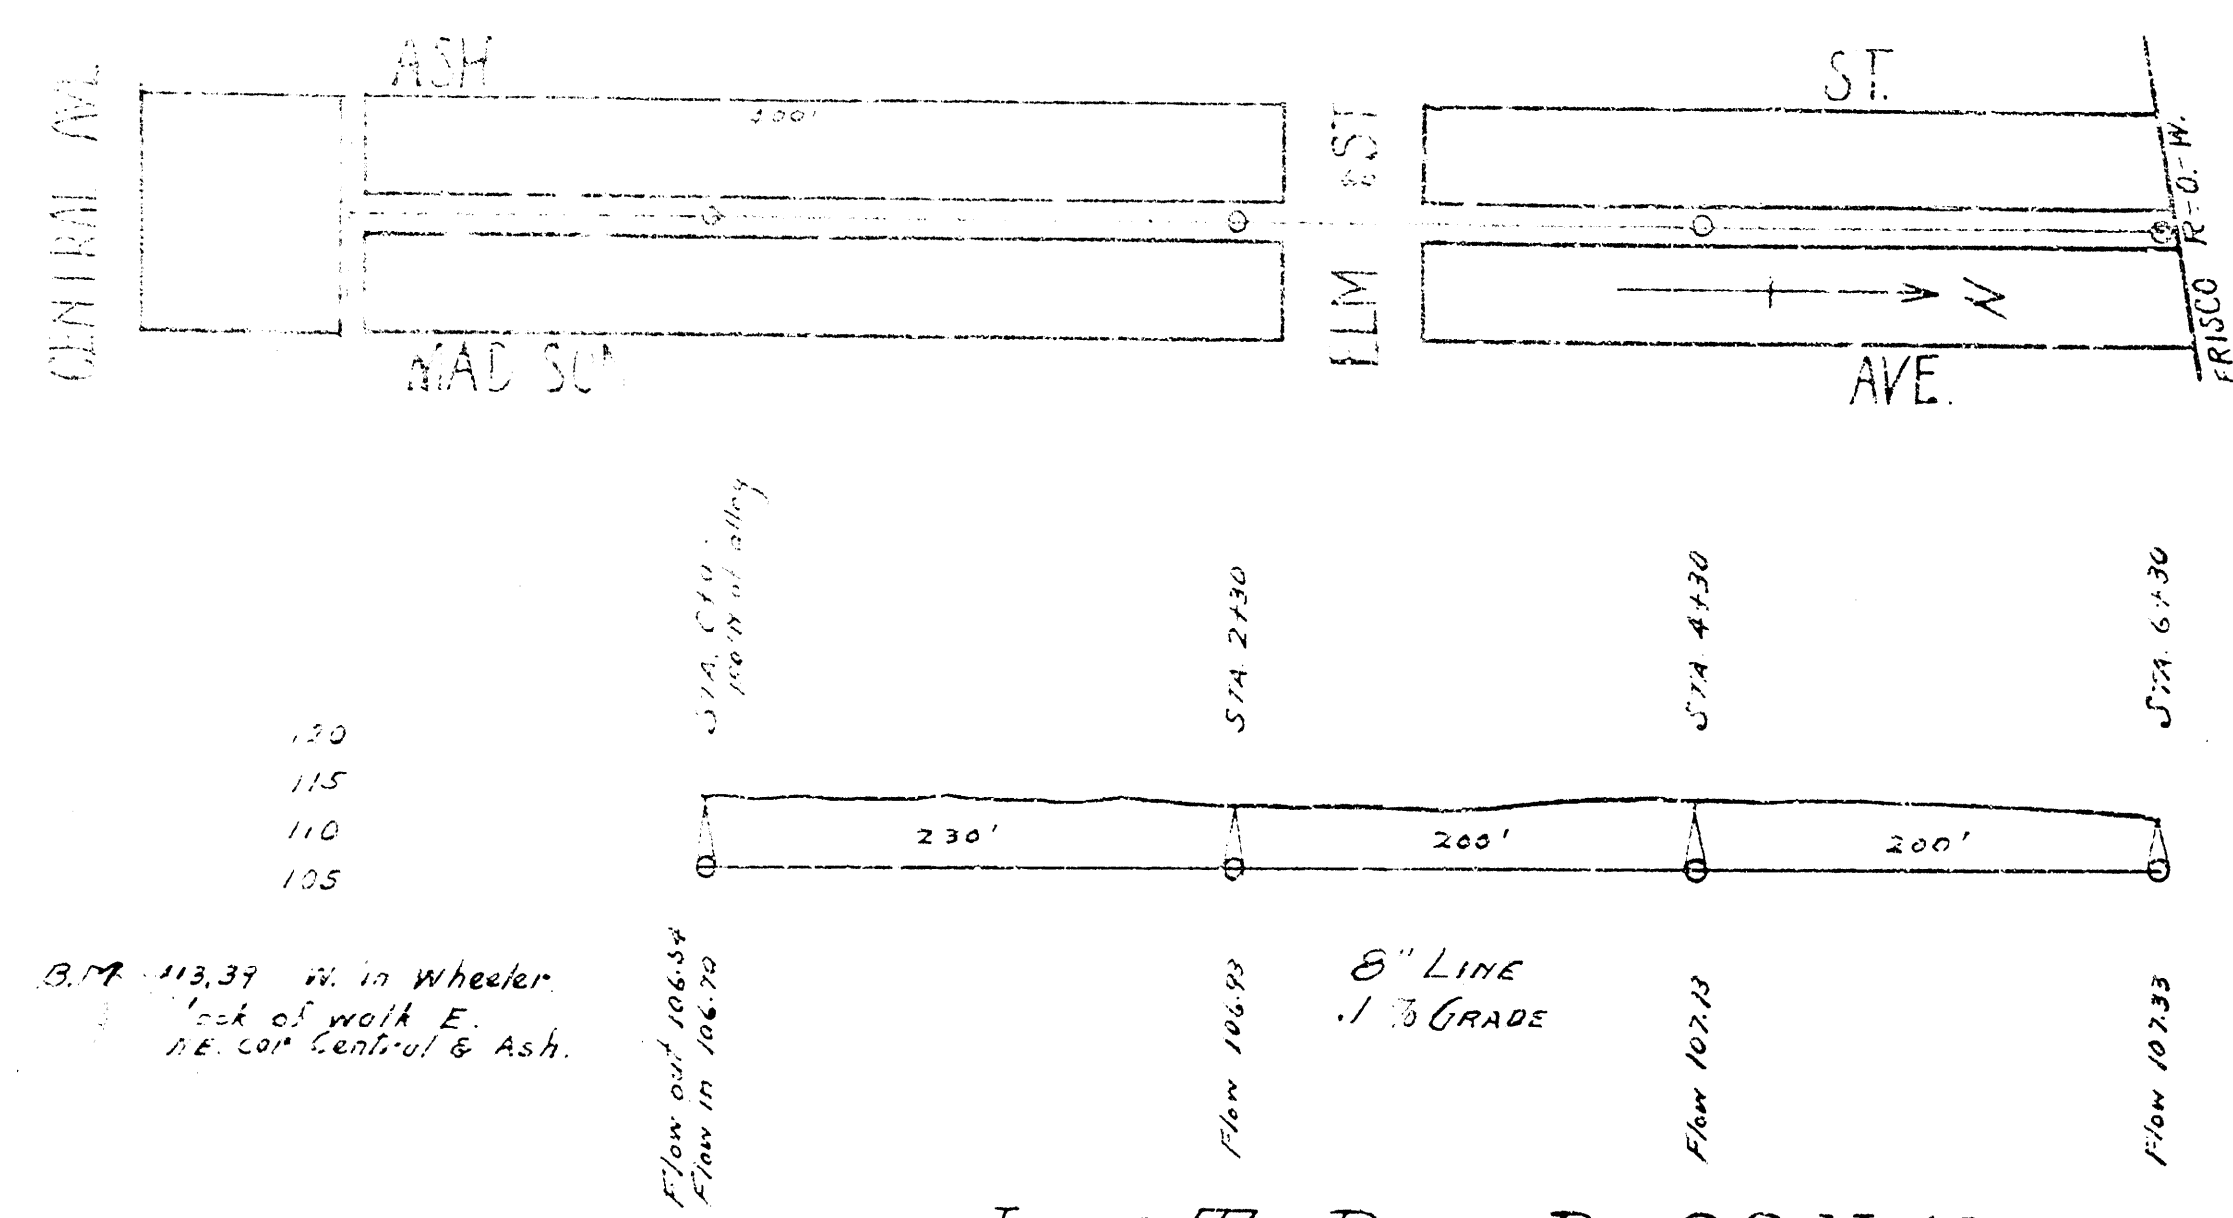


LAT. T, DIST. D., S.S. No. 12.

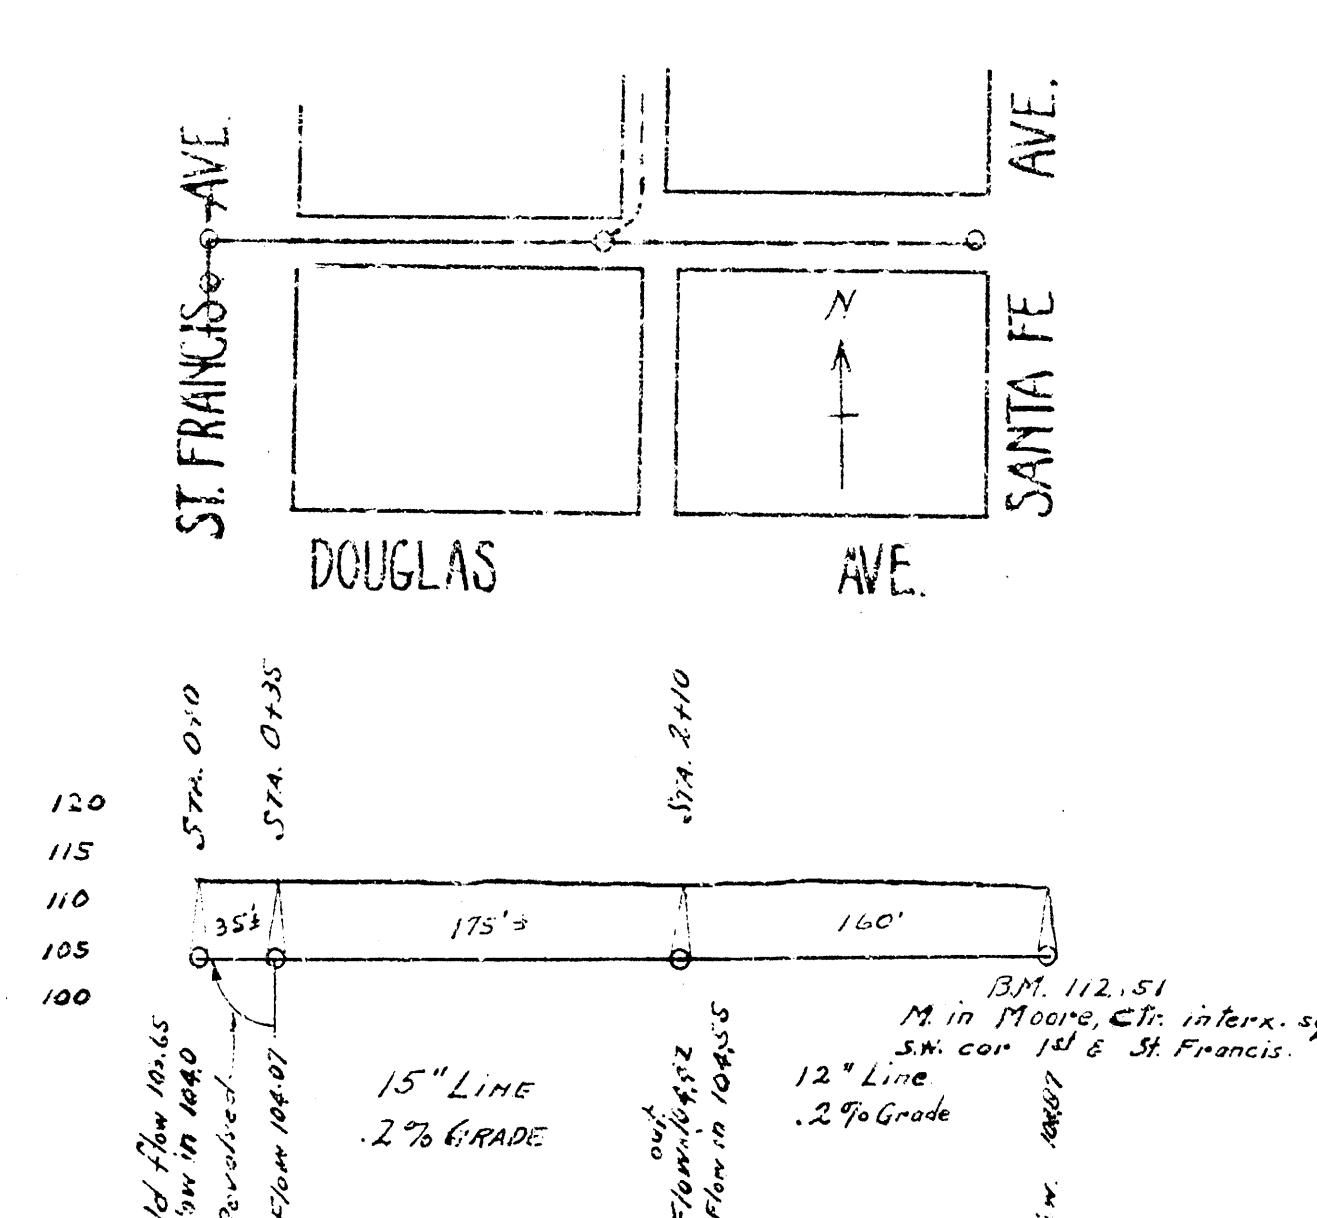


LAT. 6, S.S. No. 1

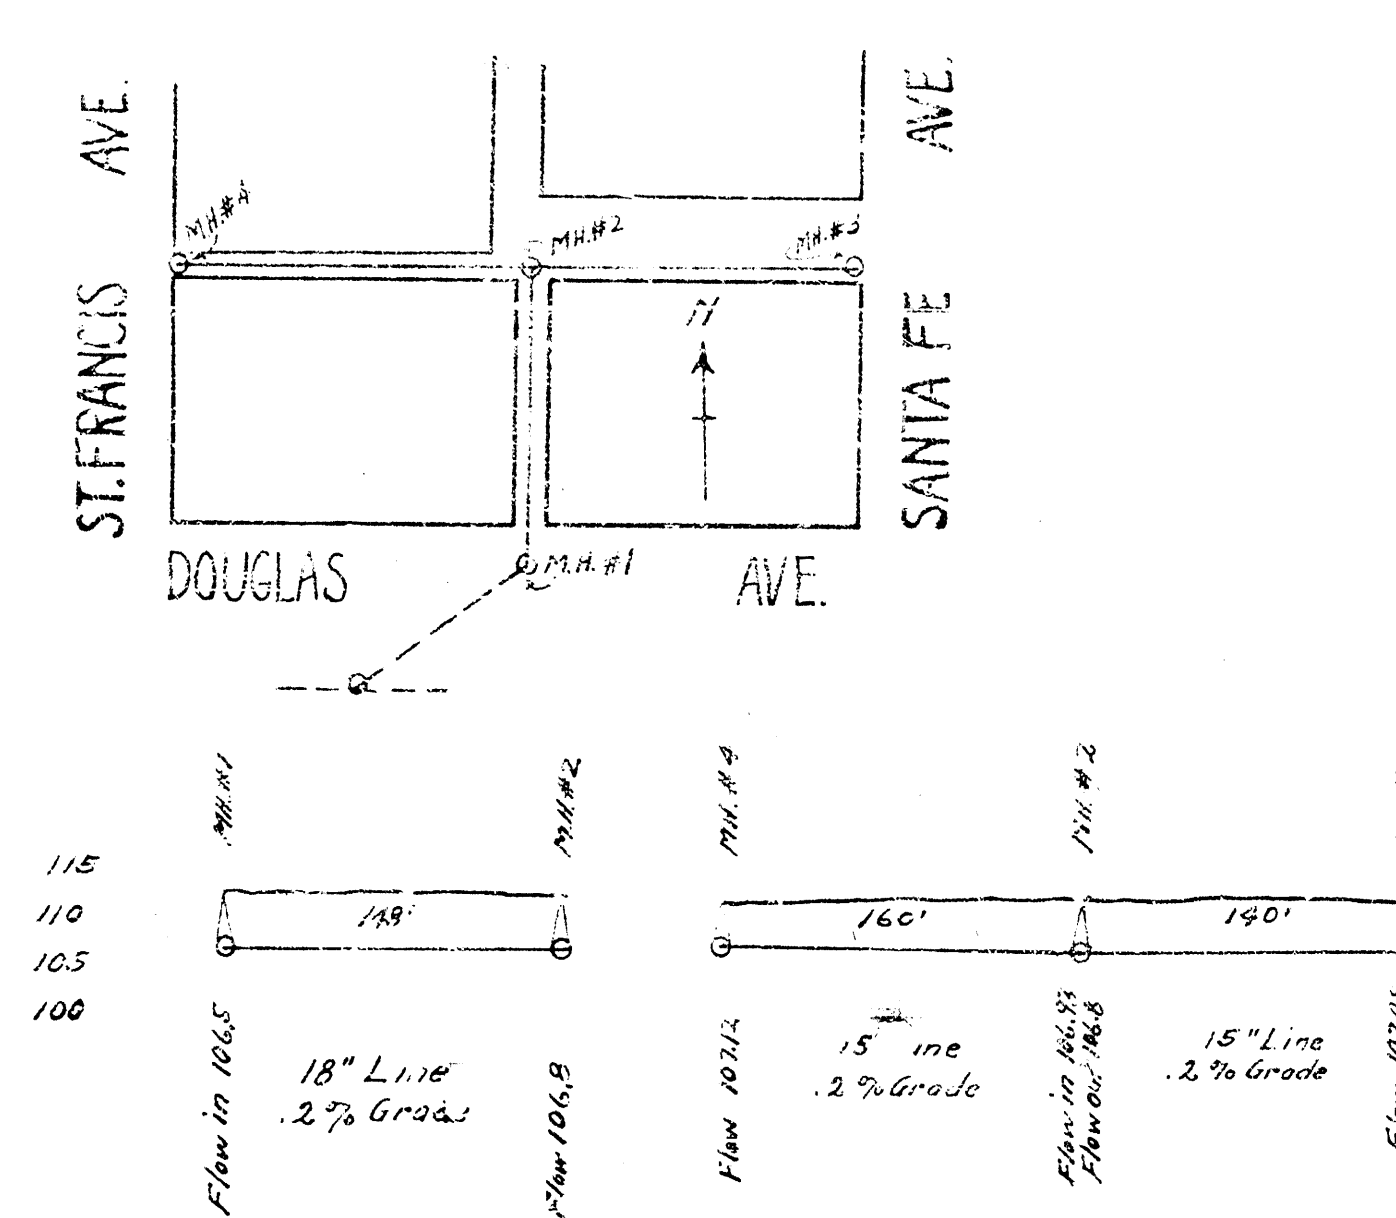


LAT. 0, DIST. B., S.W.S. No. 8

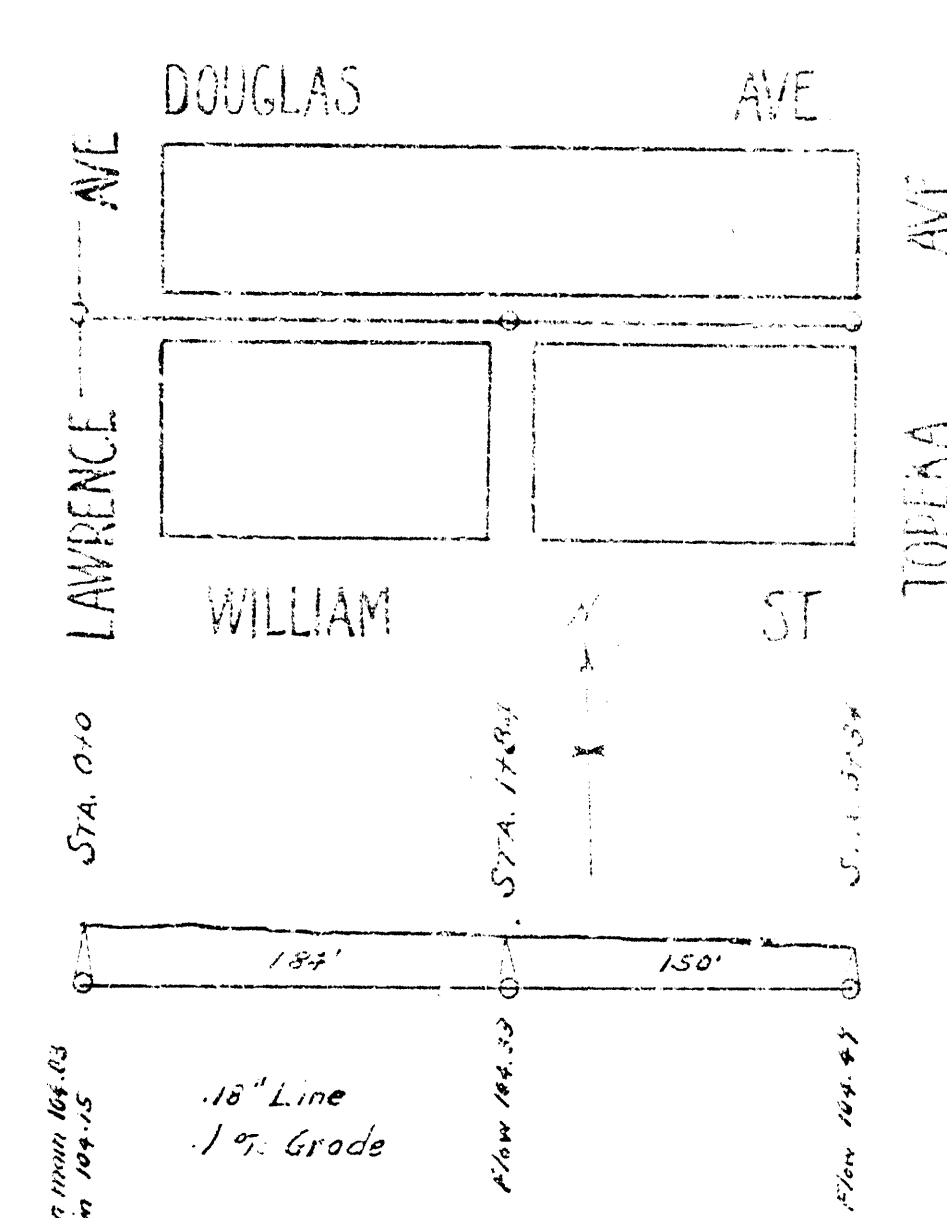

LAT. 7, S.S. No. 1

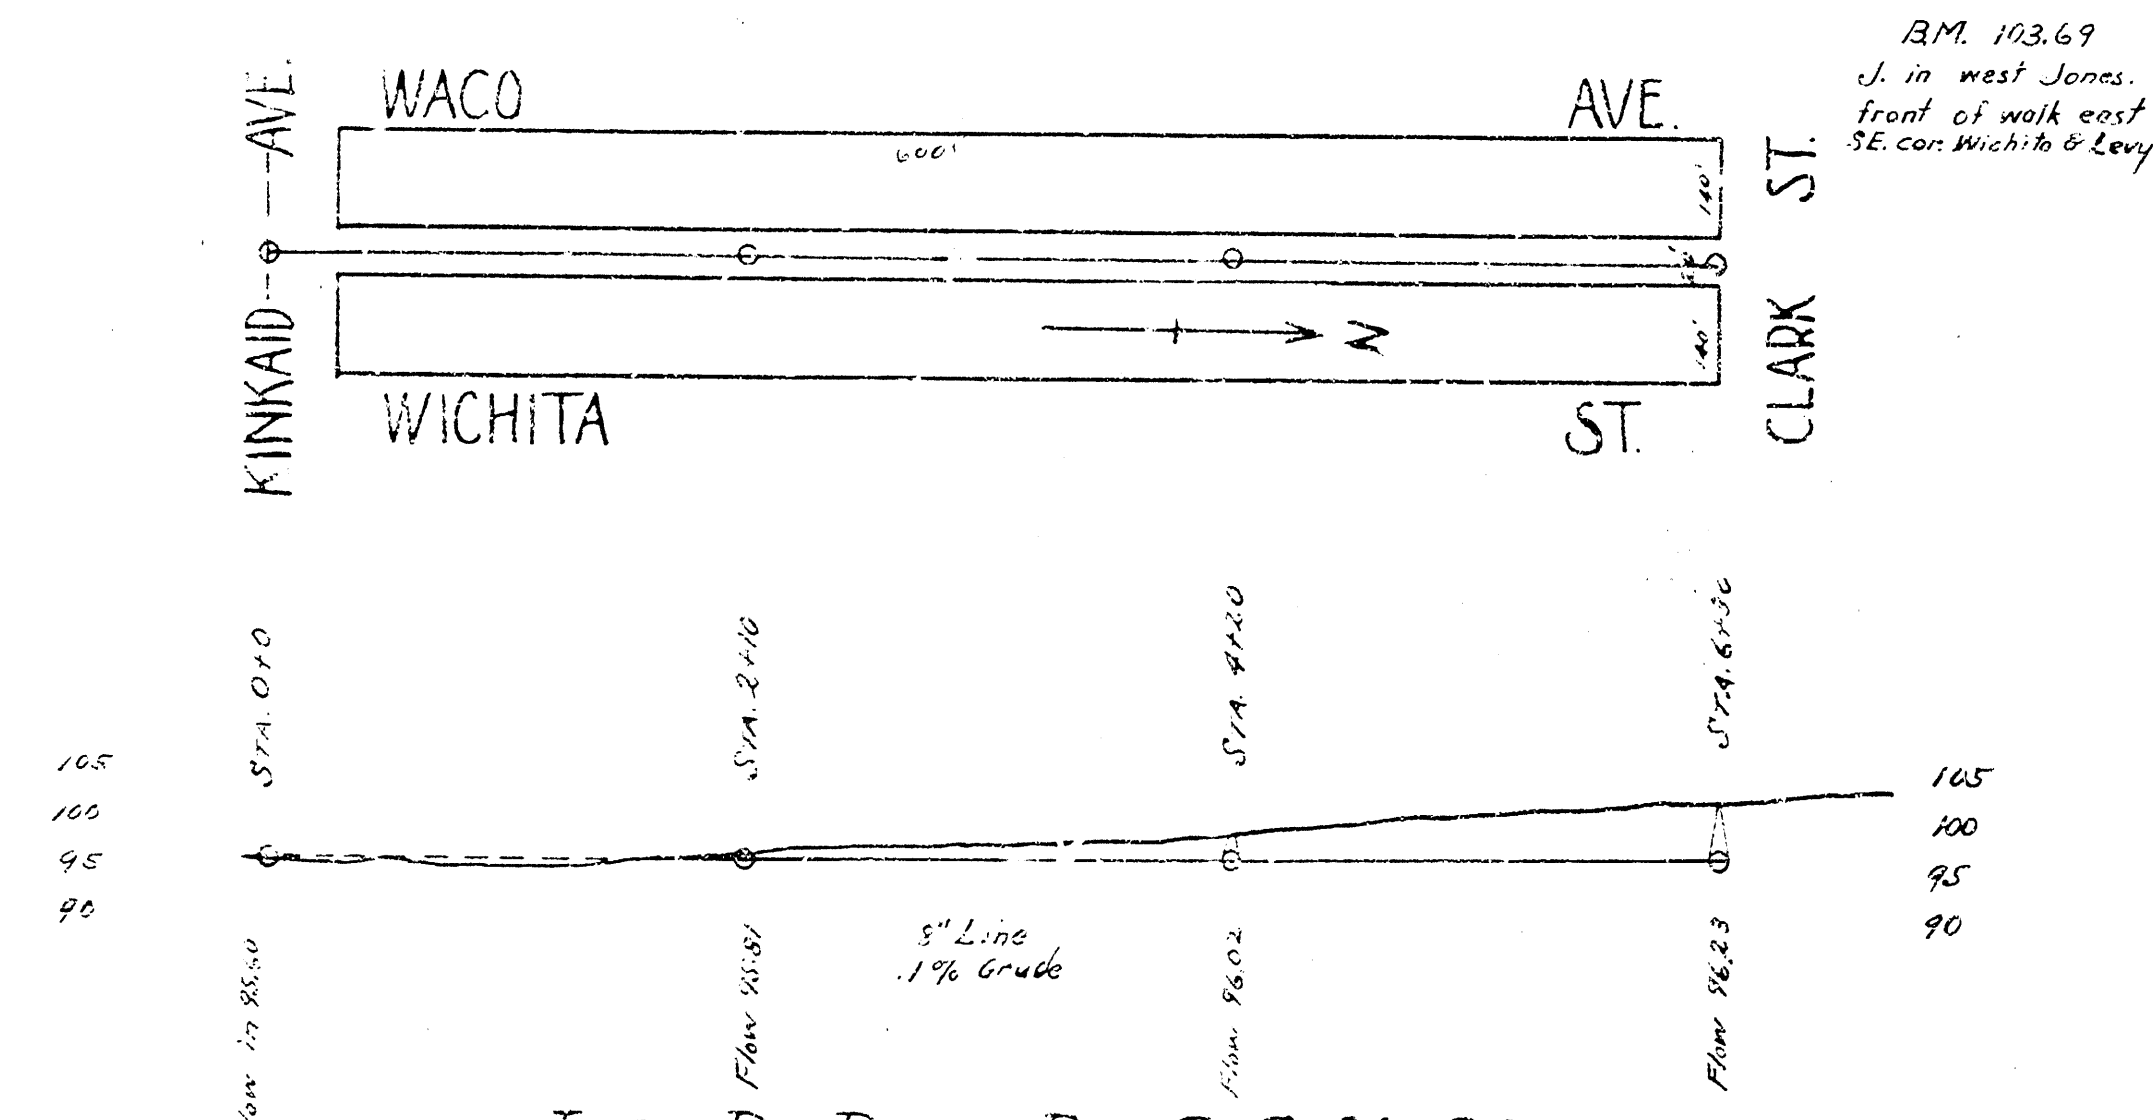

LAT. D, DIST. B., S.S. No. 20

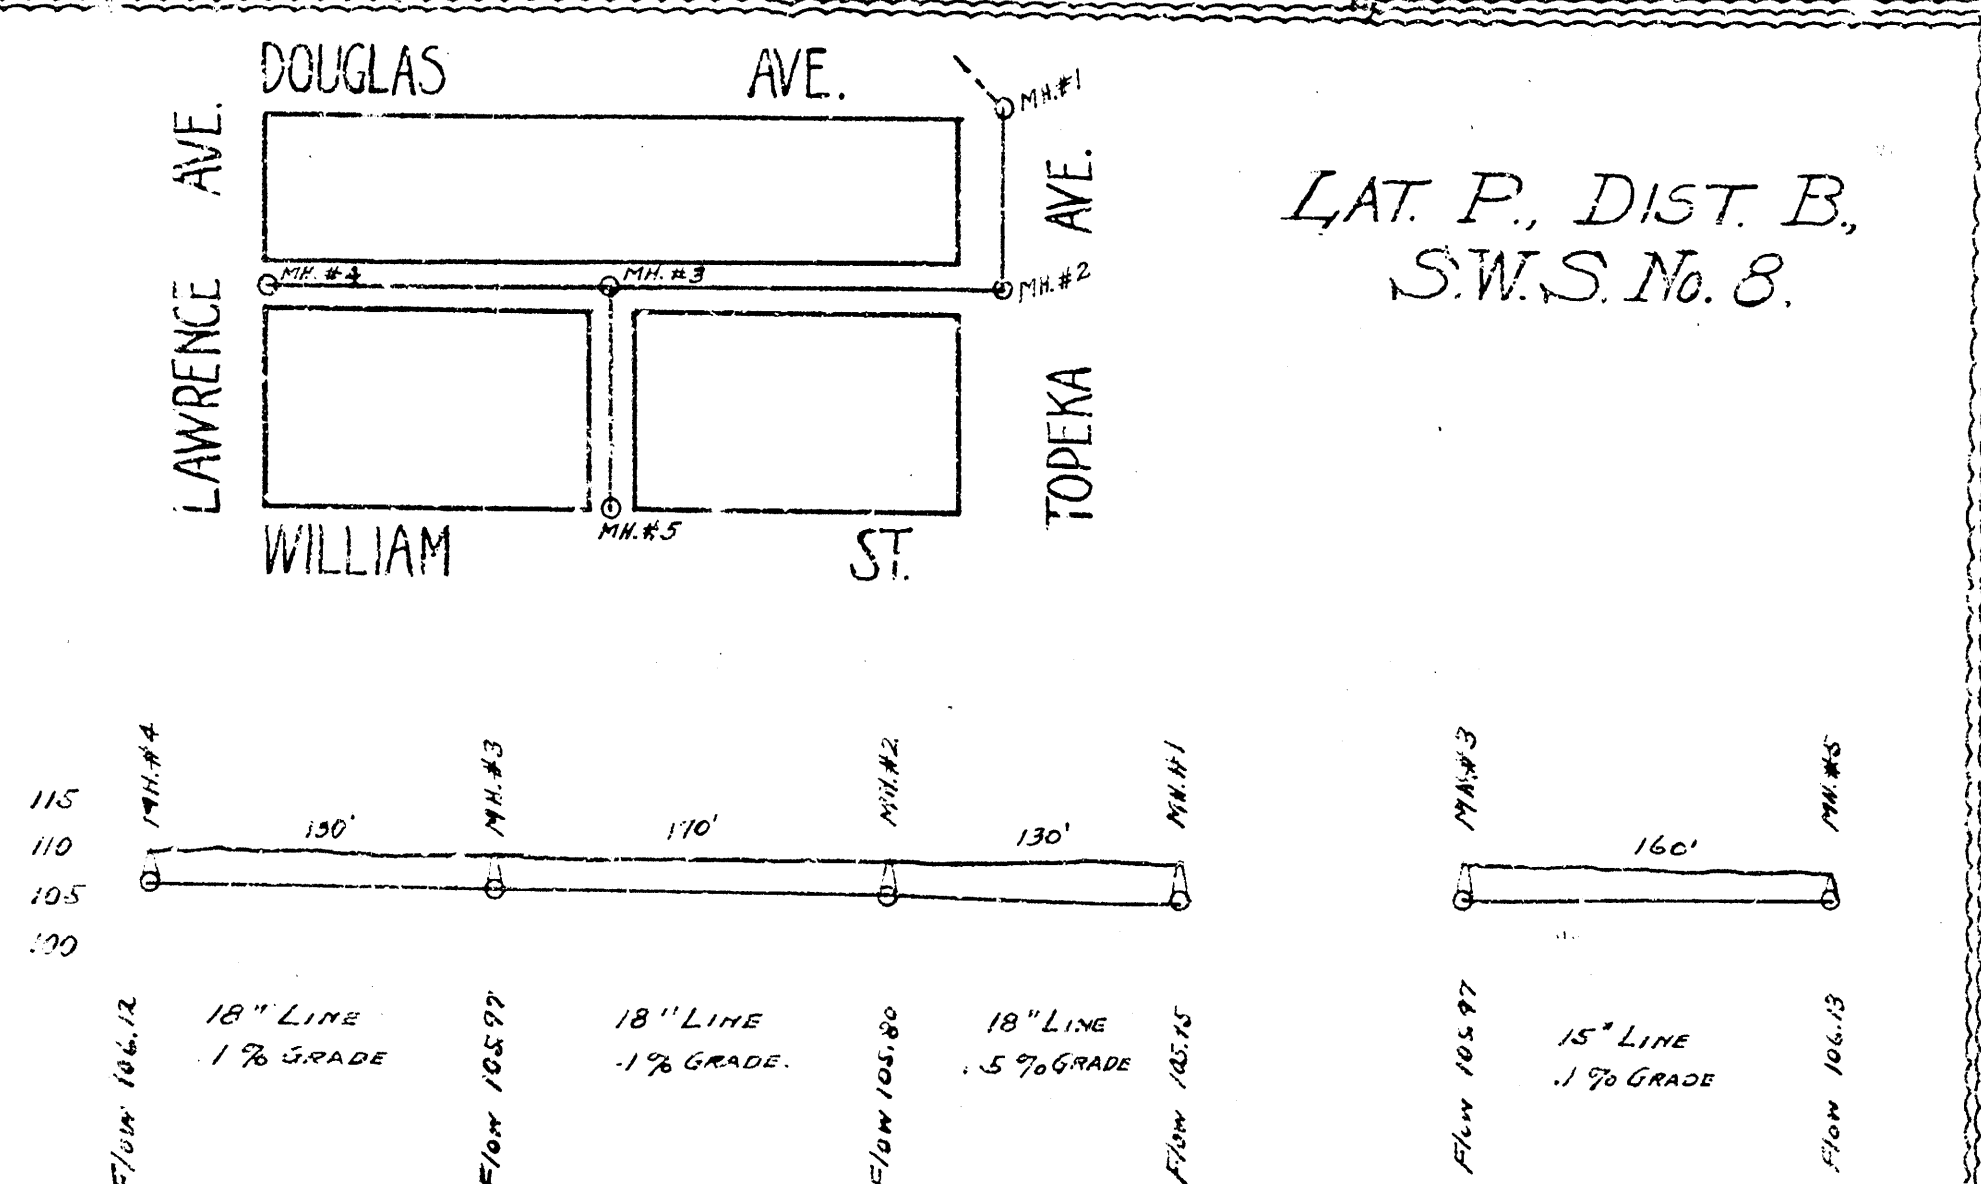

LAT. P, DIST. B., S.W.S. No. 8