


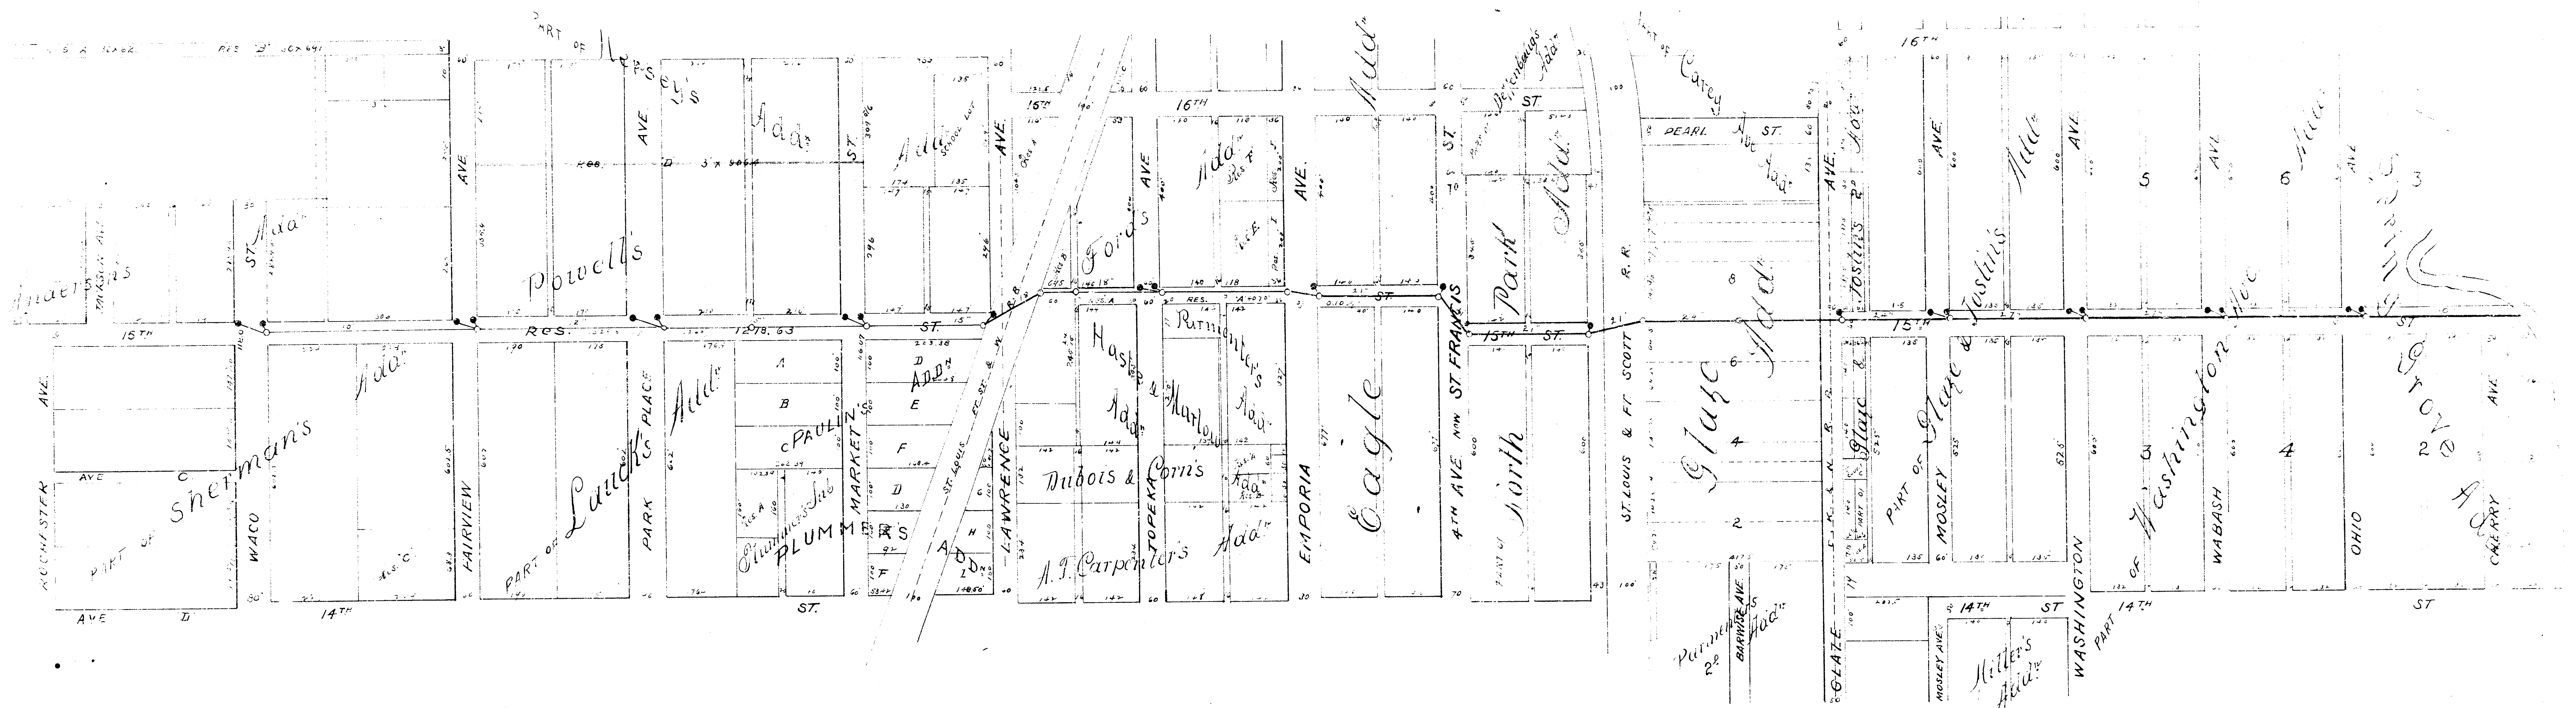

Fifteenth Street
lateral

Street
15th
16th

