
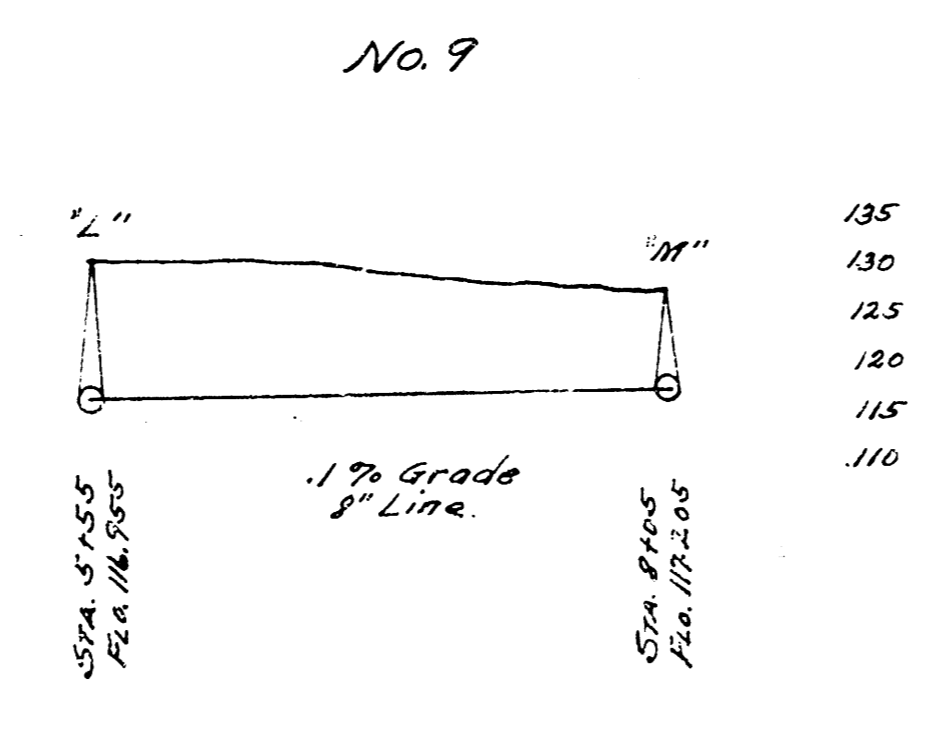
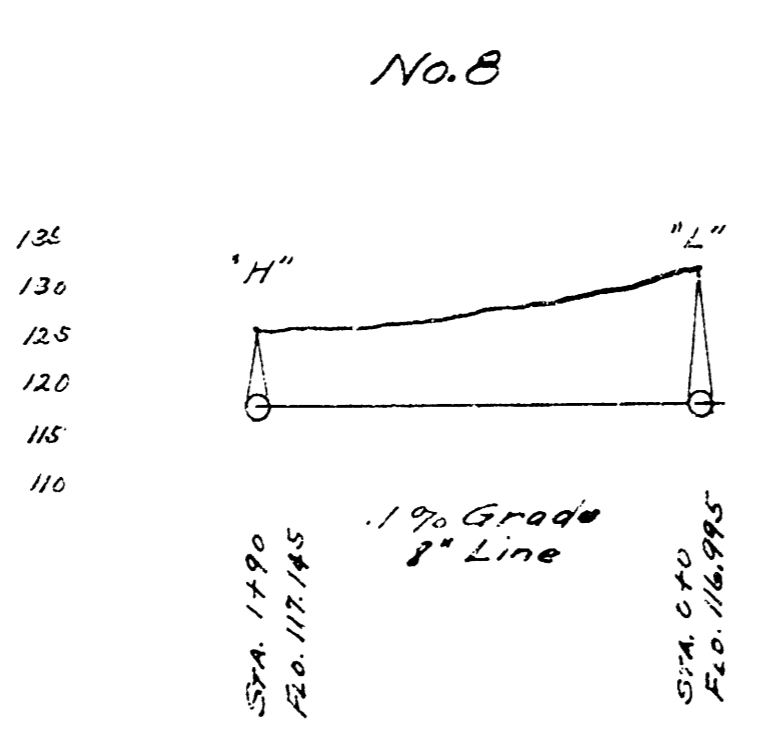
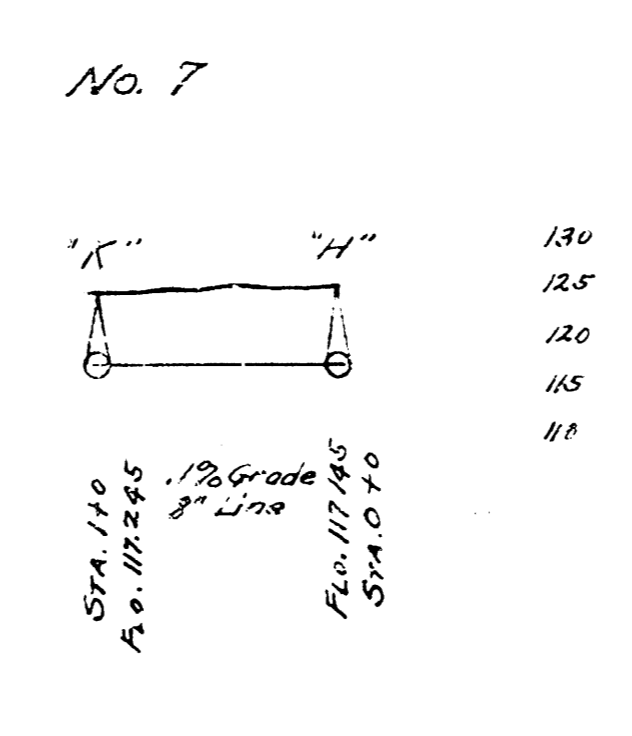
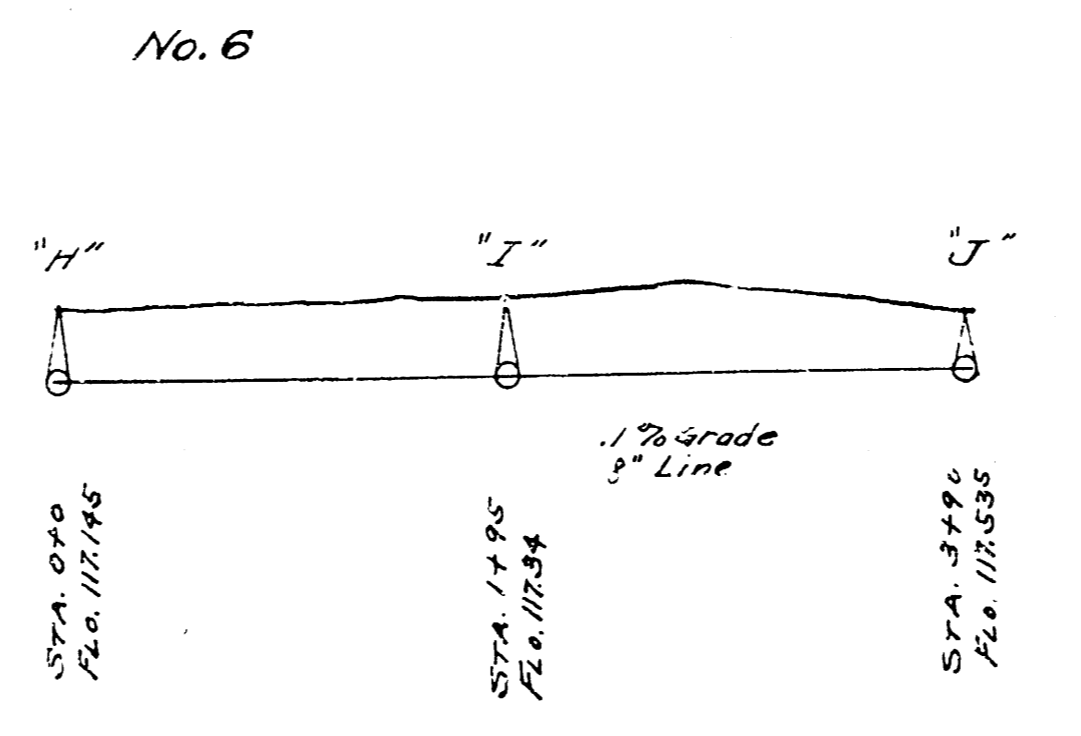
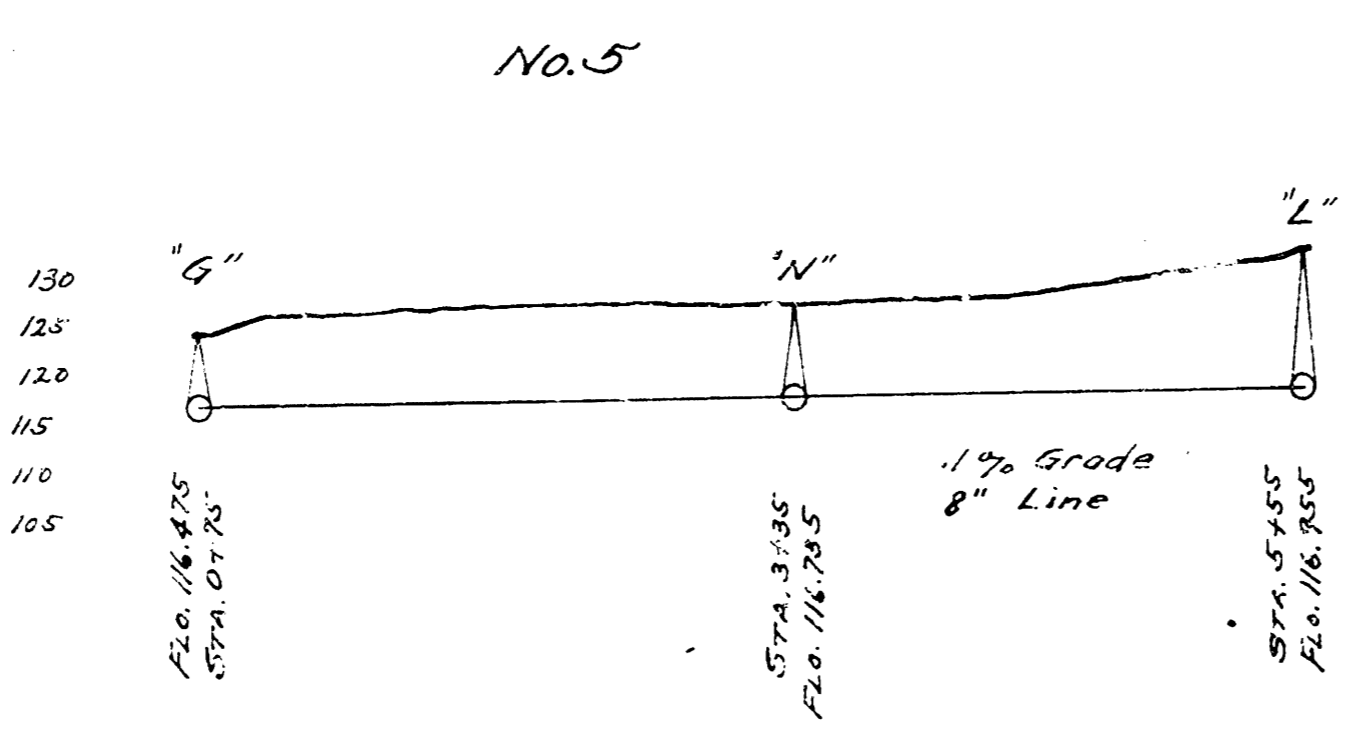
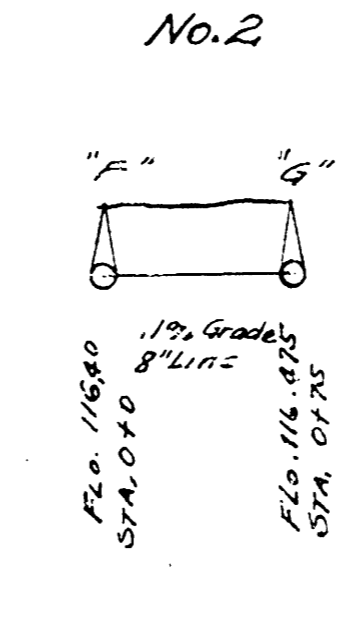
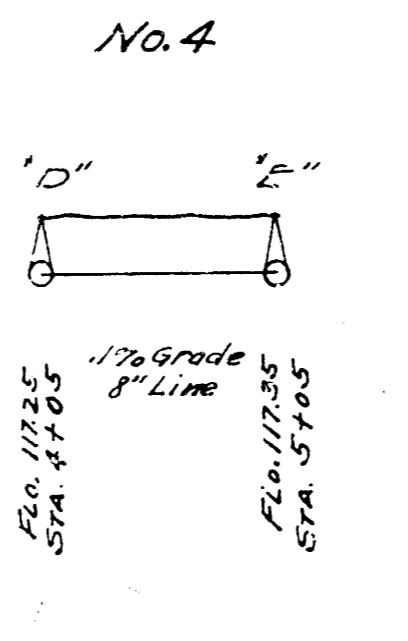
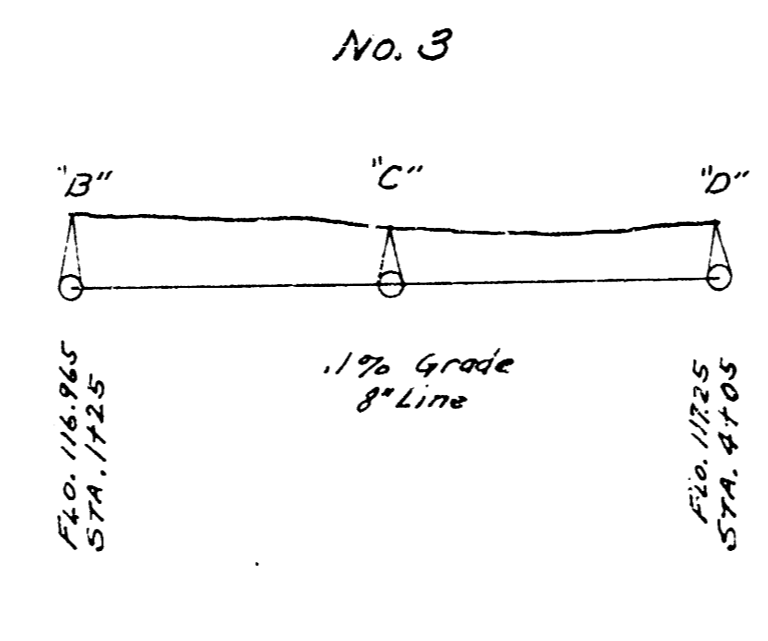
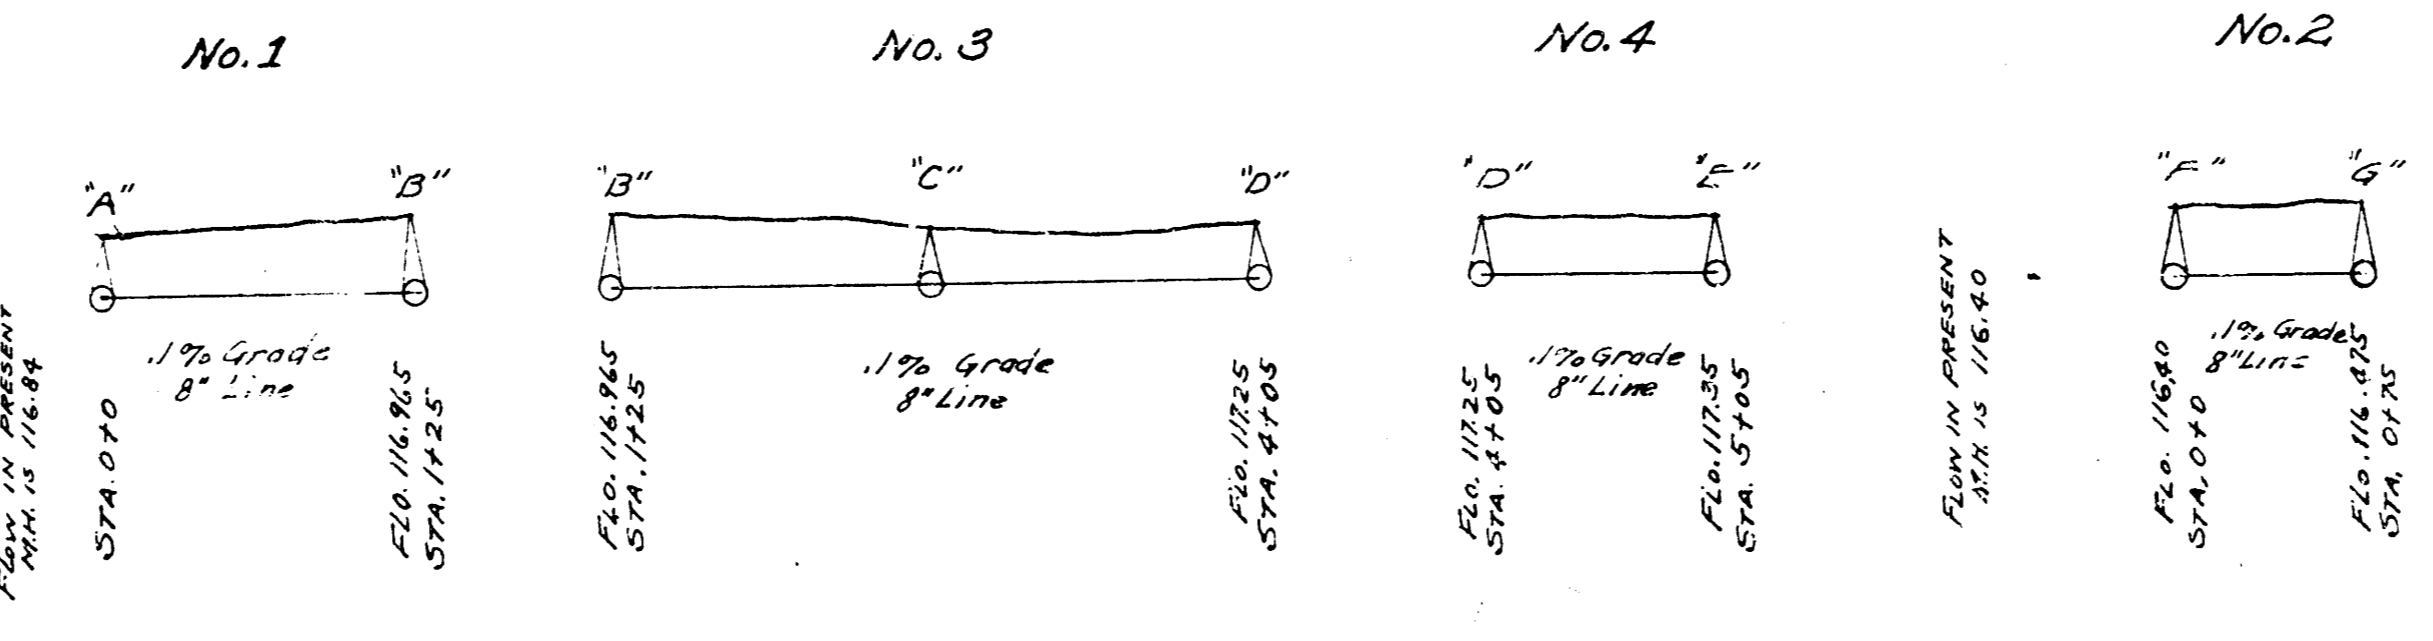


DIST. A  
S.S. No. 15

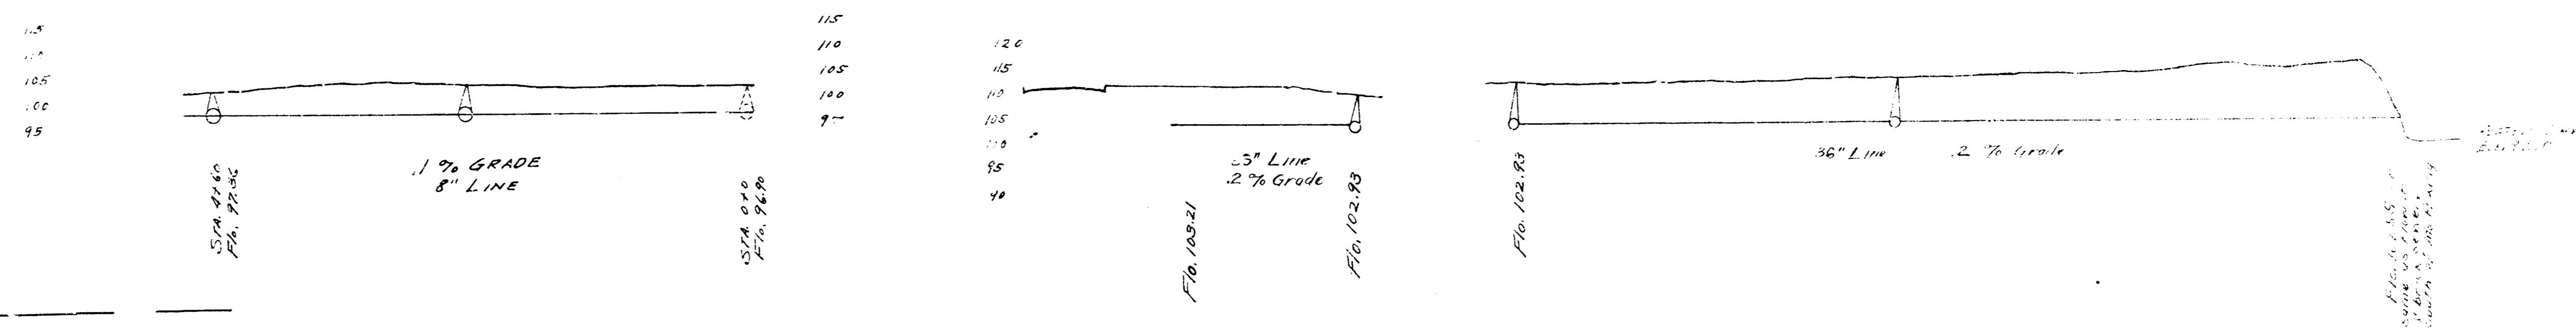

NOTE:  
SEE PLAT AT LEFT FOR LOCATION OF LINES AS DESIGNATED BY NUMBERS AND MANHOLES AS DESIGNATED BY LETTERS.