PROPOSED CHANGE
OF
STORM SEWER
AT
MOSLEY & FIRST

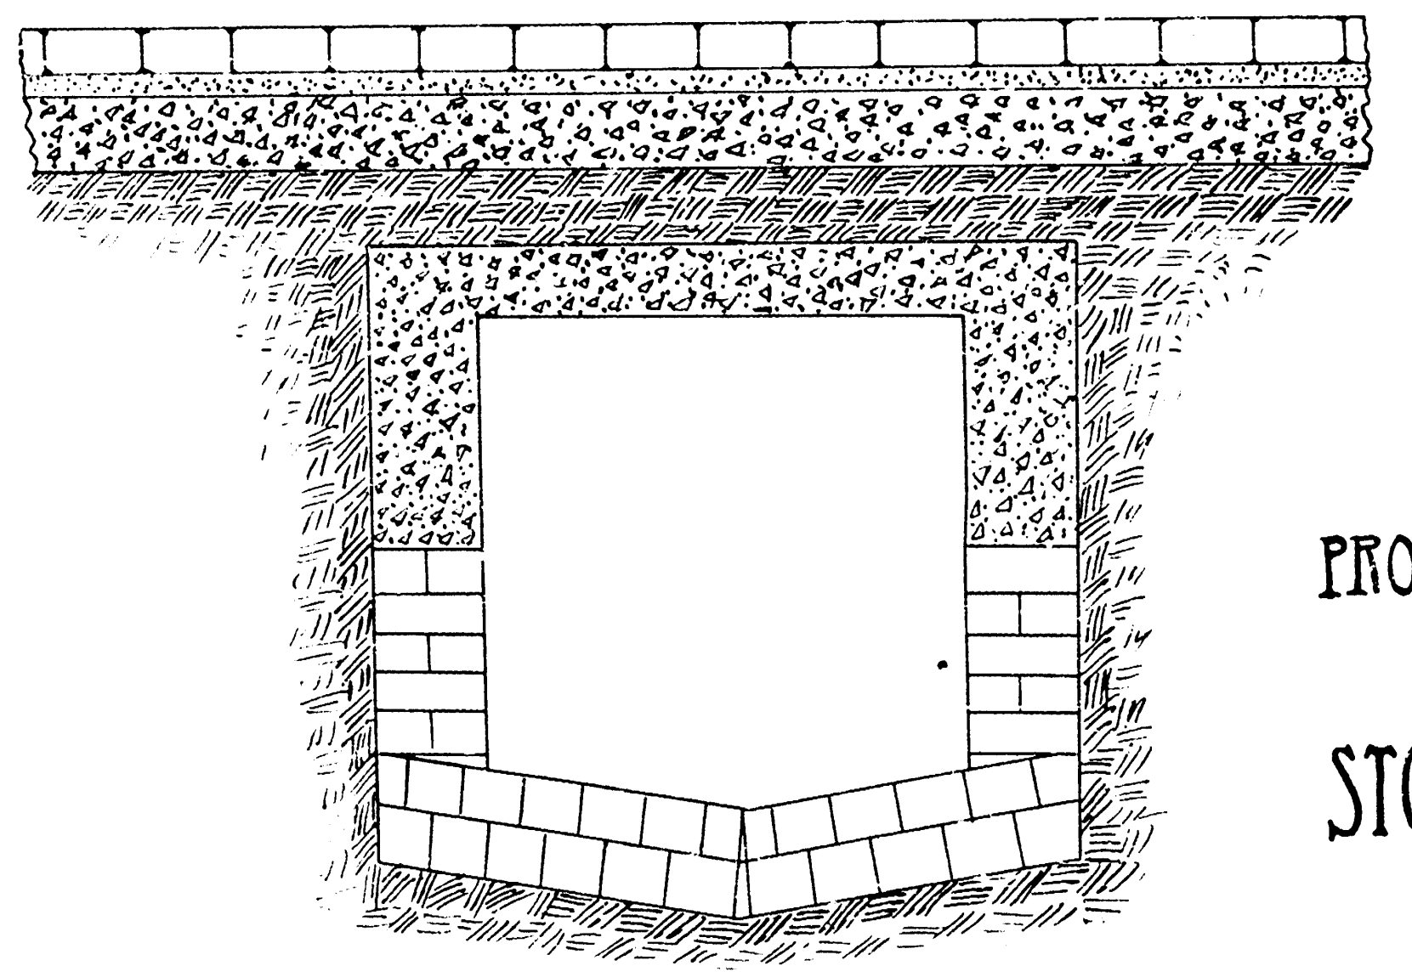

CROSS SECTION
BETWEEN TRACKS

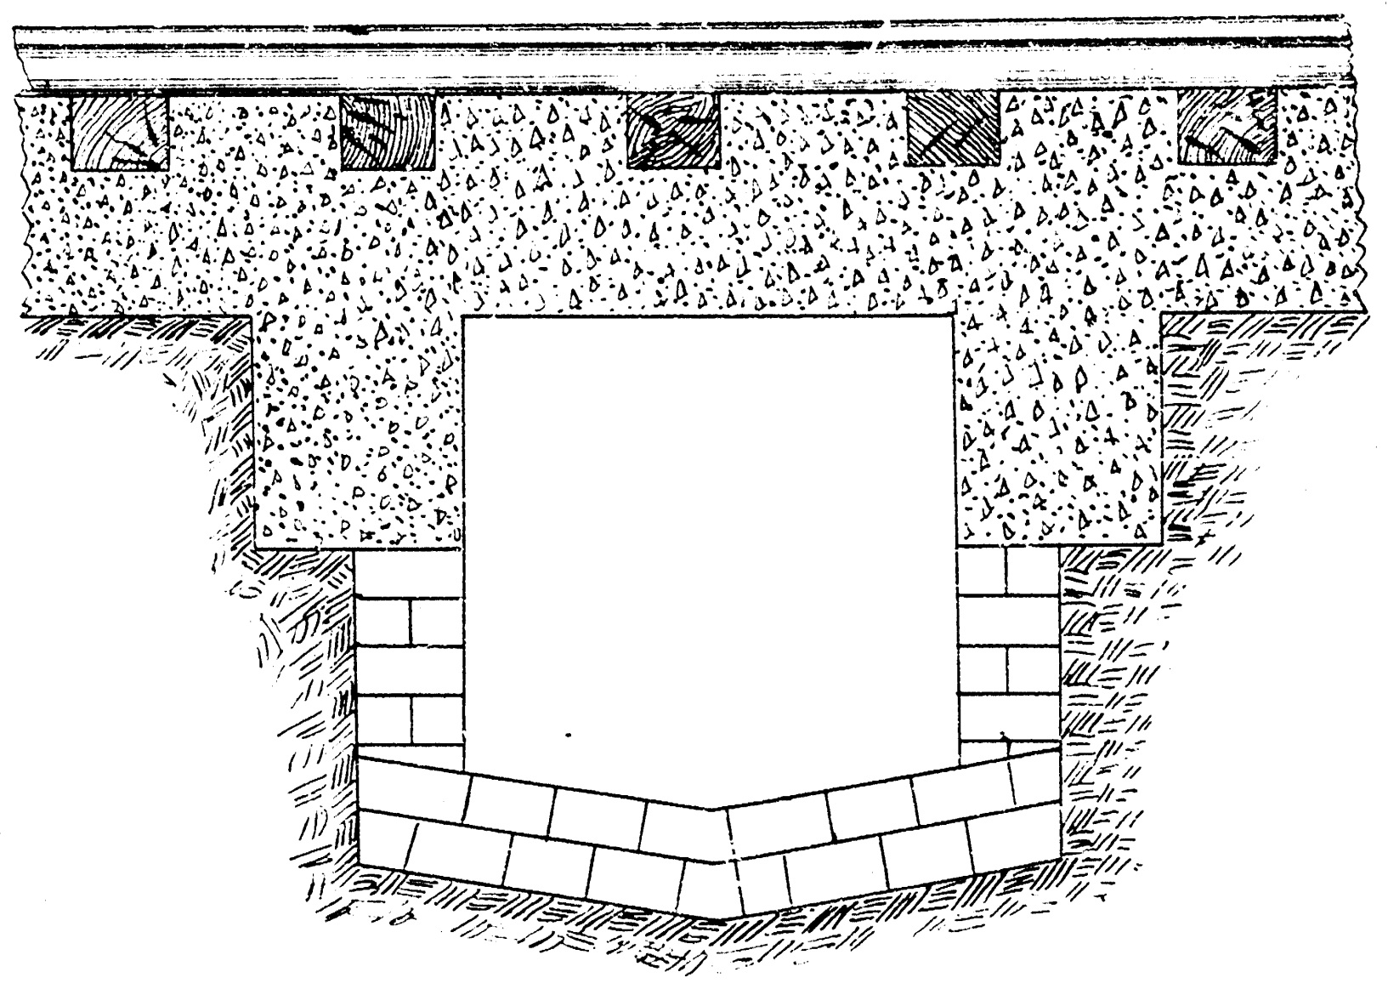

CROSS SECTION
UNDER TRACKS

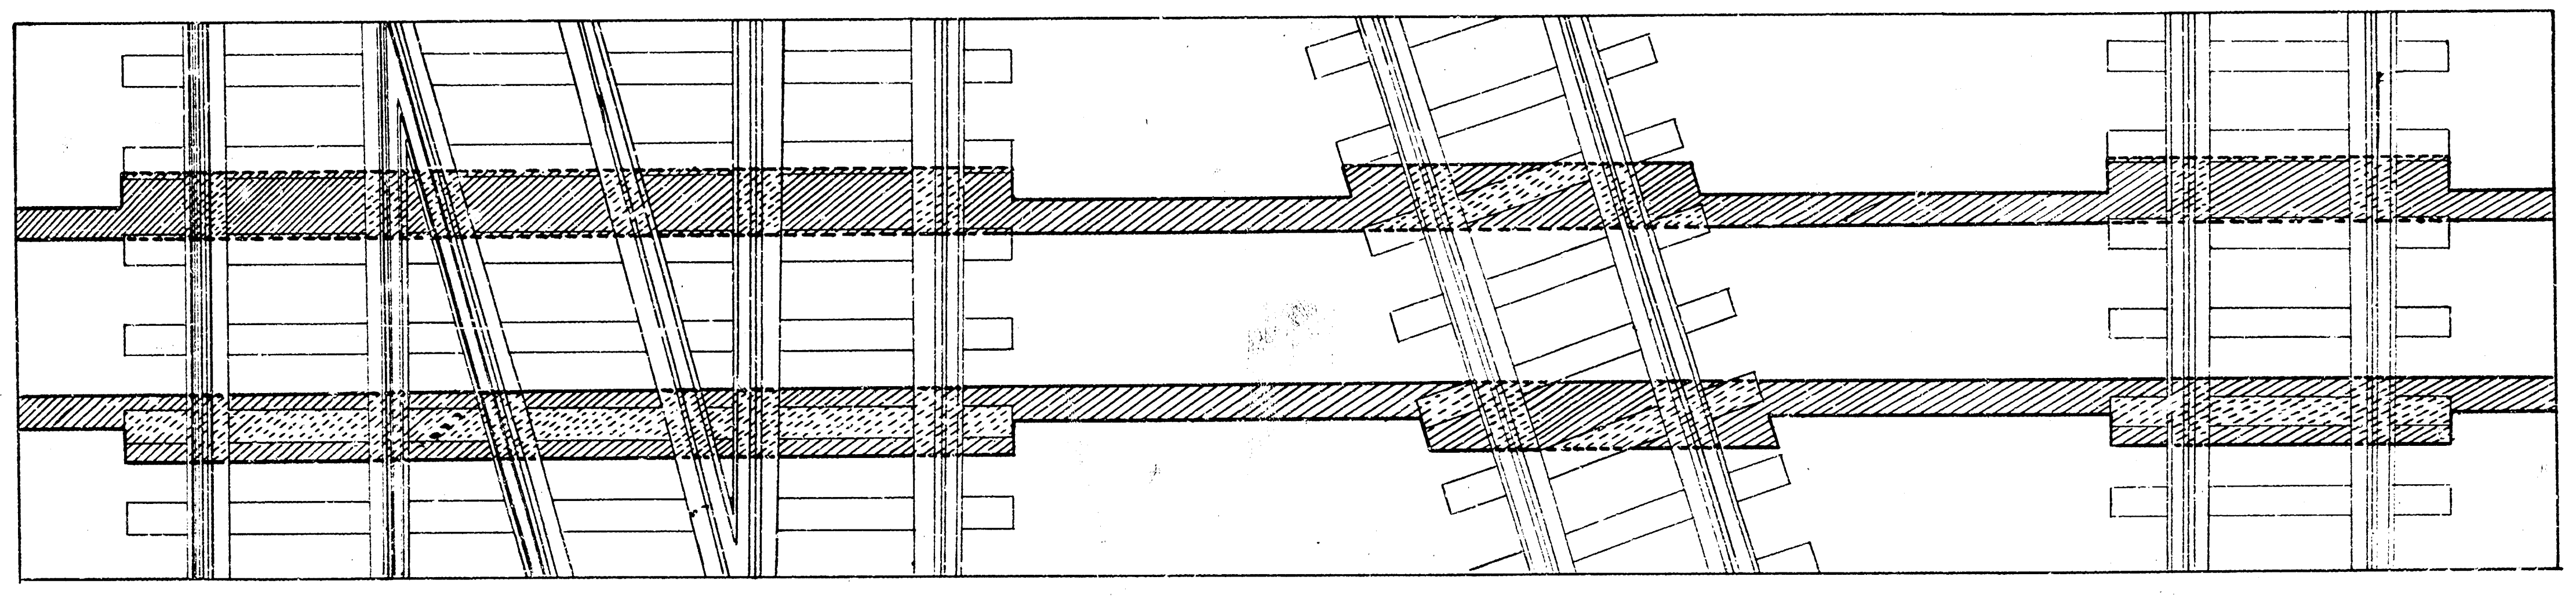

PLAN

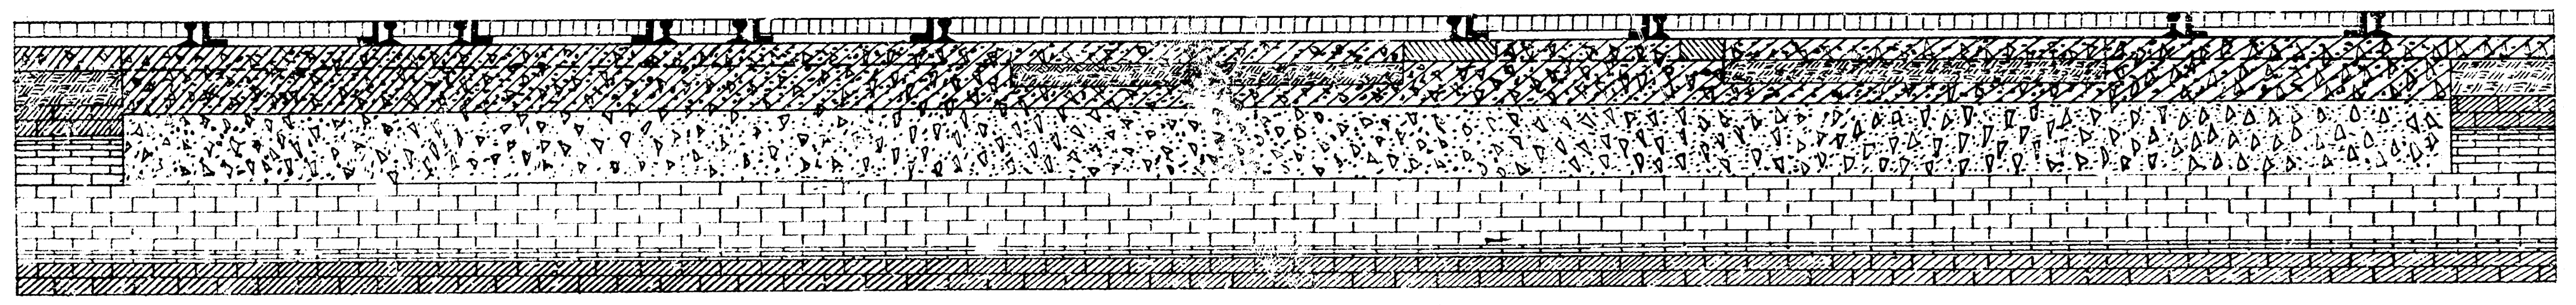

ELEVATION

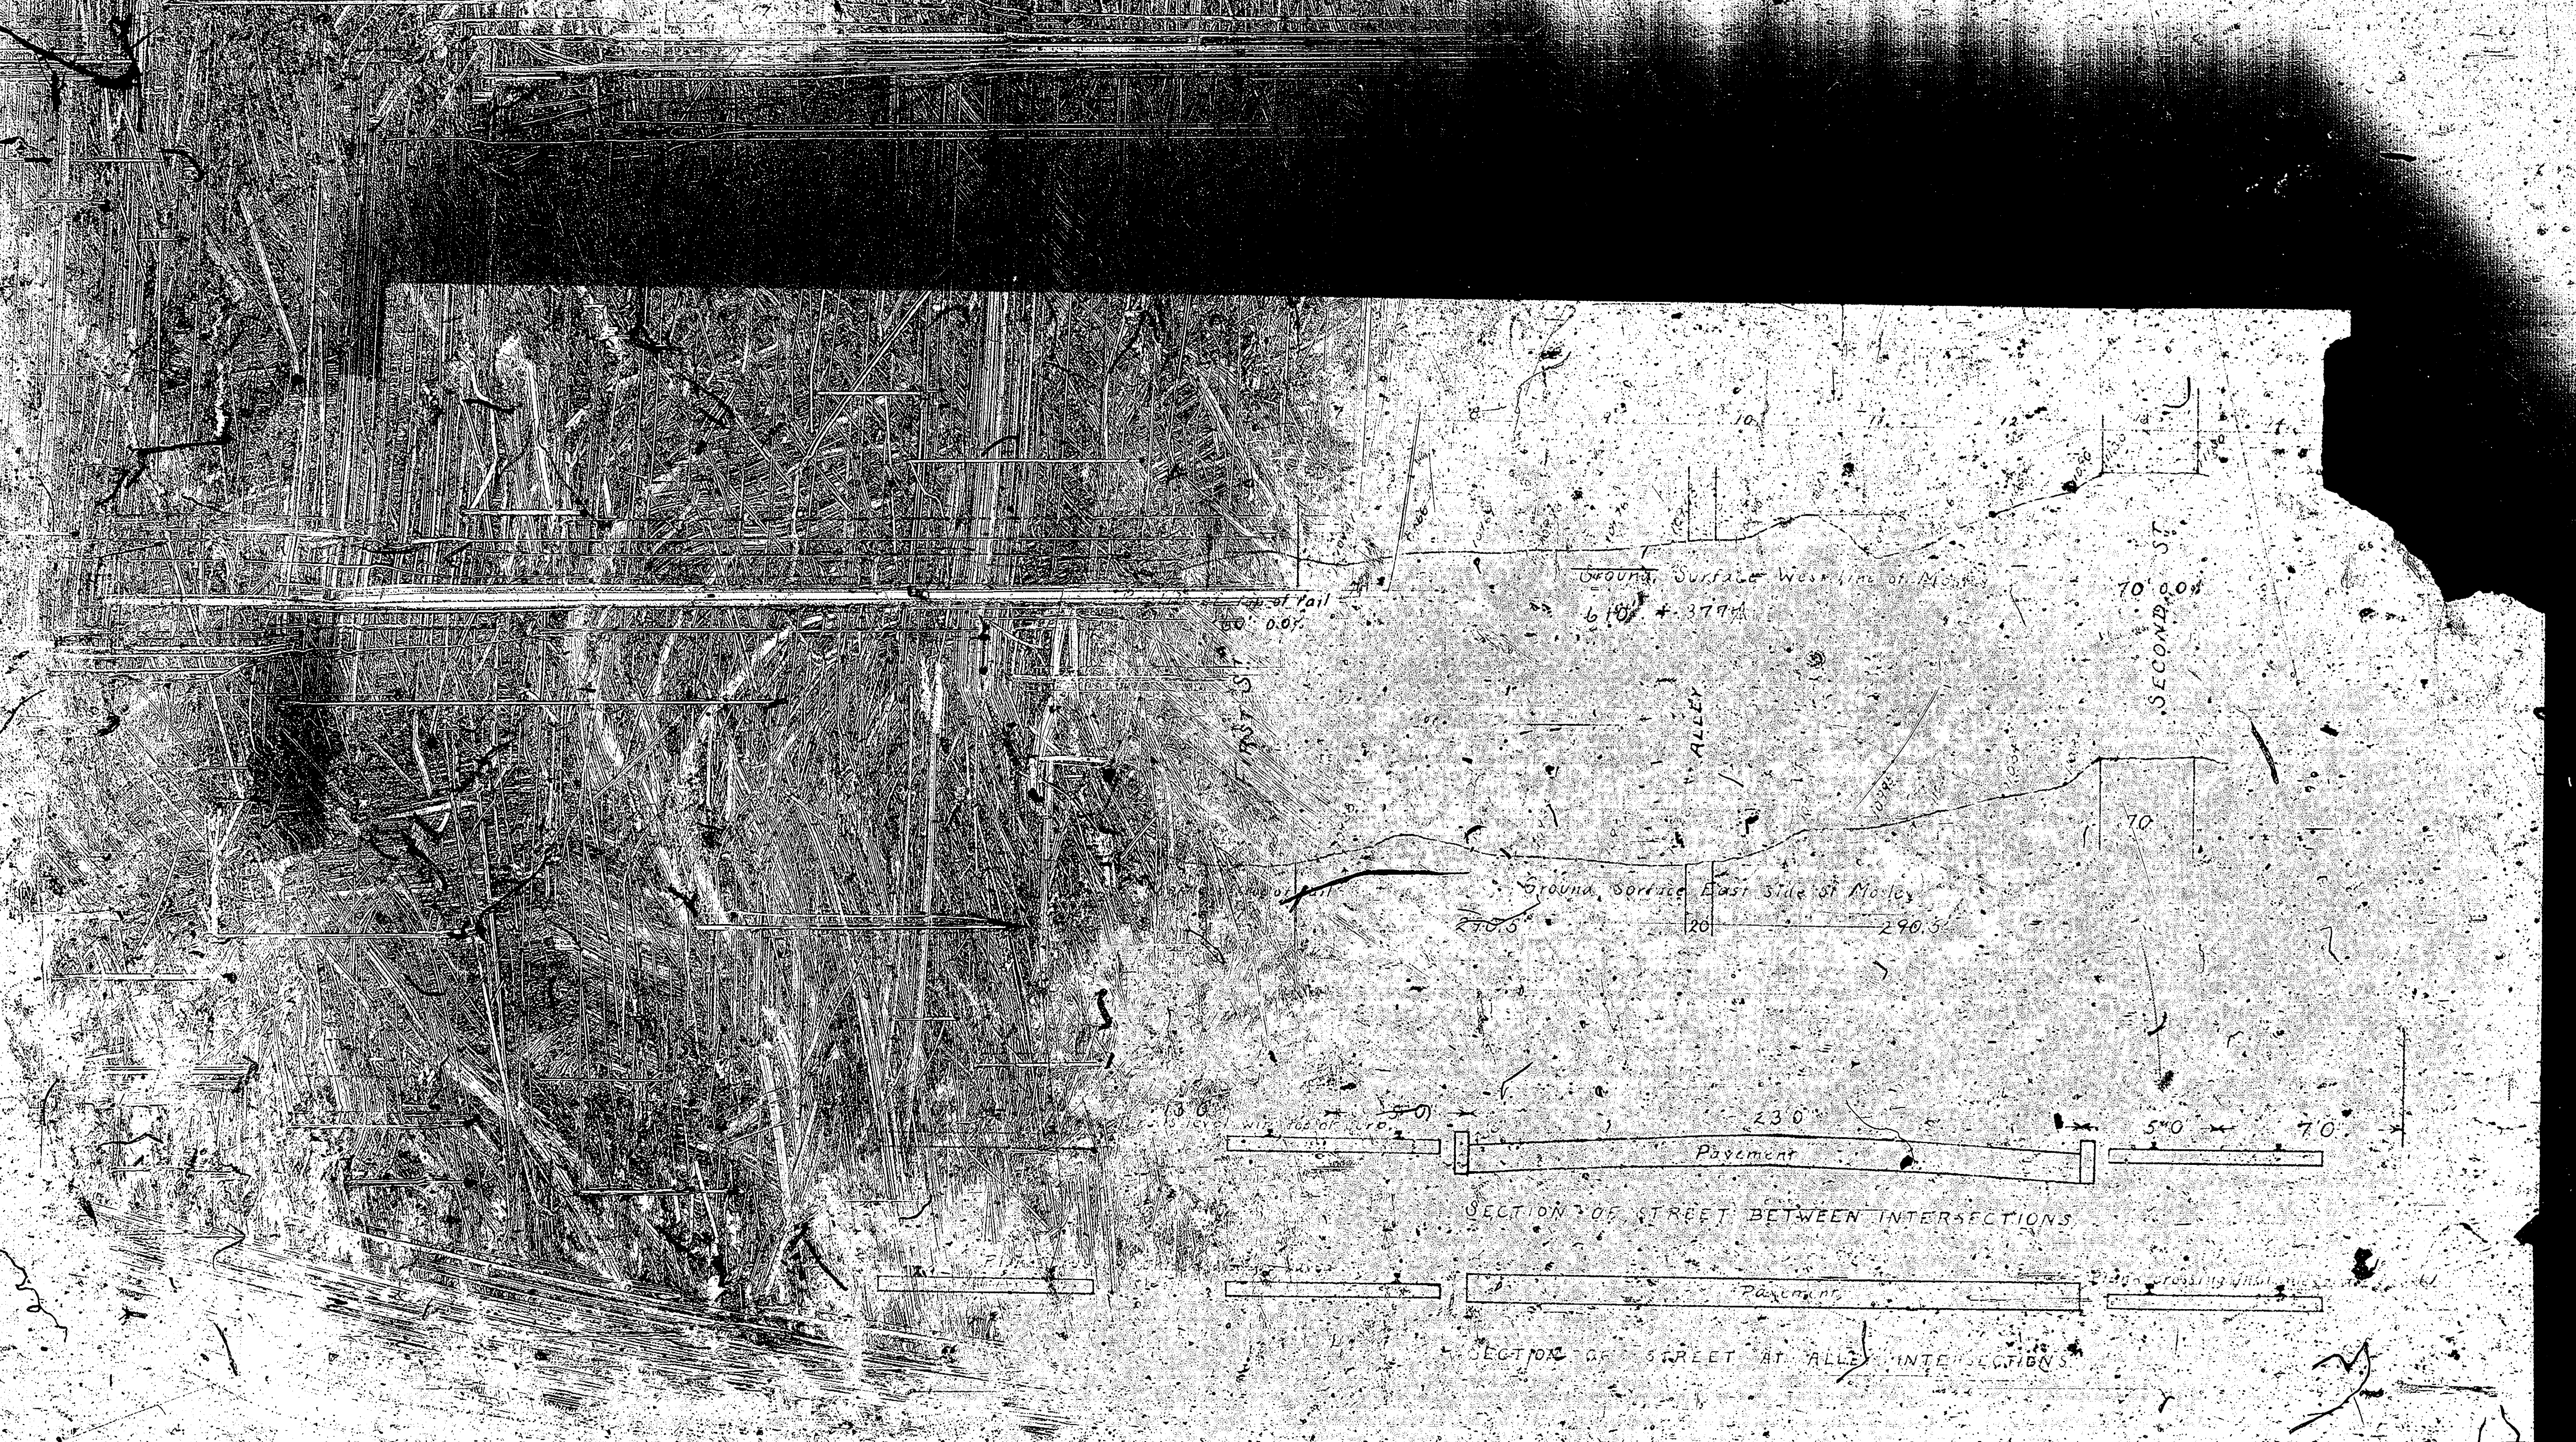
Ground Surface West line of Mosley
610' + 377%
top of rail
0.0%
70' 0.0%
FIRST ST
ALLEY
SECOND ST
Ground Surface East side of Mosley
270.5
20
290.5
70
10
11
12
13
14
23.0
5.0
7.0
Pavement
SECTION OF STREET BETWEEN INTERSECTIONS
Pavement
SECTION OF STREET AT ALLEY INTERSECTIONS

PROFILE AND GRADES ON MOSLEY AVENUE
DOU[illegible] AVENUE TO SECOND STREET