




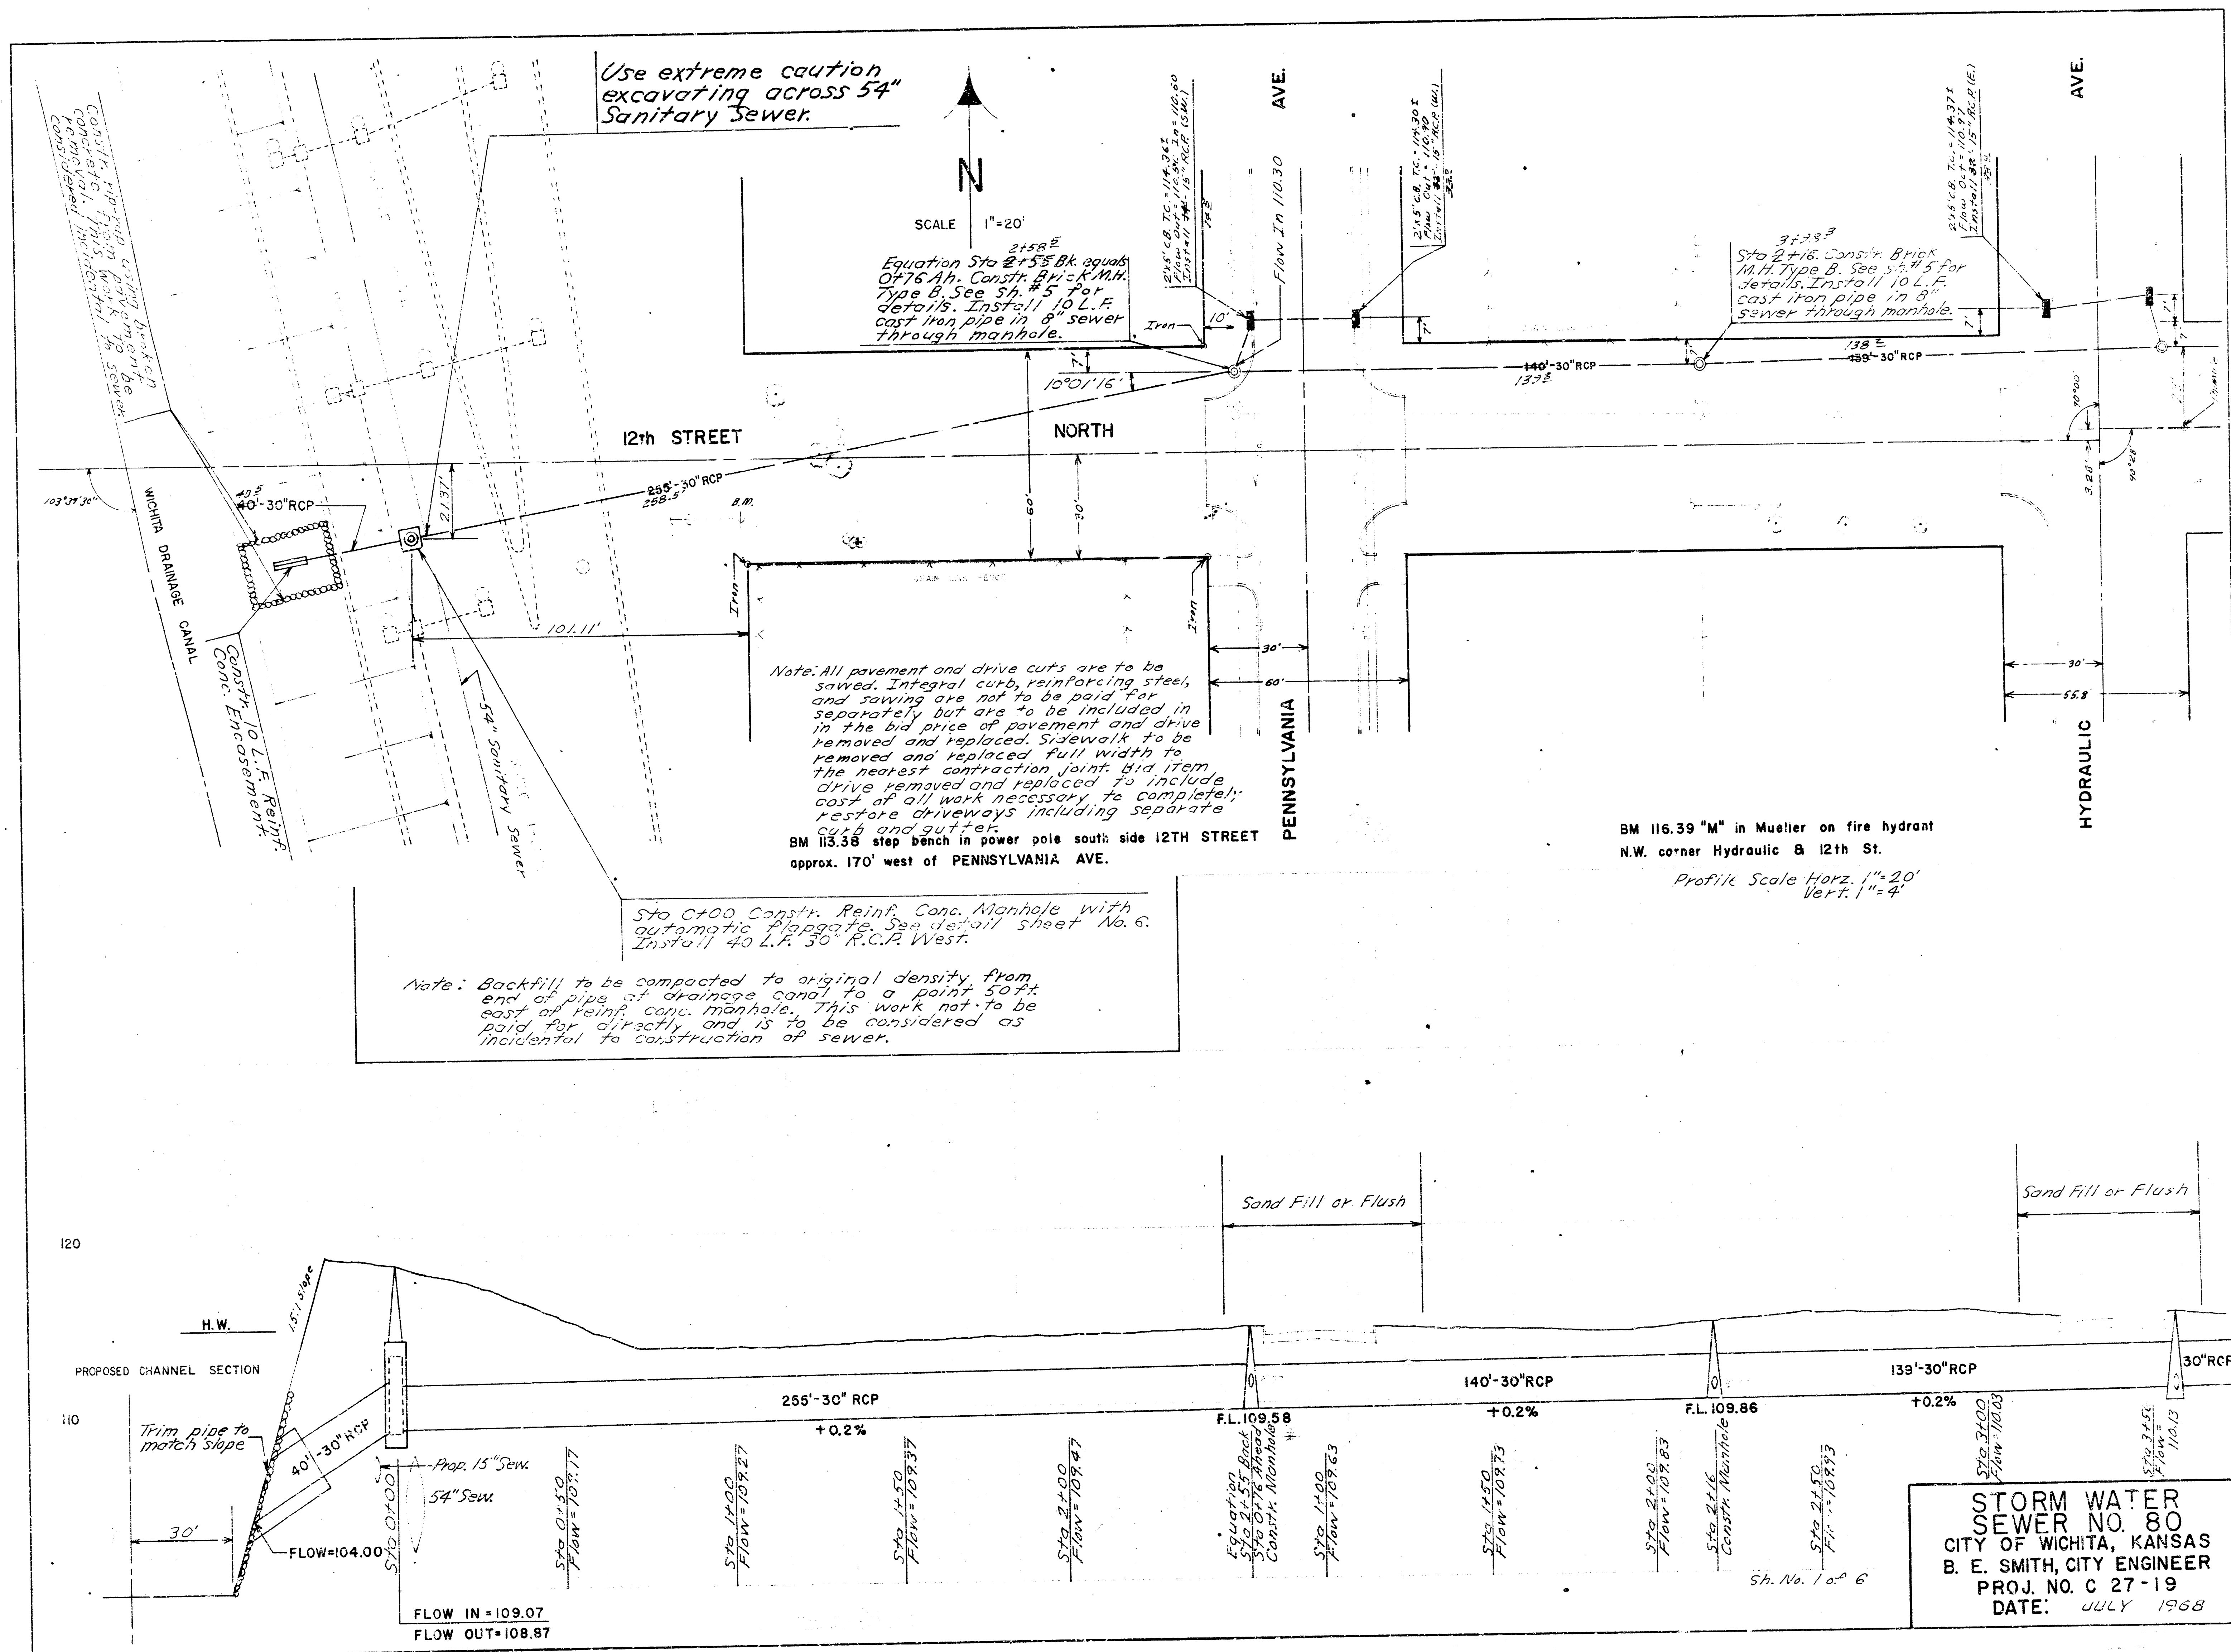


TOP VIEW

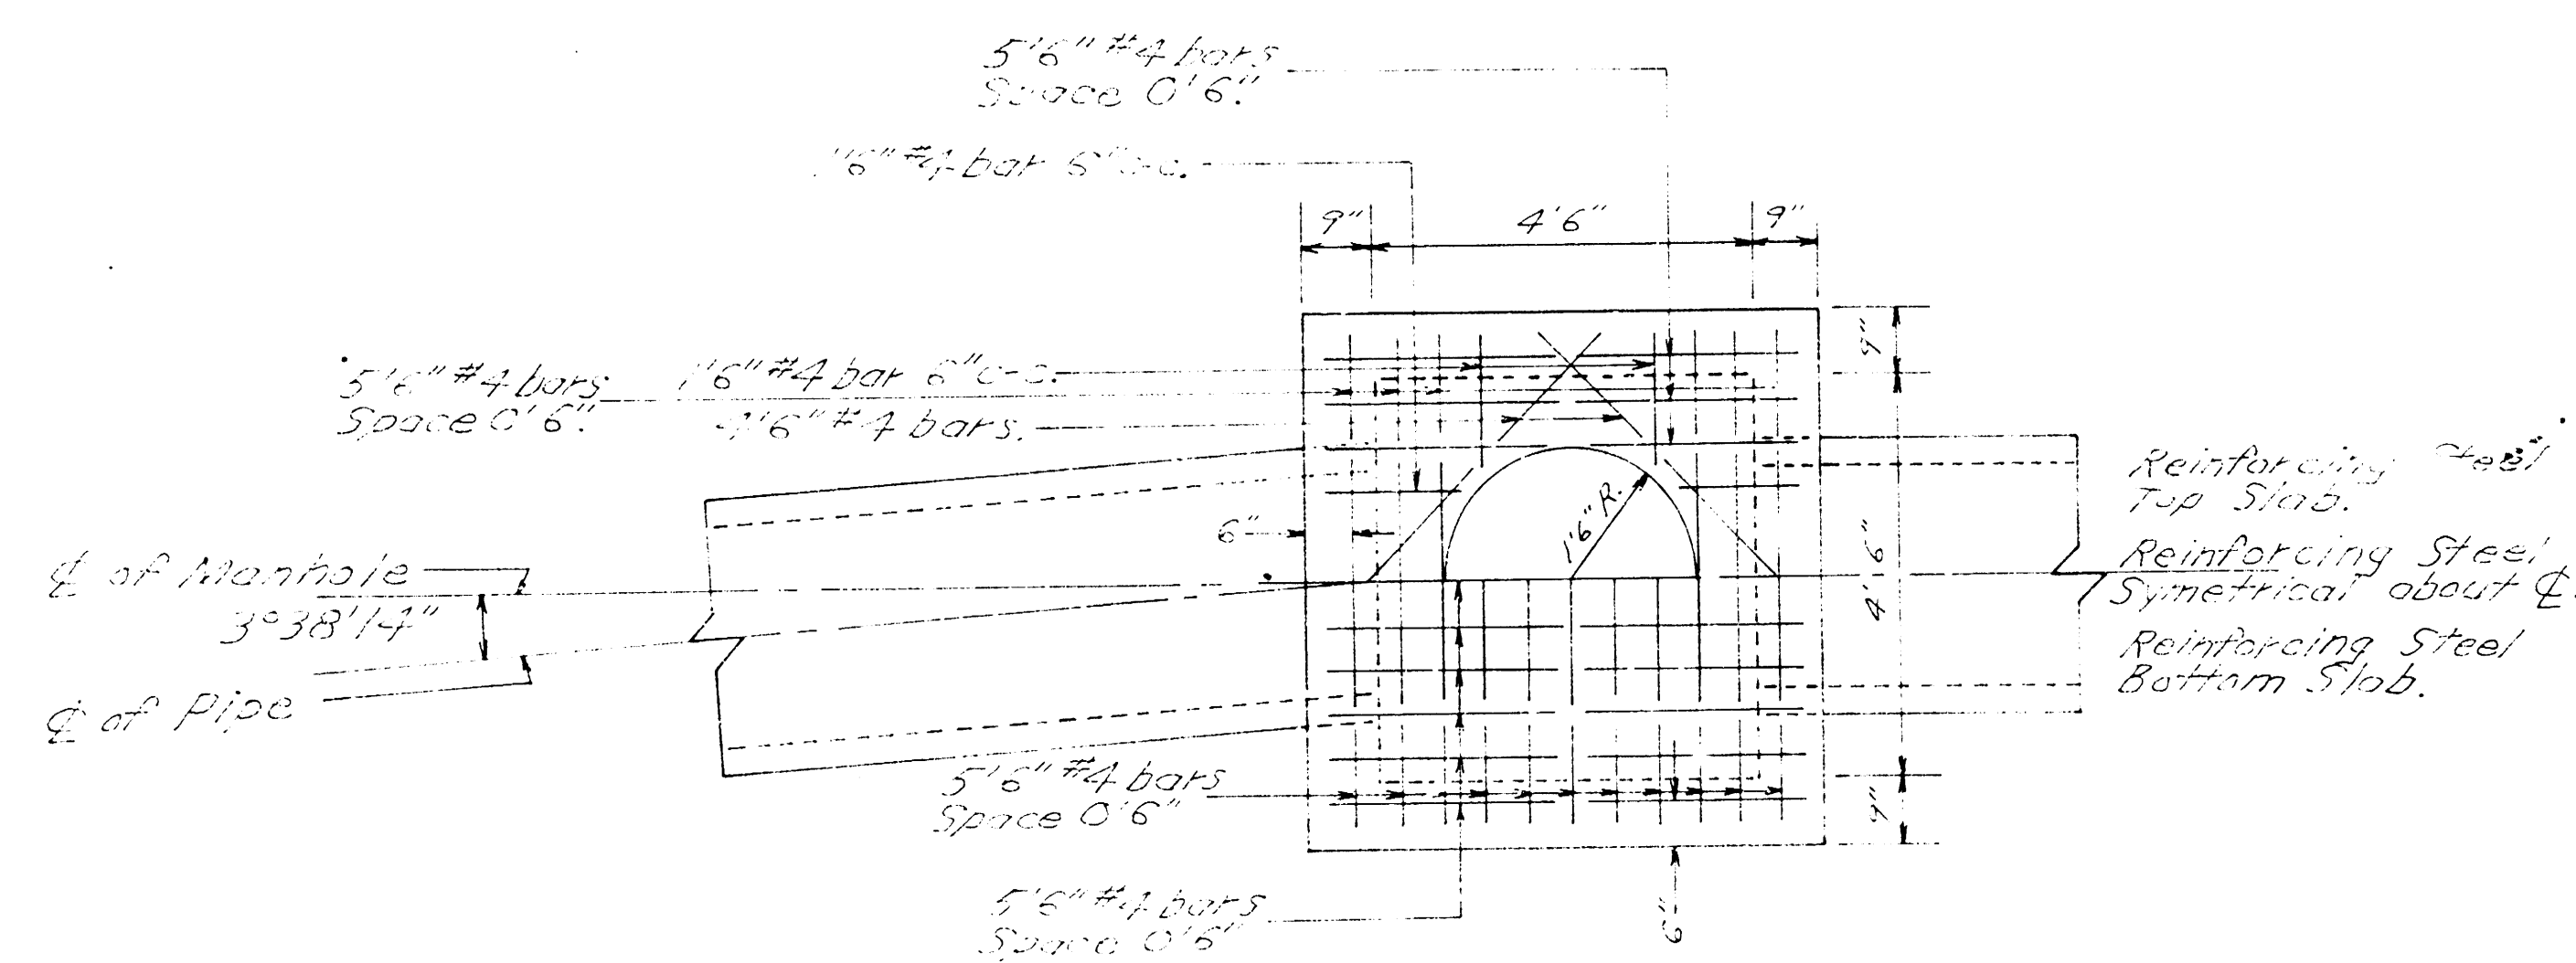

ELEVATION

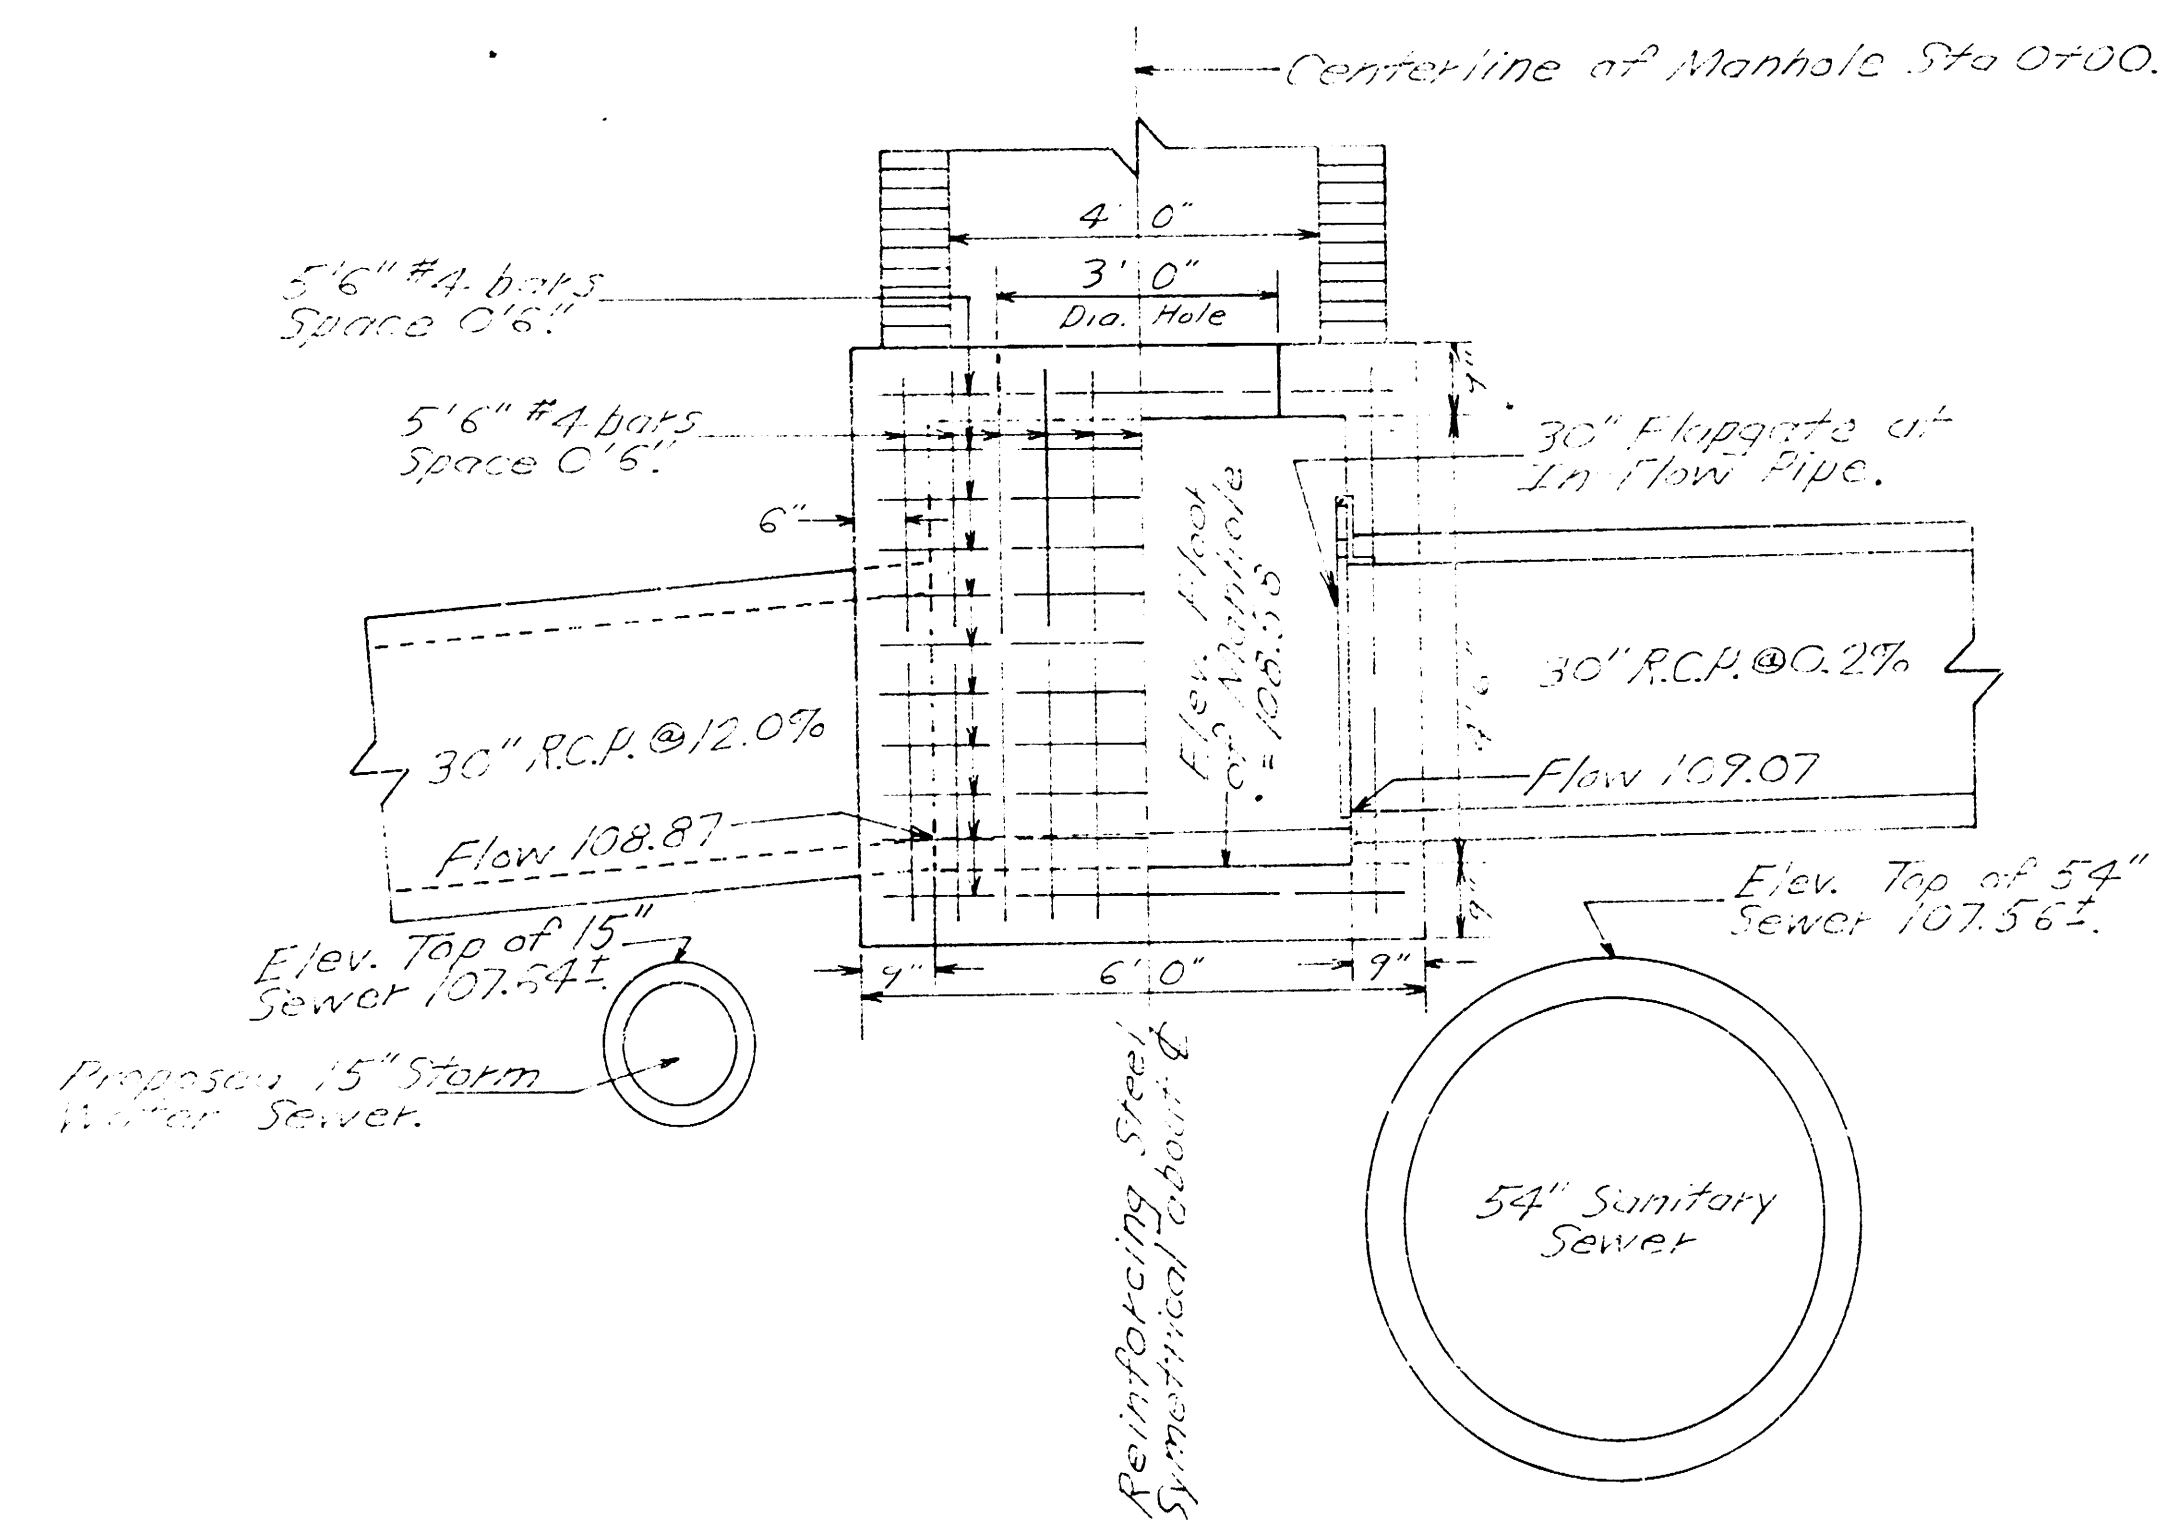

ELEVATION

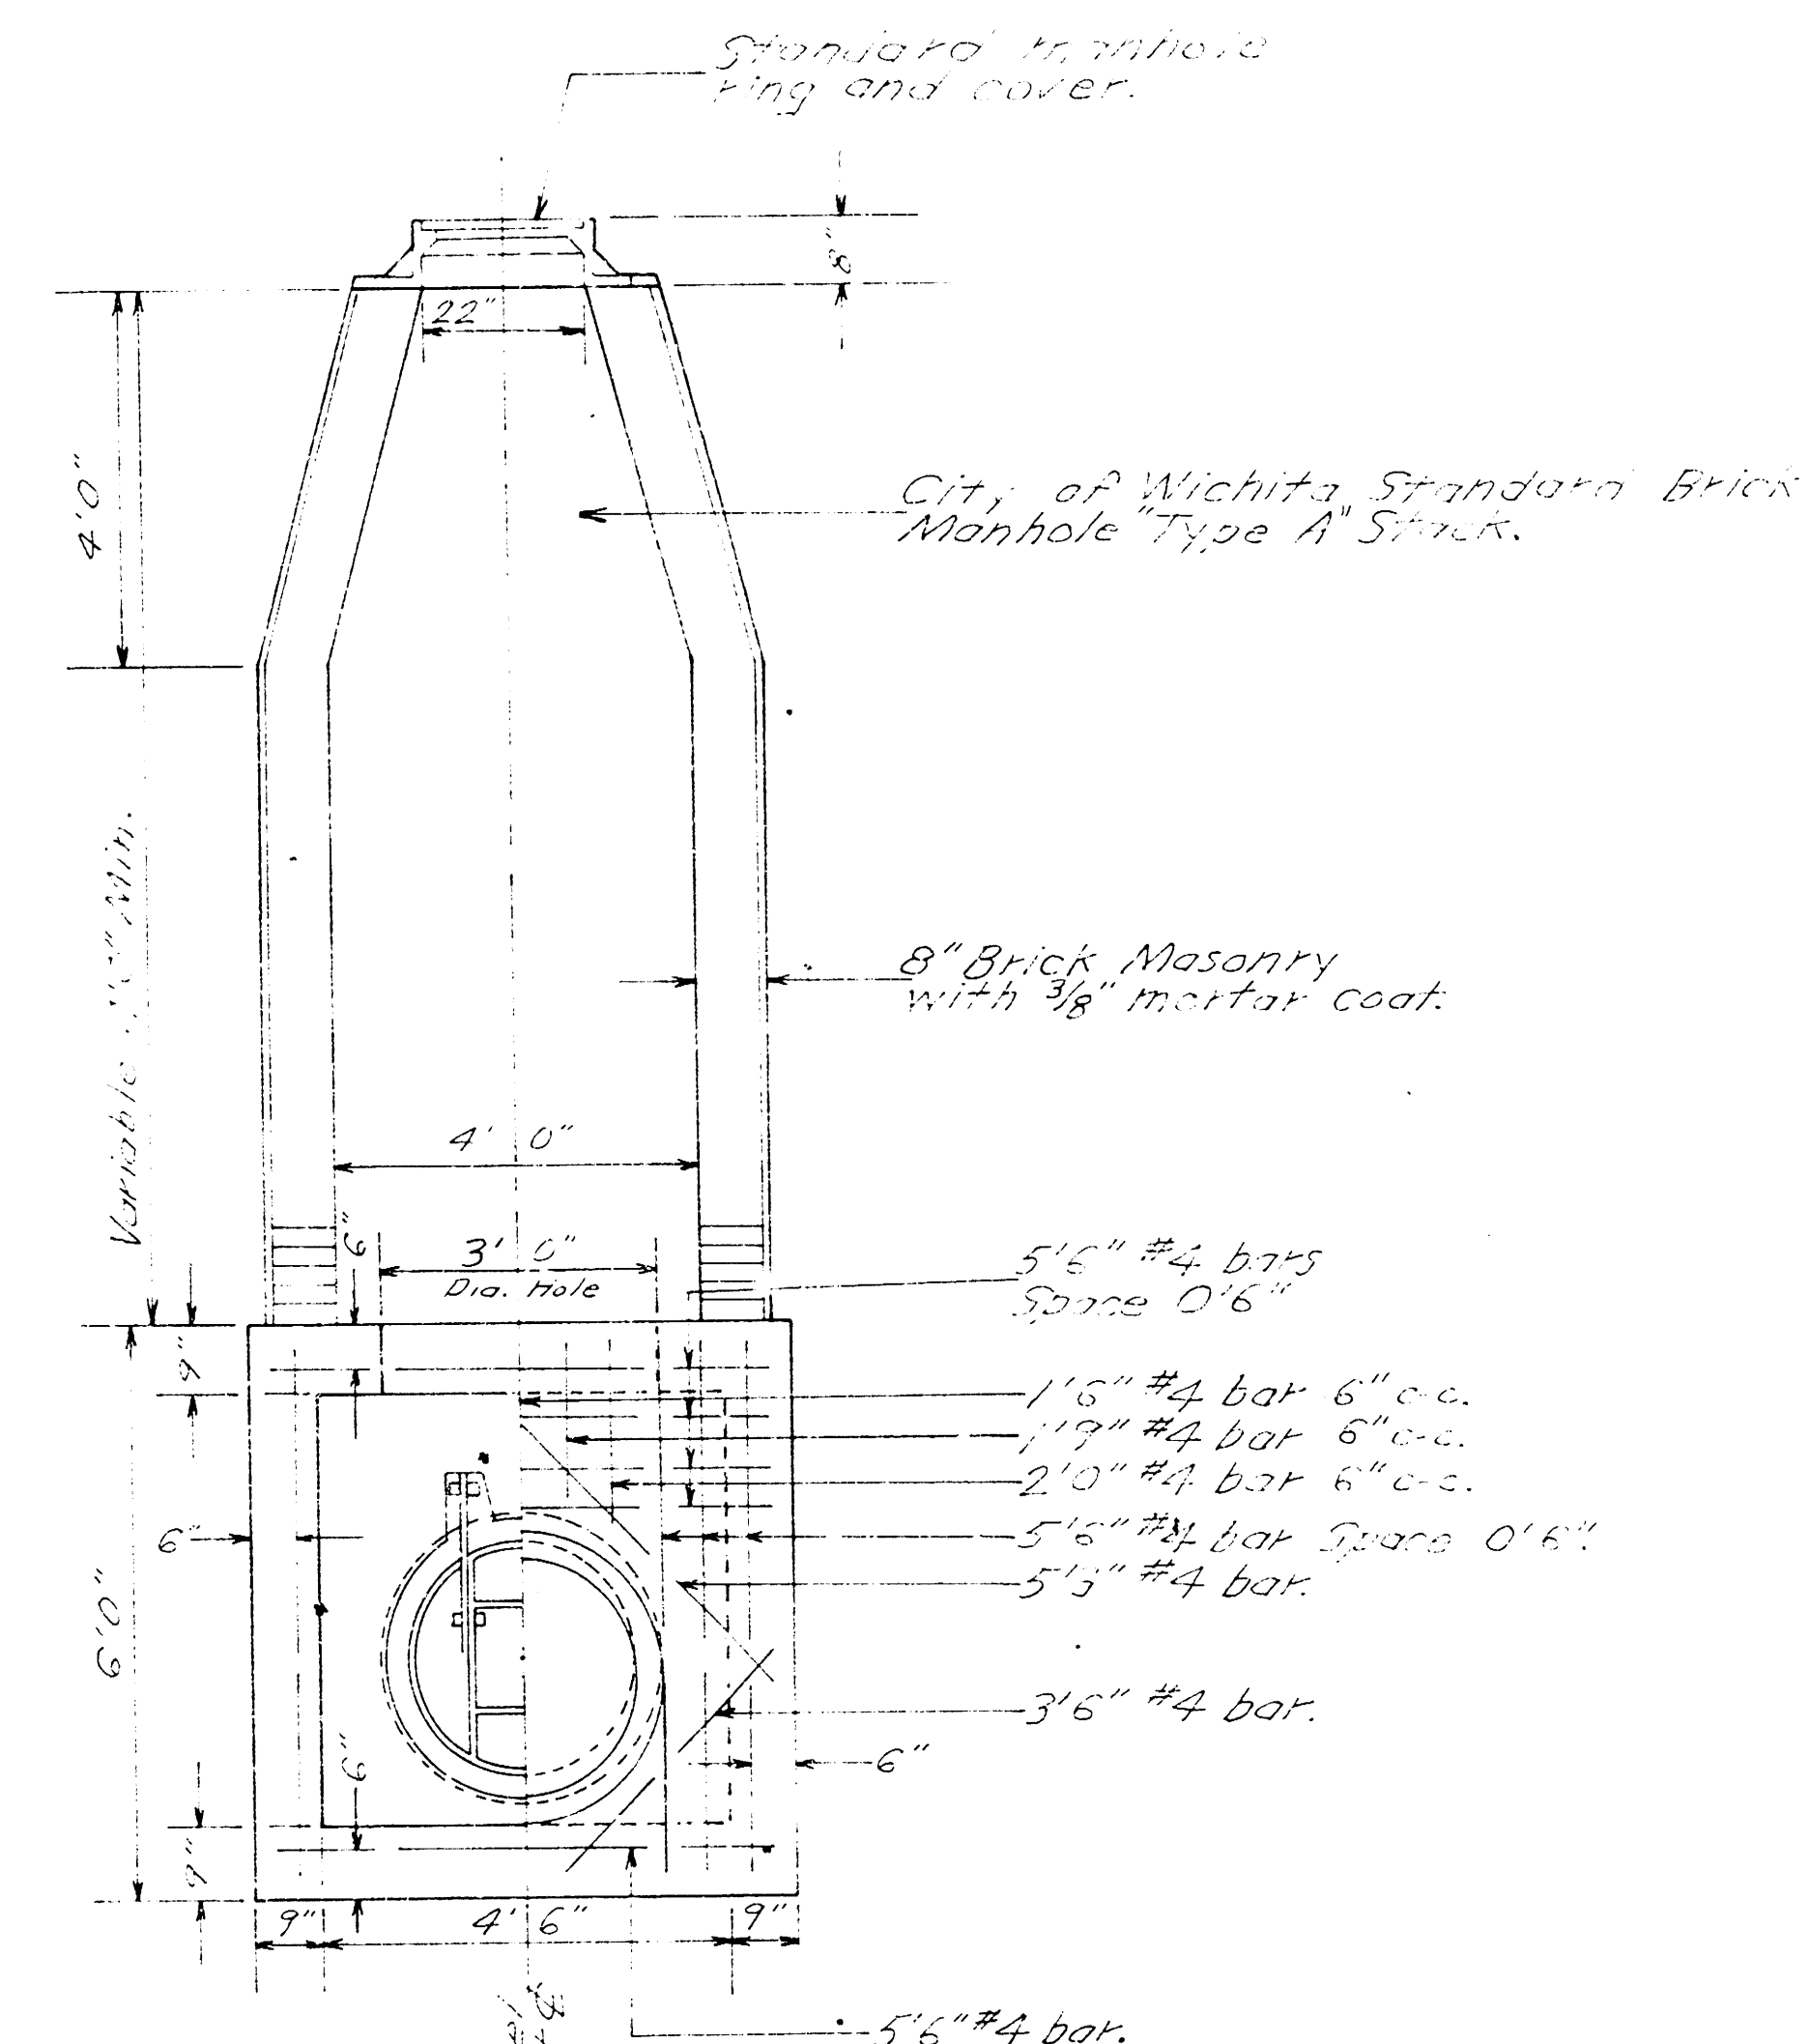




Bill of Material
374 Lbs. Reinforcing Steel
#1 Cu. Yds. Concrete


REINFORCED
CONCRETE
MANHOLE
STORM WATER
SEWER NO. 80
PROJ. NO. C 27-19

Sta. No. 6 of 6

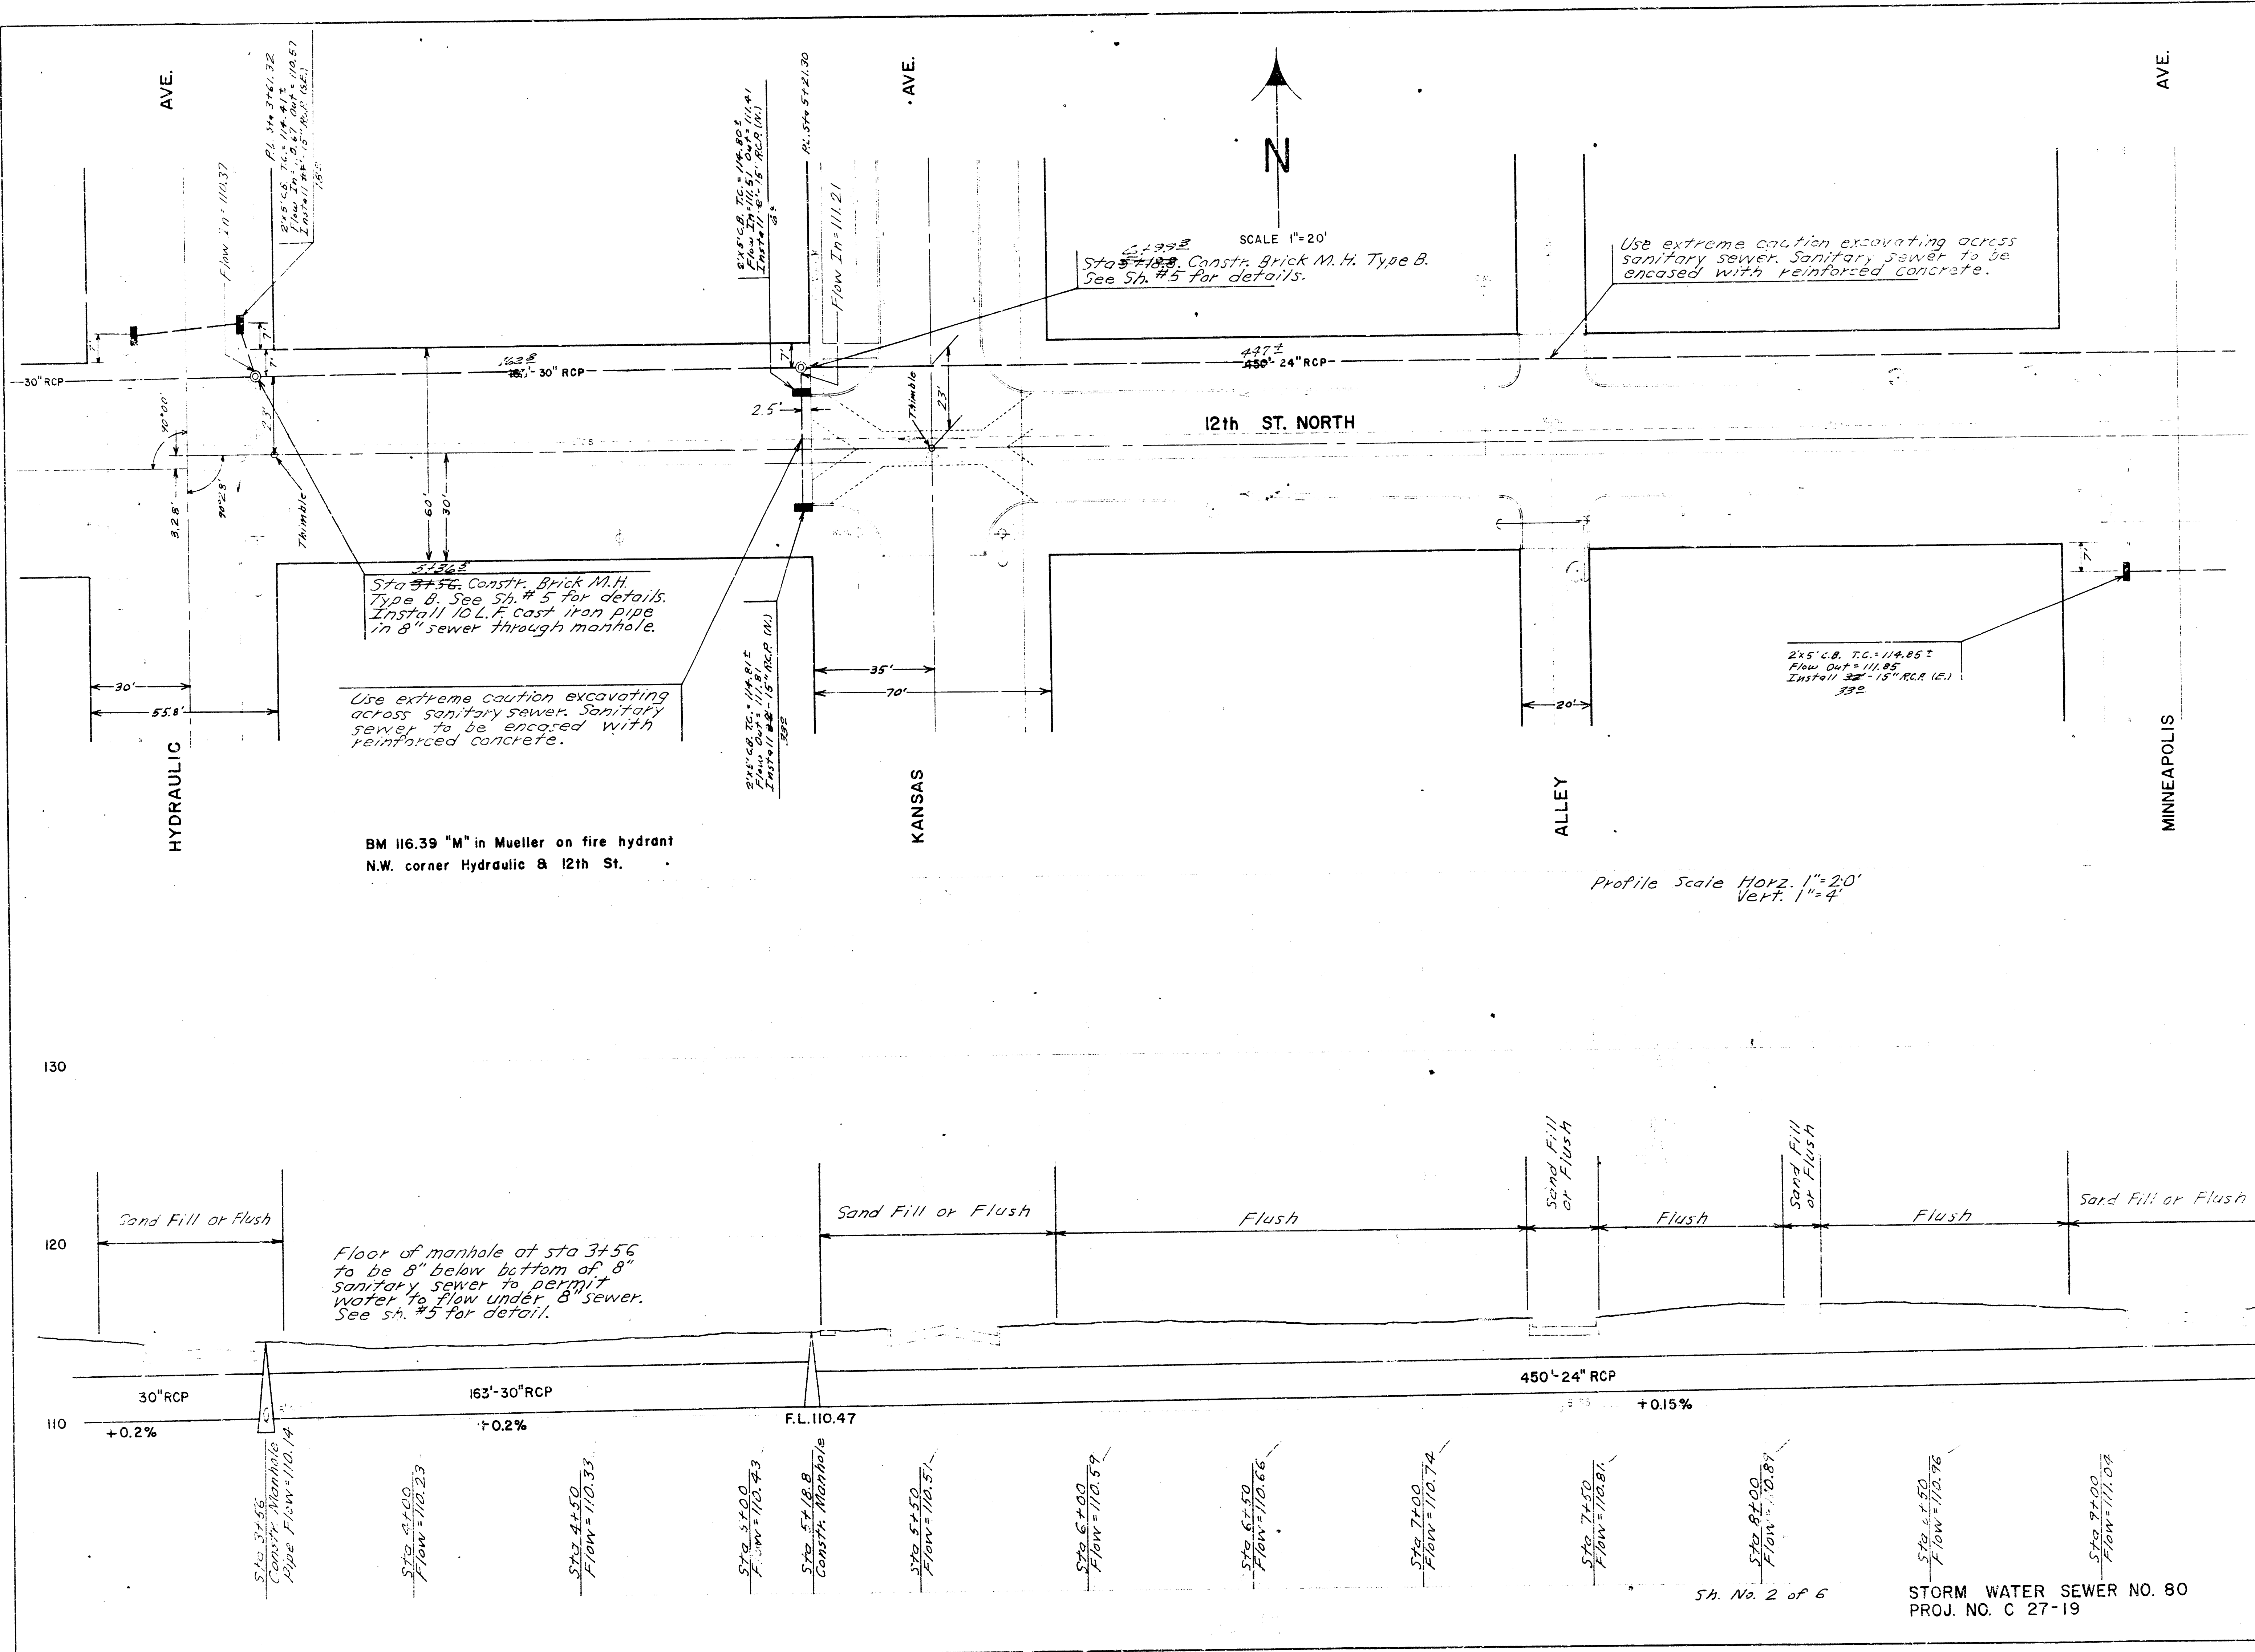

Sh. No. 2 of 6

STORM WATER SEWER NO. 80
PROJ. NO. C 27-19

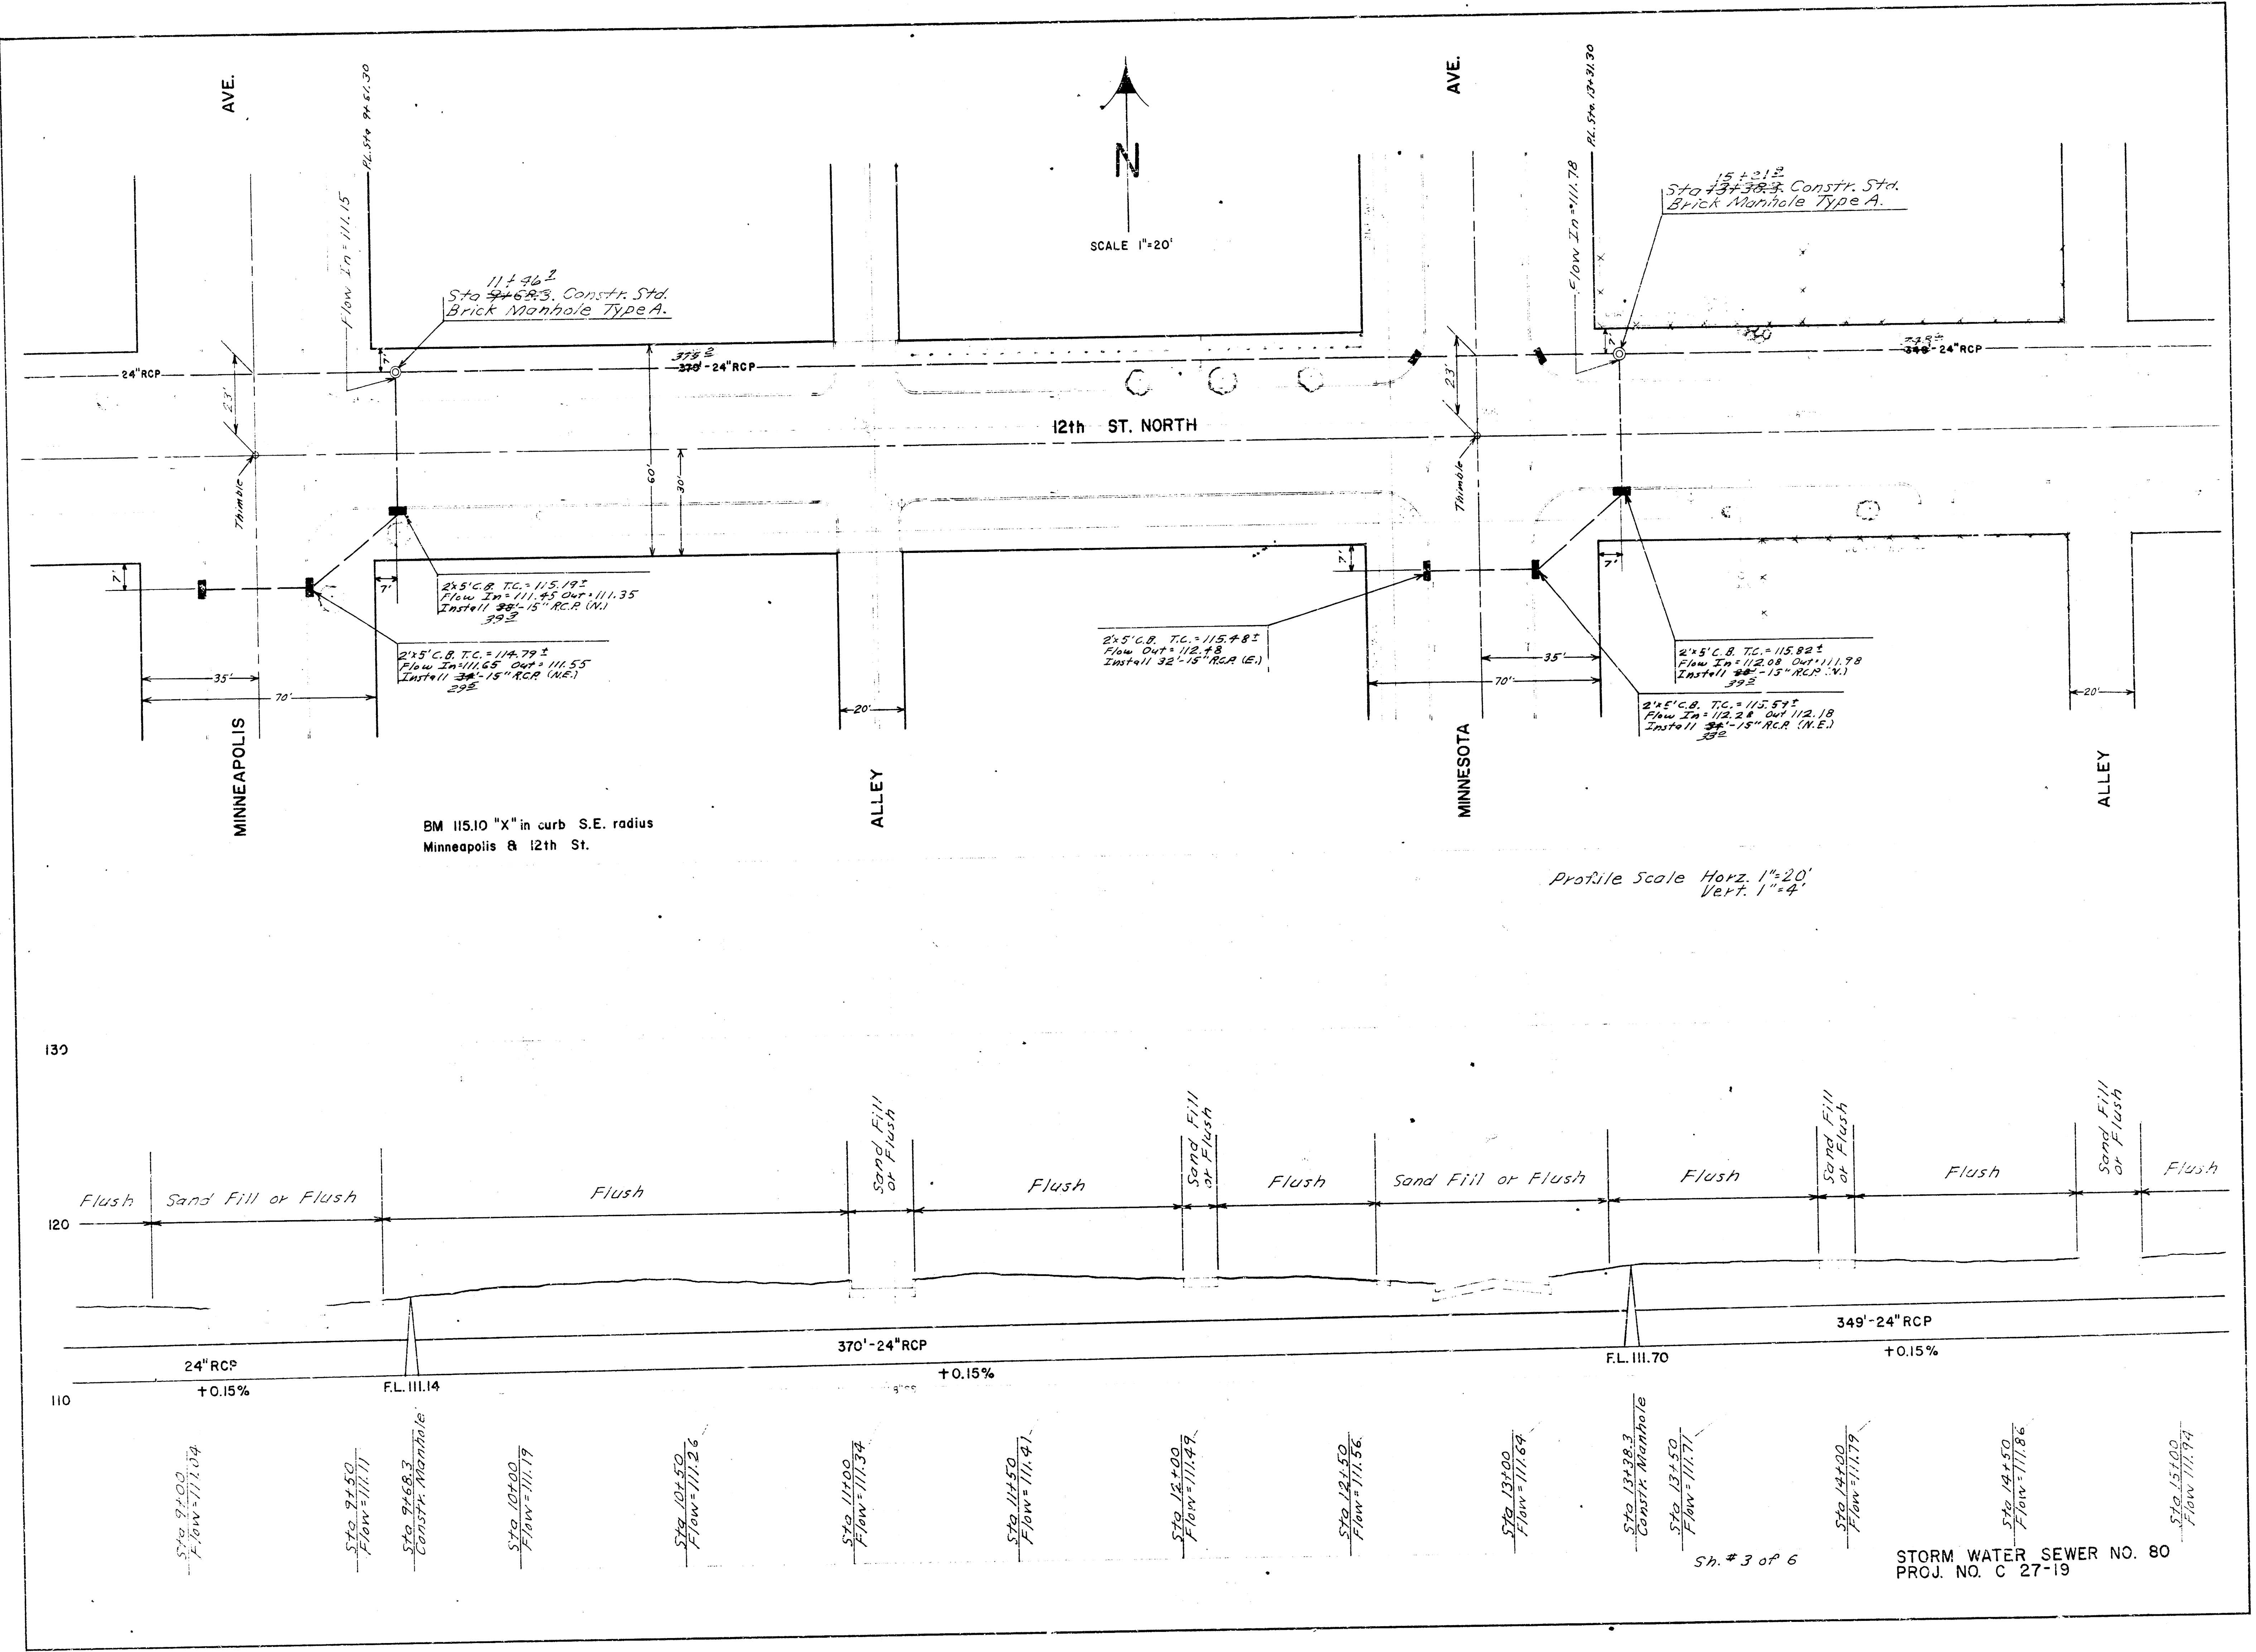

STORM WATER SEWER NO. 80
PROJ. NO. C 27-19

