






STORM WATER SEWER NO. 130

CITY OF WICHITA, KANSAS



R. W. LINN, CITY ENGINEER

PROJECT NO. DBKA 577095

DATE: Jan. 27, 1978

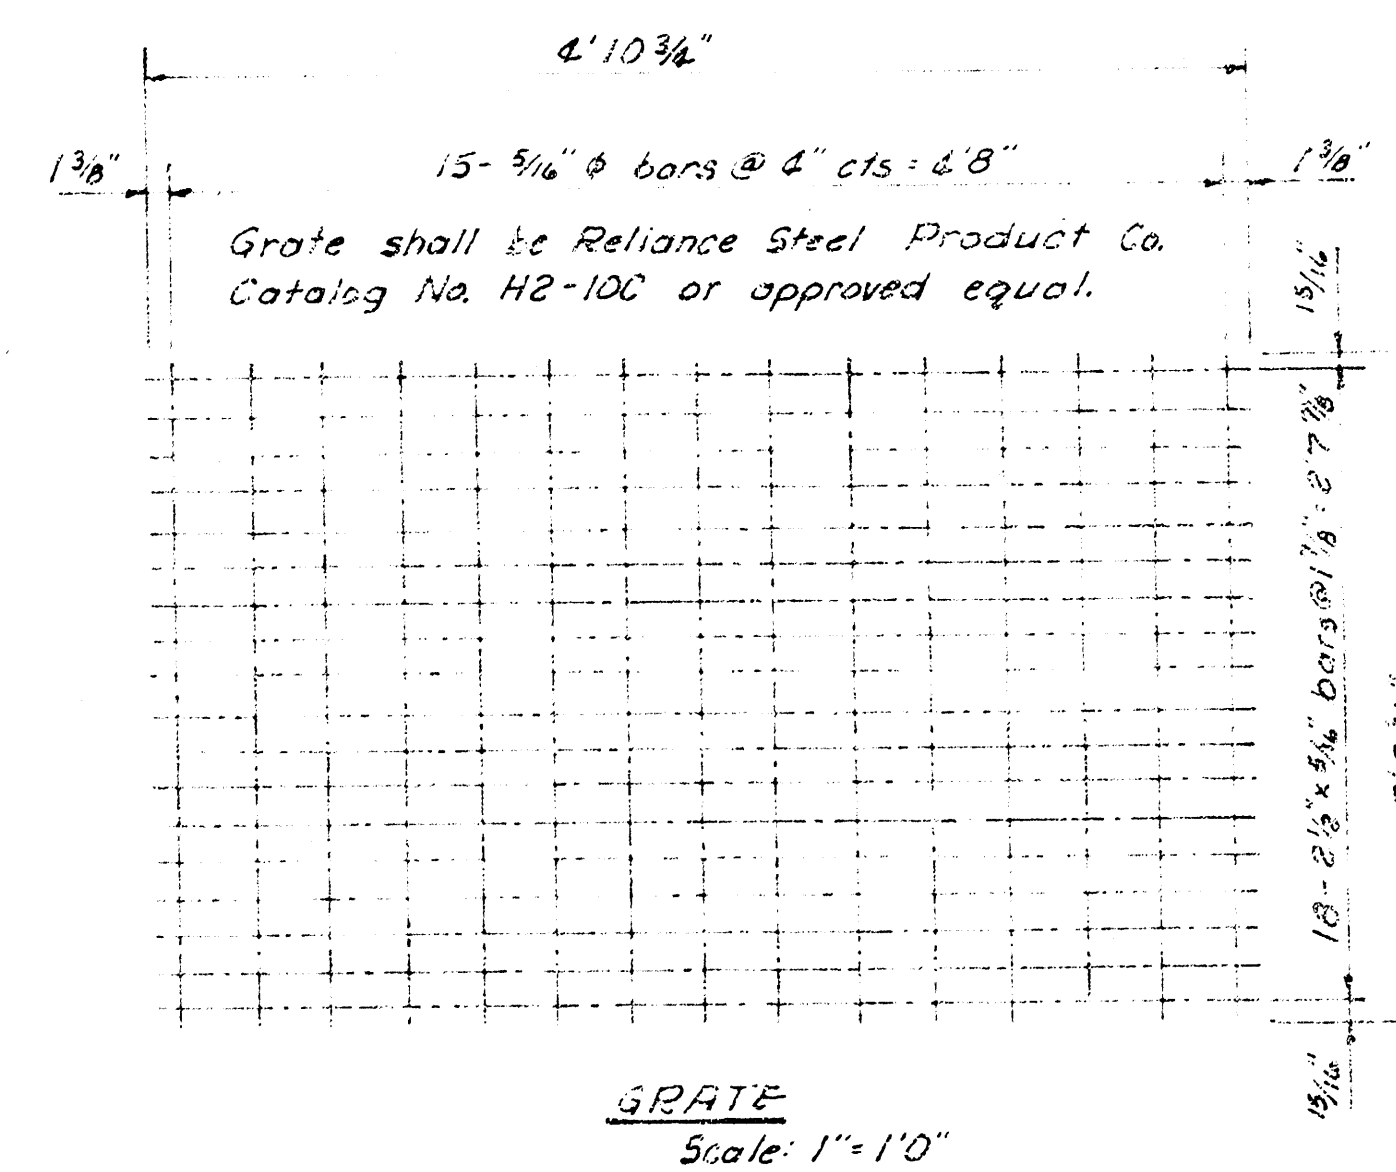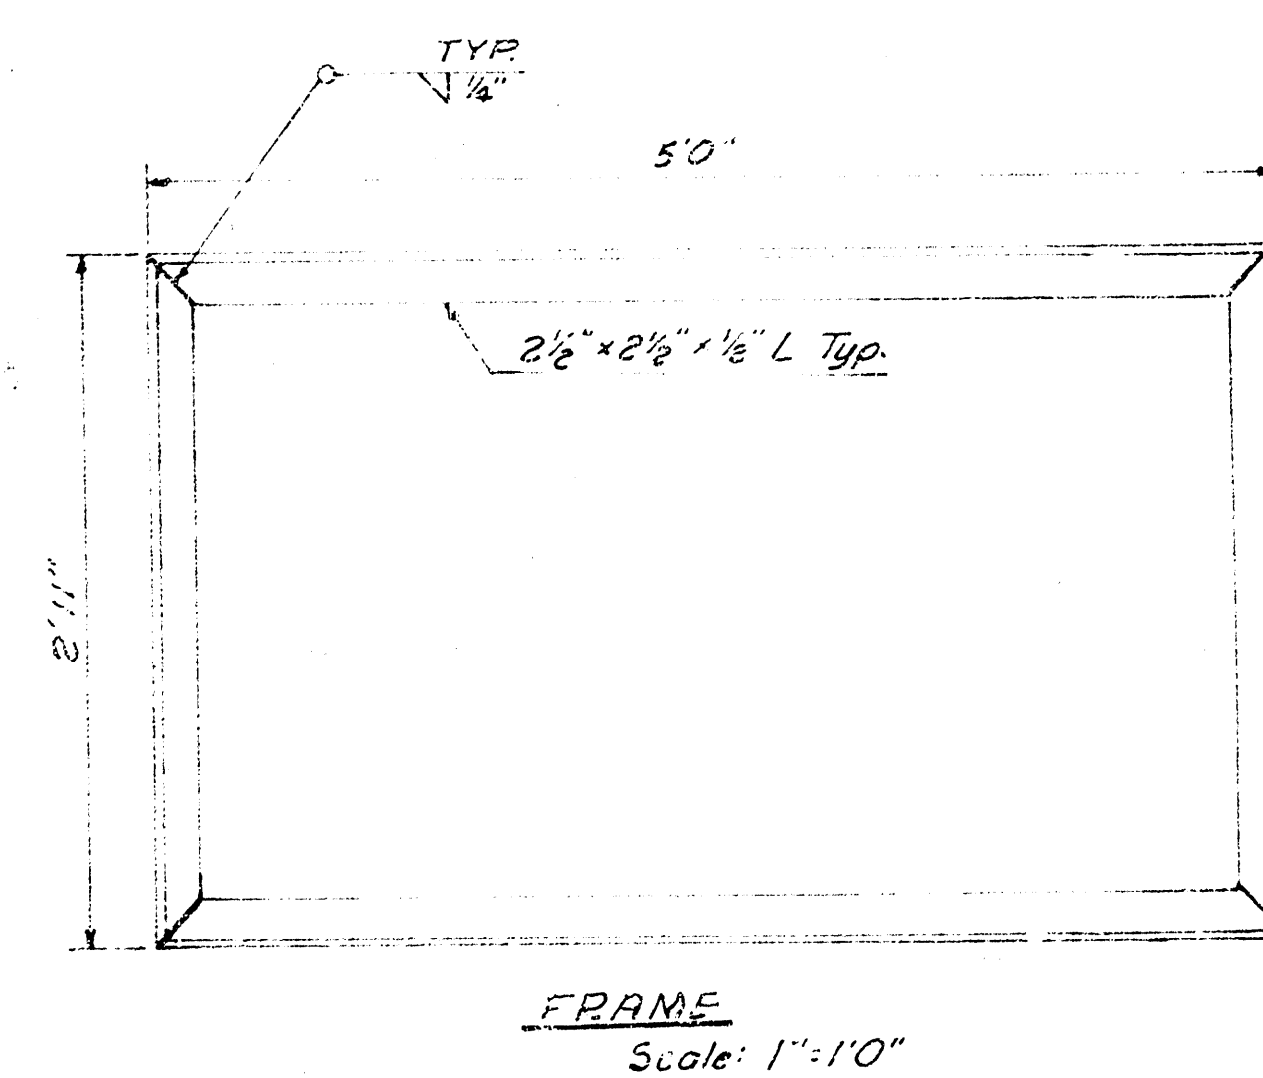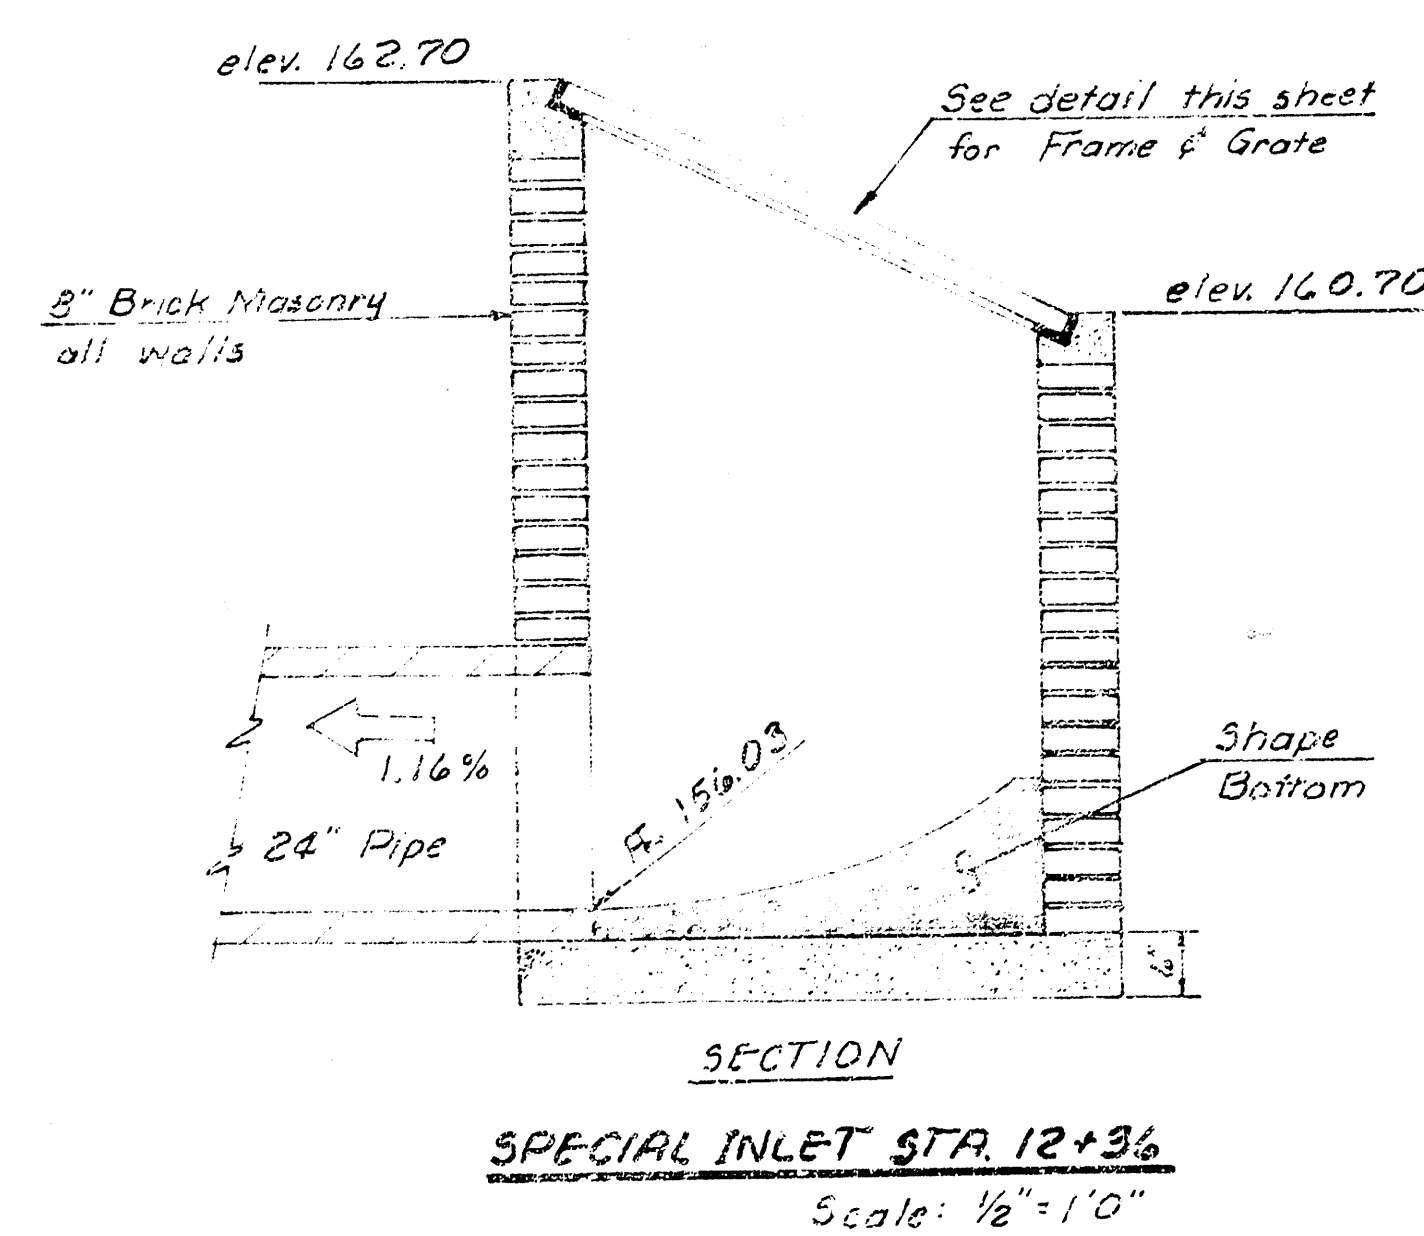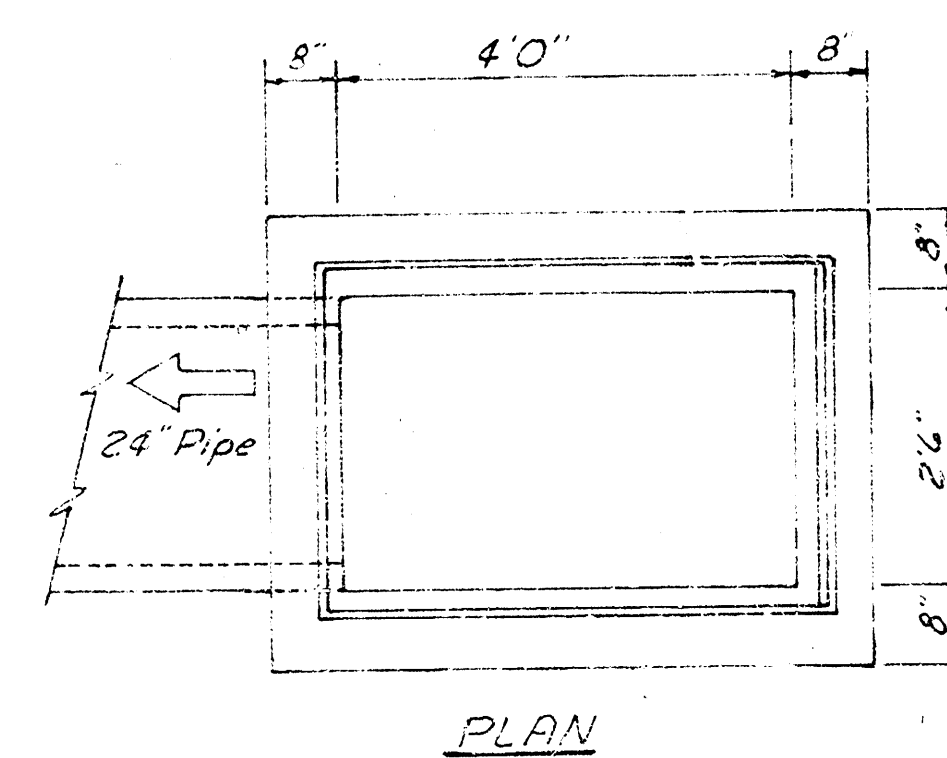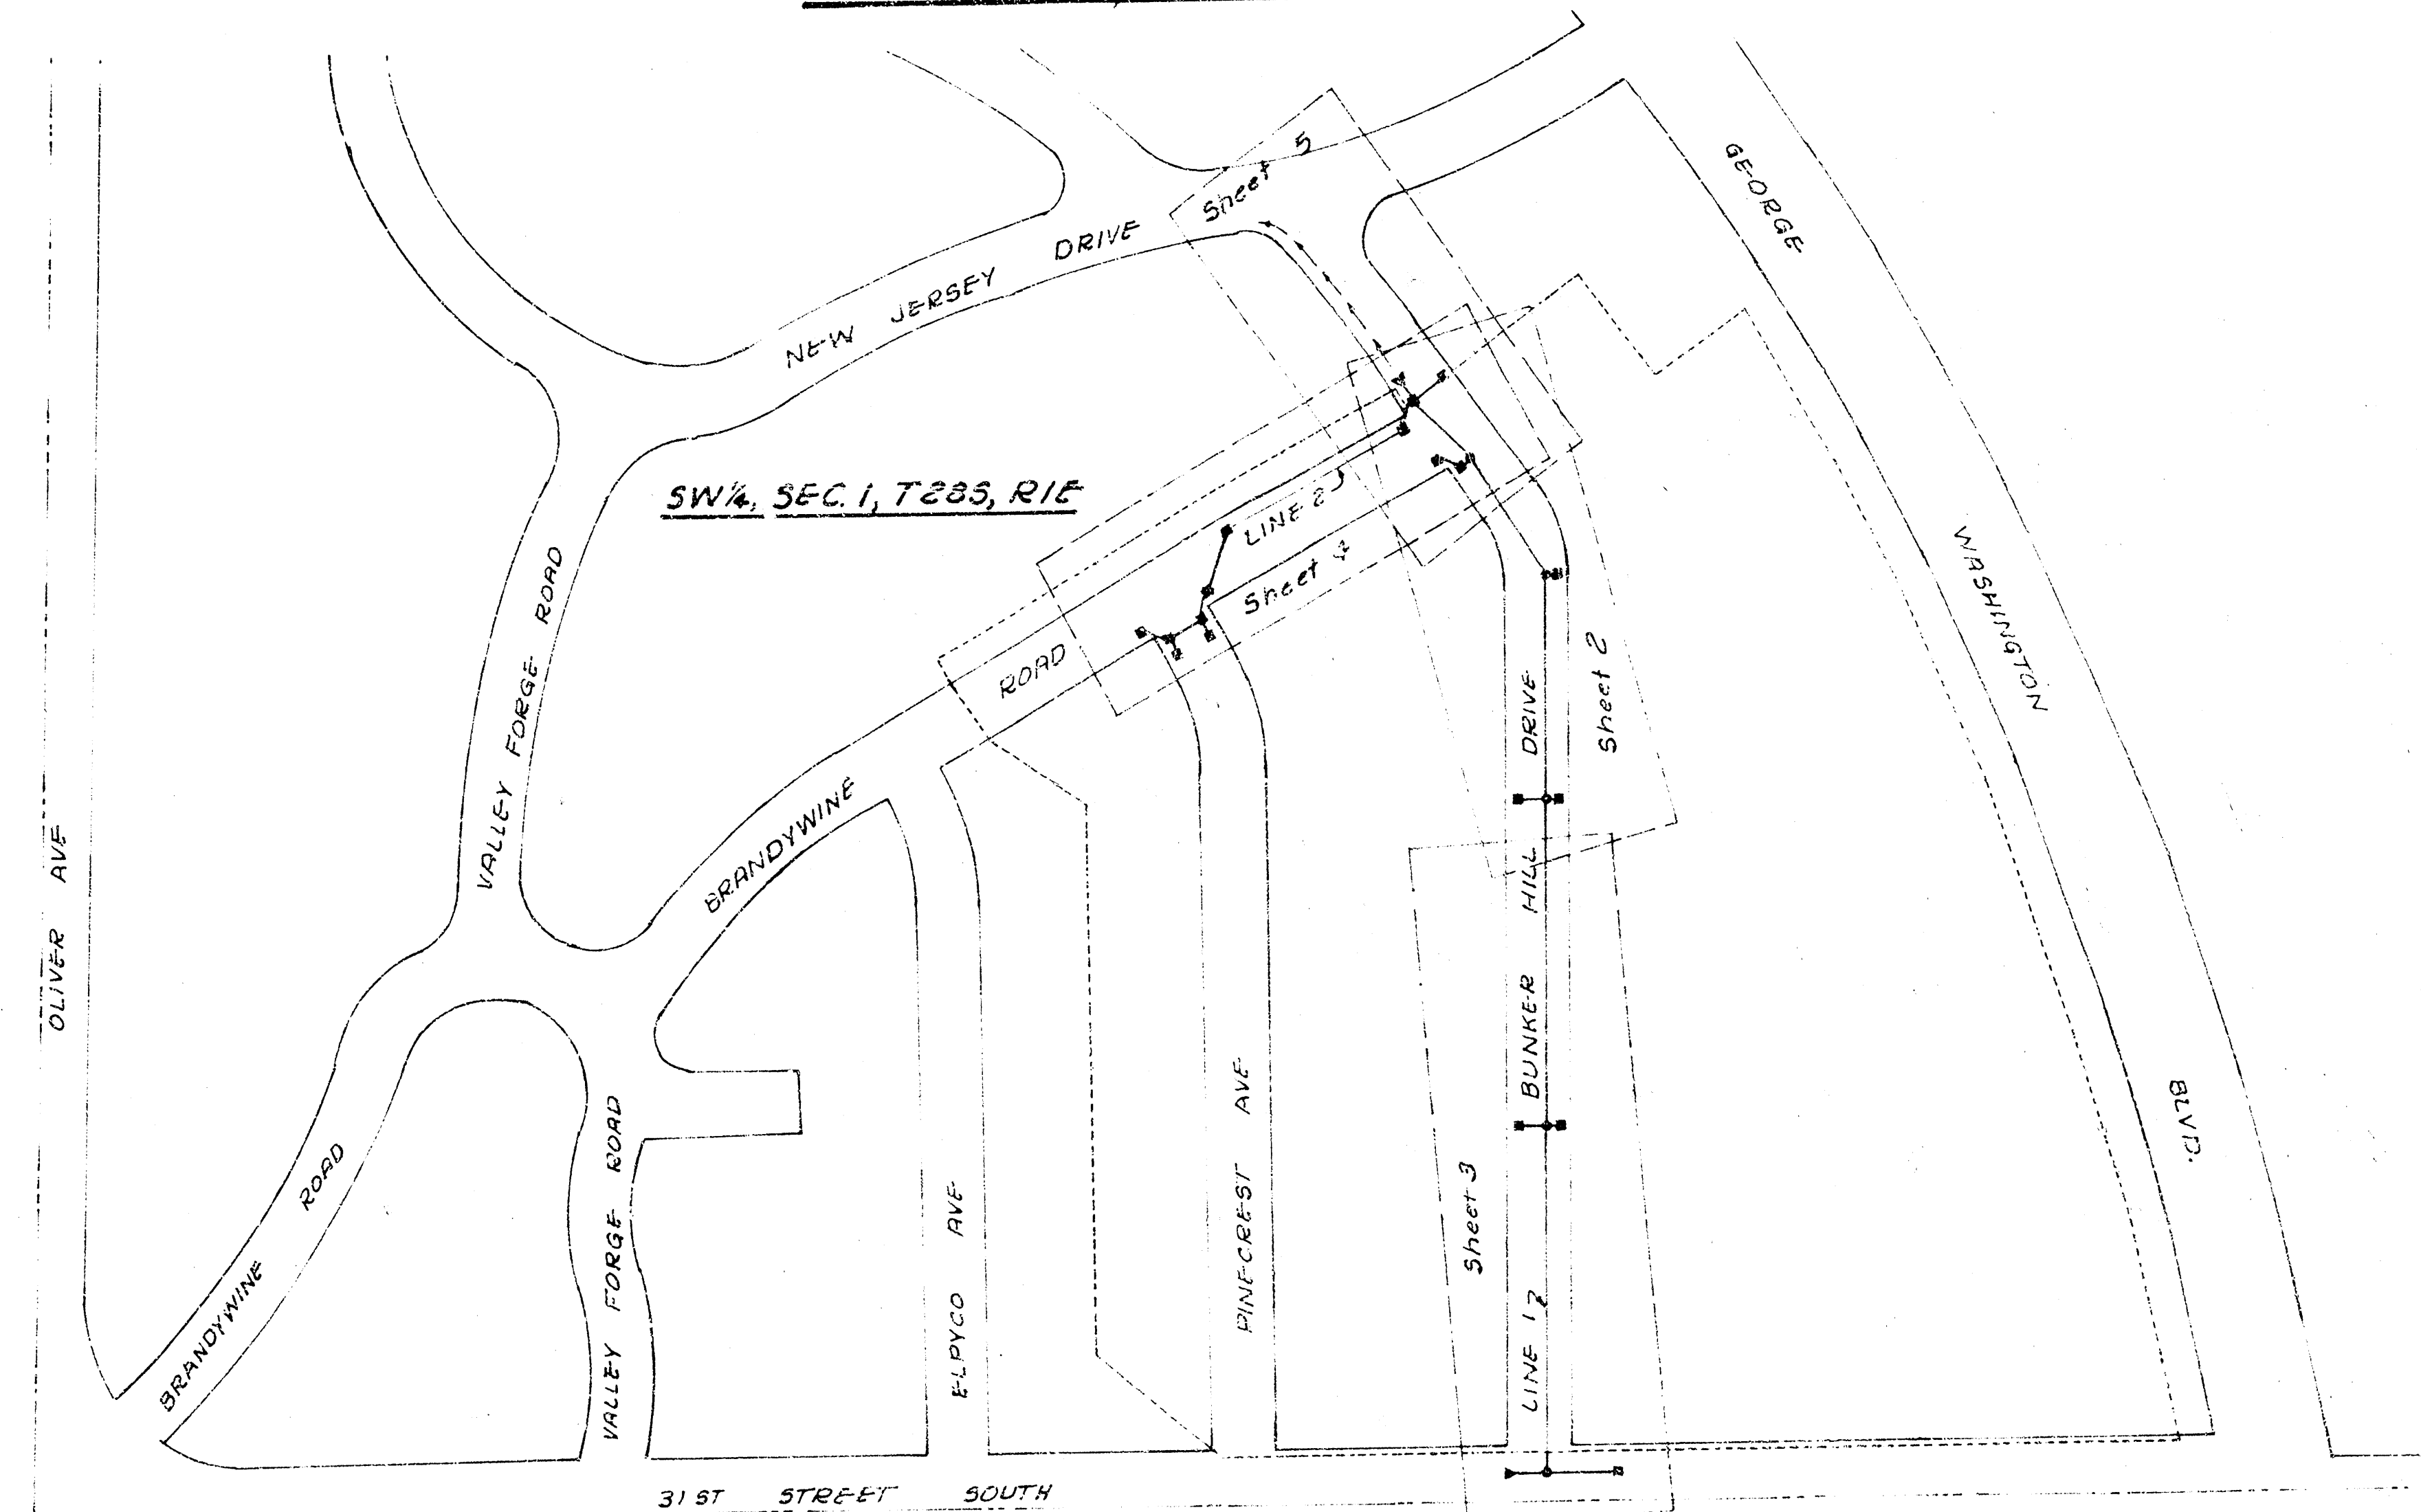


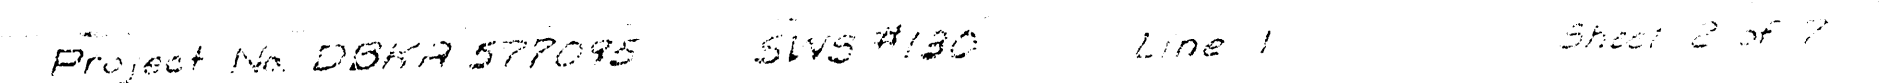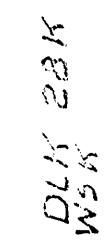

SCALE: 1"=20'

Cut Area Consist. Ditch from existing 2'x2' DCCB to 14.43
to Spec. Inlet Top 140.70. Ditch bottom 2' with 3/4" sides.
Cost to be included in other bid items. (Cut = 45 x CY)

Constr Spec. Inlet Sta 12+36
See detail, Sheet 1

Install 2" Pipe

Future 29 E/B Street

1212 RCB

Tele. Cable

Consist. Manhole Box 11+26
Street Paving Box 0+76

Install 38' of 15" Pipe with
end section D5FL 143.2;
D5FL 156.0

11 H. of 15" Pipe @ 1.82%
154.7; DSFL 154.5

Constr. Type 1A Curb Inlet Top 158.40
w = 3'10" Floor Elev 154.51



Constr. Type B Manhole Sta. 8+42
Street Paving Sta. 4+00

Remove Tree


BUNKER HILL DRIVE

Constr. Type 1B Curb Inlet, Top 158.65
W = 30" Floor Elev. 154.71
Install 24" of 15" Pipe @ 1.67%
USFL 154.9, DSFL 154.5

Project No. DBKA 577095 SWSP/130 LINE 1 Sheet 3 of 7

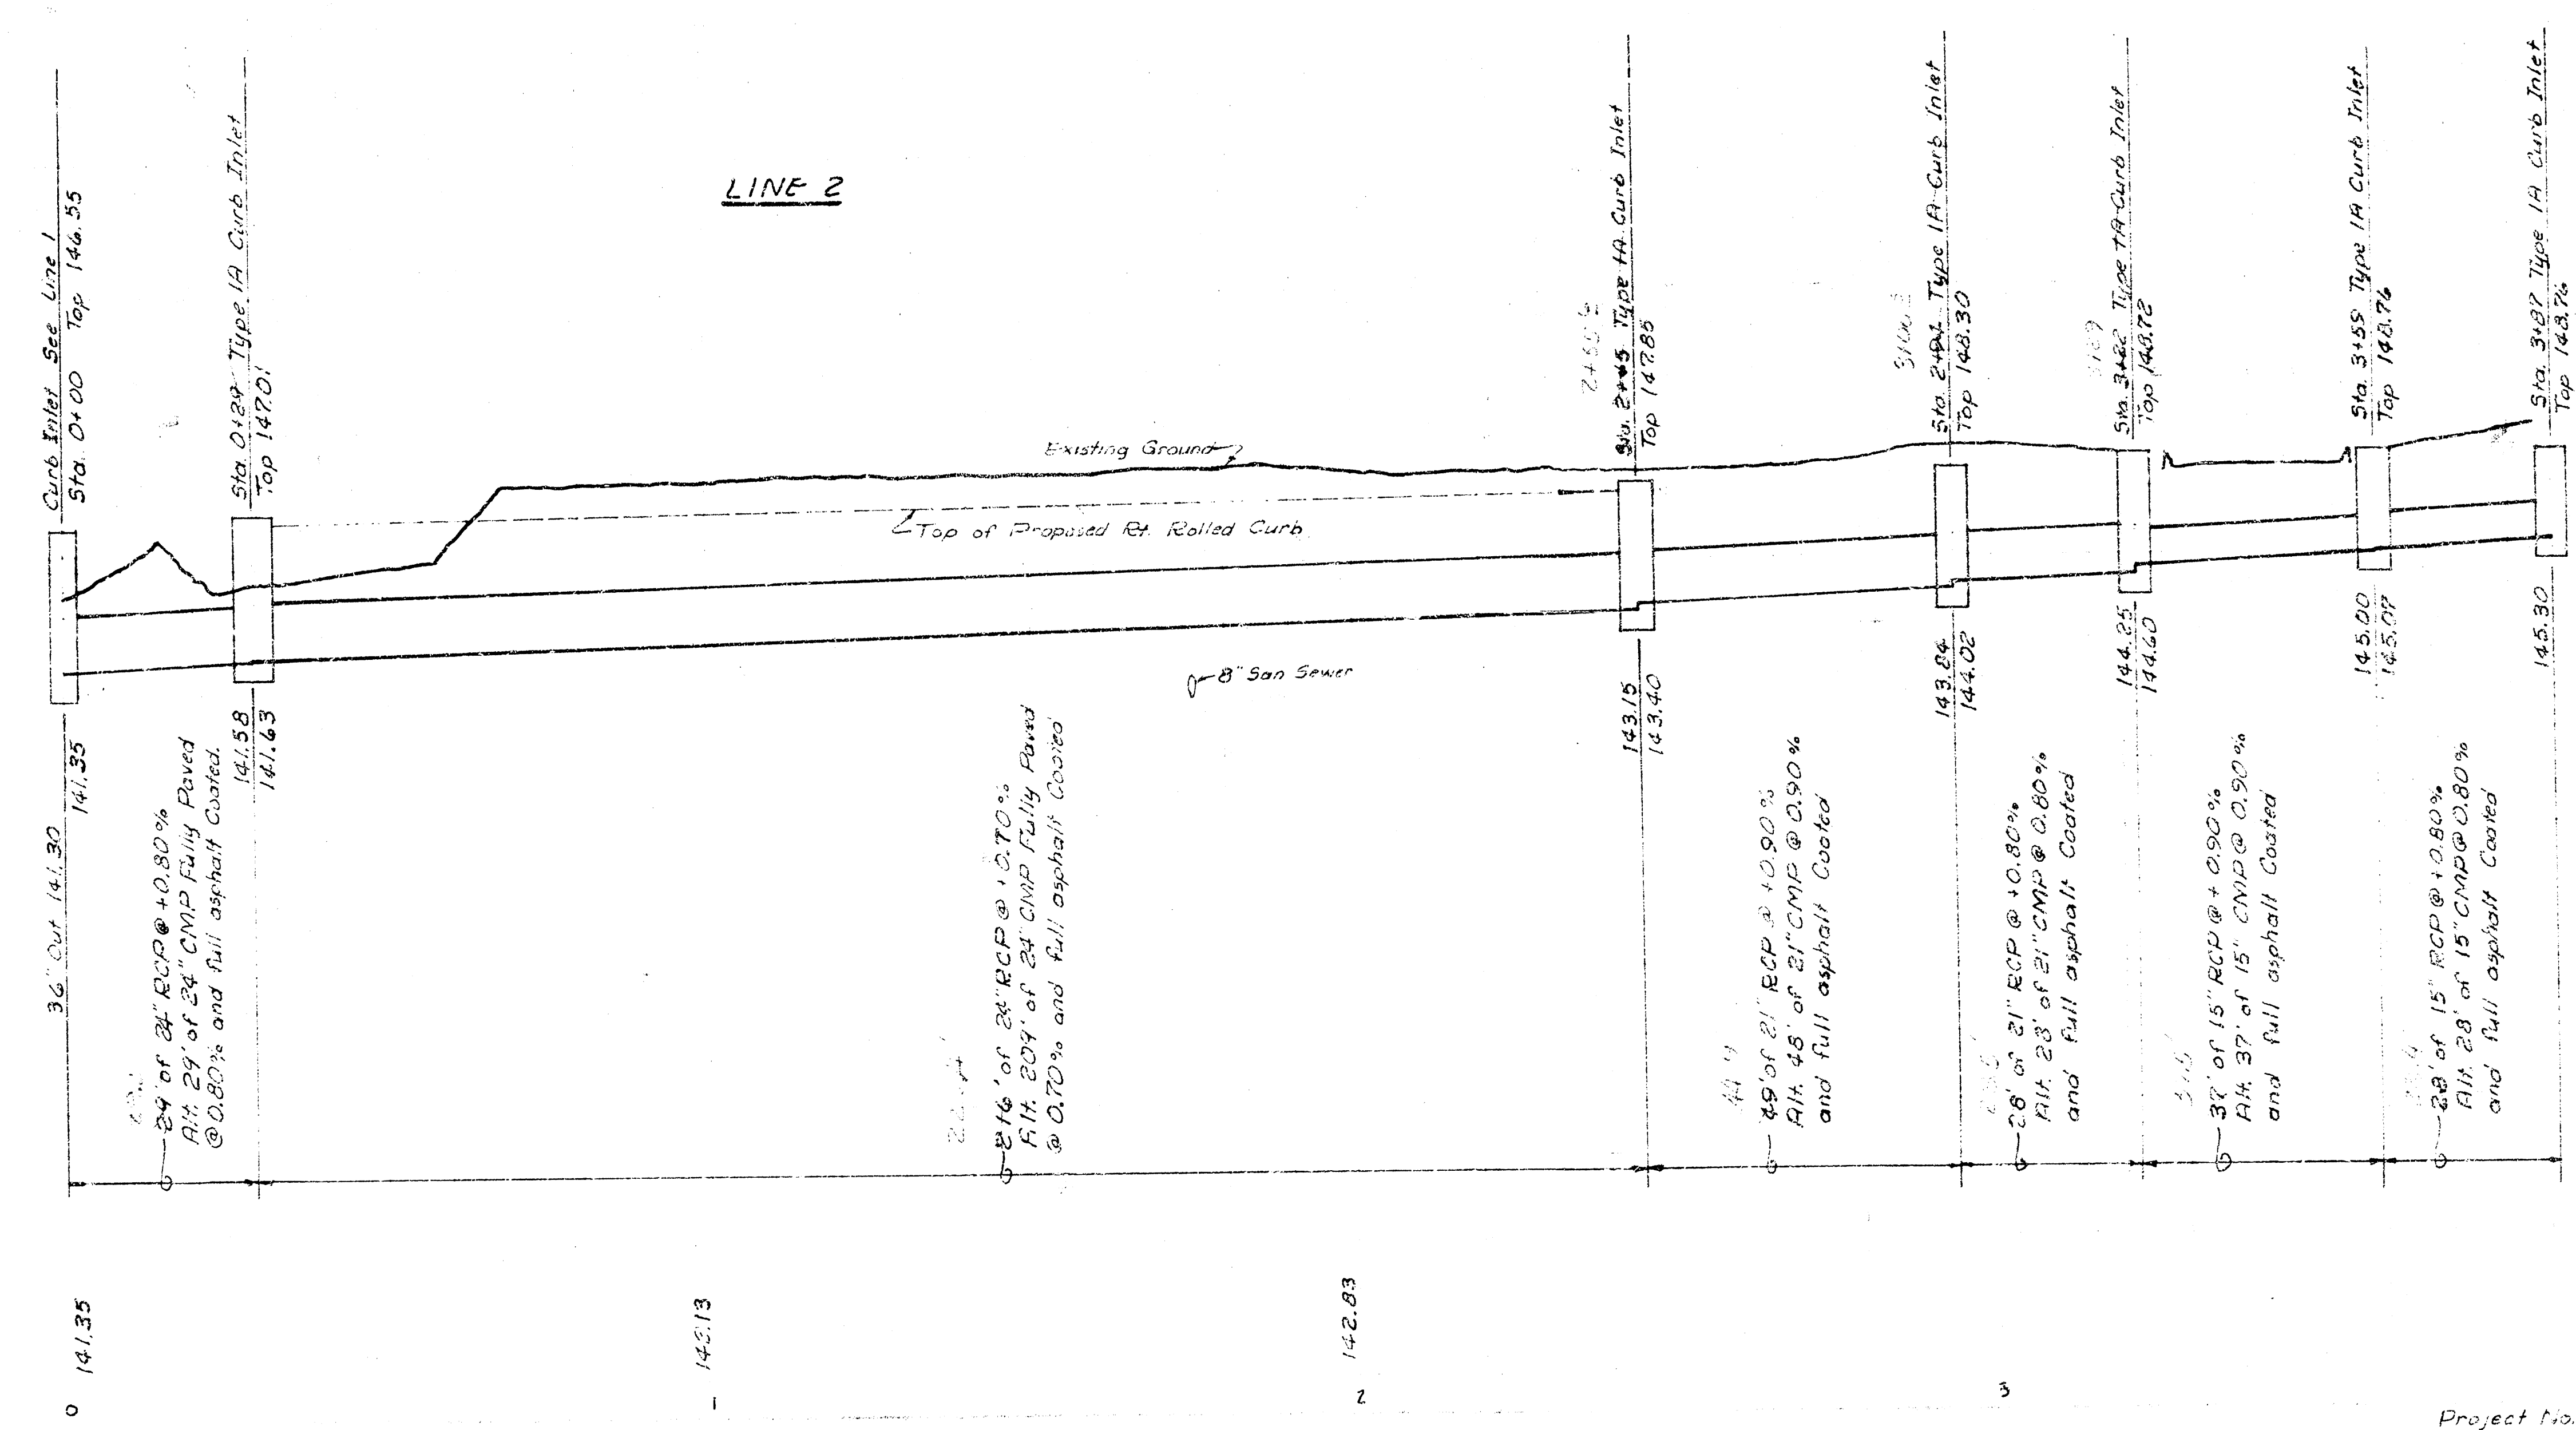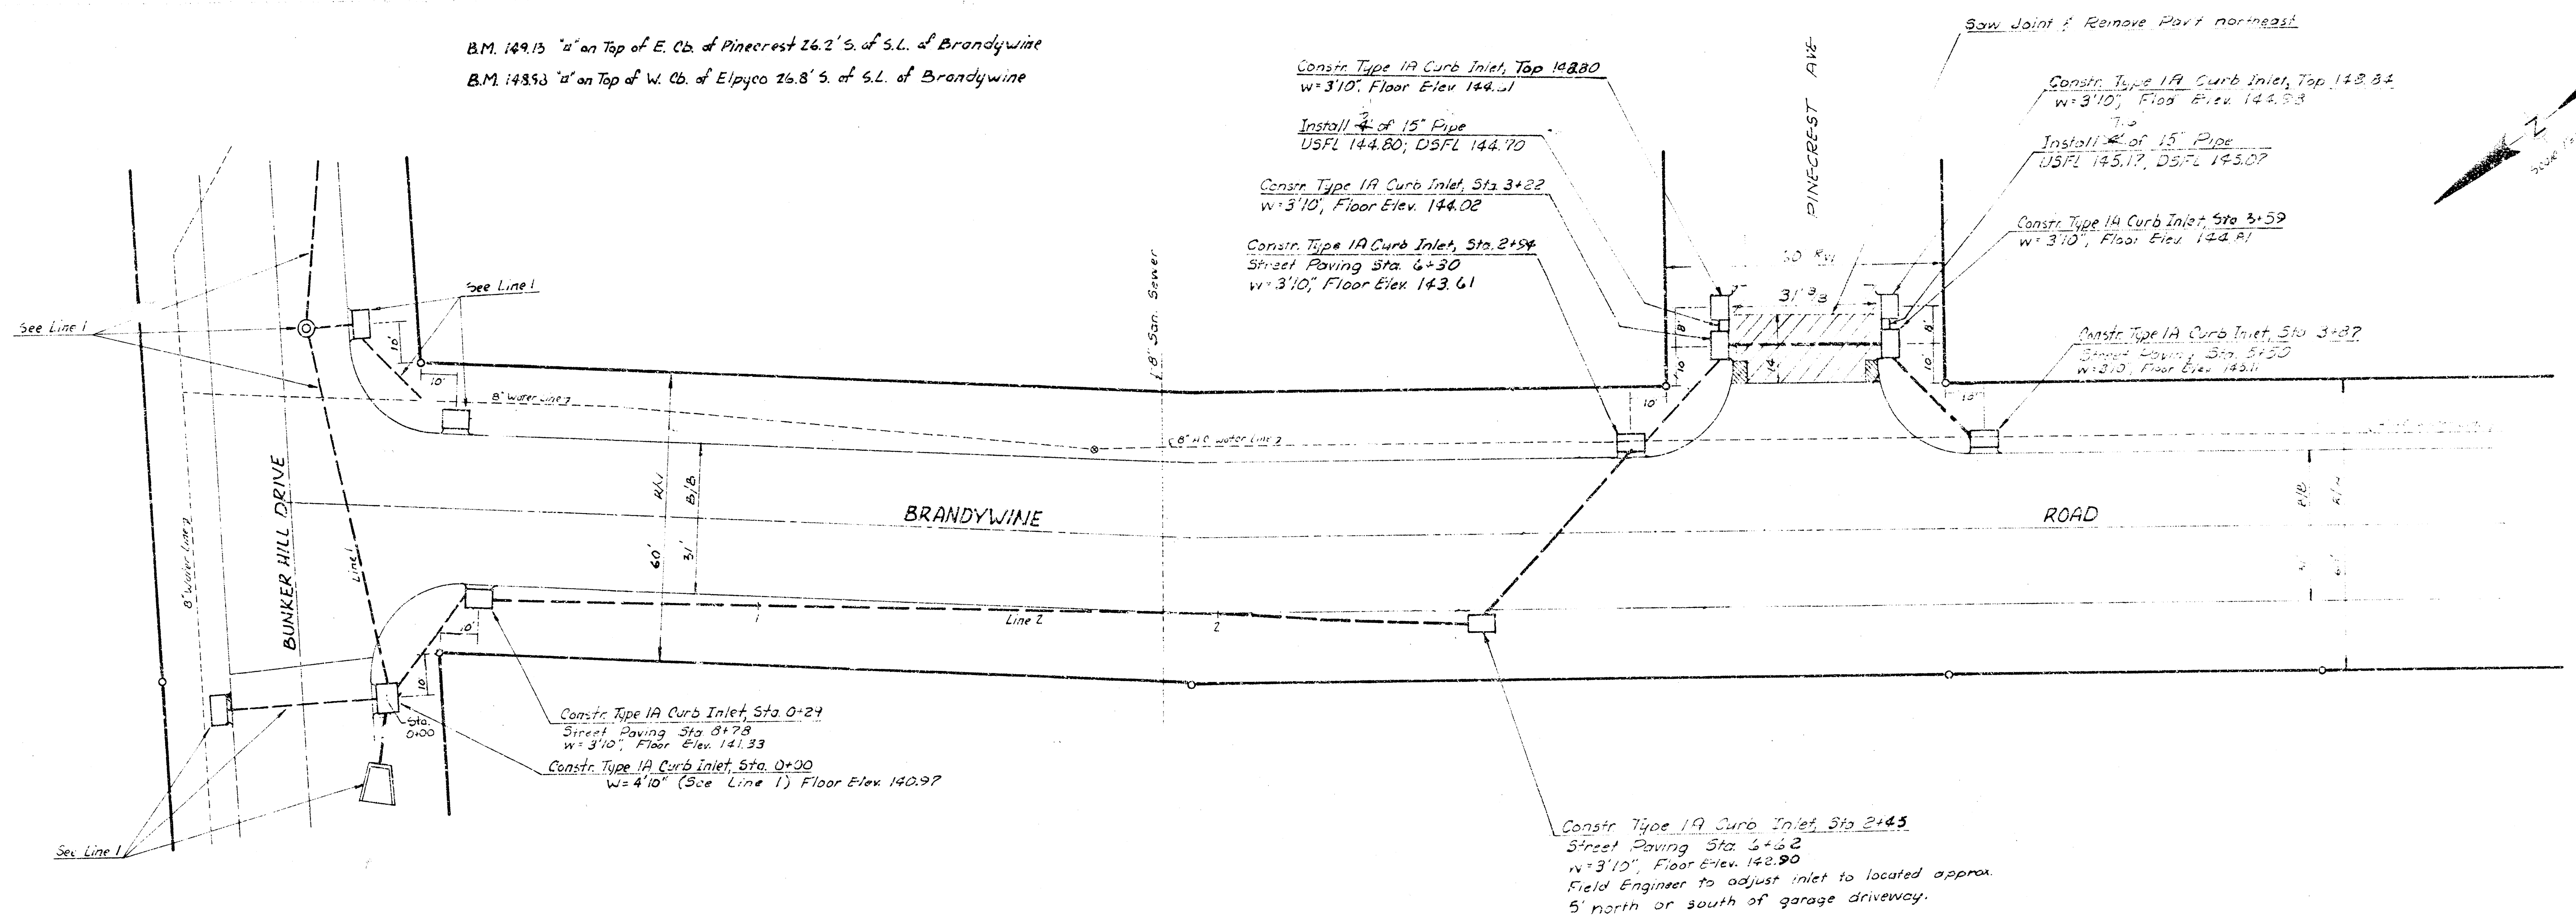

06-030







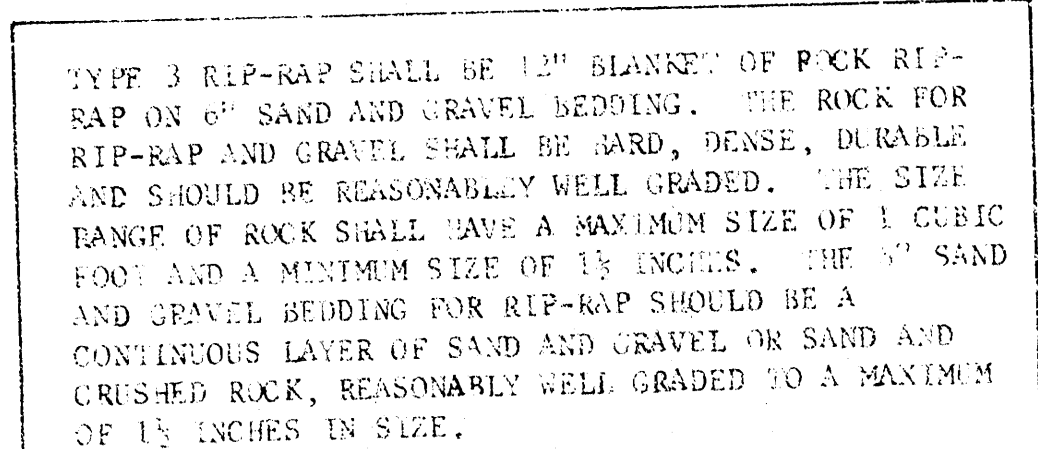


PLAN

SECTION

Scale: 1/2" = 1'0"

[illegible]

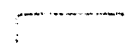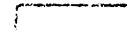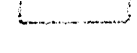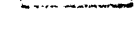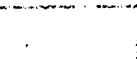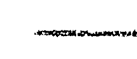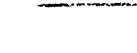
