
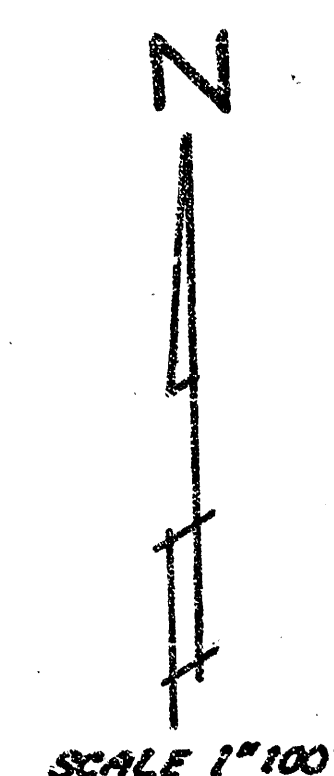


STORM WATER SEWER No. 178

CITY OF WICHITA, KANSAS

D.S. SELLERS ACTING CITY ENGINEER

PROJ No. 468-76-245-80893000-000-001

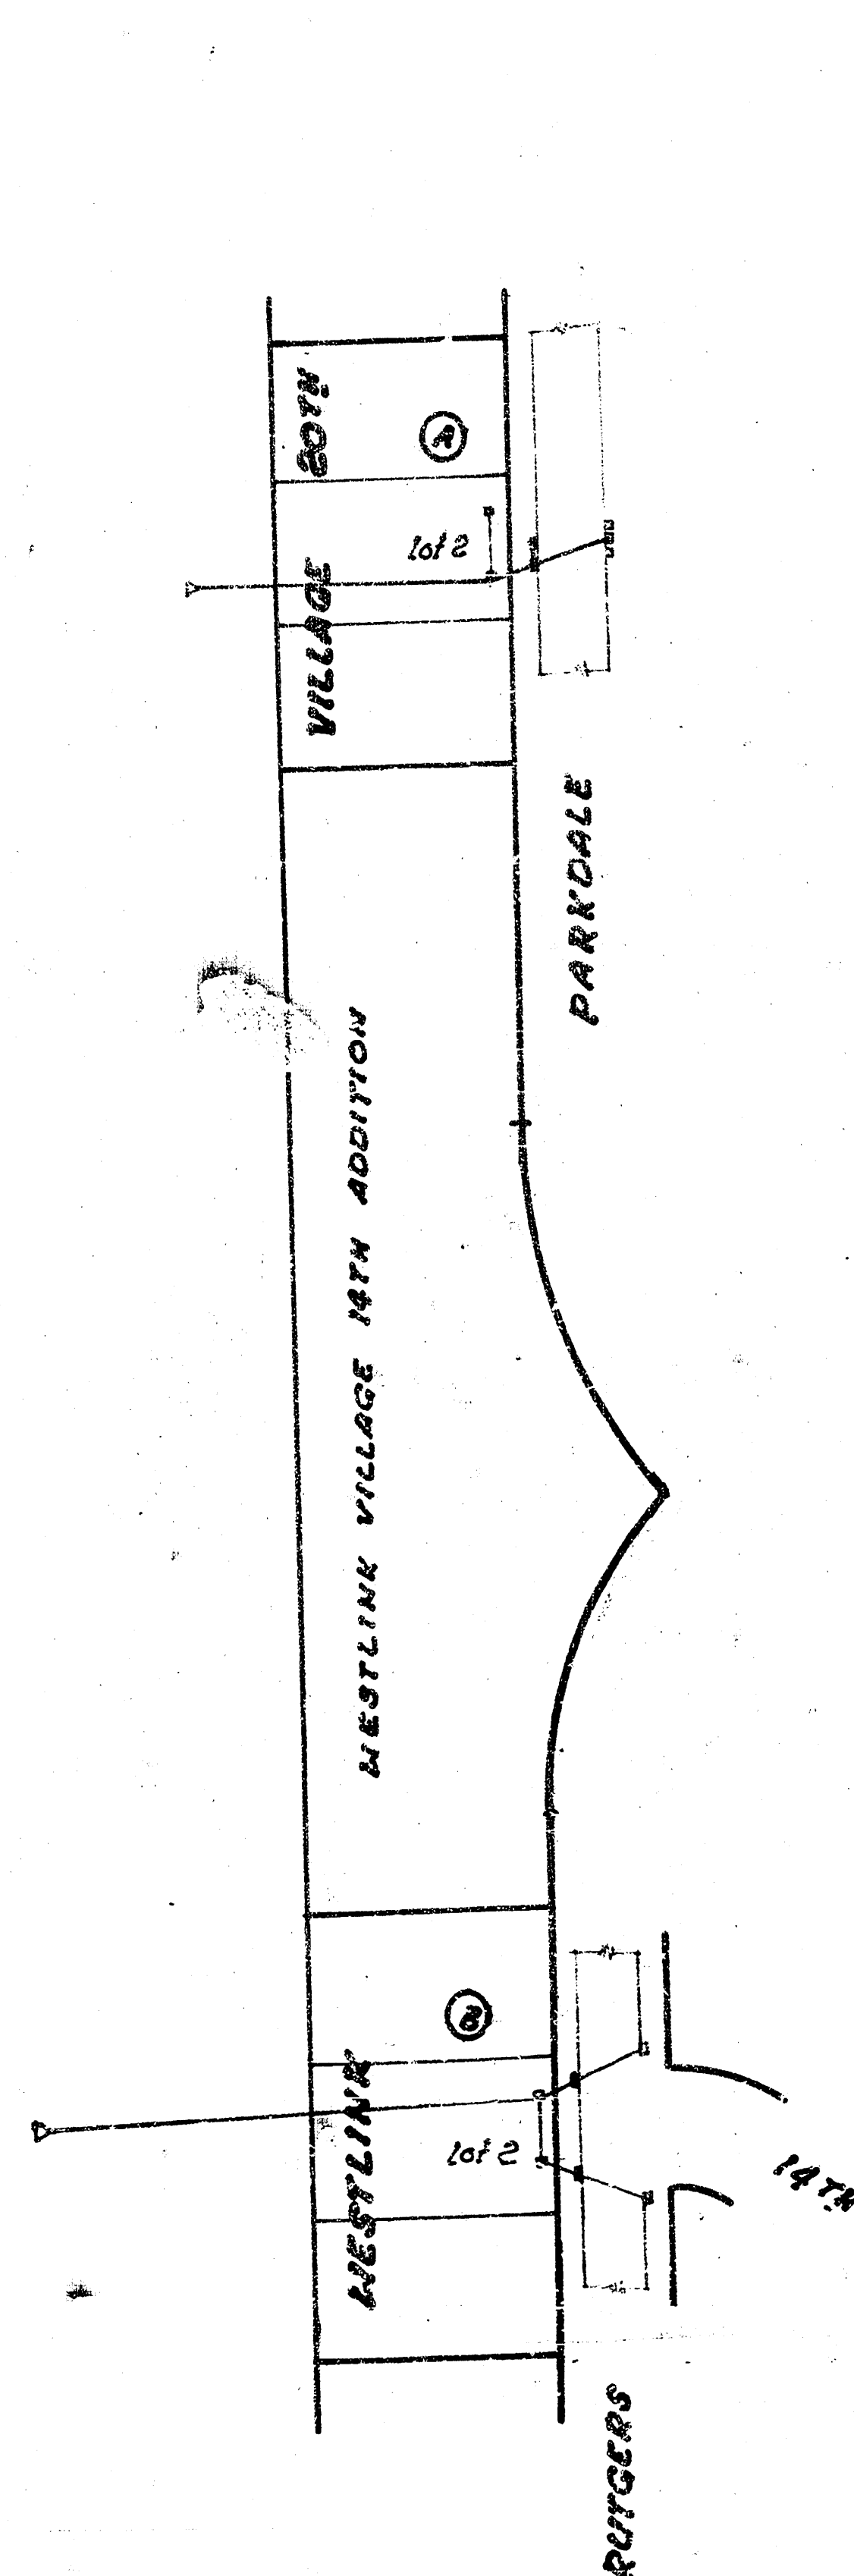

BM 15930 RR 50' ± W. to PP approx. 115' W &
20' S of NW cor. 13th & Prescott
(8th Pl. W of Maize Rd.)

CONSTRUCT STANDARD
MANHOLES - TYPE A

CONST TYPE 1-A CURB
INLET OVER EXISTING
24" PIPE. Top curb 157.31
Existing 84" 149.91 21'-4" ±

Sta. 3+31 Existing
Type 1-A Inlet w/5'0"

81' - 24" RCP

52' - 24" RCP

ABANDONED 24" PIPE - PLUG BOTH ENDS -

PLUG INLET OPENING
see detail SH 3

DRAINAGE & UTILITY EASEMENT

Existing 15" Pipe

PLUG INLET OPENING
see detail SH 3

LOT 2, BLK B
WESTLINK VILLAGE 20TH ADDN

Existing TYPE 1-A
Inlet Top 157.20

Proposed SWRT Co. Cable

30' util
easement


CONST TYPE 1-A CURB INLET
OVER EXISTING 15" PIPE 11'-4" ±
Top curb 157.32 Existing 15" 155.20

NOTE: All inlets this sheet are Type 1A Curb
Inlets w/4'2" unless otherwise noted.

as revised sept 1979 --

PROJ. No. 463-76-245-80893000-000-001

PROFILE
NOTE BOOK

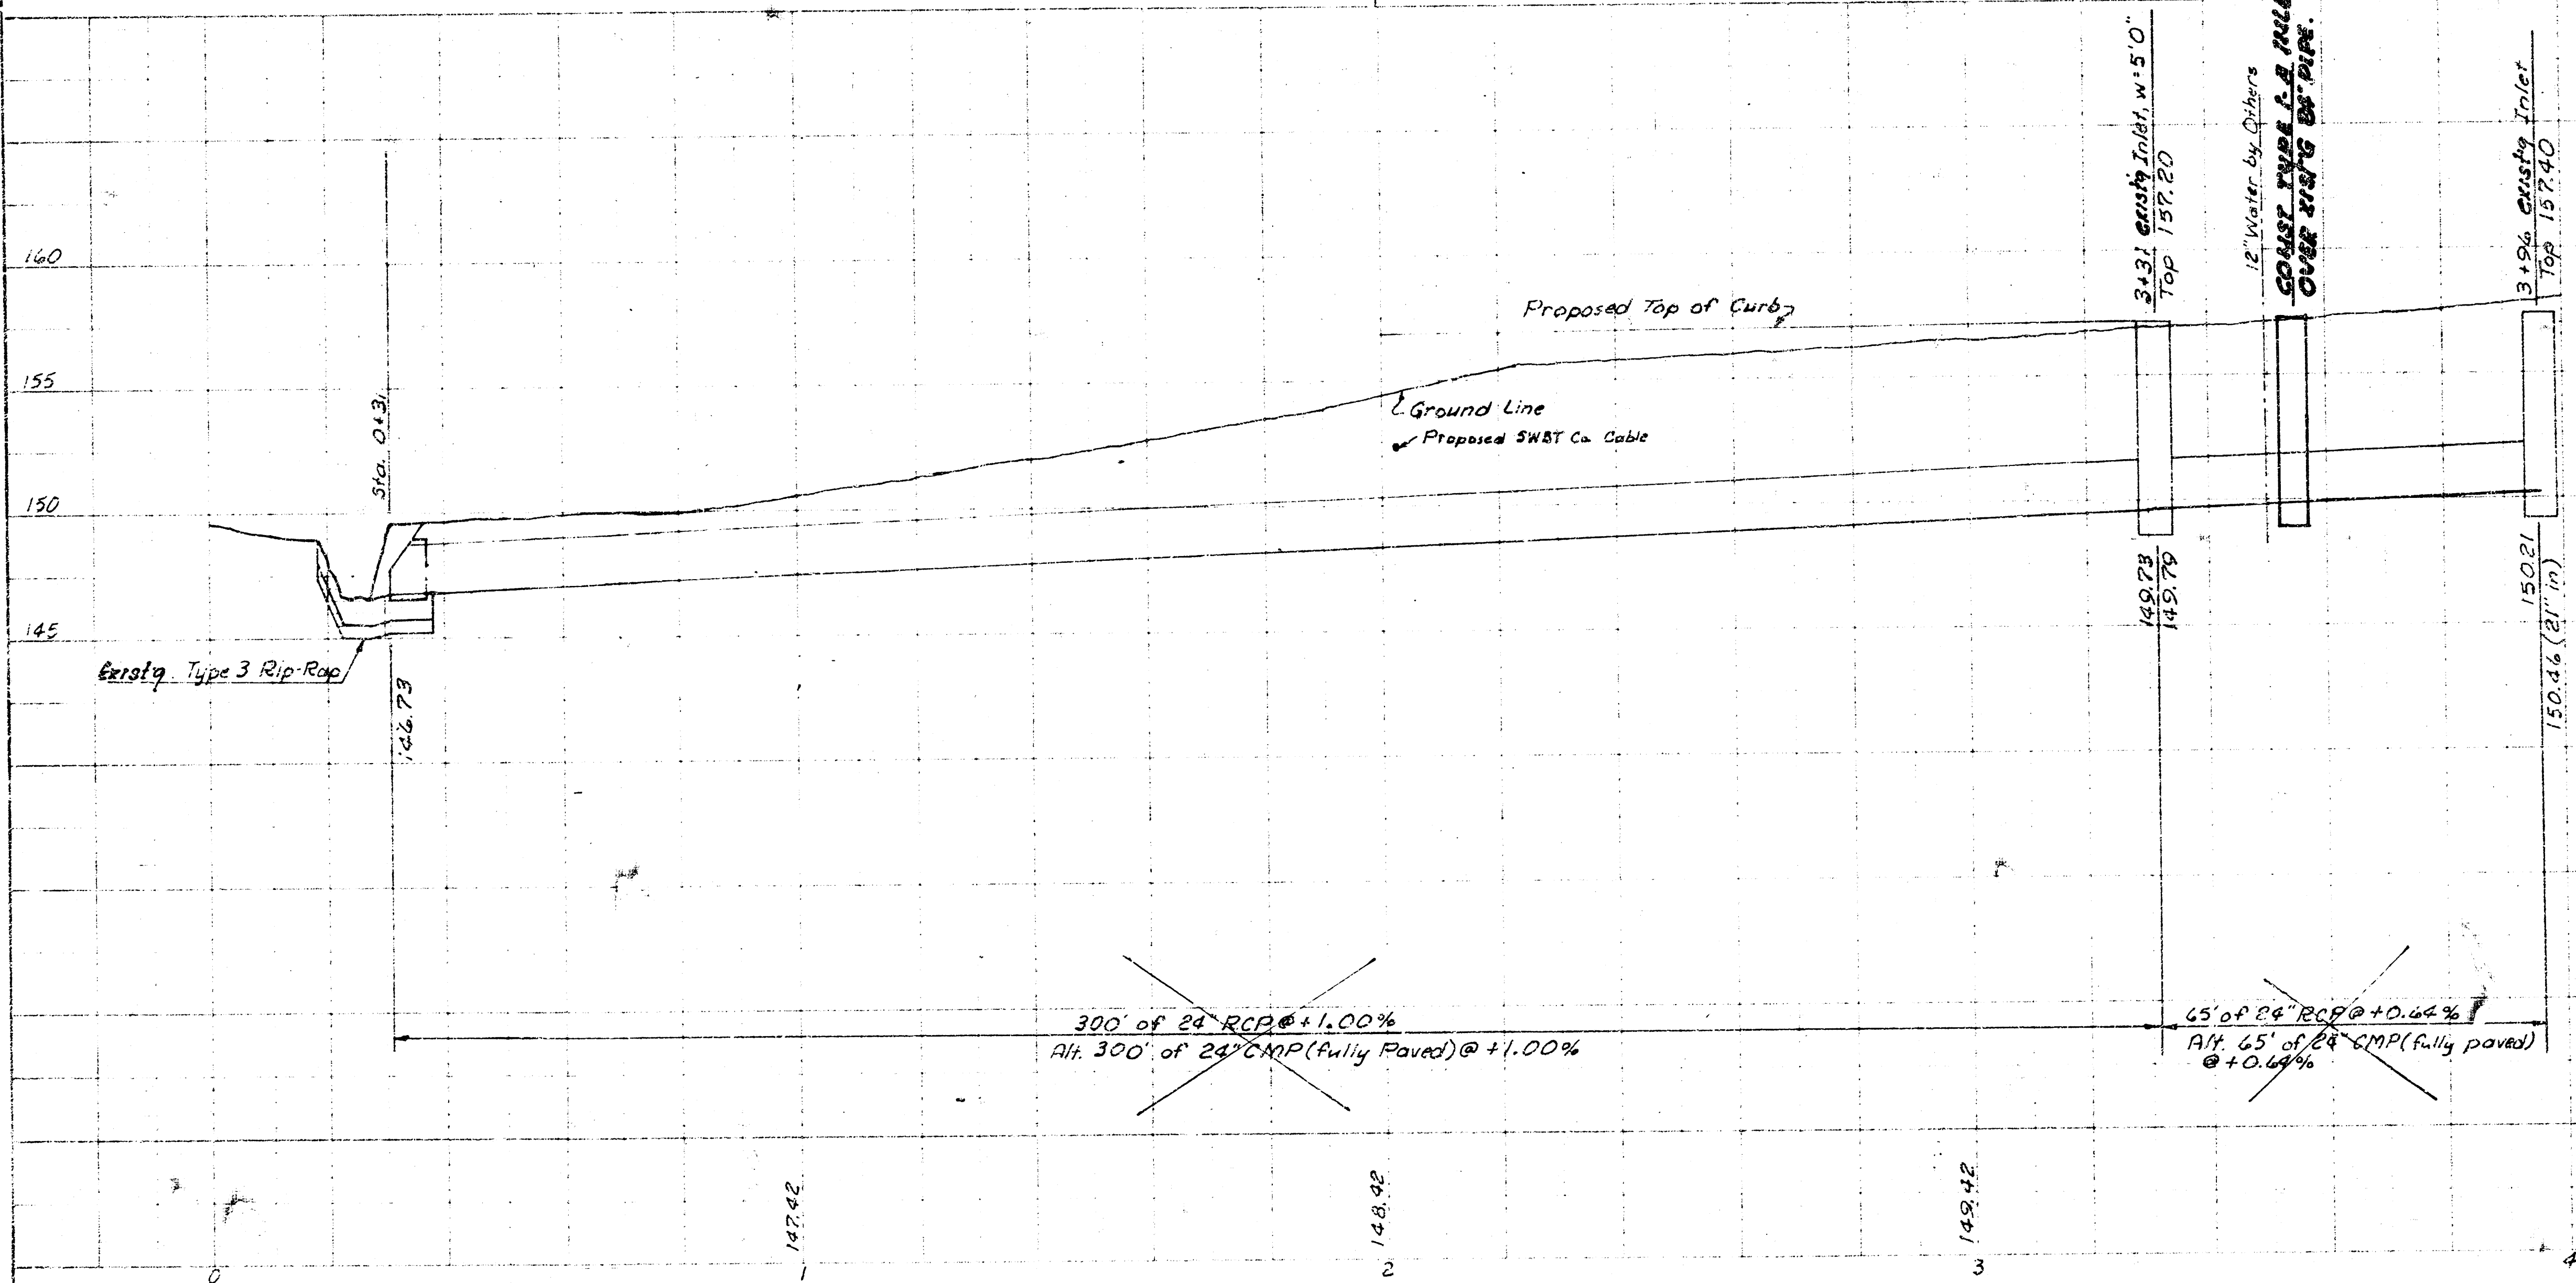

S.H.S. # 178



Sheet 2 of 3

PLATE 1. PLAN, PROFILE
REQUIRED & ISSUED TO
48 100-1 1/2" X 11" X 1/2"

FILMED FROM THE BEST
AVAILABLE COPY



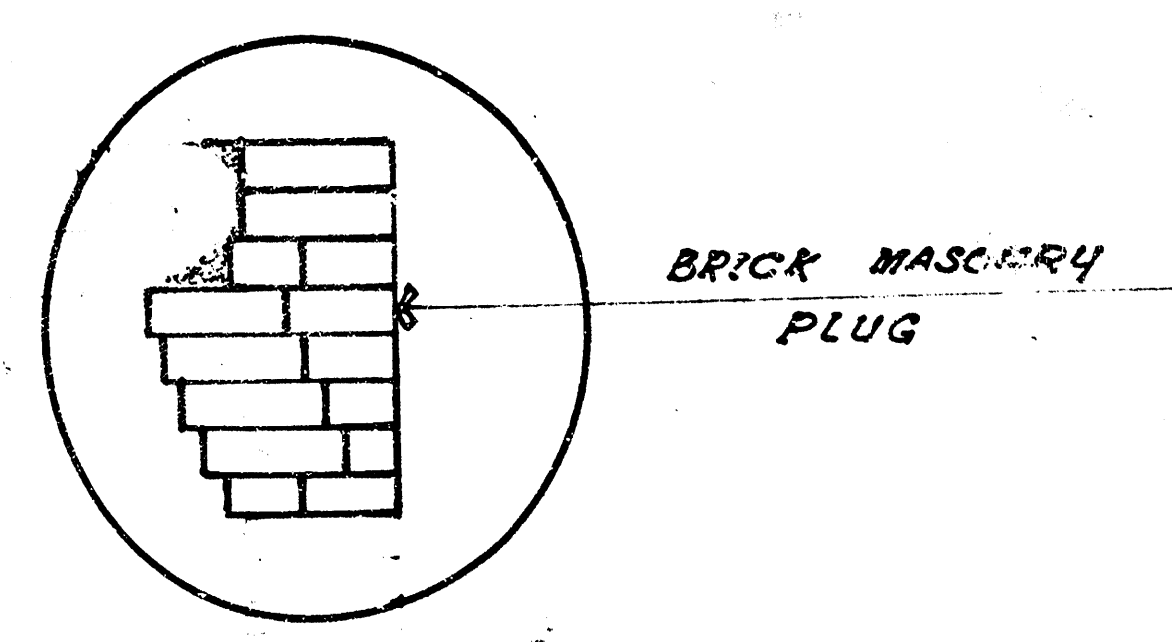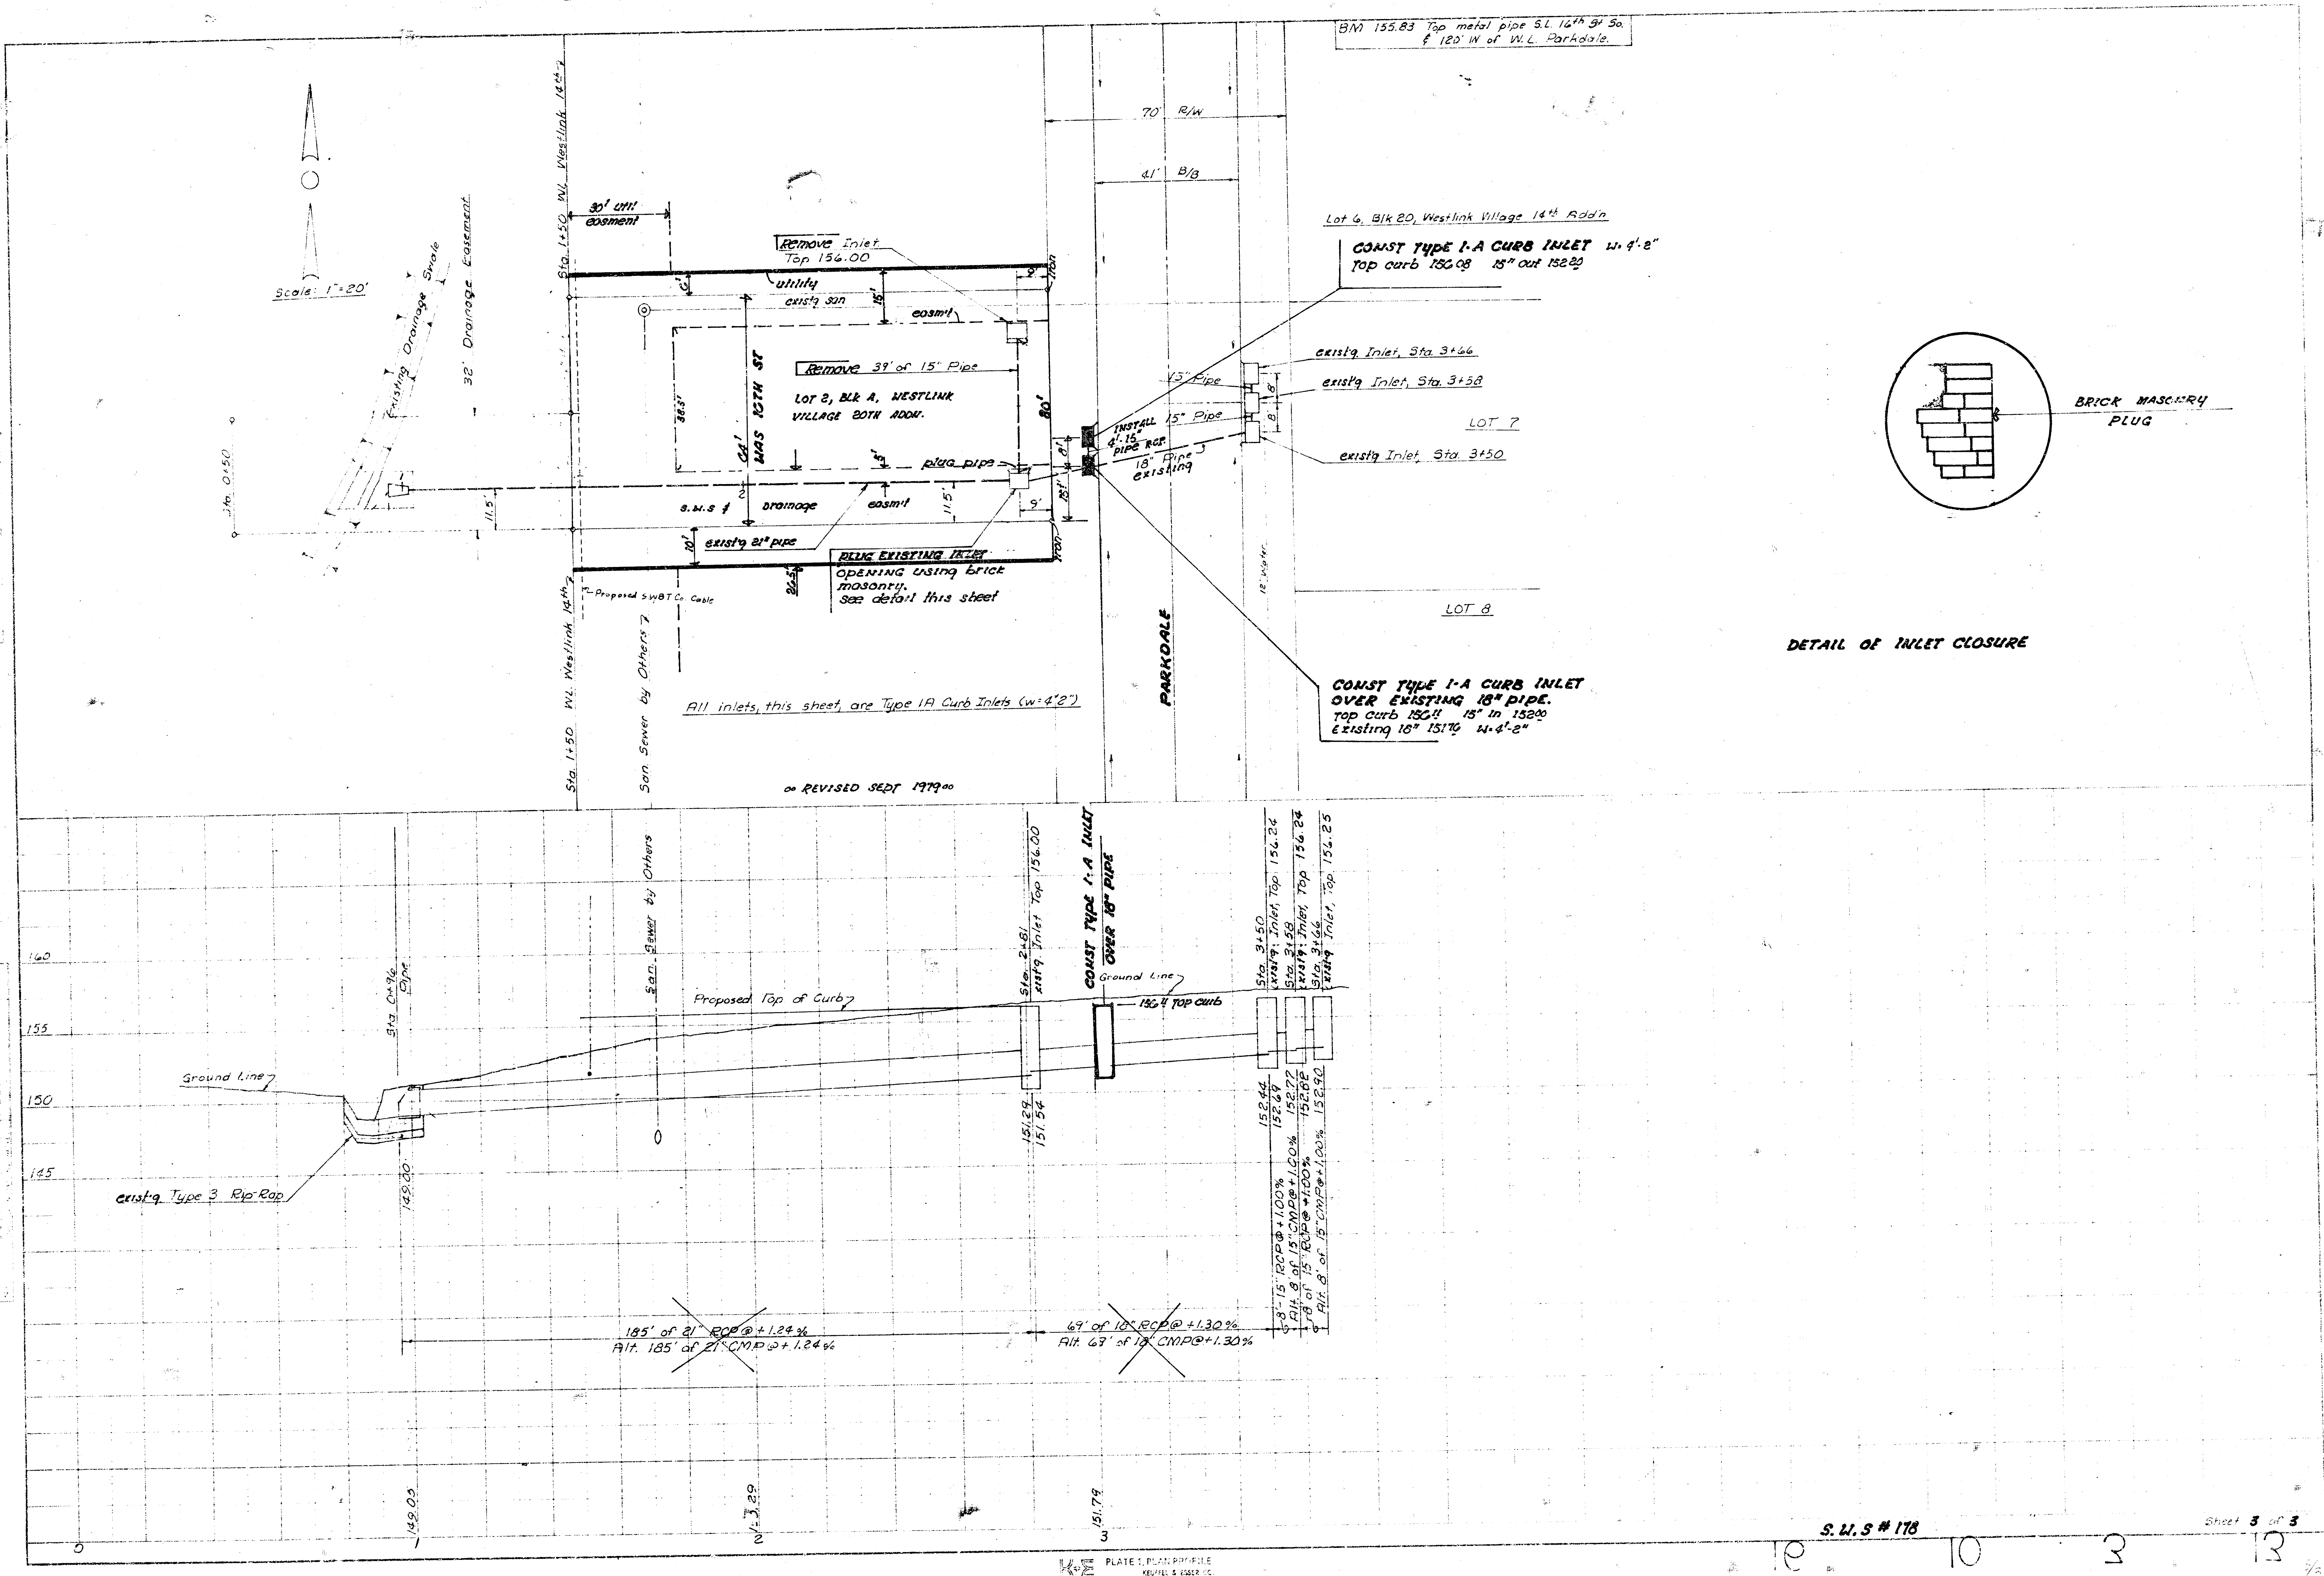

DETAIL OF INLET CLOSURE