BM 127.74 N.E. Cor. Conc. Step No. 1631 N Kessler.

N

Scale 1" = 20'

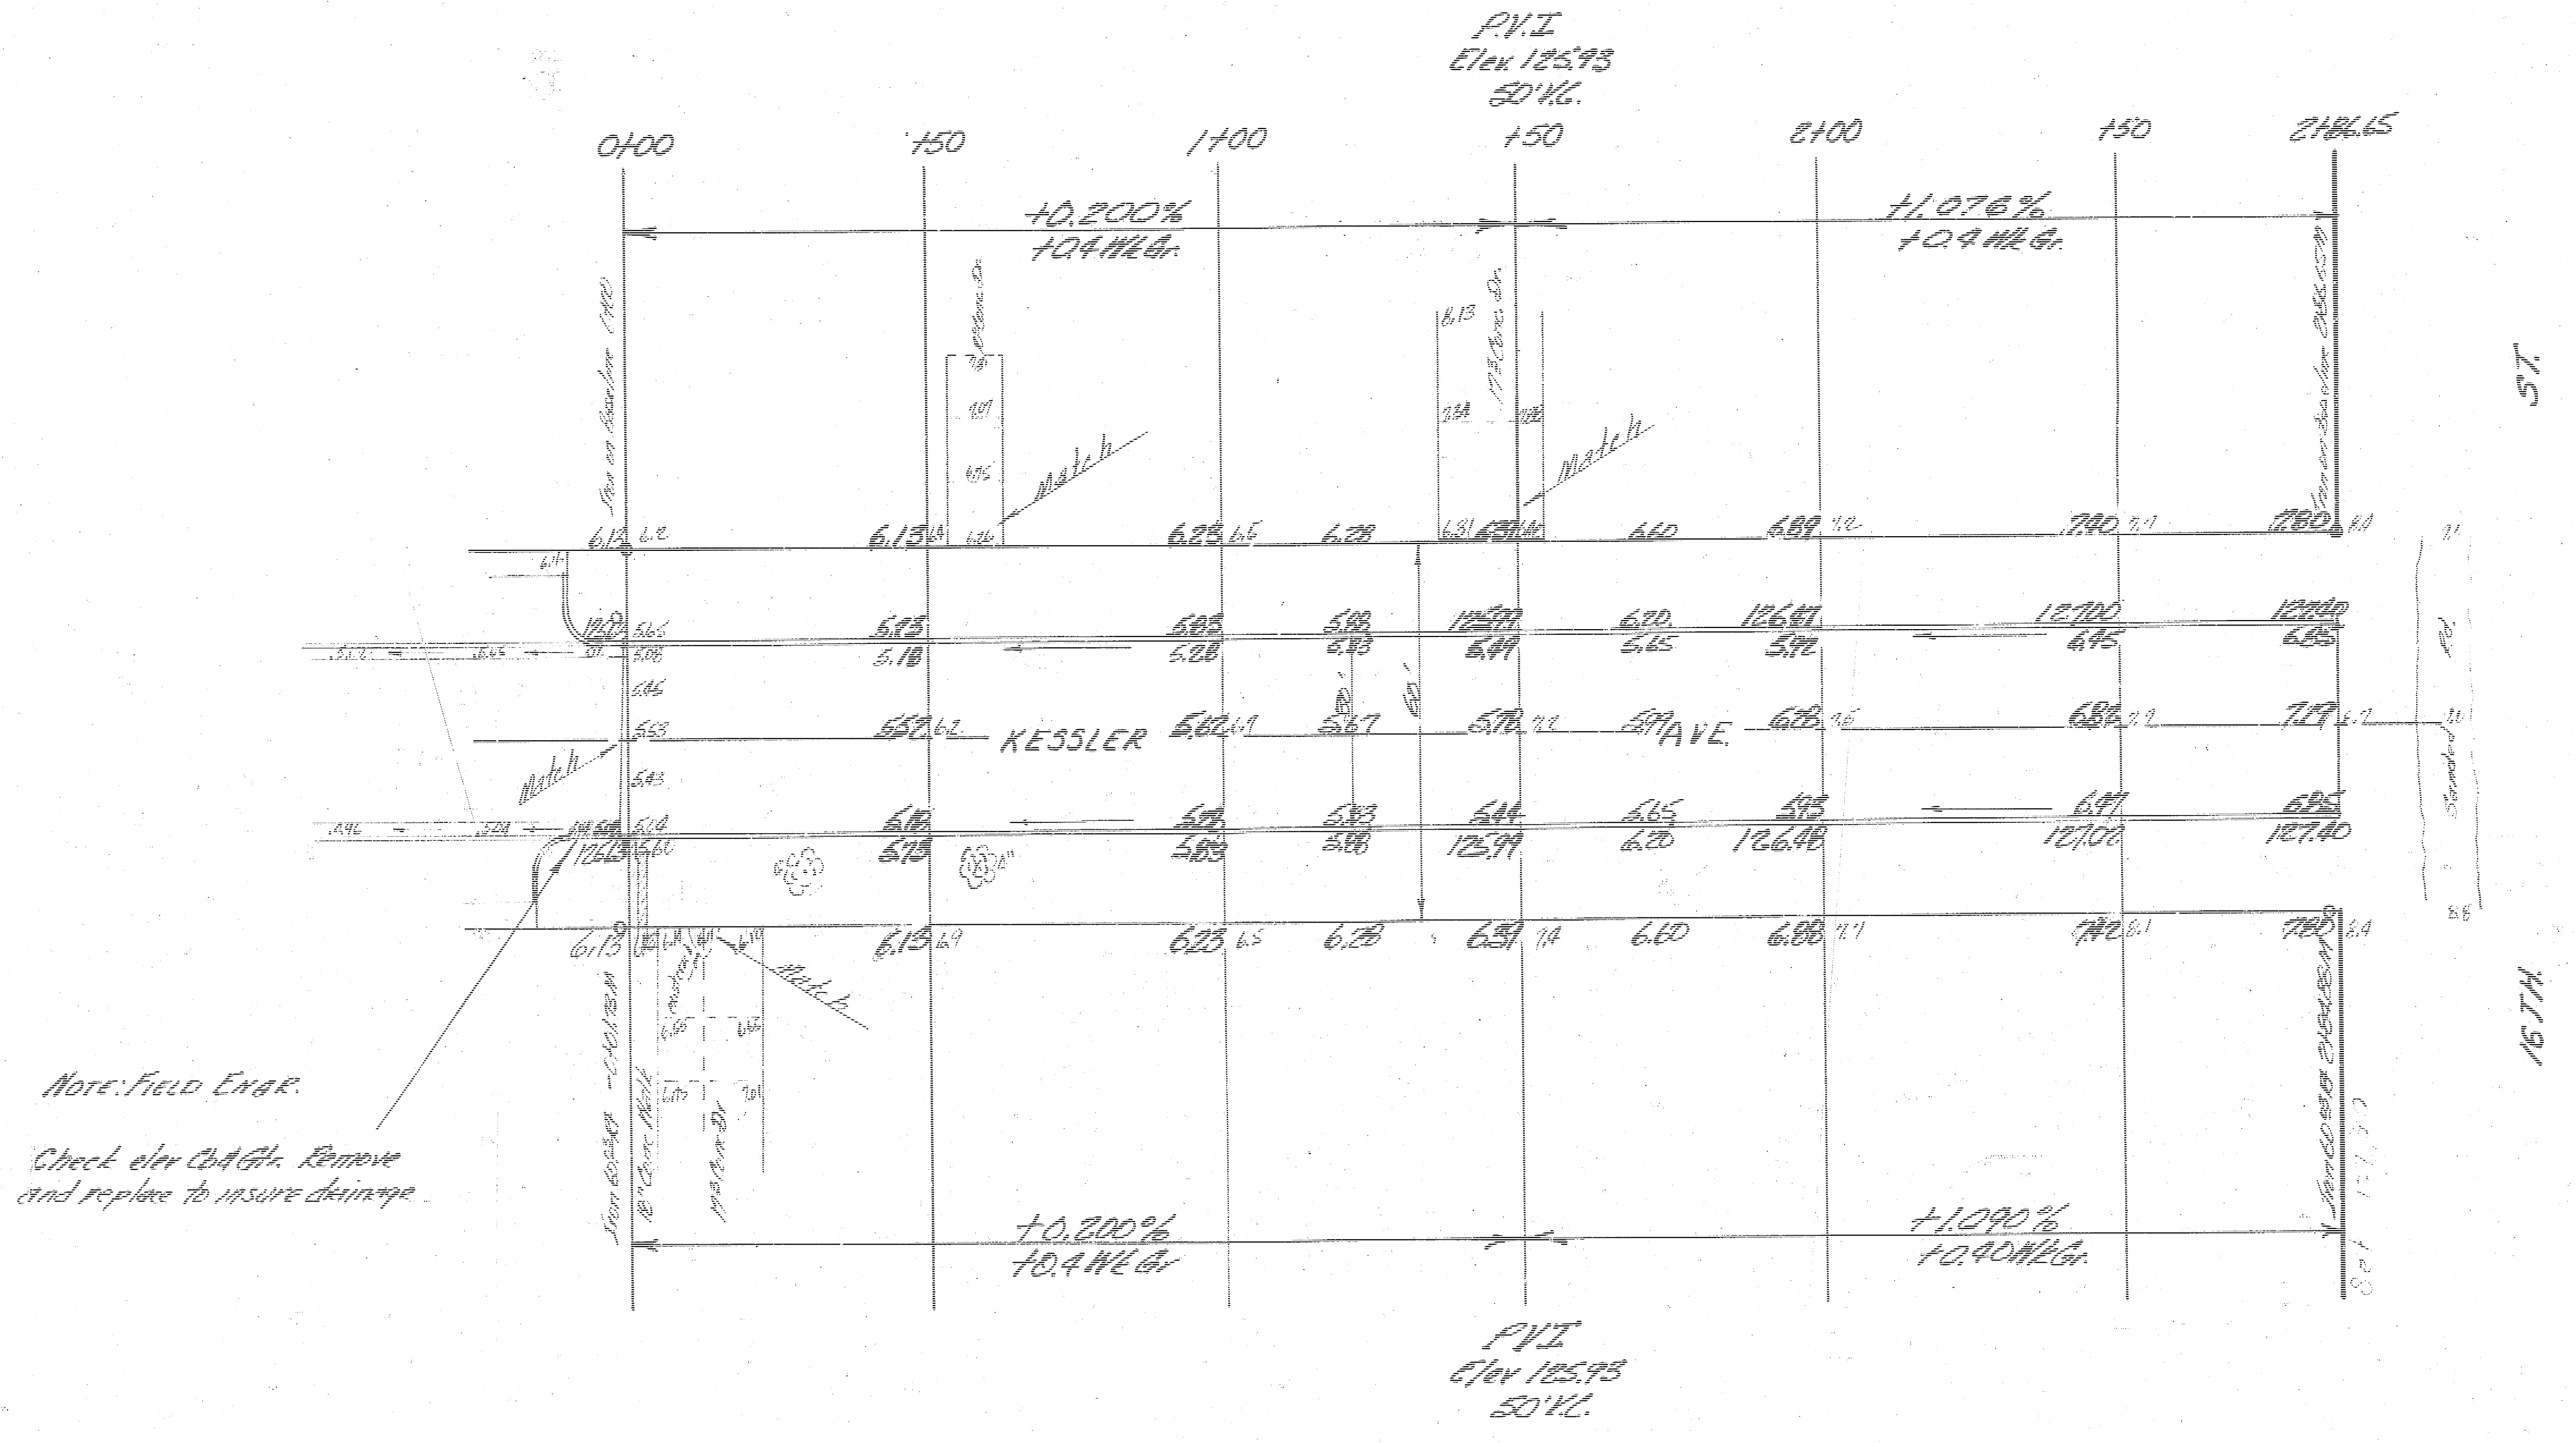
P.V.I
Elev. 125.93
50' V.C.
0+00
+50
1+00
+50
2+00
+50
2+86.65
+0.200%
+0.4 W.L.Gr.
+1.076%
+0.4 W.L.Gr.
Match
KESSLER
AVE.
60'
16TH
ST.
+0.200%
+0.4 W.L.Gr.
+1.090%
+0.40 W.L.Gr.
P.V.I
Elev 125.93
50' V.C.

Note: Field Engr.
Check elev Cb & Gtr. Remove and replace to insure drainage

Baseline = W.R.

Excavation
Prop.

699.8 C.Y.
70.0 +10%
769.8 C.Y. Total

KESSLER AVE.
N.L. J.H. JARRETT ADDN. TO
S.L. 16TH ST.
30' CONC. & C.B.
CITY OF WICHITA, KANSAS
B.E. SMITH CITY ENGINEER
DATE MAY 1966 PROJ. C 16-4

3684

436

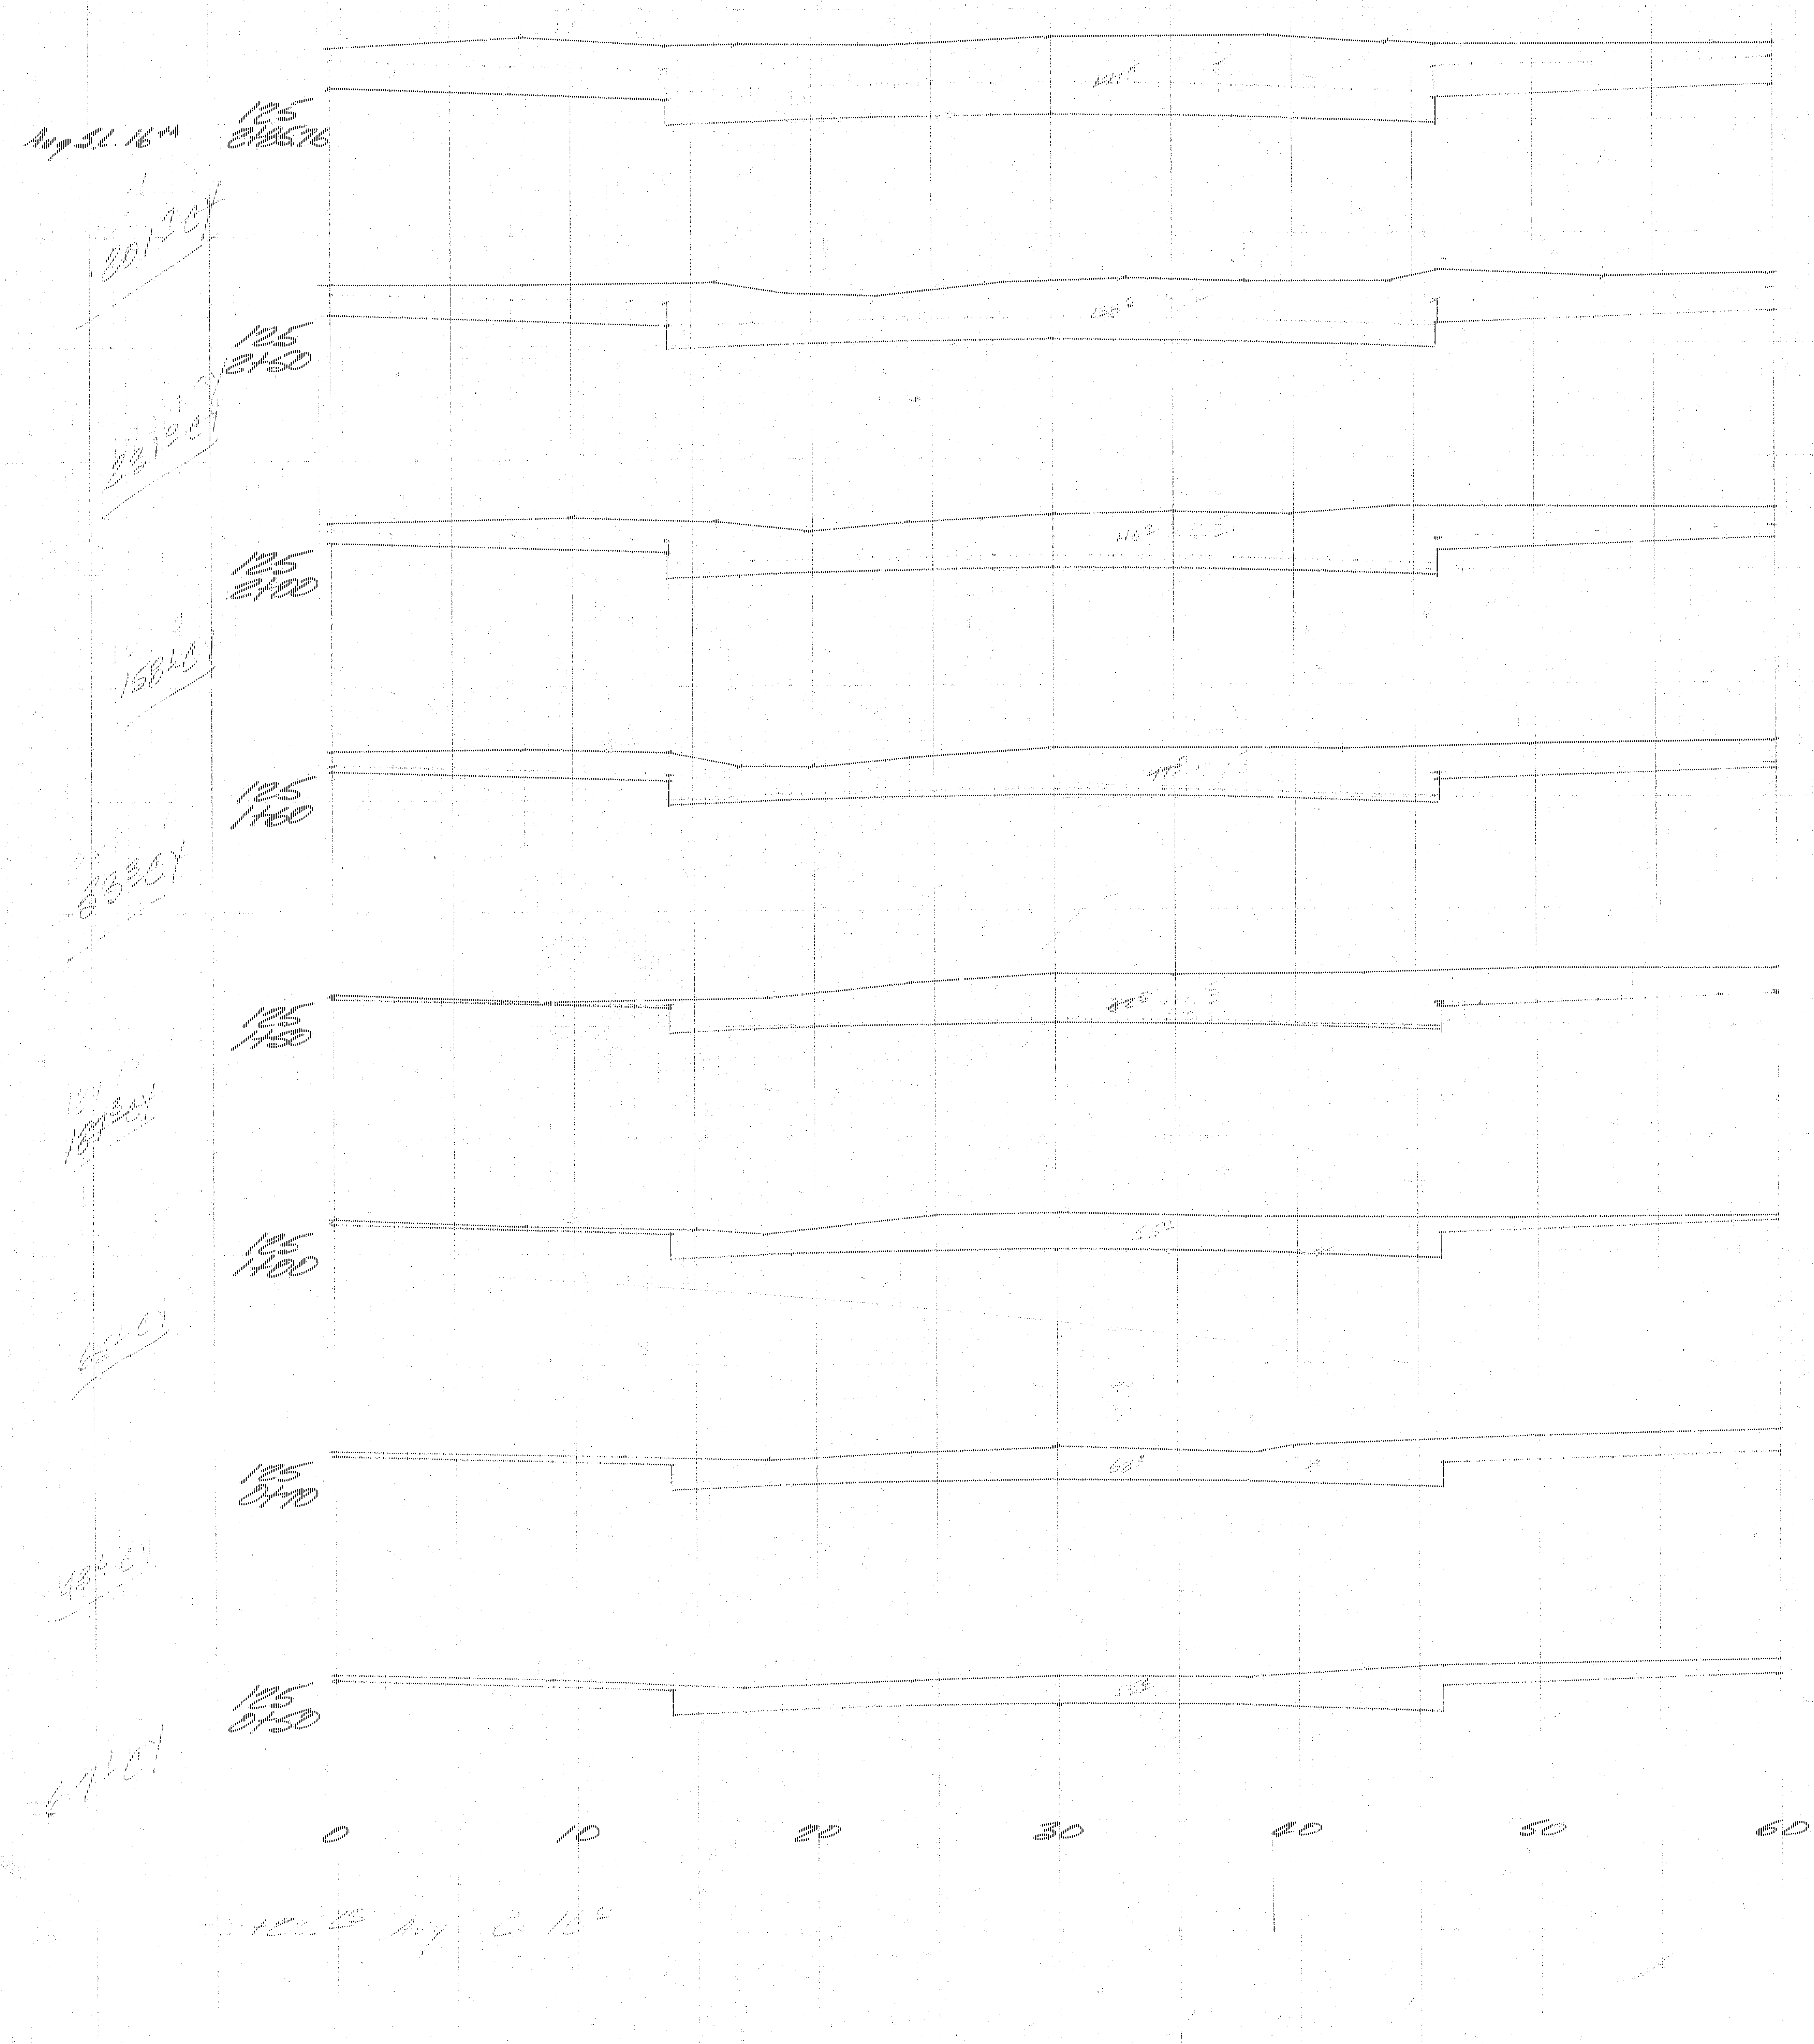
Aug S.L. 16th
125
2+85.76
201.2 CY
125
2+50
222.0 CY
125
2+00
158.6 CY
125
1+60
88.3 CY
125
1+30
187.3 CY
125
1+00
68.2 CY
125
0+70
48.6 CY
125
0+50
67.2 CY
0
10
20
30
40
50
60

Kessler Ave
N.L. J.H. Jarett Addn
To S.L. 16th St
C16-4