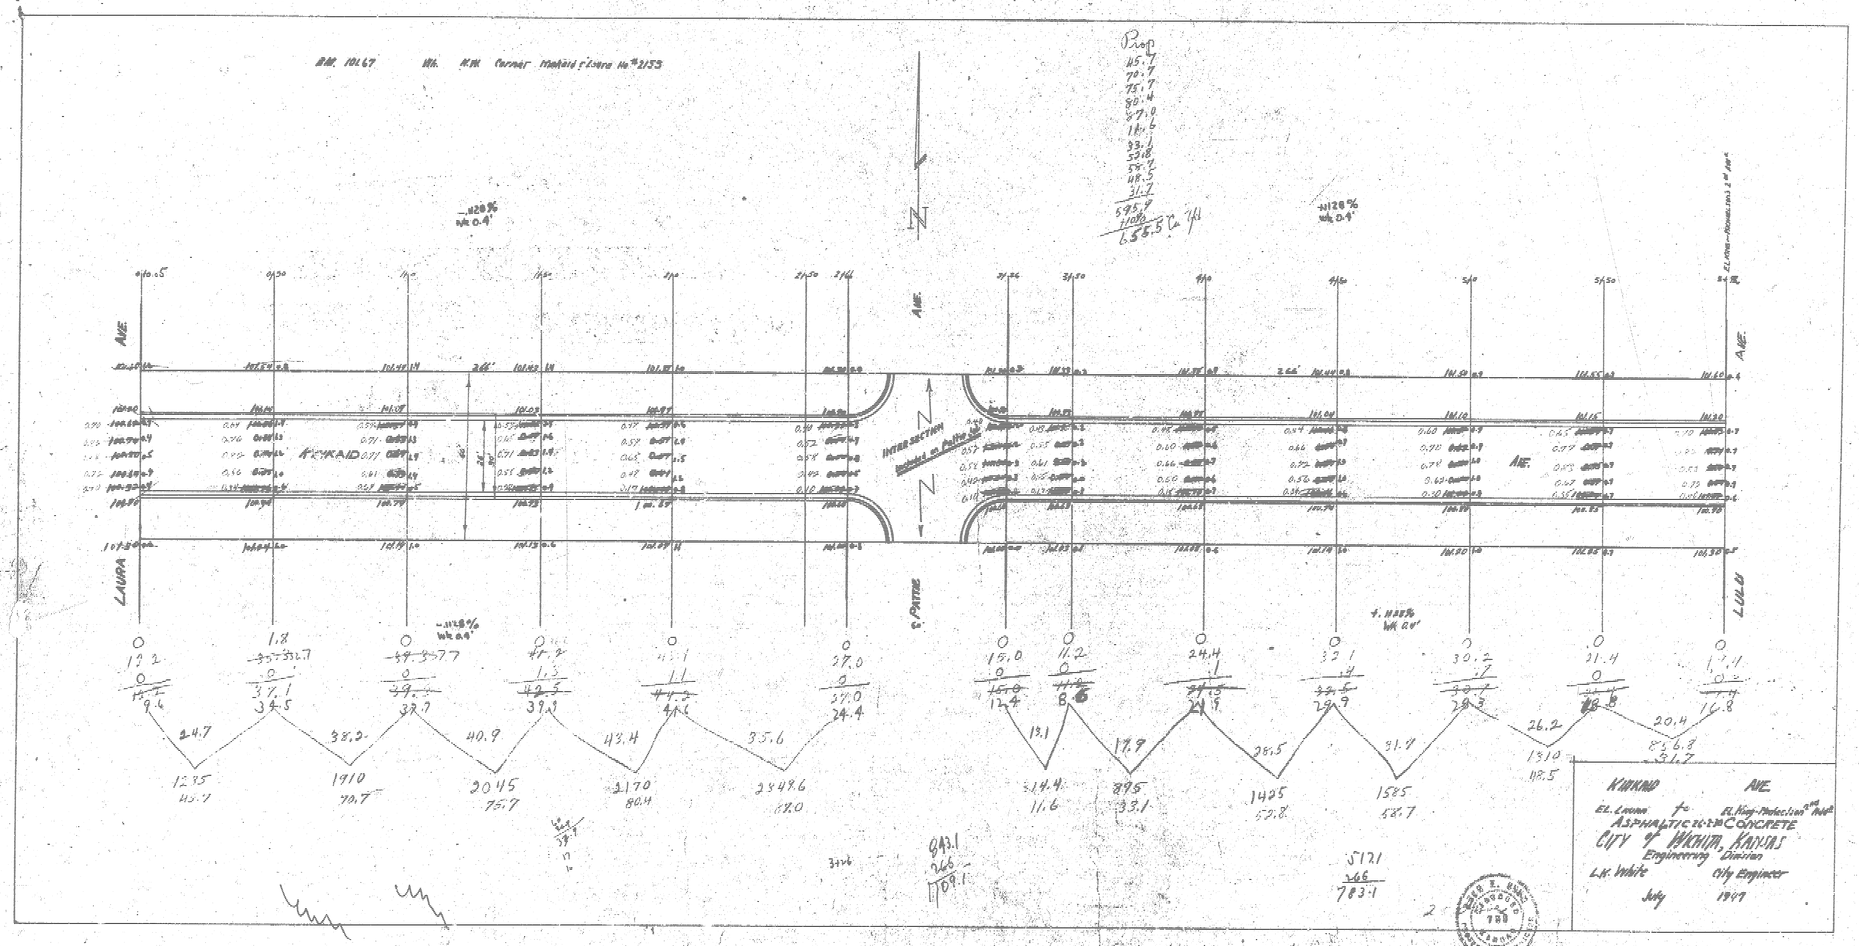
BM. 101.67
Wh. KW Corner manhole Elevation No. 2153
Prop
115.7
70.7
75.7
80.4
87.0
114.6
33.1
55.8
58.7
48.5
31.7
595.9
1100
655.5 Cu yd
N
LAURA
LULU
S. PATTIE
INTERSECTION
Ladders on Pattie St.
26'
+1.28%
Wk 0.4'
-1.28%
Wk 0.4'
-2.28%
Wk 0.4'
+1.88%
Wk 0.4'
1275
45.1
1910
70.7
2045
75.7
2170
80.4
2348.6
87.0
1445
53.8
1585
58.7
1310
48.5
843.1
265
109.1
5121
266
783.1
EL. Lawn to EL. King-Pedestrian 2nd Walk
ASPHALTIC CONCRETE
CITY OF WICHITA, KANSAS
Engineering Division
L.K. White City Engineer

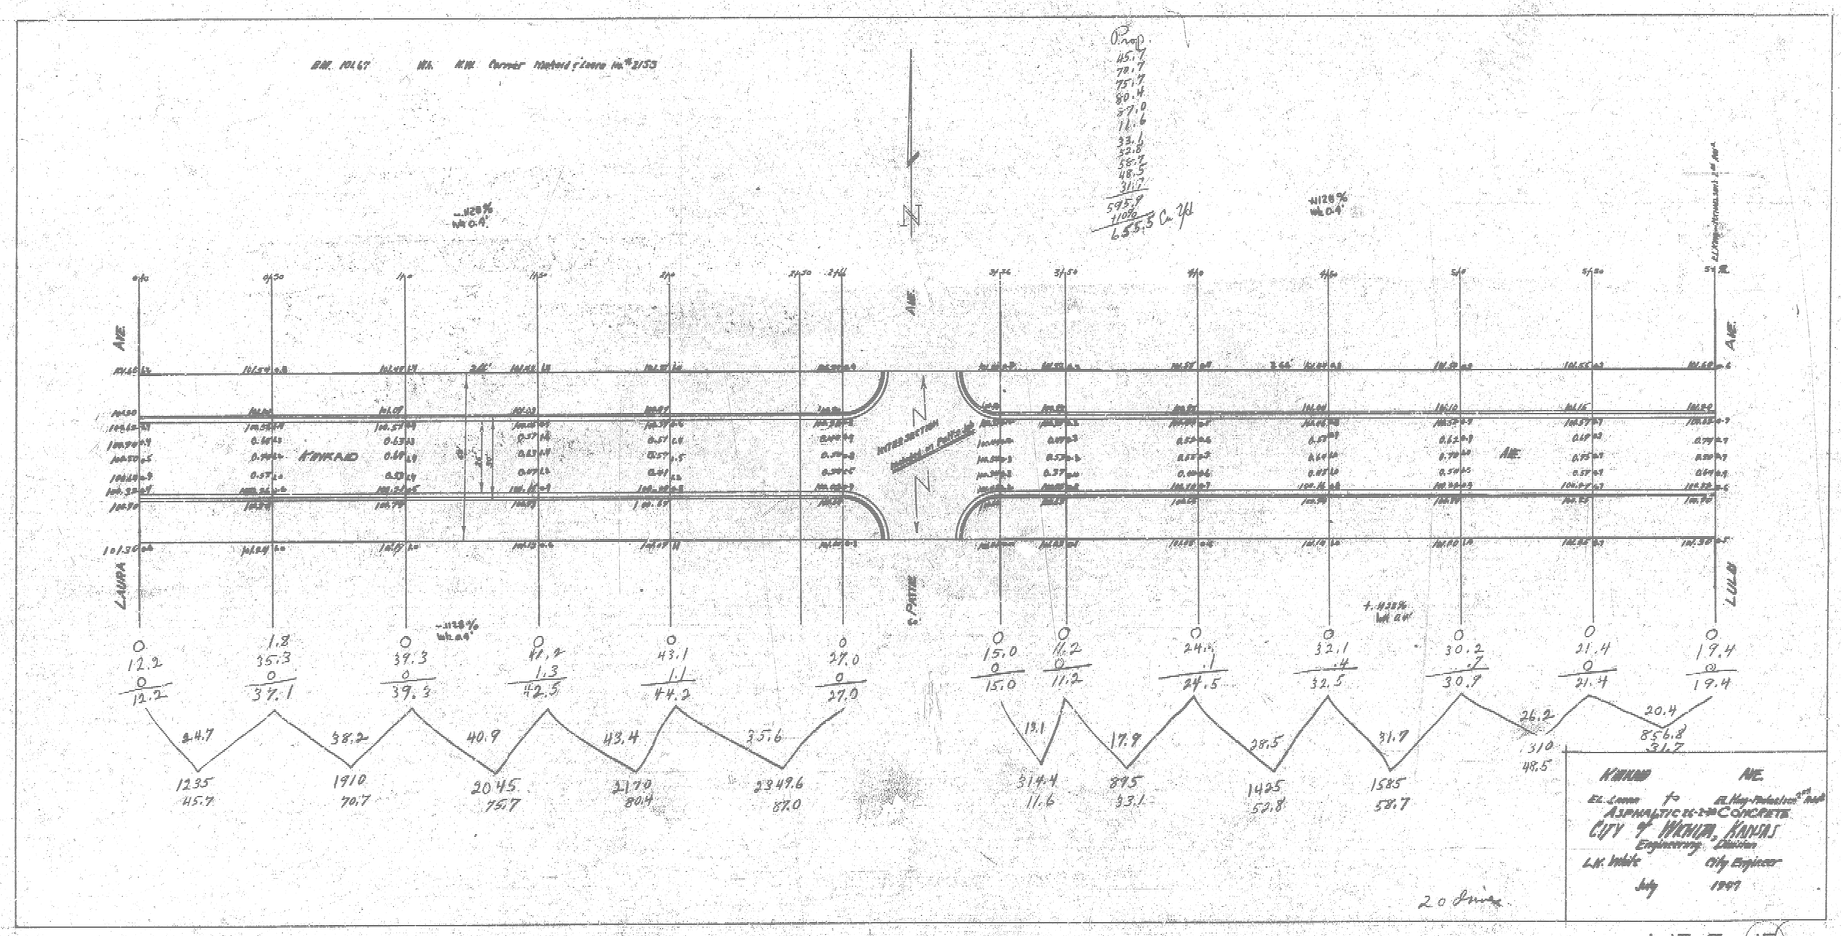
B.M. 101.67
N
Cmp.
115.7
70.7
75.7
80.4
57.0
11.6
33.1
52.8
58.7
48.5
311.7
595.9
1106
655.3 Cu. Yd.
+1128%
Wt. 0.4'
AVE.
LAURA
LULU
INTERSECTION
0+00
0+50
1+00
1+50
2+00
2+50
3+00
3+50
4+00
4+50
5+00
5+50
6+00
12.2
35.3
37.3
42.5
43.1
27.0
15.0
11.2
24.5
32.5
30.7
21.4
19.4
1235
45.7
1910
70.7
2045
75.7
2170
80.4
2349.6
87.0
314.4
11.6
895
33.1
1425
52.8
1585
58.7
310
48.5
856.8
31.7
20 Lines
Ex. Lanes to Ex. Hay-Pebbles 8" Asph.
ASPHALTIC CONCRETE
CITY OF WICHITA, KANSAS
Engineering Division
L.W. Webb
City Engineer
July

15 S 51 A