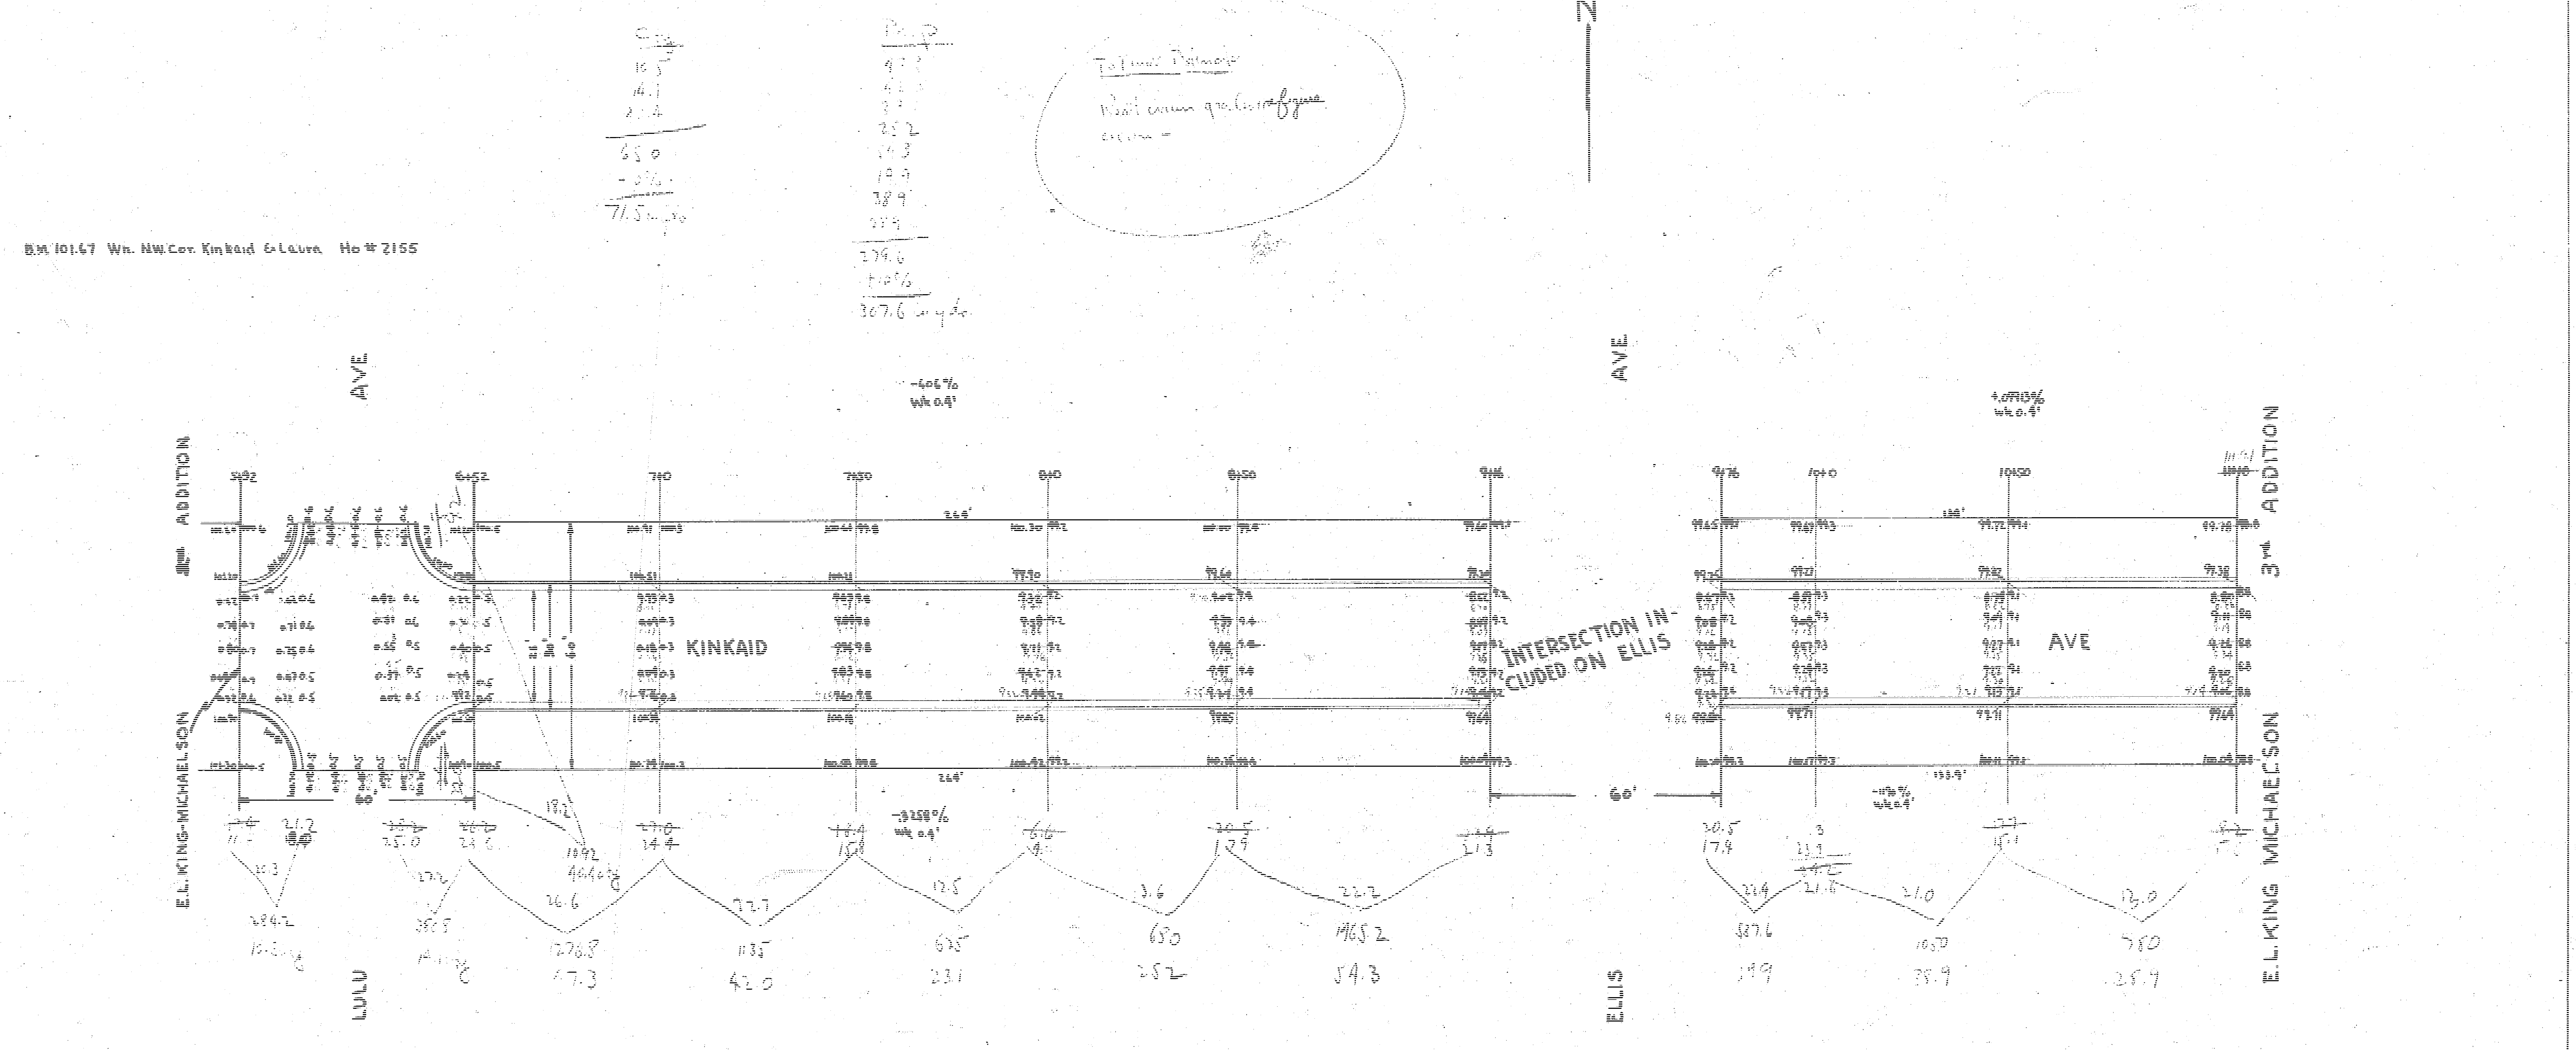
B.M. 101.67 Wn. NW. Cor. Kinkaid & Laura Ho # 2155
N
AVE
LULU
E.L. KING-MICHAELSON 2nd ADDITION
KINKAID
INTERSECTION INCLUDED ON ELLIS
AVE
ELLIS
60'
E.L. KING MICHAELSON 3rd ADDITION

1931
264
4571

KINKAID AVE
E.L.KING-MICHAELSON 2ND to E.L.KING-MICHAELSON 3rd
26'-2'-30' ASPH. CONC
CITY of WICHITA, KANSAS
L.K.WHITE CITY ENGINEER
JAN 1948 PROJ. NO. C-17-164

City
10.5
14.1
40.4
65.0
+10%
71.5 cu yds

Prep
47.3
42.0
23.1
25.2
54.3
19.9
38.9
28.9
279.6
+10%
307.6 cu yds

To Final Estimate
Revist crown grades & figure
excvn –

BM 101.67 Wb. NW Cor. Kinkaid & Laura Ho # 2155

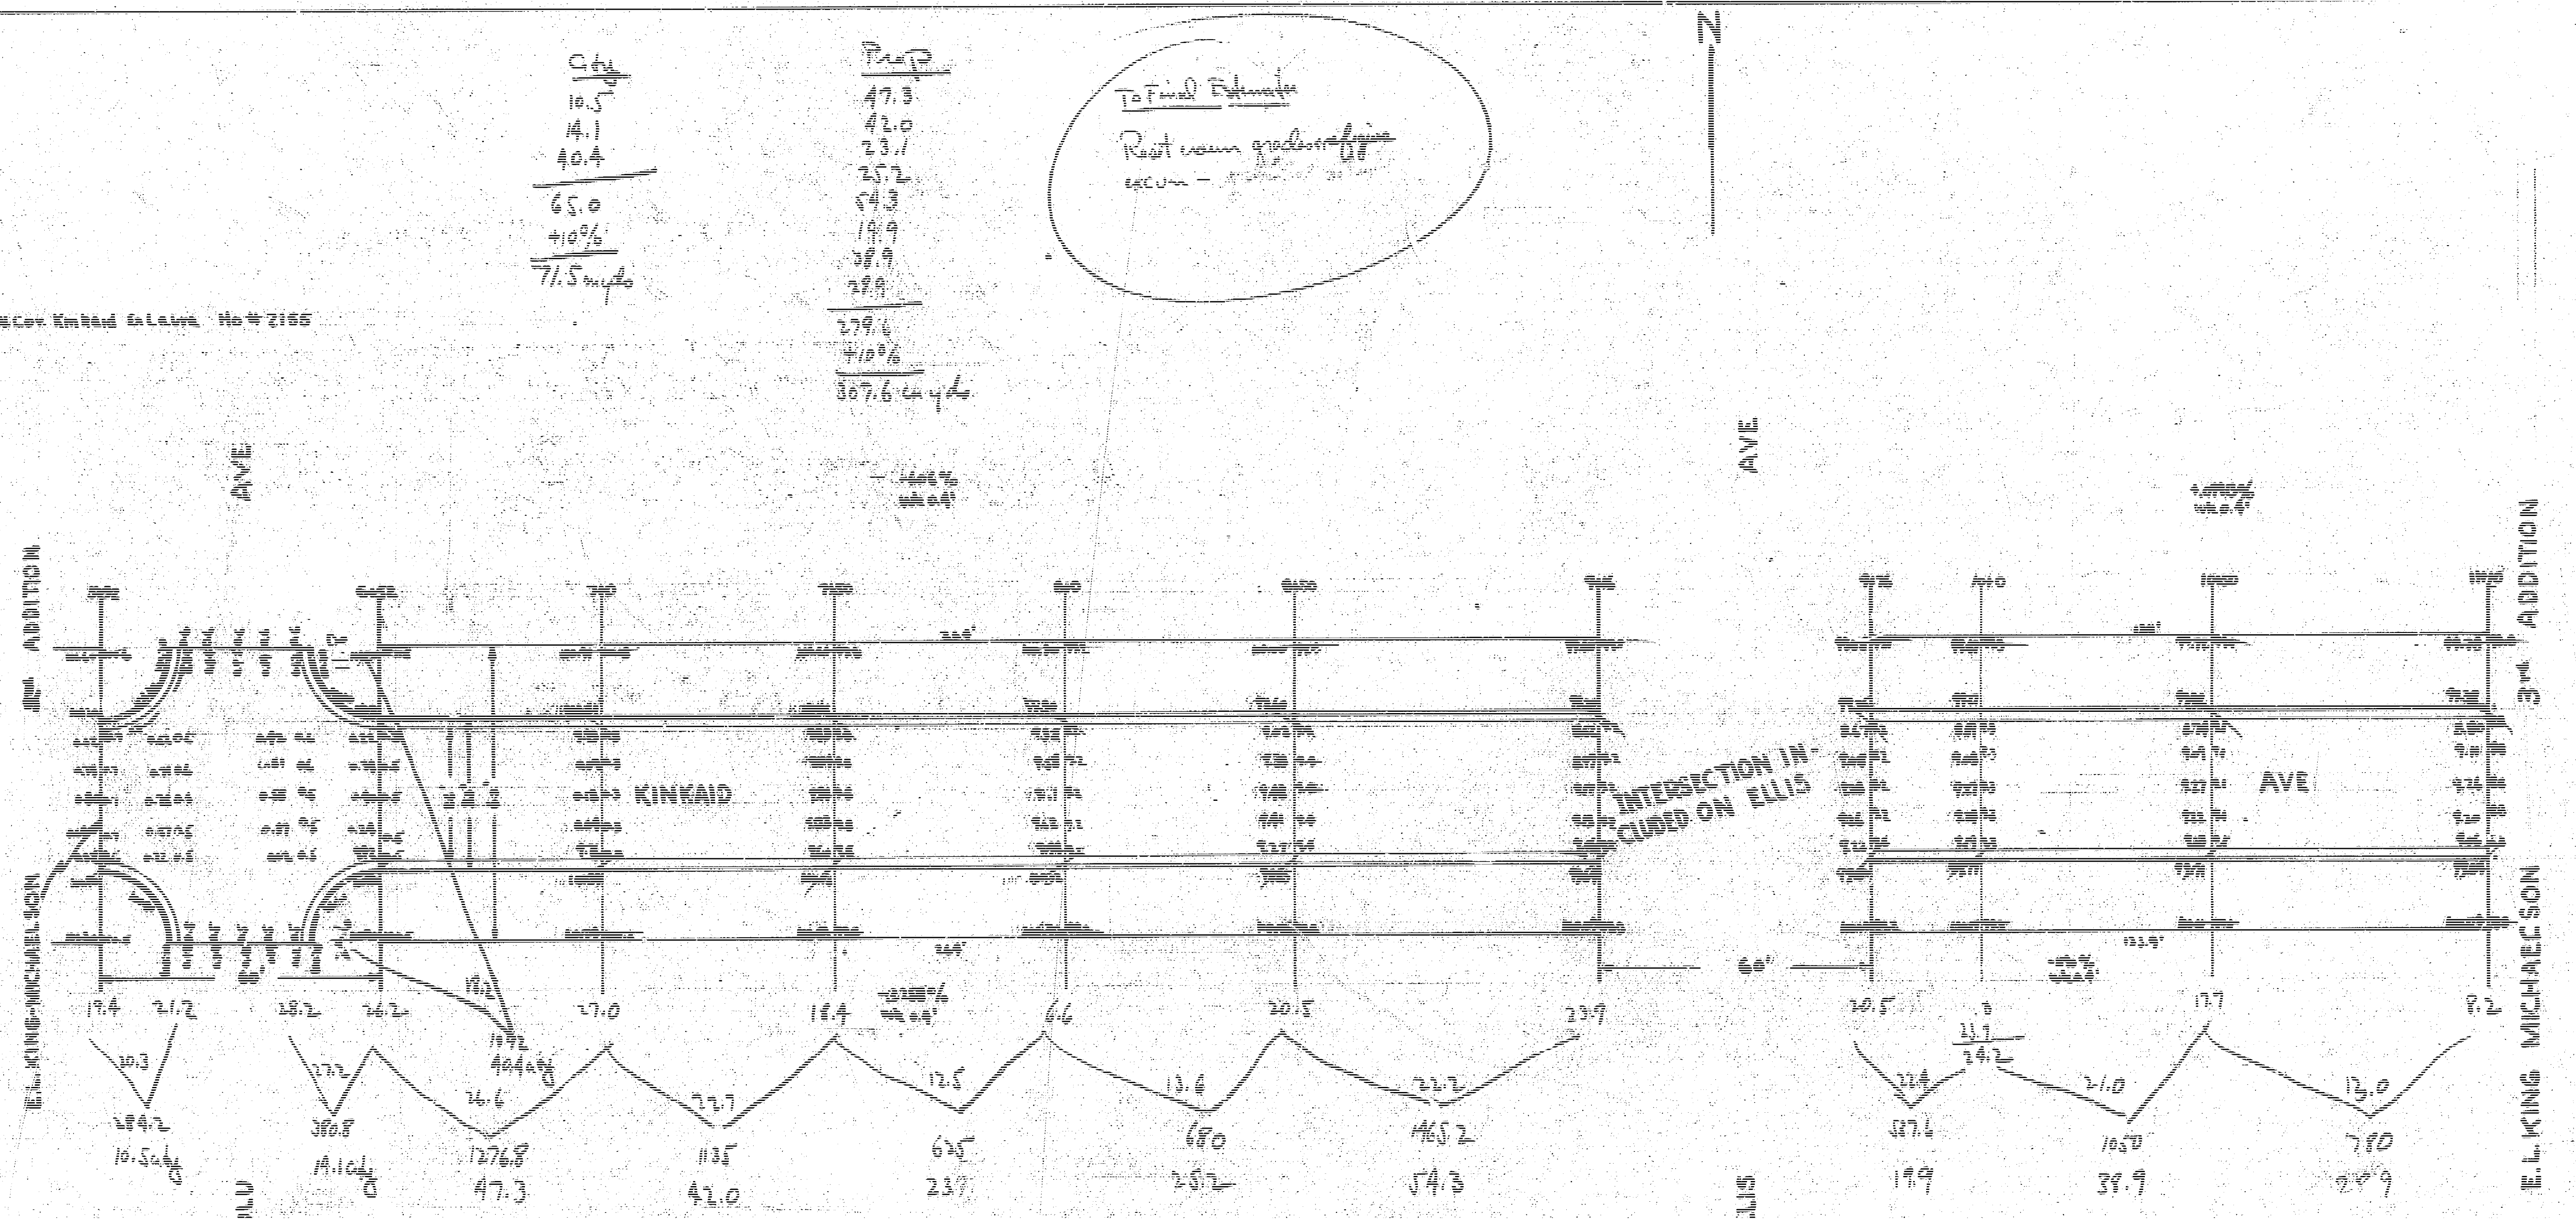

N
AVE
LULU
KINKAID
E.L. KING-MICHAELSON 2nd ADDITION
INTERSECTION INCLUDED ON ELLIS
AVE
ELLIS
AVE
E.L. KING MICHAELSON 3rd ADDITION
60'
60'
19.4
21.2
28.2
26.2
27.0
18.4
6.6
20.5
23.9
20.5
13.7
8.2
284.2
10.5 cu yds
380.8
14.1 cu yds
1992
40.4 cu yds
1276.8
47.3
1135
42.0
625
23.1
680
25.2
1465.2
54.3
537.6
19.9
1050
38.9
780
28.9

KINKAID AVE
E.L. KING-MICHAELSON 2nd to E.L. KING-MICHAELSON 3rd
26'-2'-30' ASPH. CONC
CITY of WICHITA, KANSAS
L.K. WHITE CITY ENGINEER
JAN 1948 PROJ. NO. C-17-164

4 15 5 ⑪