


B.M. 116.78 1" Top curb, N. side Kessler south of S.L. Douglas.
 B.M. 121.11 N.E. cor curb steps at No. 2229 N. Kessler.
 Baseline & survey from a line 79' West of E. Kessler.

EARTHWORK			
CITY		PROP.	
110.9		956.1	
+10%	11.1	+10%	95.6
122.0	Cu. Yds.	1051.7	Cu. Yds.

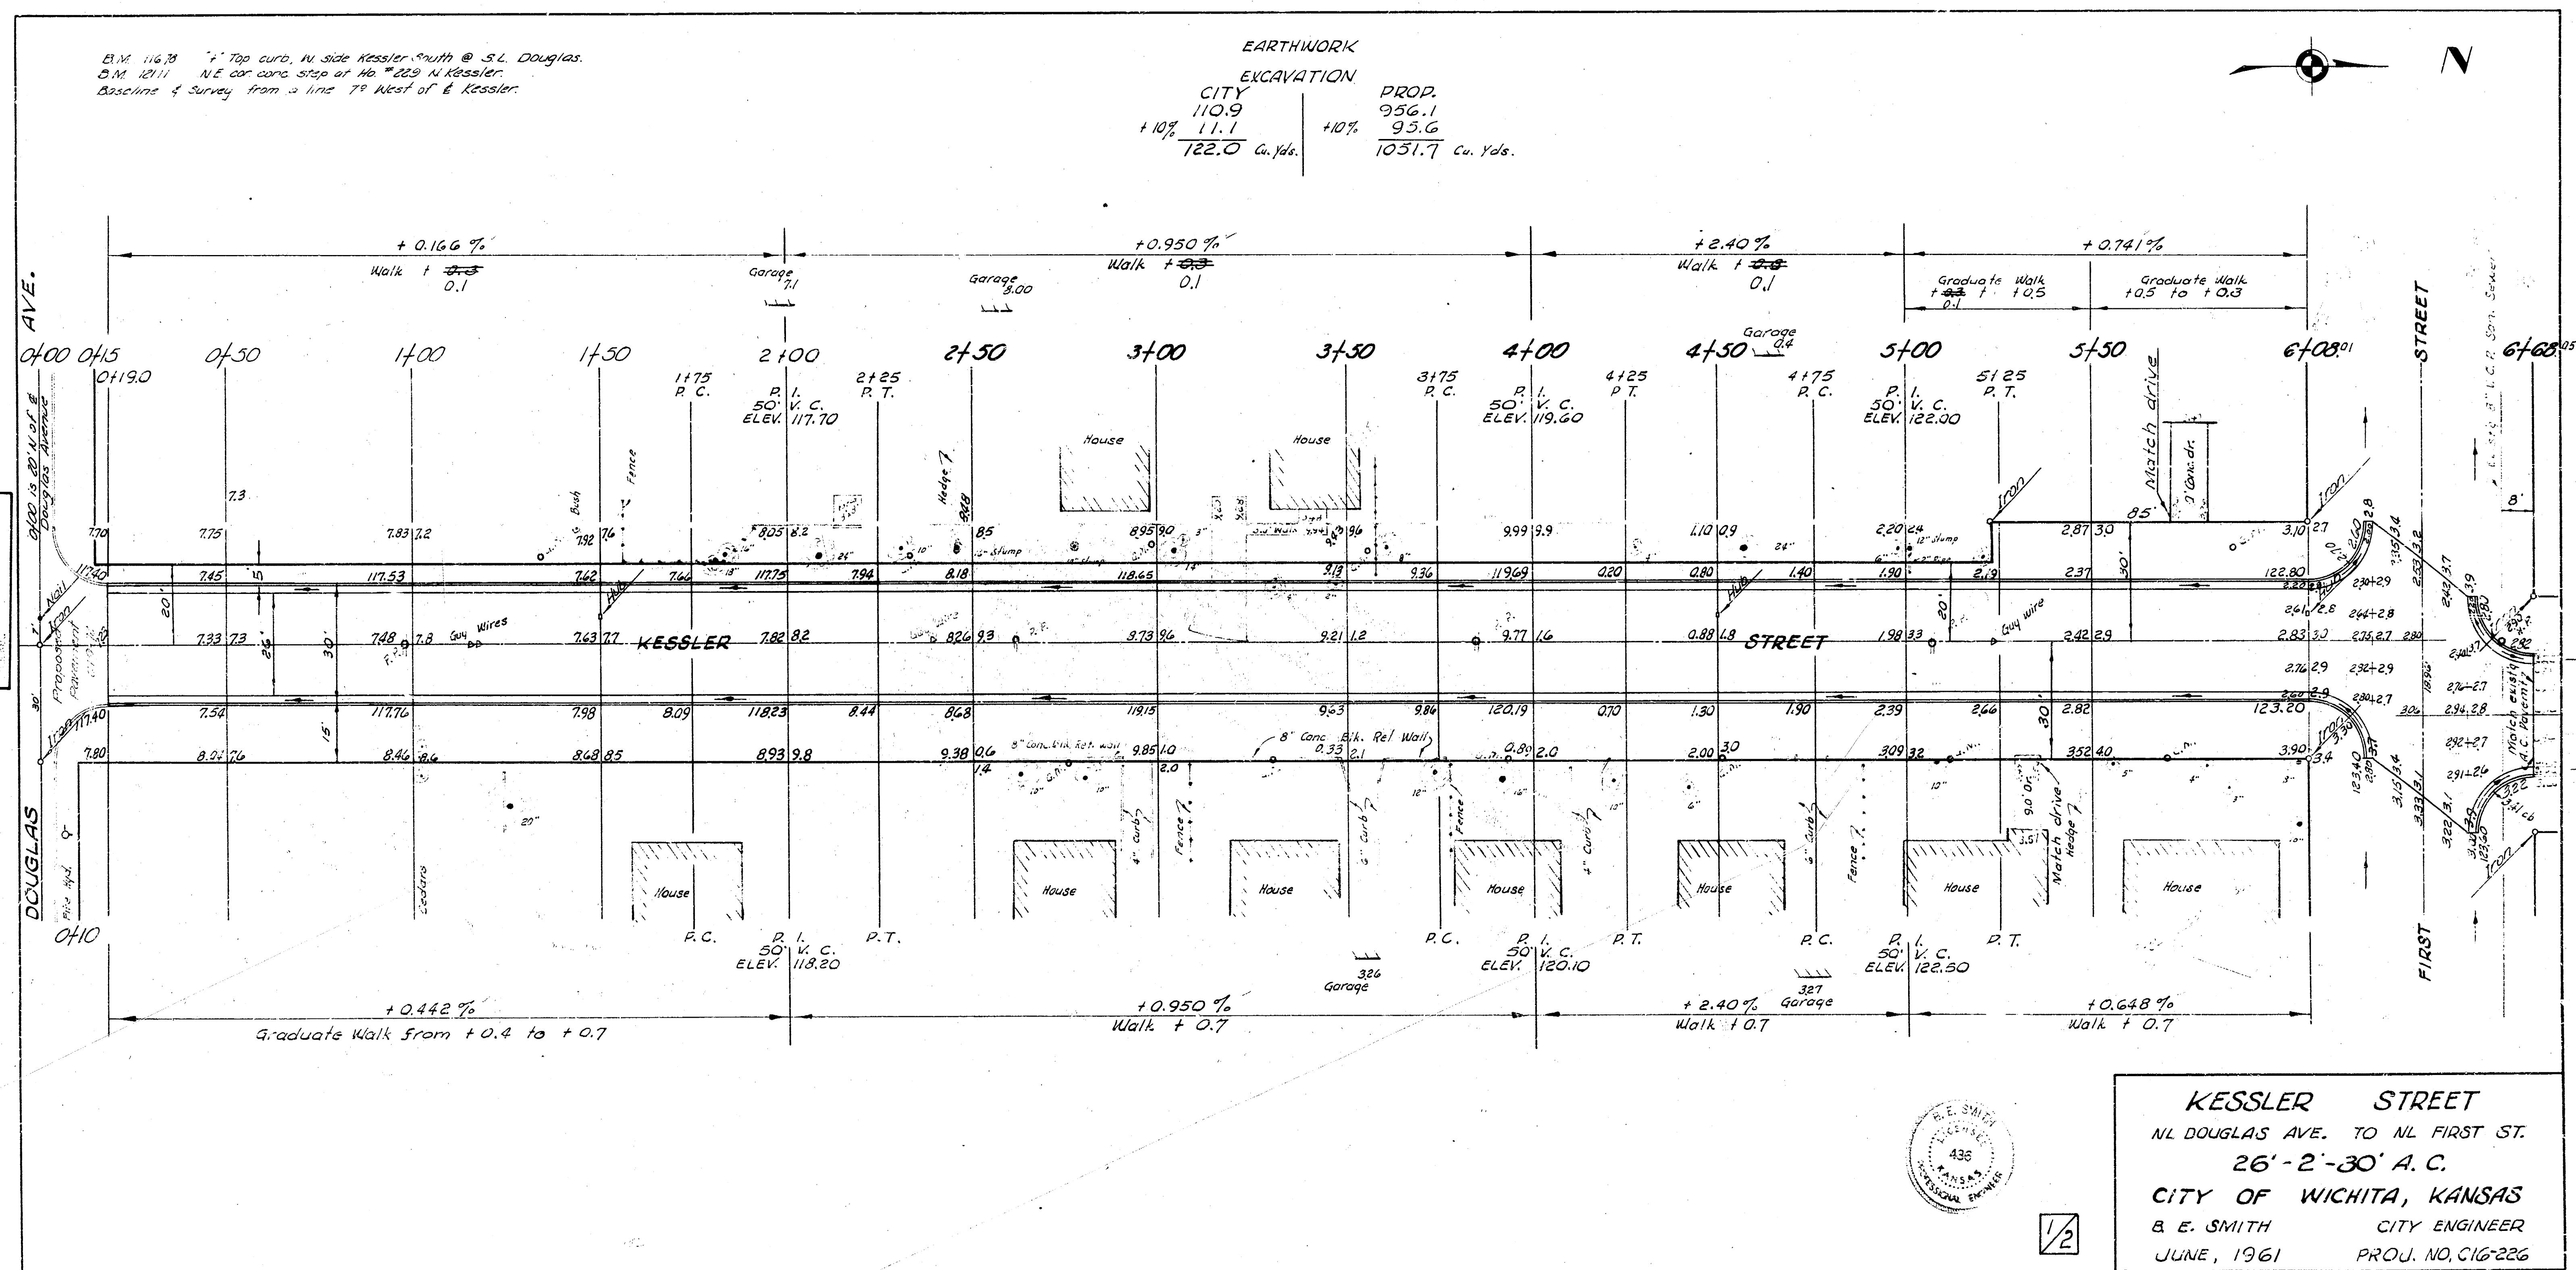

1/2

KESSLER STREET
 N. L. DOUGLAS AVE. TO N. L. FIRST ST.
 26'-2'-30" A.C.
 CITY OF WICHITA, KANSAS
 B. E. SMITH CITY ENGINEER
 JUNE, 1961 PROJ. NO. CIG-226