



BM 76.10 SE COR CONC PORCH 116 116 2869 LAURA
 3" 116 37 "11" IN MUELLER TOP FIVE REG 5" CONC WASSALL & LAURA

STA 114 91 INTERSECT E W HESTER 0+00 TO 2+5831
 STR ON N.E. 2+5831 ON NORTH

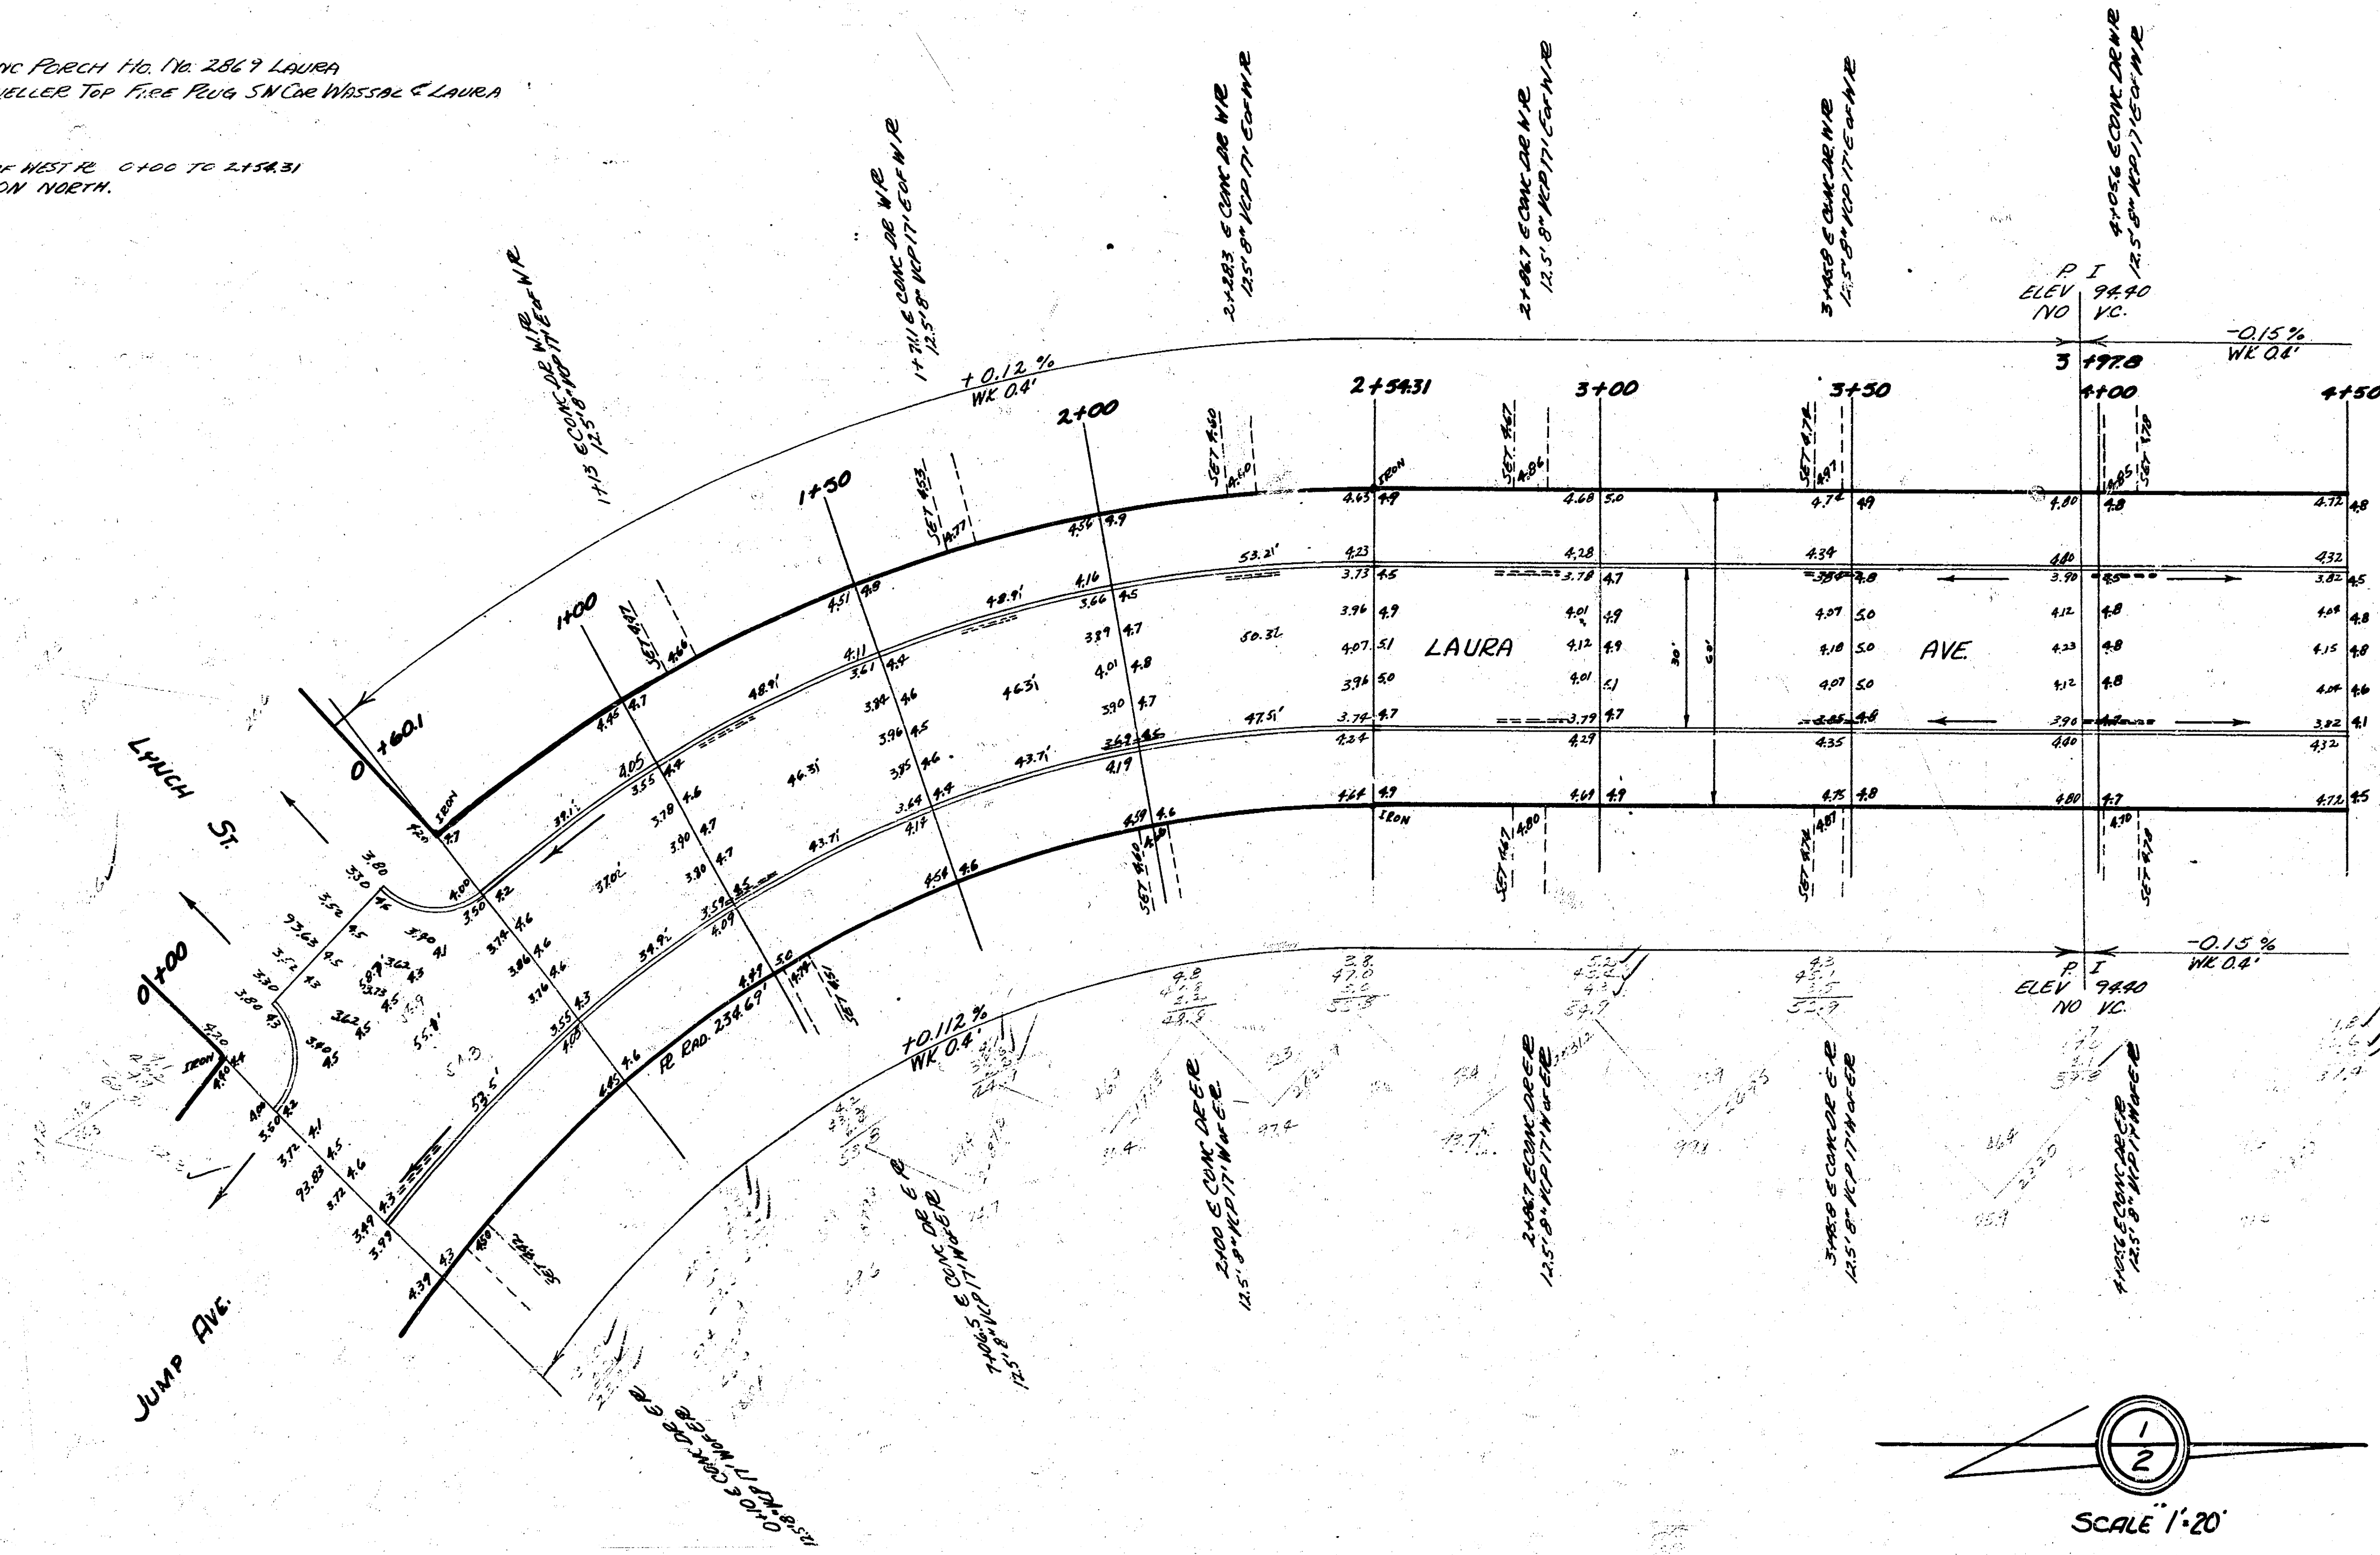


NOTE TO CONTRACTOR & FIELD ENGINEER:
 ALL ENTRANCE PIPES TO BE PLACED ON
 OWNERS PROPERTY. THE STREET DEPT.
 WILL HAUL THIS PIPE AWAY UPON THE
 REQUEST OF THE PROPERTY OWNER.

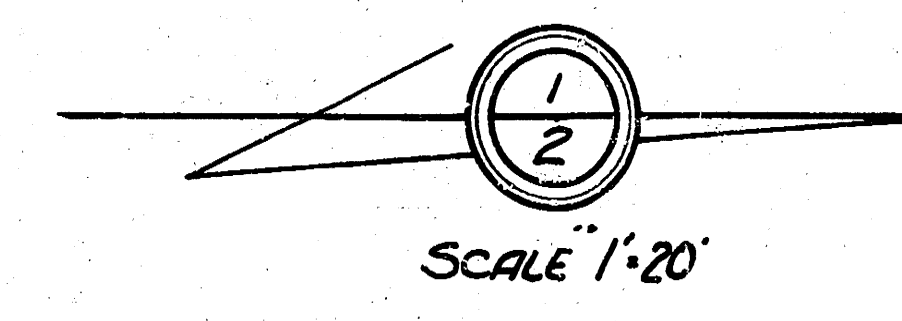


LAURA AVE.
 EL. LYNCH TO SL. WASSALL
 30' CONC #CB

CITY OF WICHITA, KANSAS
 B.E. SMITH CITY ENGINEER
 JAN. 9, 1952 PROJ. No. C12-130

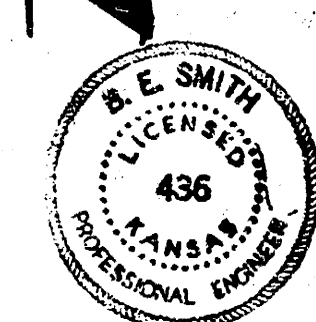

Surveying
 Plan
 Checked
 D.D.

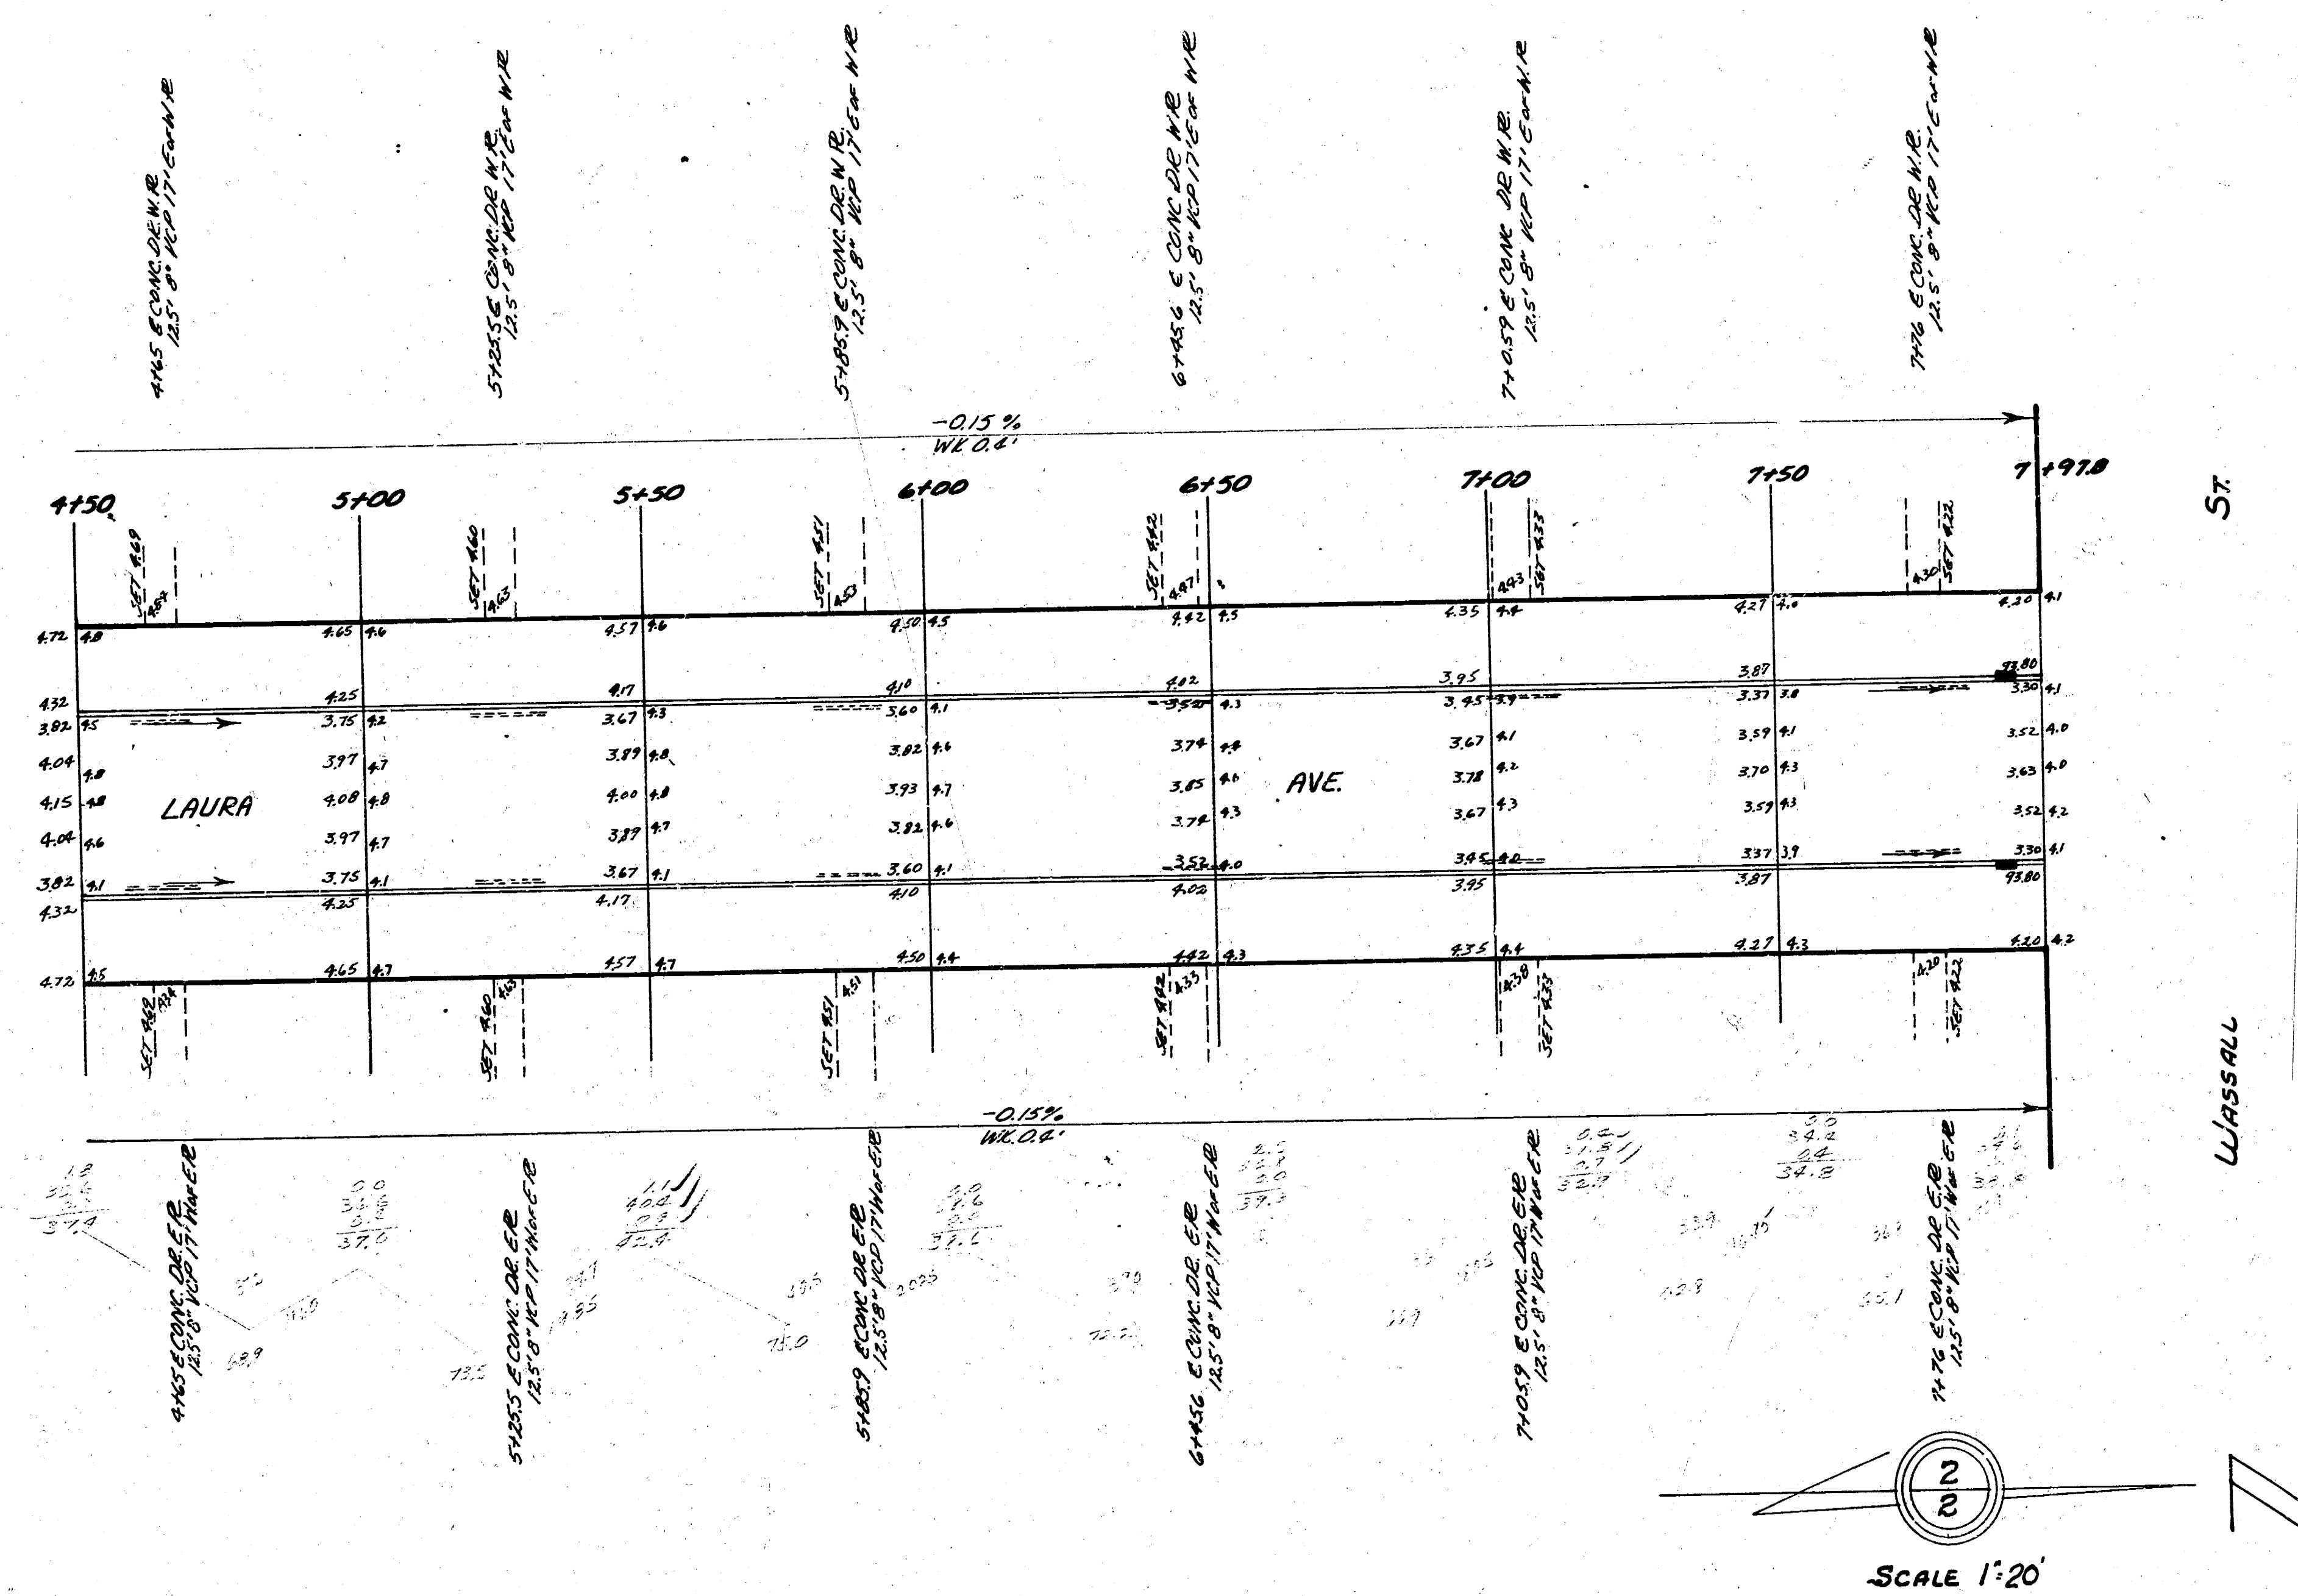

LAURA AVE.