

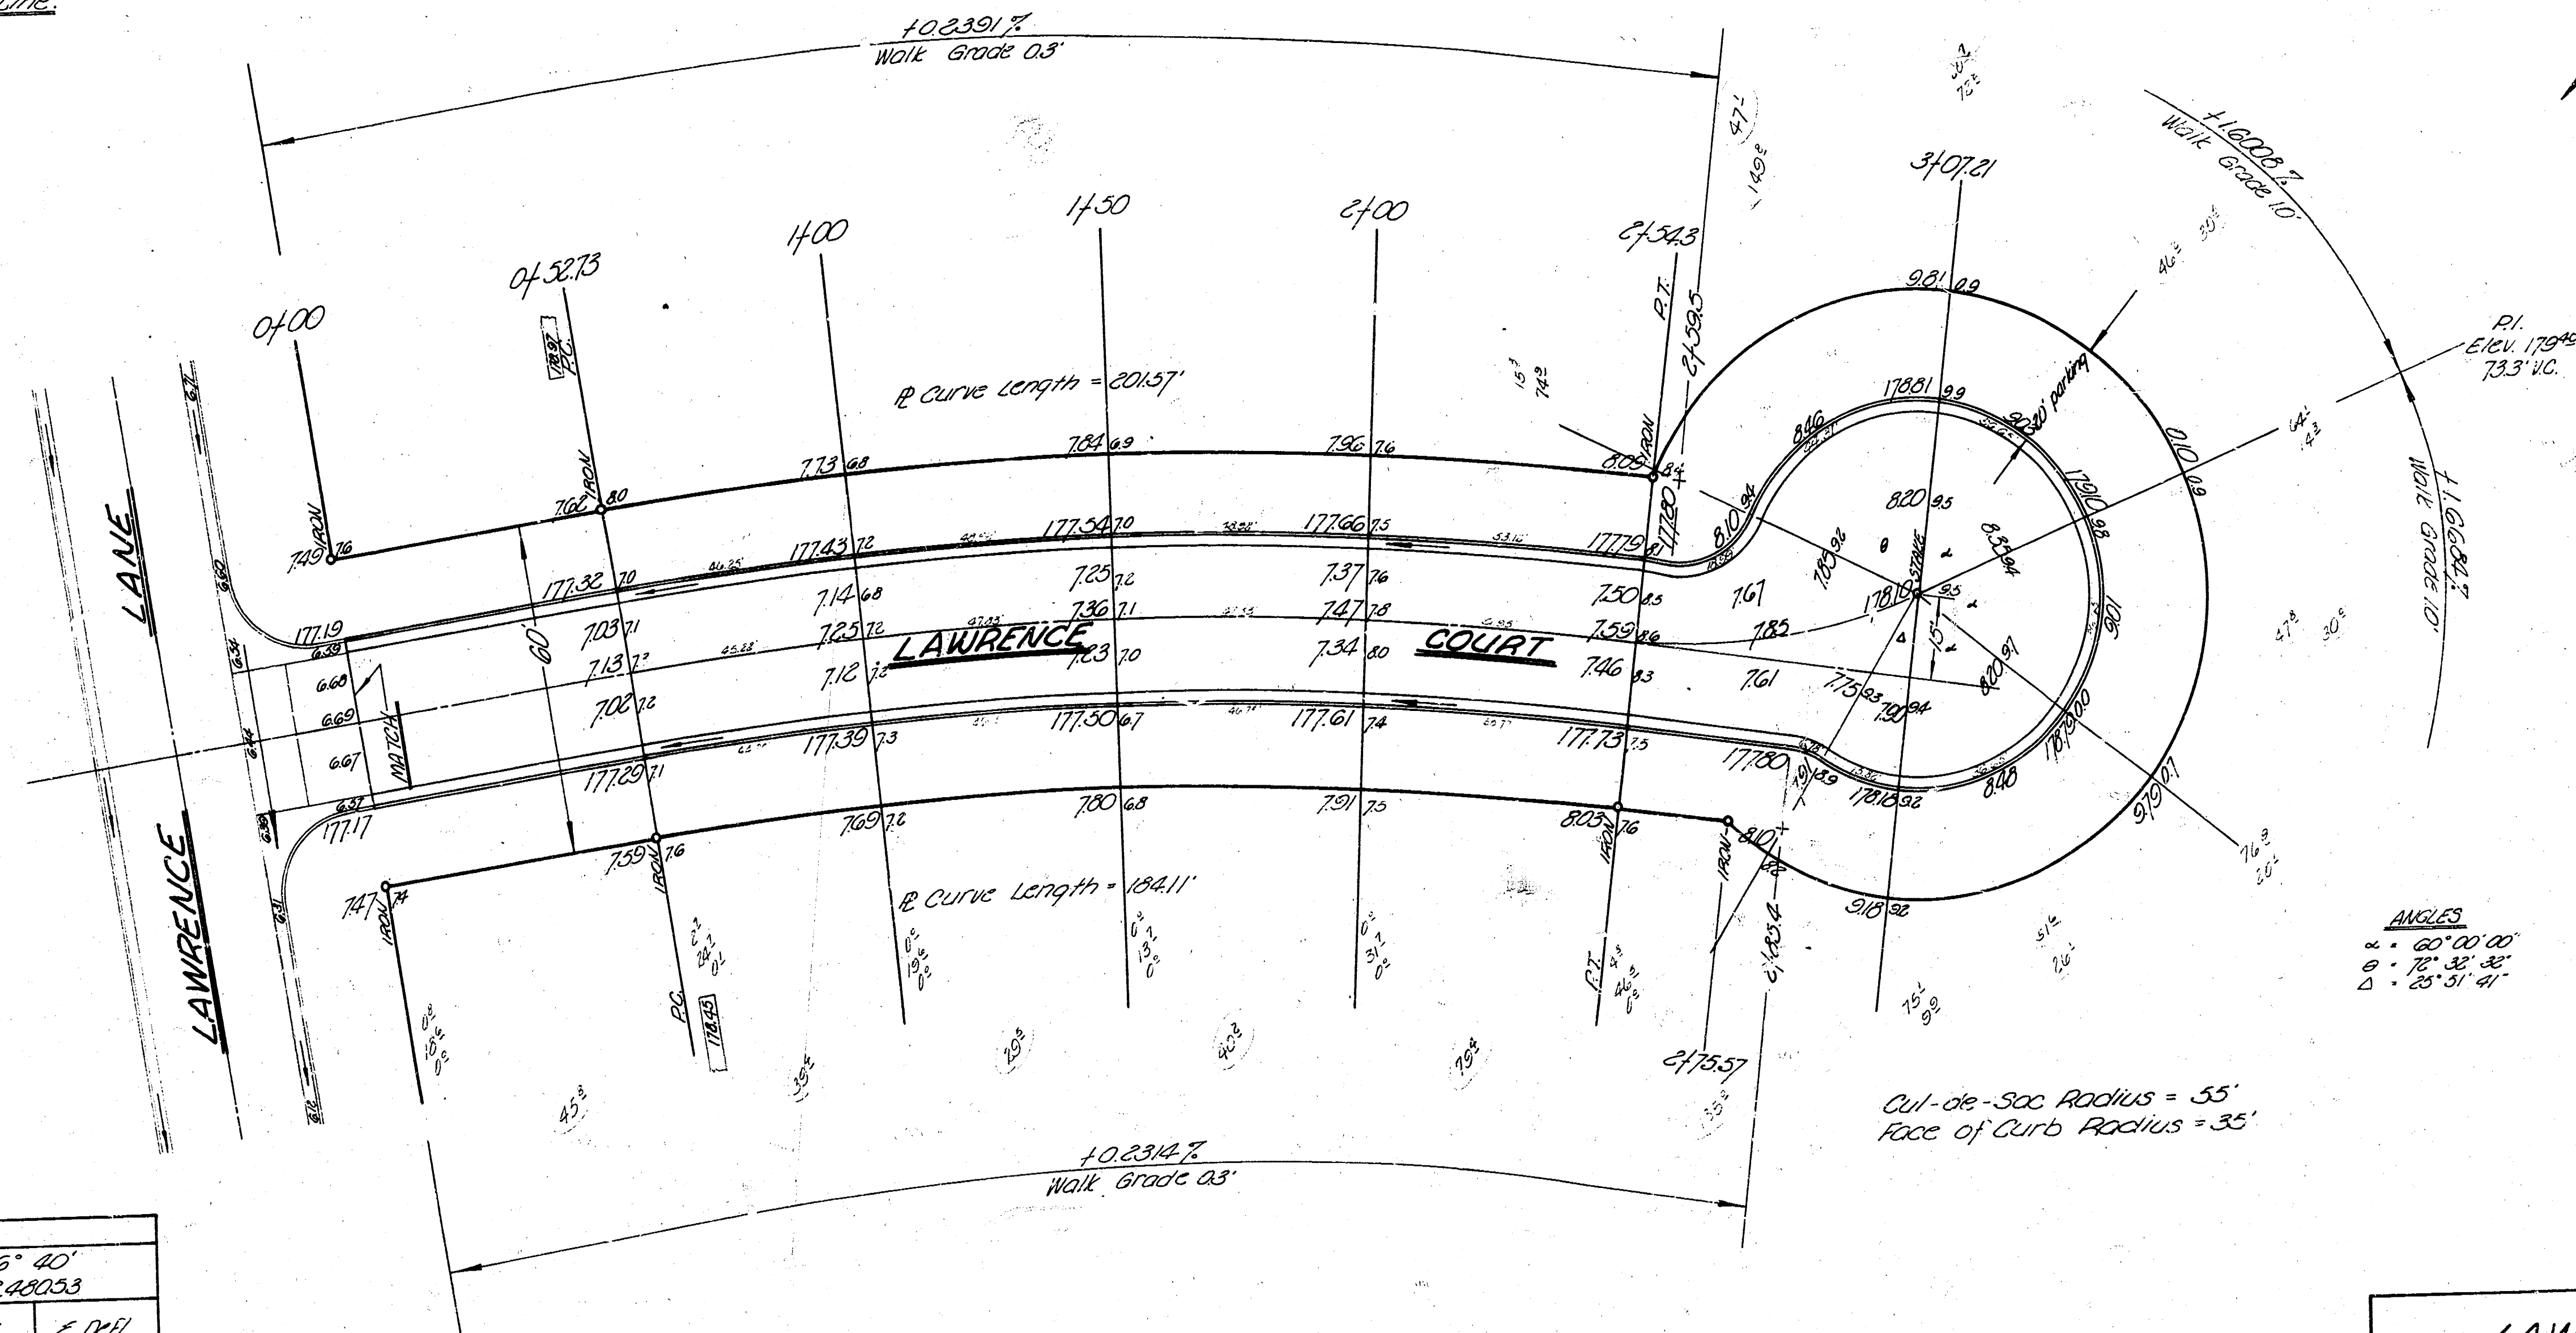


B.M. 18174 N.E. Cor. Cong. Drive bk. Ho. "1082 Armour"
 B.M. 17116 "B" in Ritech Bros. N. of Lawrence Dr. & E. Lawrence Lane
 Baseline & Stationing as North Property Line

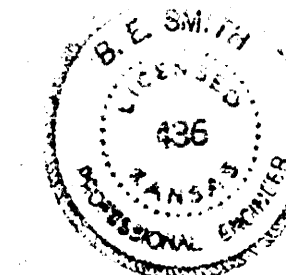

CURVE DATA					
Radius @ M.P. = 692.83		Δ = 16° 40'			
Length of Curve = 201.57		Min. = 2.42033			
Sta.	Alt.	Chord		Defl.	E. Defl.
N. P.	S. P.	N. P.	S. P.		
0+32.7	47.27	47.26	46.70	1° 57' 15.3"	1° 57' 15"
1+30	30.00	49.97	49.47	2° 04' 01.6"	2° 01' 17"
2+00	30.00	49.97	49.47	2° 04' 01.6"	2° 05' 48"
2+57.30	34.30	33.73	32.13	2° 14' 41.6"	2° 20' 00"

EXCAVATION
 798.2
 798.3
 8' 10" C.C.

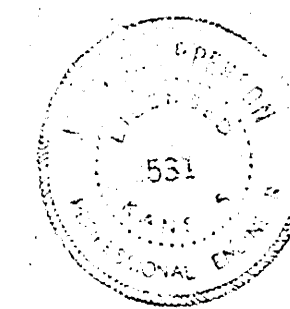


LAWRENCE COURT
 E.L. Lawrence Ln. to 4th St. Cul-de-sac
 26'-2'-30' A.C.
 City of Wichita, Kansas
 B.E. Smith City Engineer
 Date: JULY 1962, Proj. No. C19-143

FILE



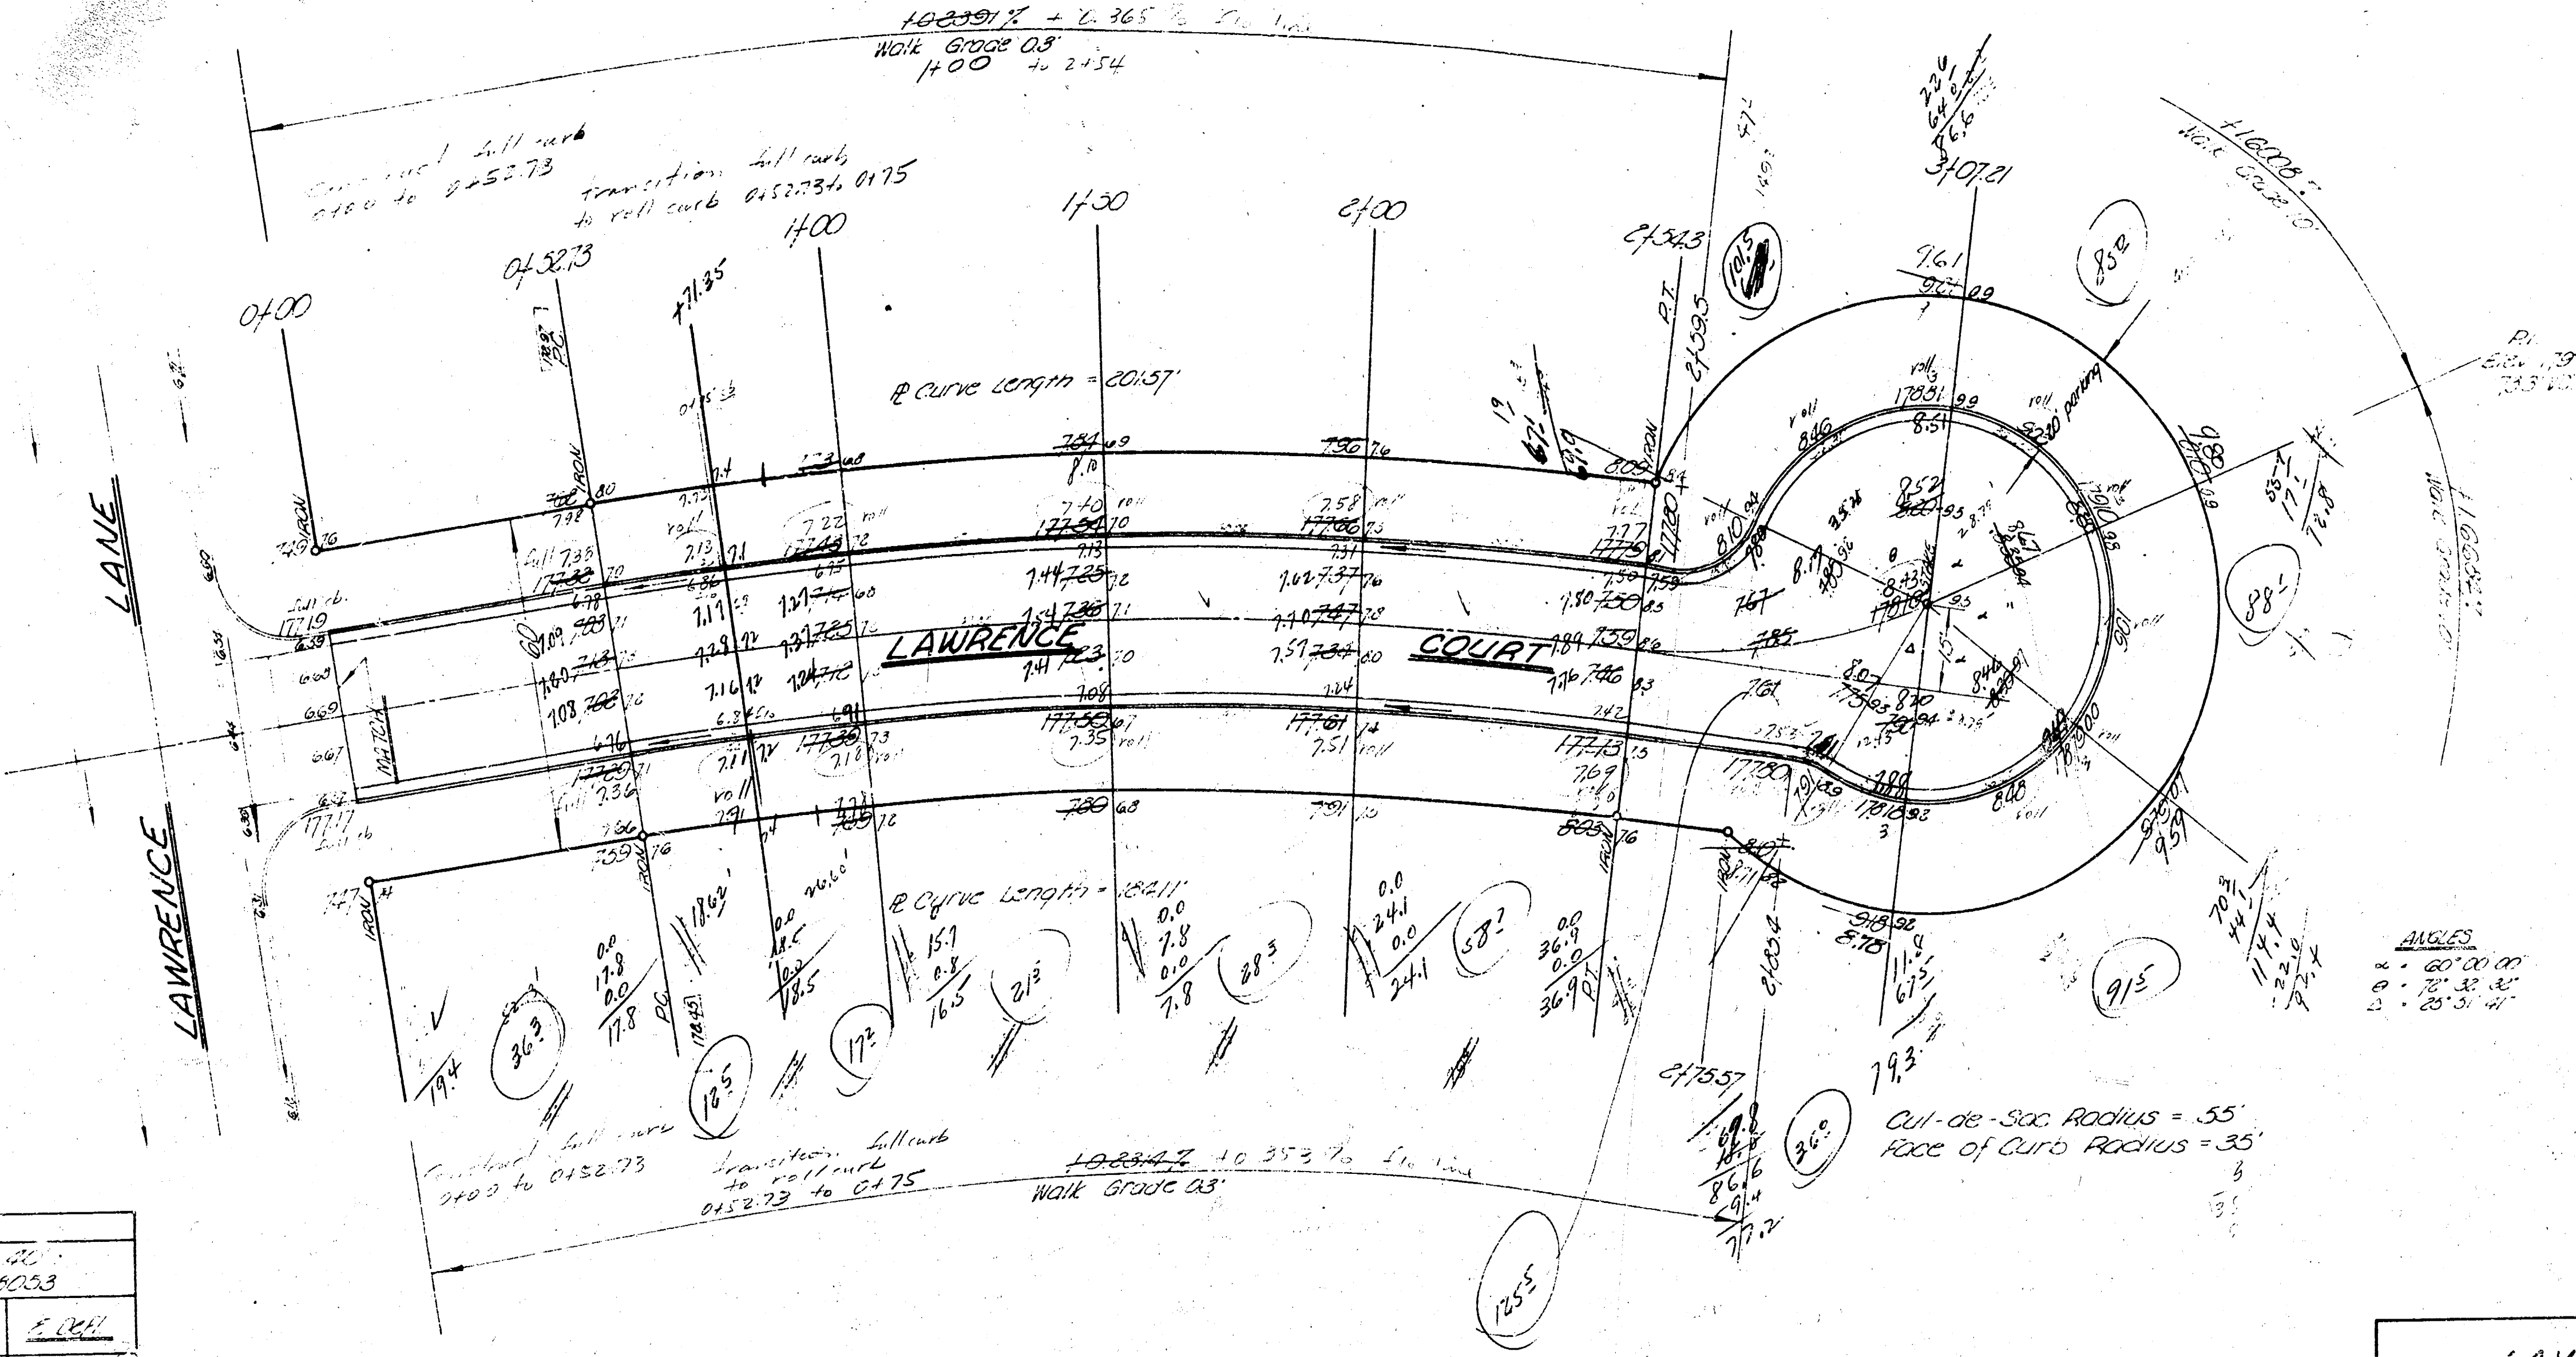

CURVE DATA					




LAWRENCE COURT
 86' - 8' - 30' AC.
 B.E. Smith

