


Paid	10.00
4.2	4.2
3.7	4.2
23.7	26.7
26.0	19.40
22.1	
60.7	64.6
65.9	+10.00 6.50
61.3	71.1
76.1	
25.0	
5.9	
347.4	
+10.00	347.4
227.3	


Totals for Job	
Prp	City
354.3	71.1
163.0	34.6
266.0	52.7
574.6	148.4
577.9	152.3
574.6	
264.7	
2020.1	741.6


Grand Total → 3761.7

1941

6" Crown
7" Carb

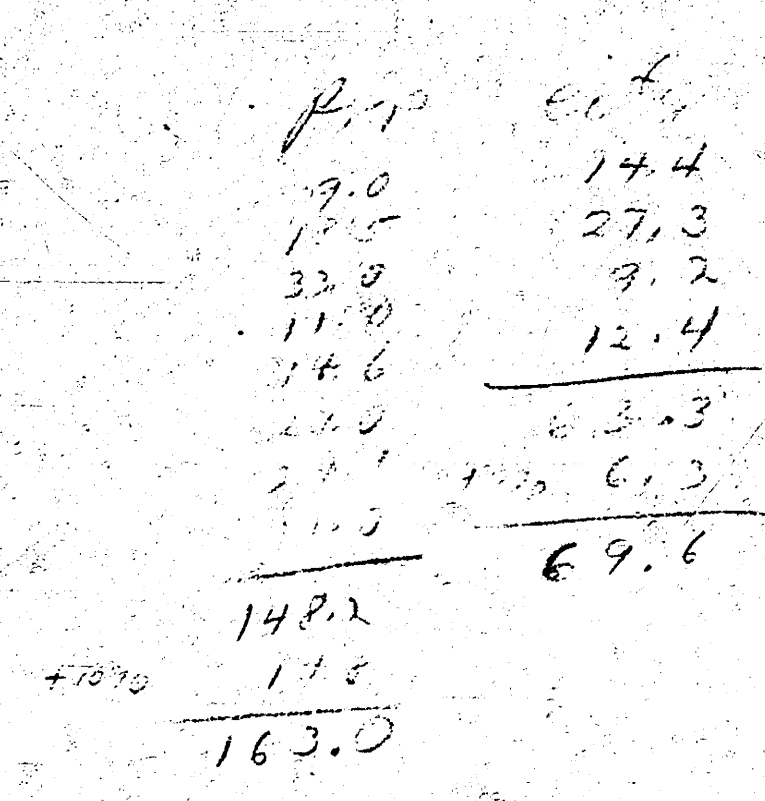


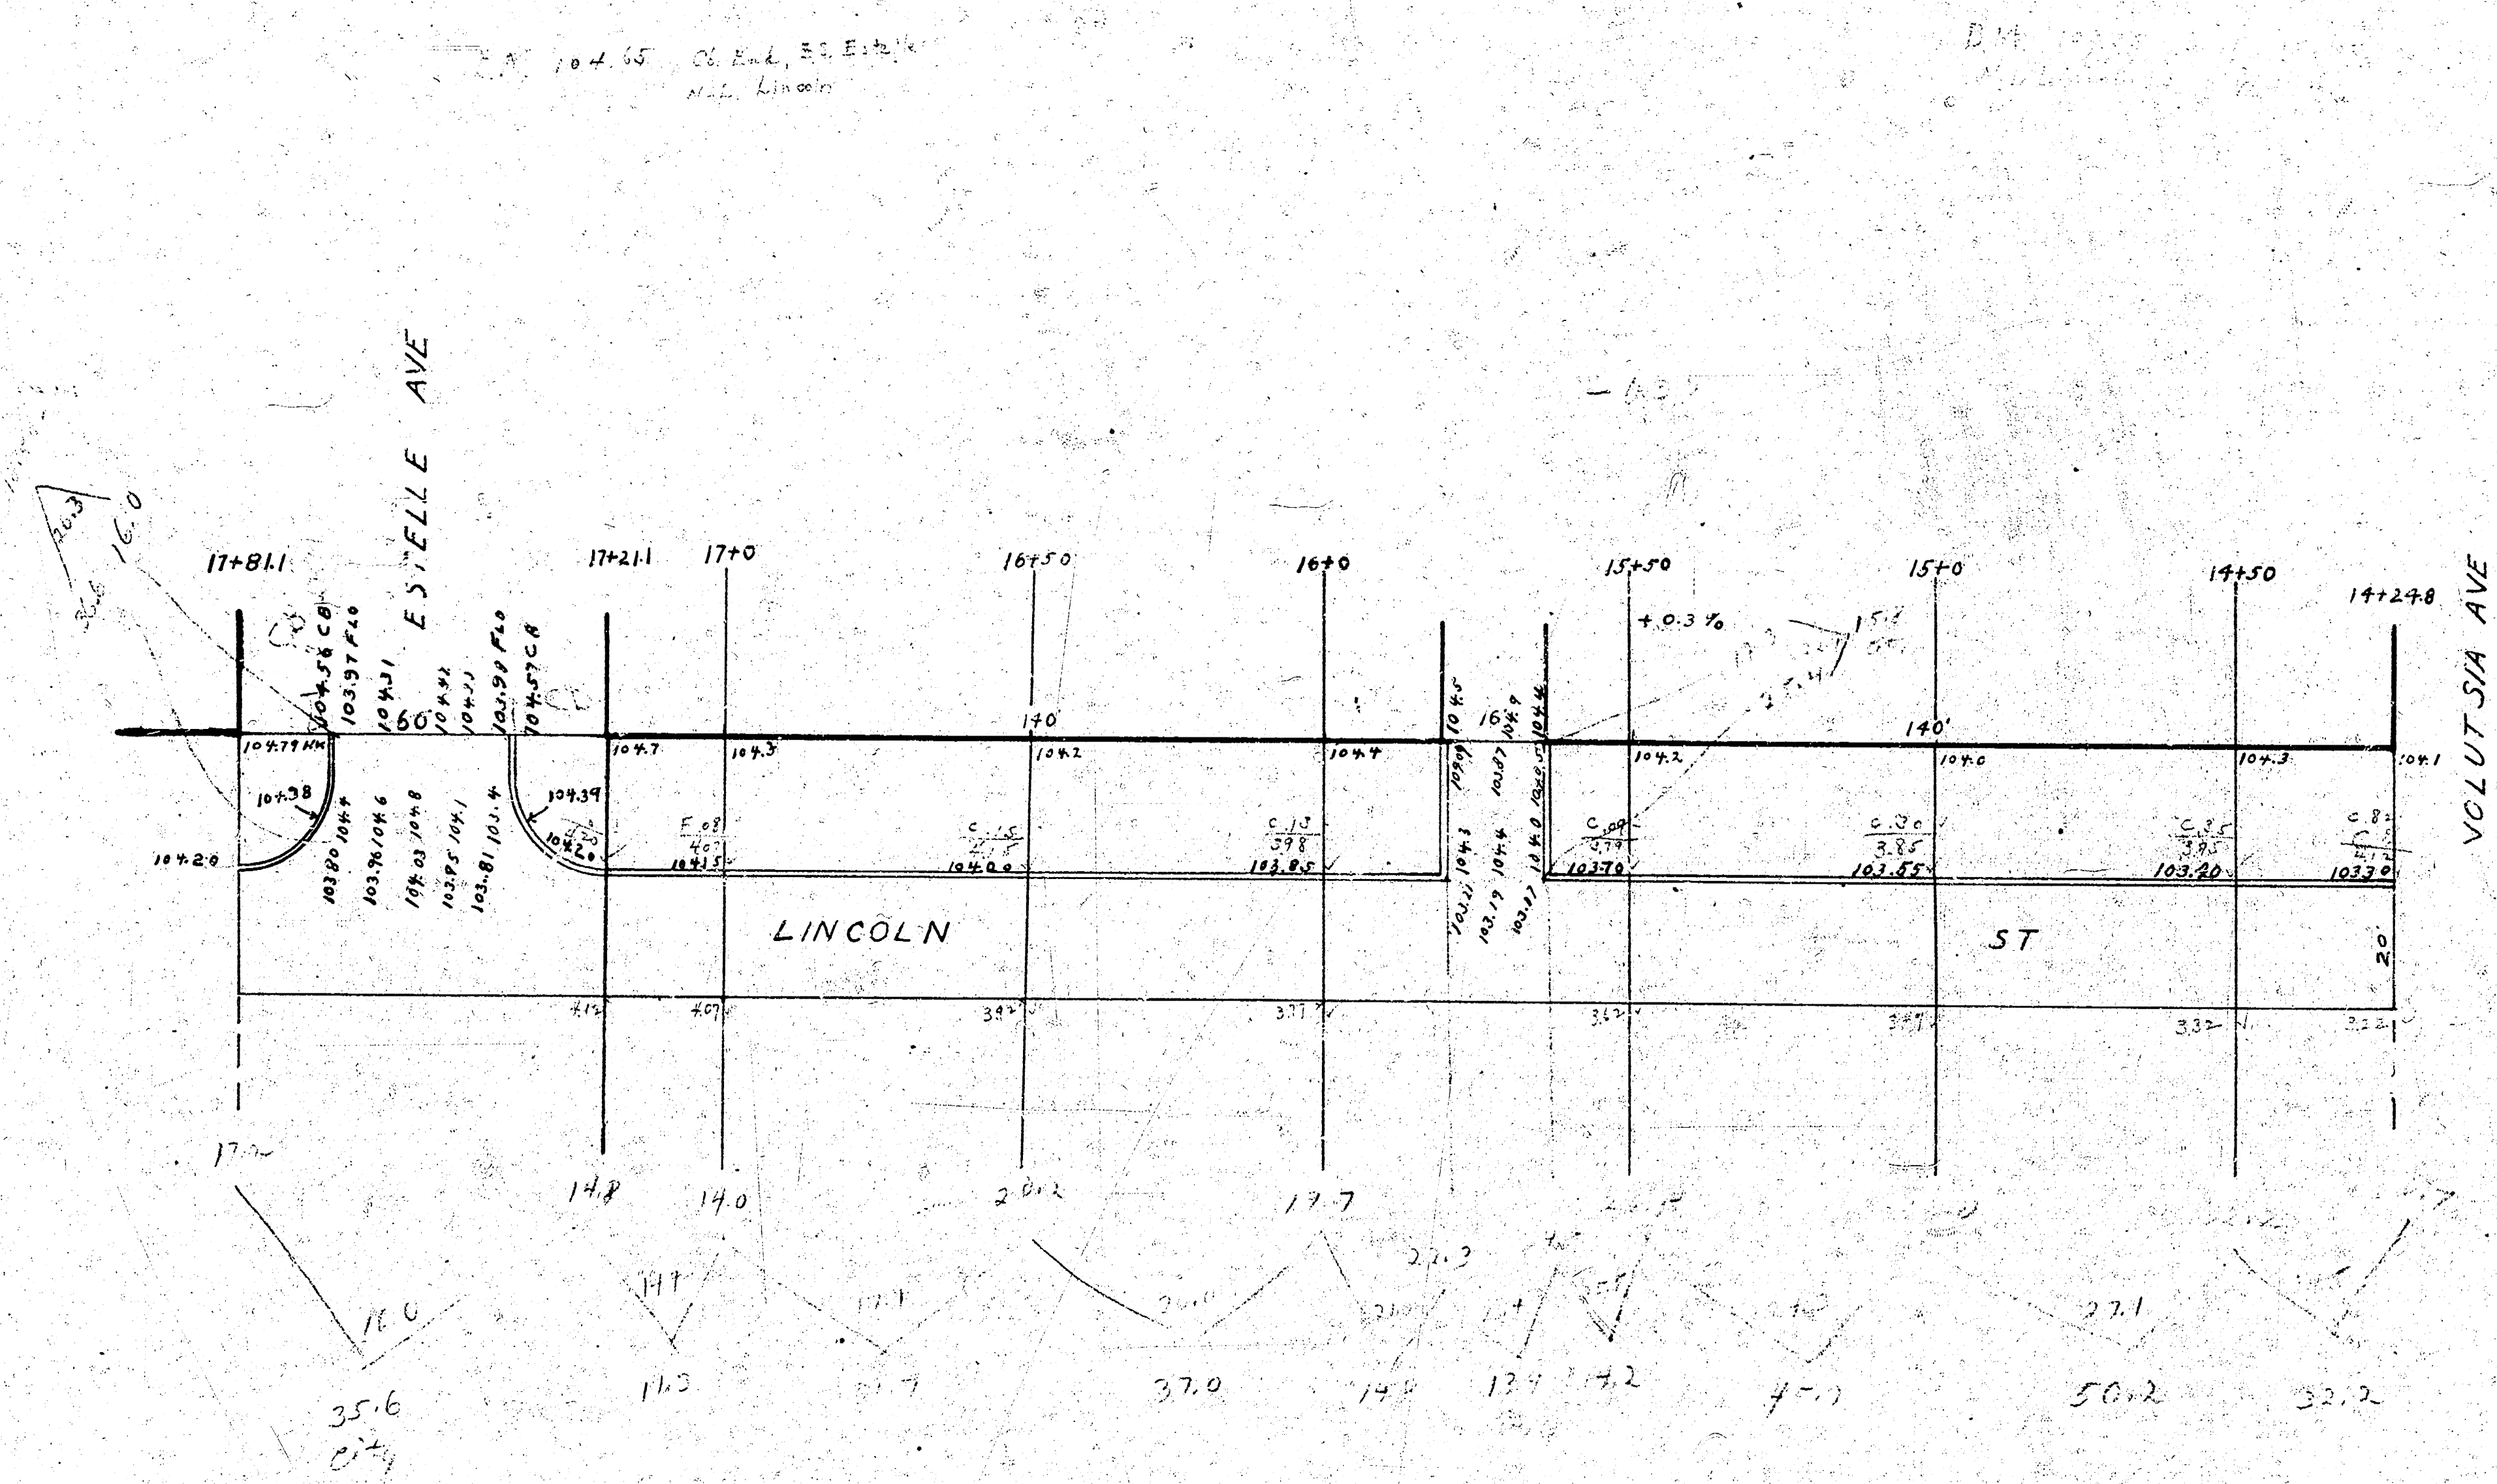

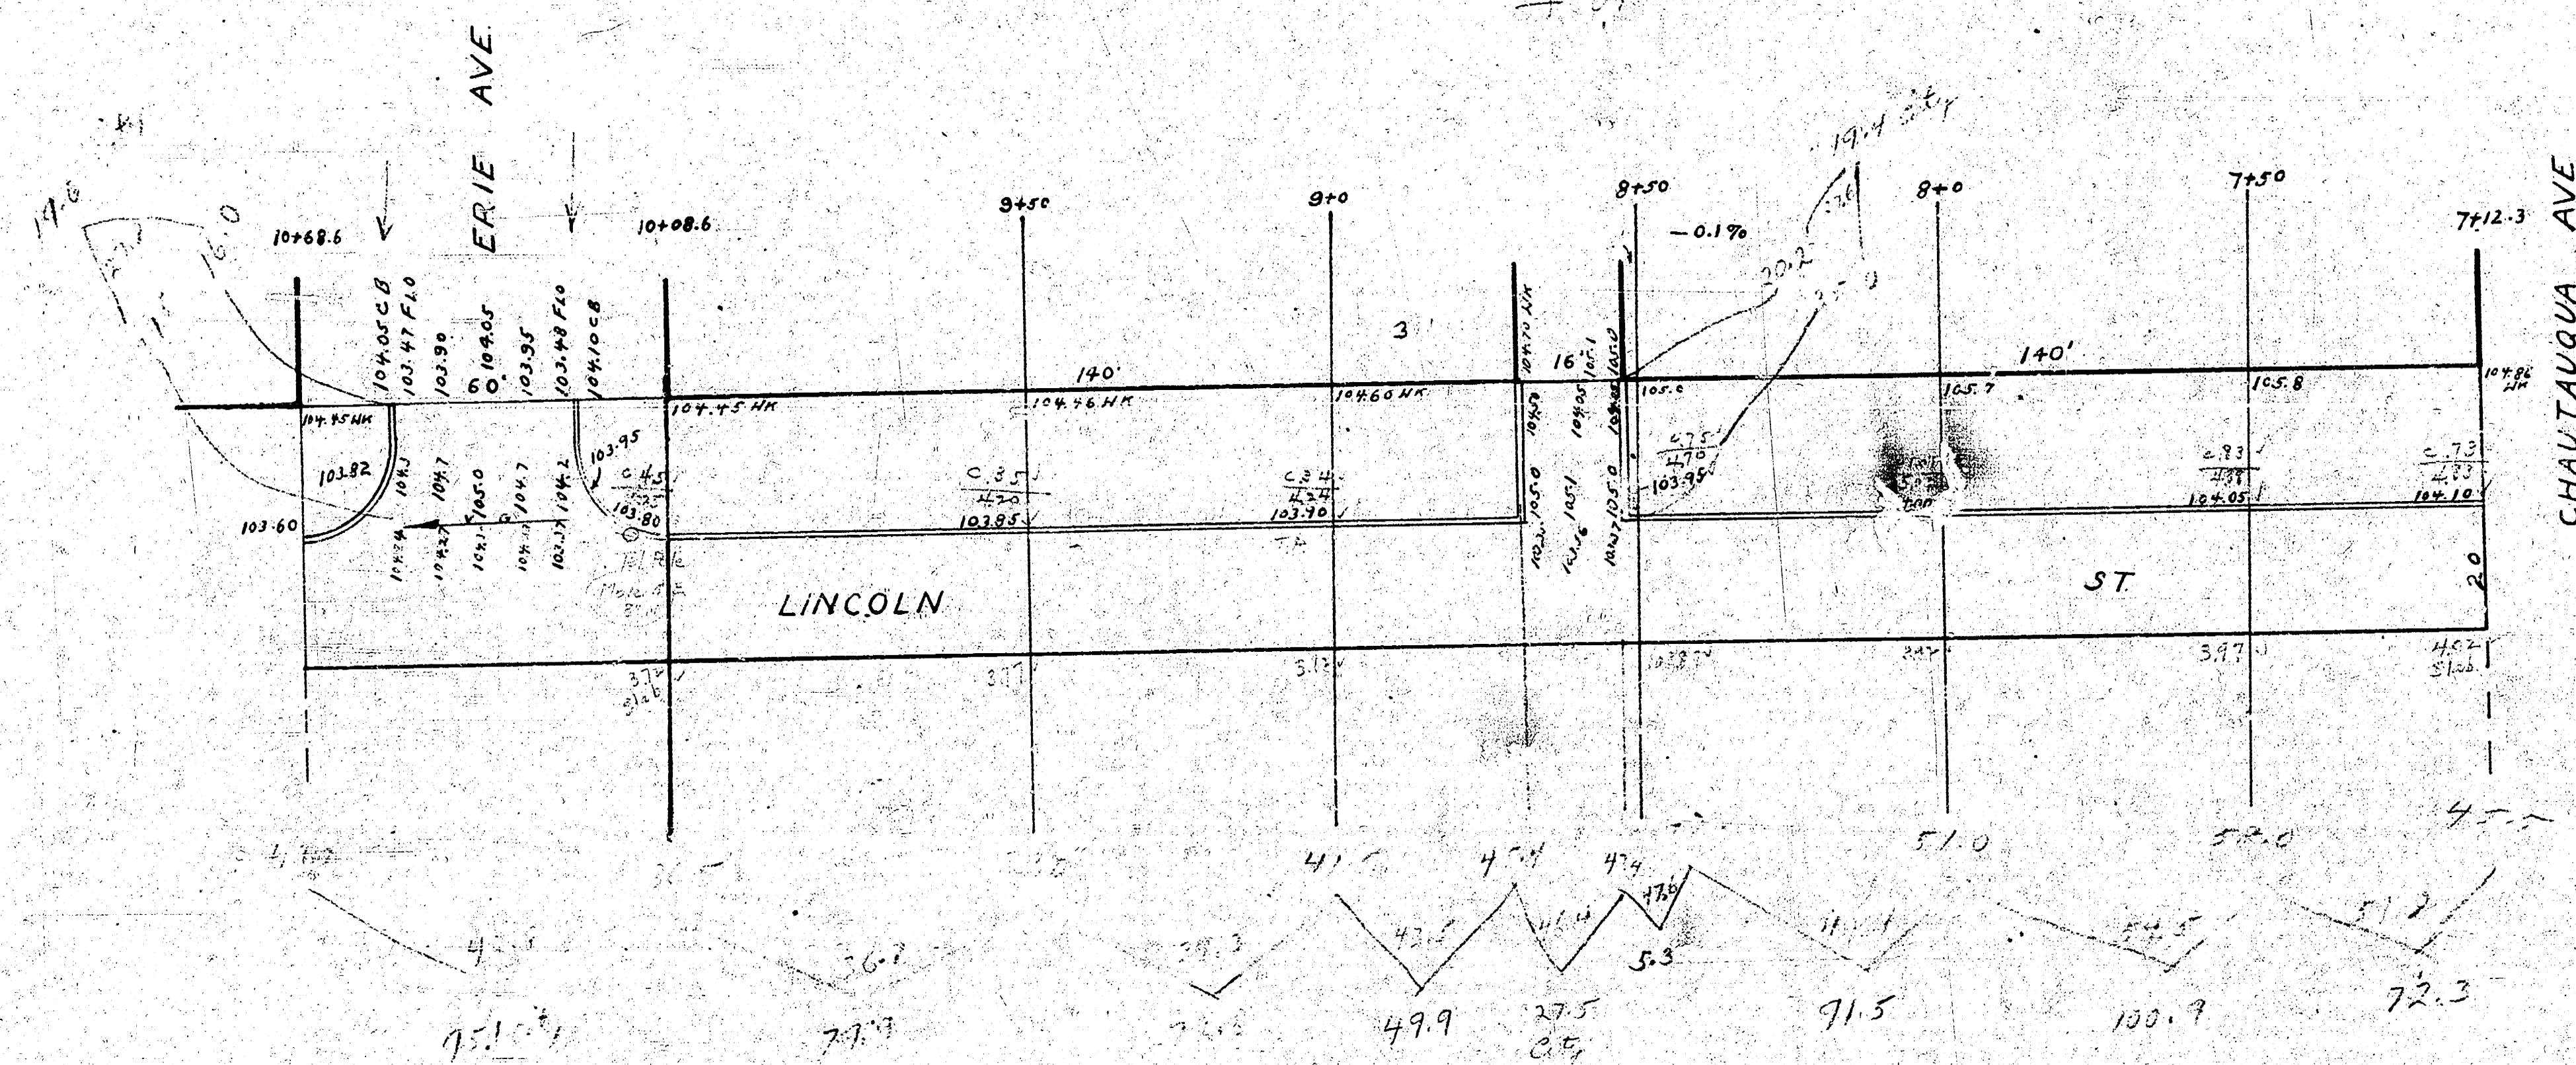


Prop City


73.9	19.6
72.8	95.1
177.7	19.4
51.3	27.5
91.5	161.6
100.7	+0.2 16.2
721.3	177.8
472.6	
47.3	
519.9	

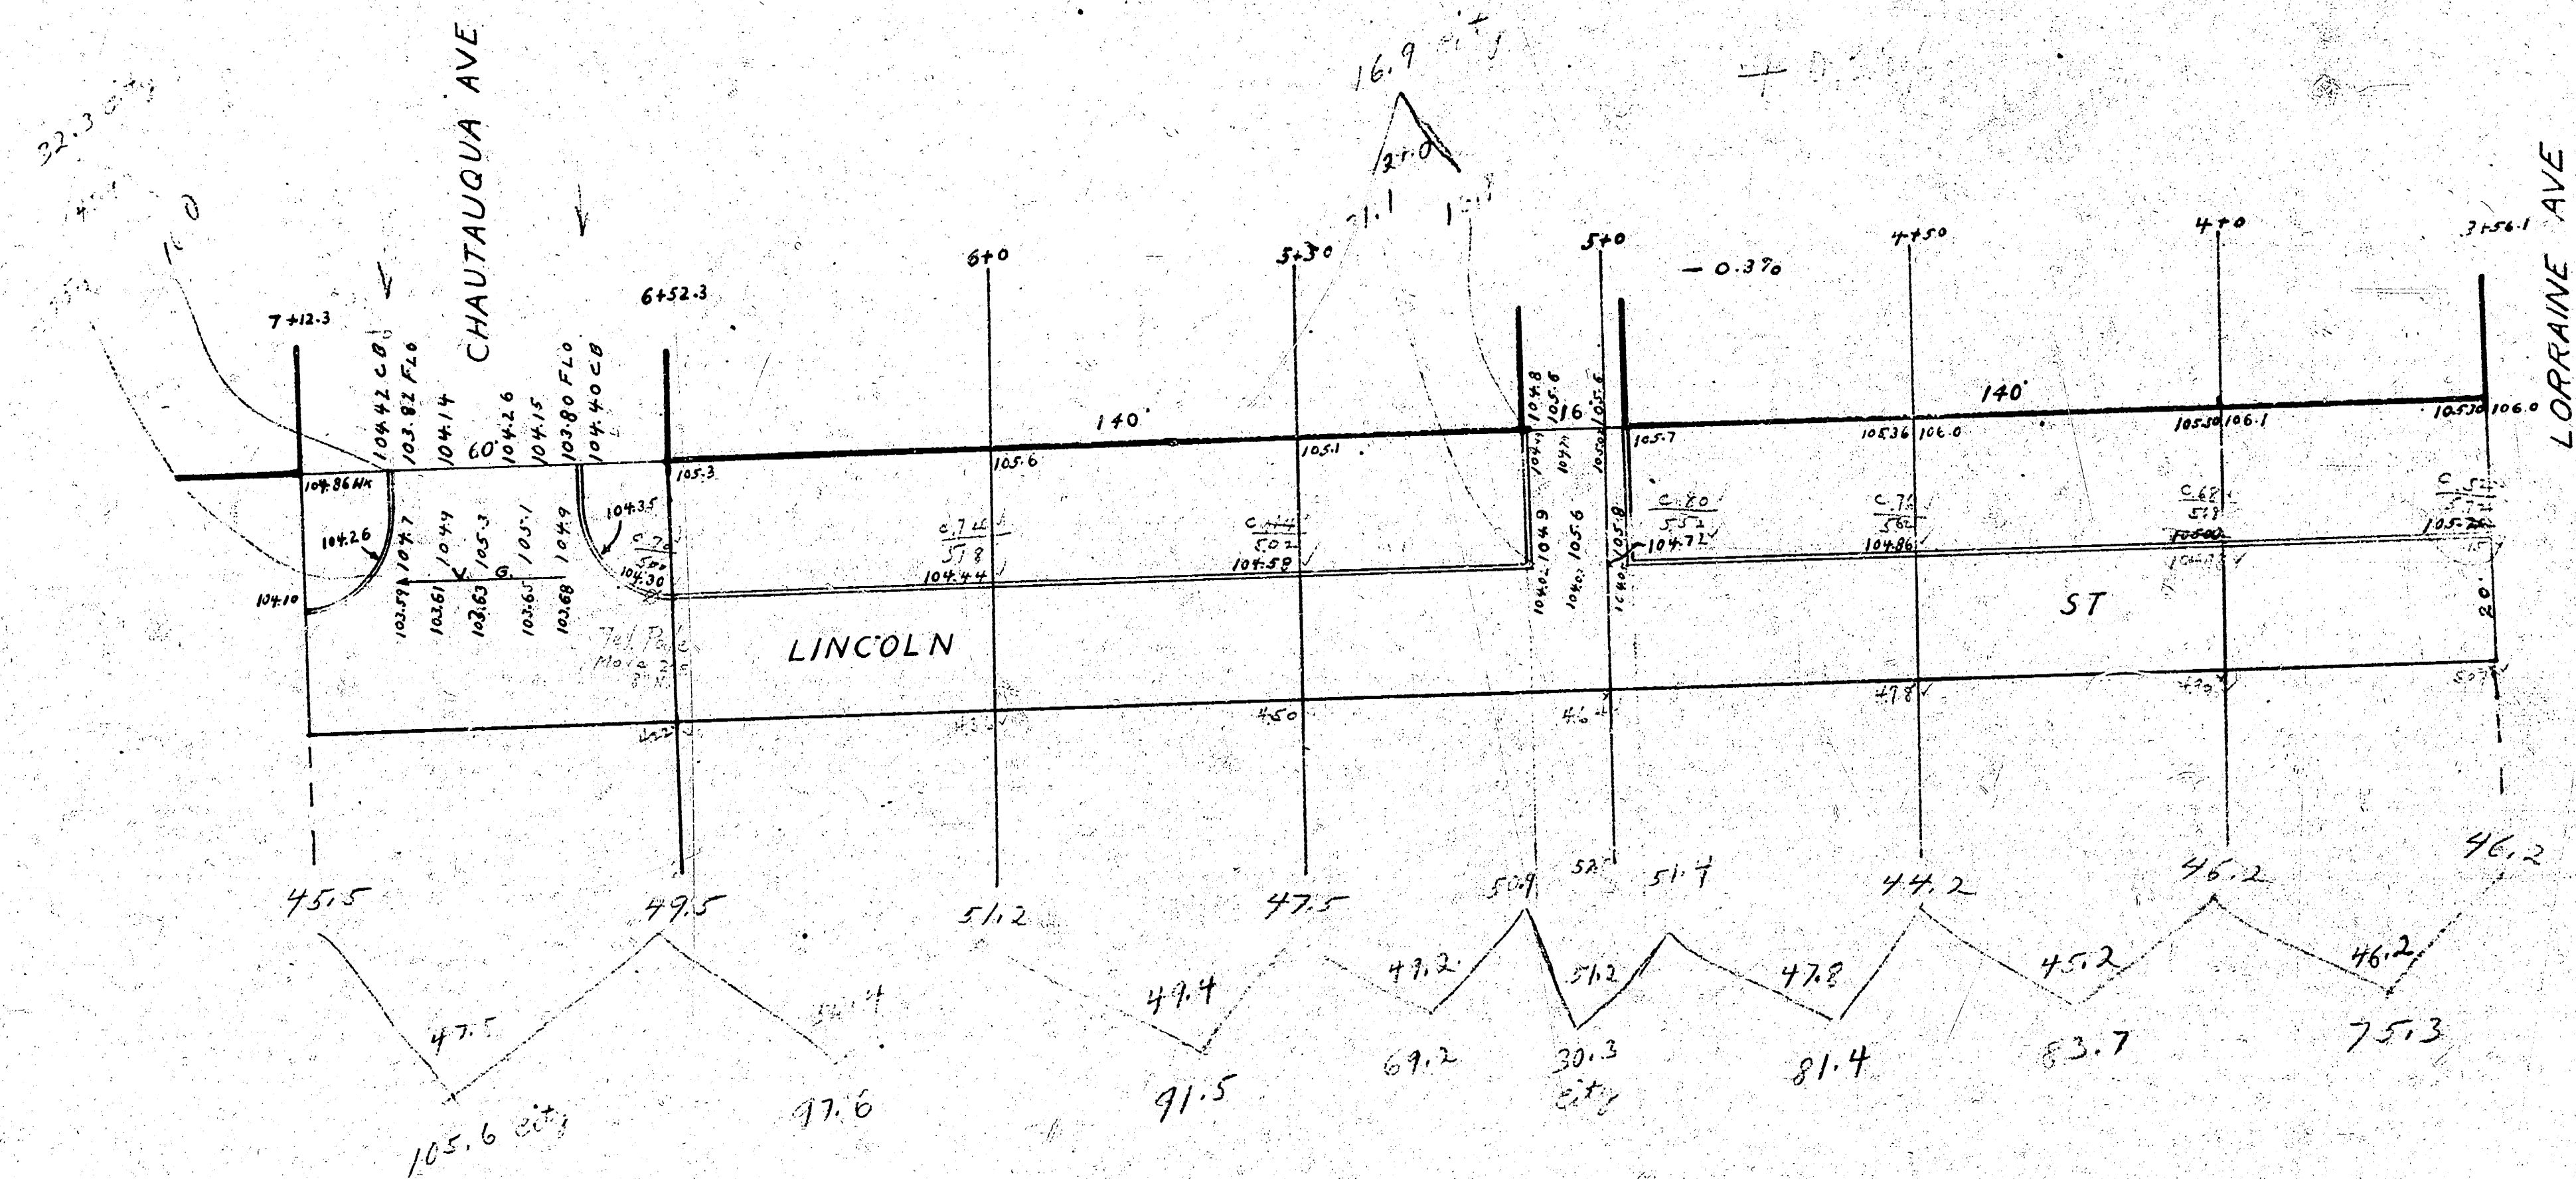

7+12.3	32.3
97.6	32.3
91.5	105.6
87.2	16.9
81.4	30.3
83.7	105.1
75.3	1.5
47.7	303.6
47.7	
47.7	

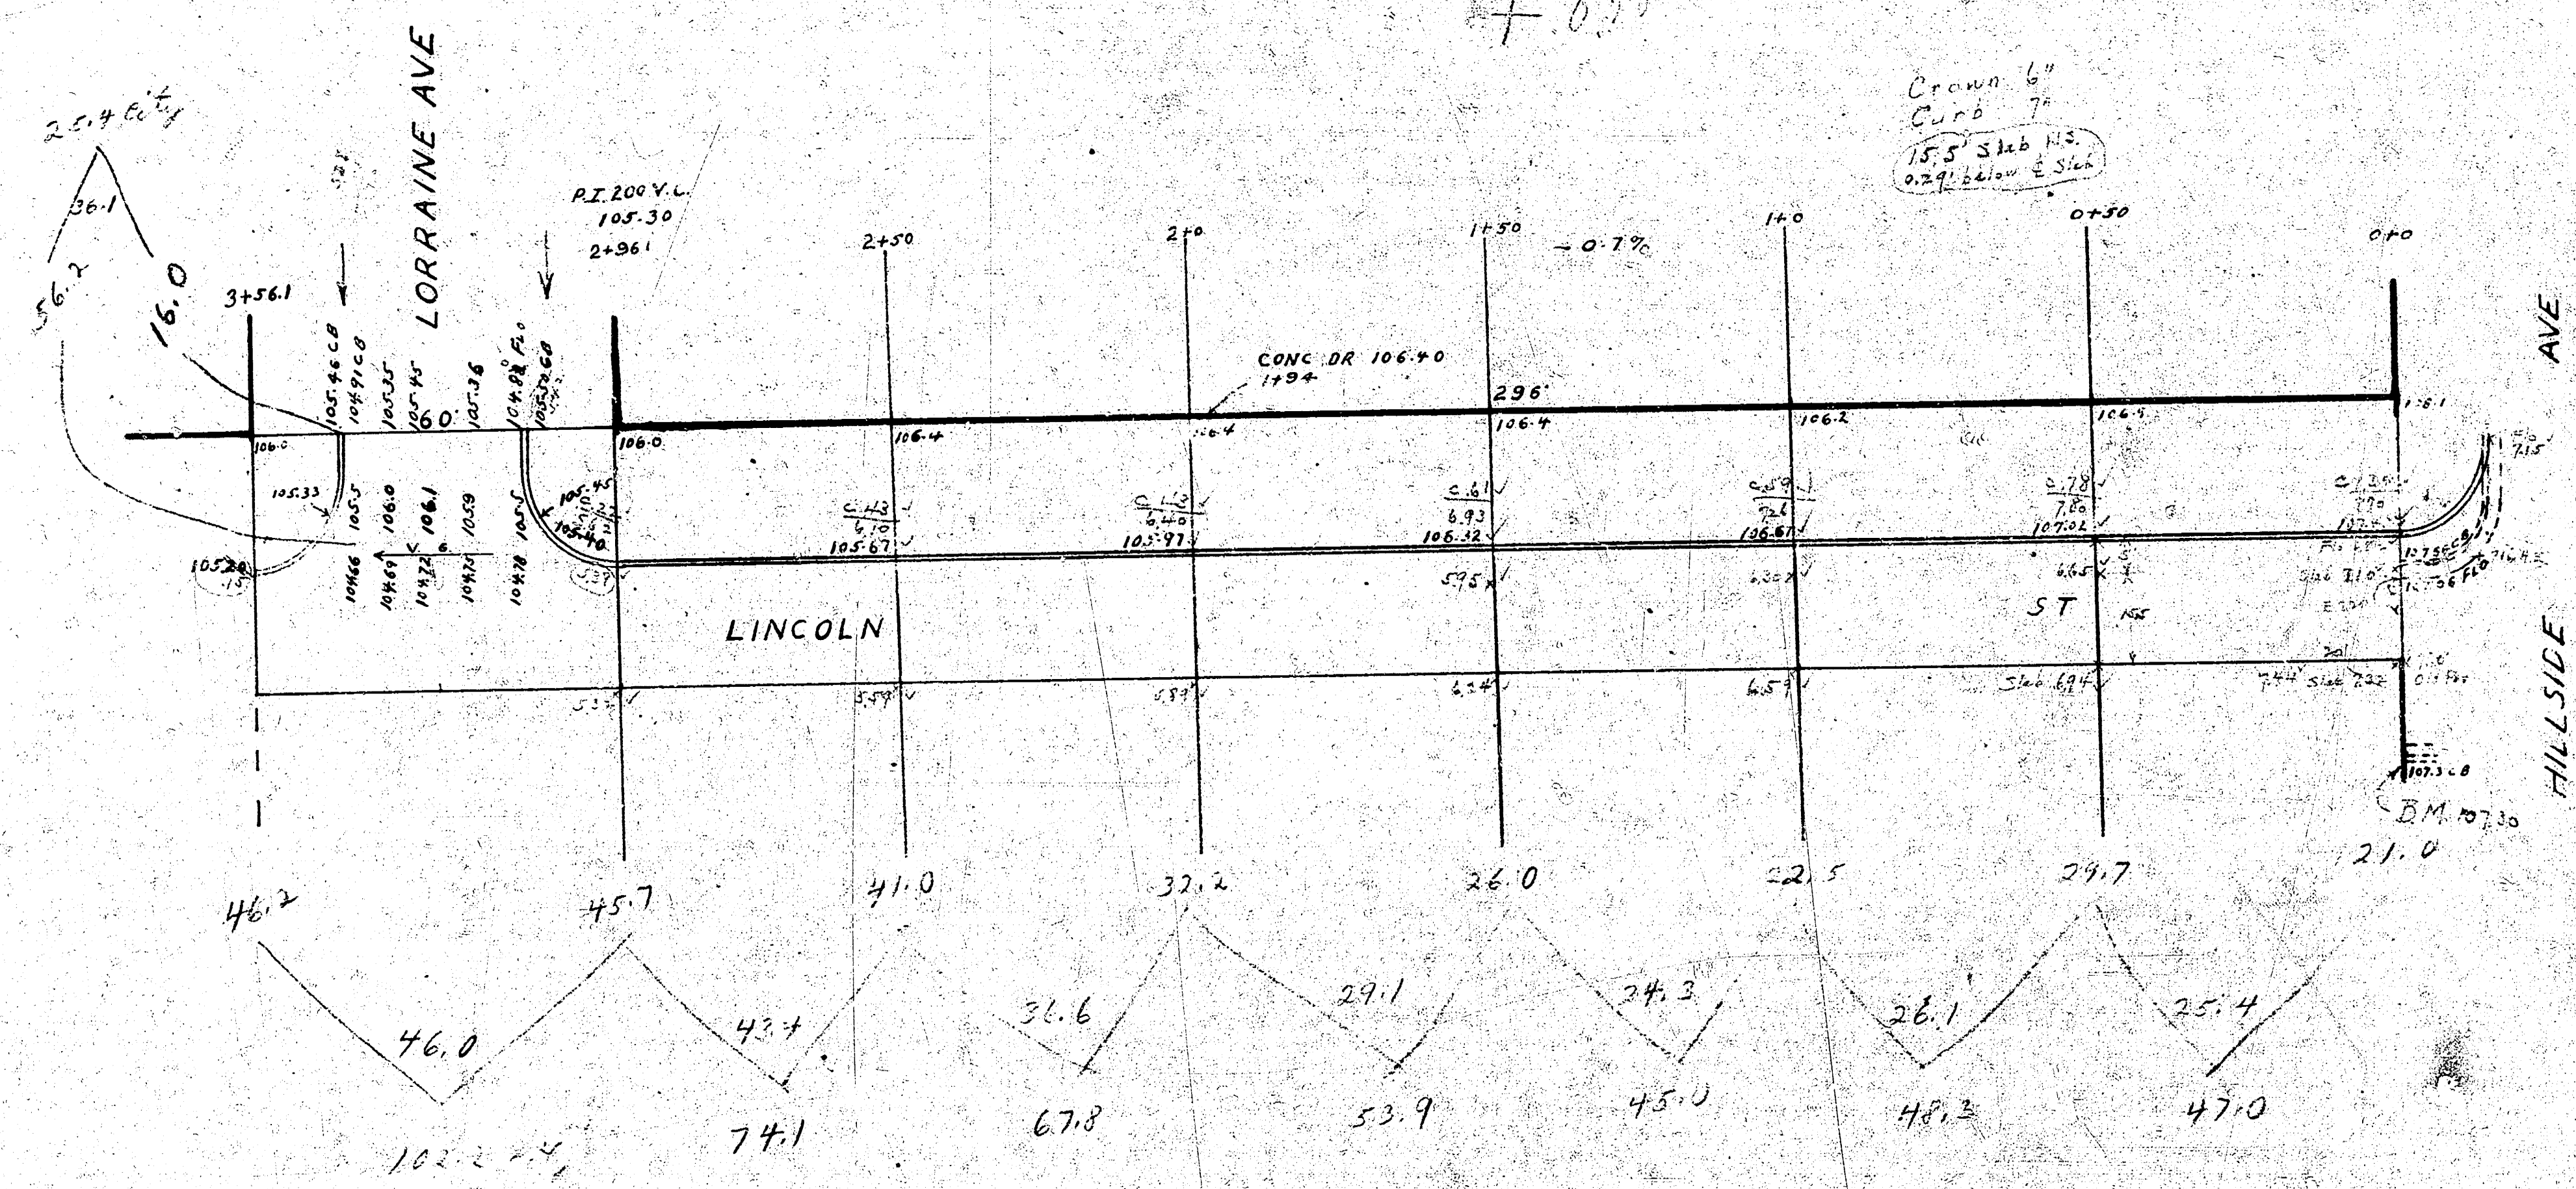

74.1	2.1
67.8	2.1
53.9	12.7
41.0	13.0
48.3	14.7
47.0	14.7
336.1	
+1.7	6
36.7	

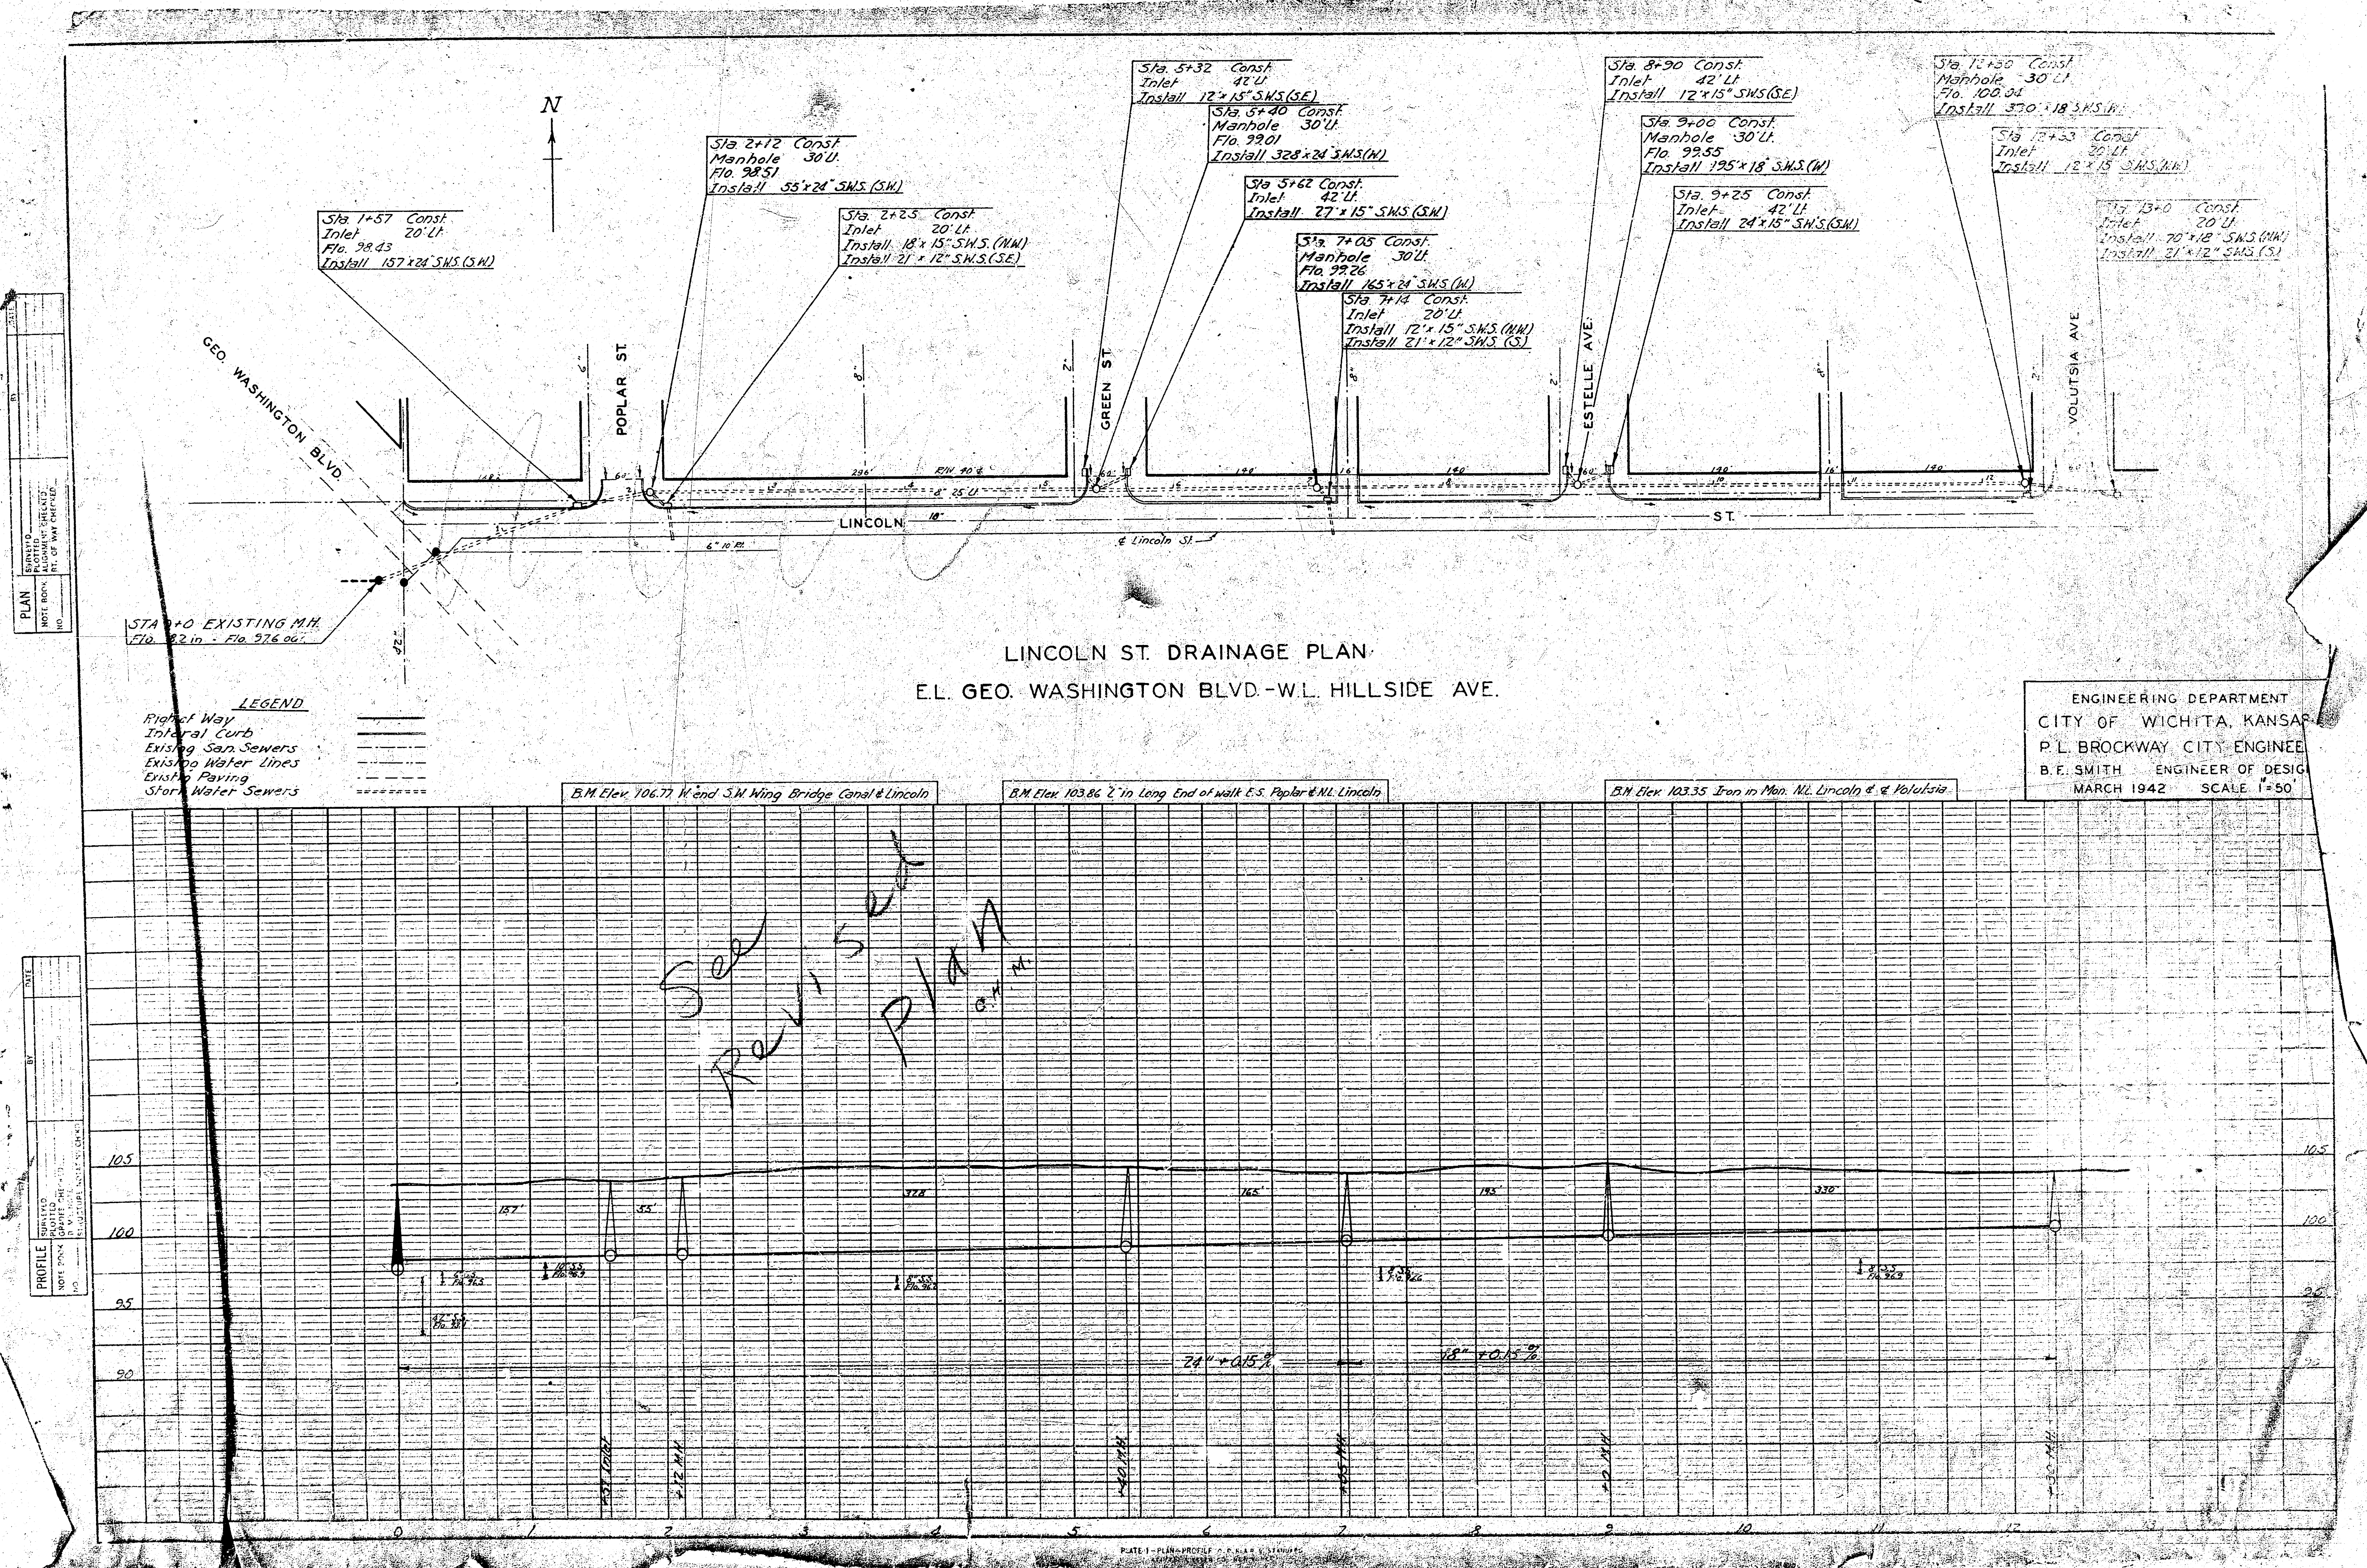

See Revised Plan