


LINCOLN ST. EL. HYDRAULIC TO W.L. GEORGE WASHINGTON BLVD.

THIS SHEET FROM EL. HYDRAULIC TO EL. MINNEAPOLIS 40' CONCRETE INTEGRAL CURB.
 BM. 106.17 Standard SW Lincoln & Hydraulic.
 BM. 106.77 W. and SW. Wing Conc. Bdg. Lincoln & Canal.

Use machine in
 & approx equal width
 strips of 10' each
 with 1/2" gaps
 on top of sheet

East of Canal
 Right 20' ft. in
 type B curb
 should be to
 center of roadway
 and 1/2" gap

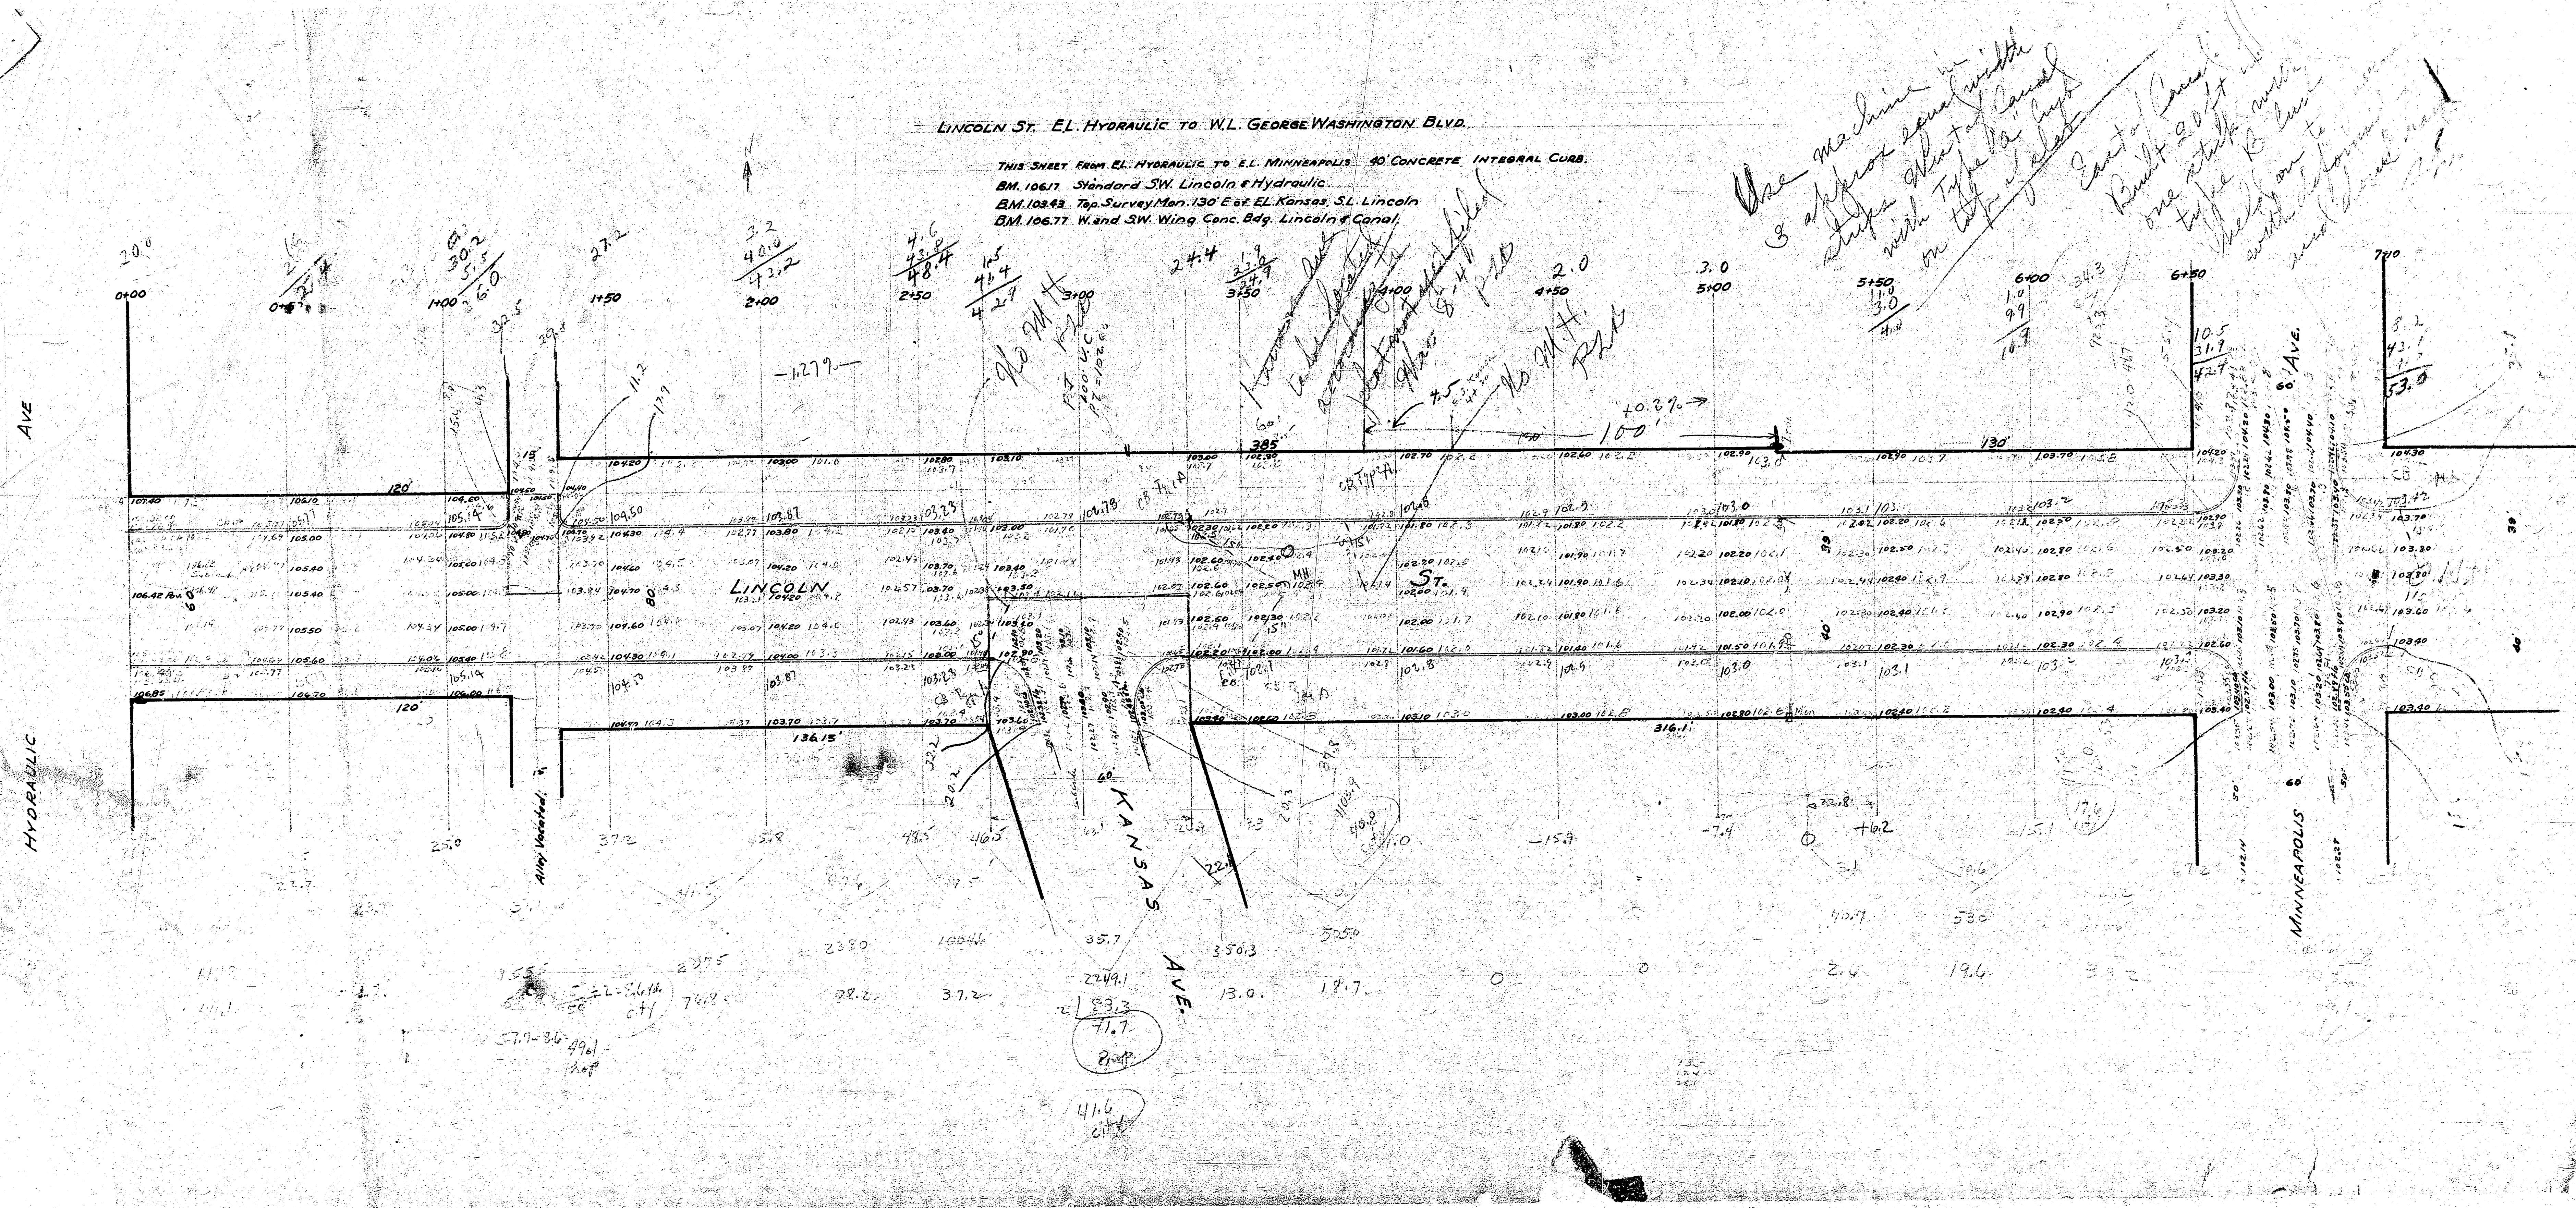

[illegible]

