



Trowel Finish

a

C.L. MARKER DETAIL
NO SCALE

WHERE CURBS IN THE SAME SECTION
ARE AT DIFFERENT ELEVATIONS USE
ELEVATION SHOWN ON PLAN FOR
CONSTRUCTION JOINT.



B.M. 10553 "B" in Burns, W.S. Info., S.E. Ida & Lincoln
 B.M. 10449 Standard Washington & Lincoln
 B.M. 10446 N.E. cor. R.R. sub light base S.S. Lincoln, 100' W of Masley
 B.M. 10563 "K" in Keeler, c. W. S. (E.S. of S.L.) (S.E. Santa Fe & Lincoln)
 B.M. 10676 "M" in Martin I.N.E. of N.E. cor. Emporia & Lincoln

Base Lines - 28' x 1/2 S. of 1/4 Section Line

Total Fill	
Prop	City
0	x-sect. 7.7
	Plans 26.2
	110% 27.9
	30.7 cu. yds.


Total Excav - Gen.	
Prop	City
0	x-sect. 40.7
	Plans 23.2
	110% 27.1
	298.5 cu. yds.

Total Excav - Hand	
Prop	City
0	71 cu. yd.
+3% 2	73 cu. yd.

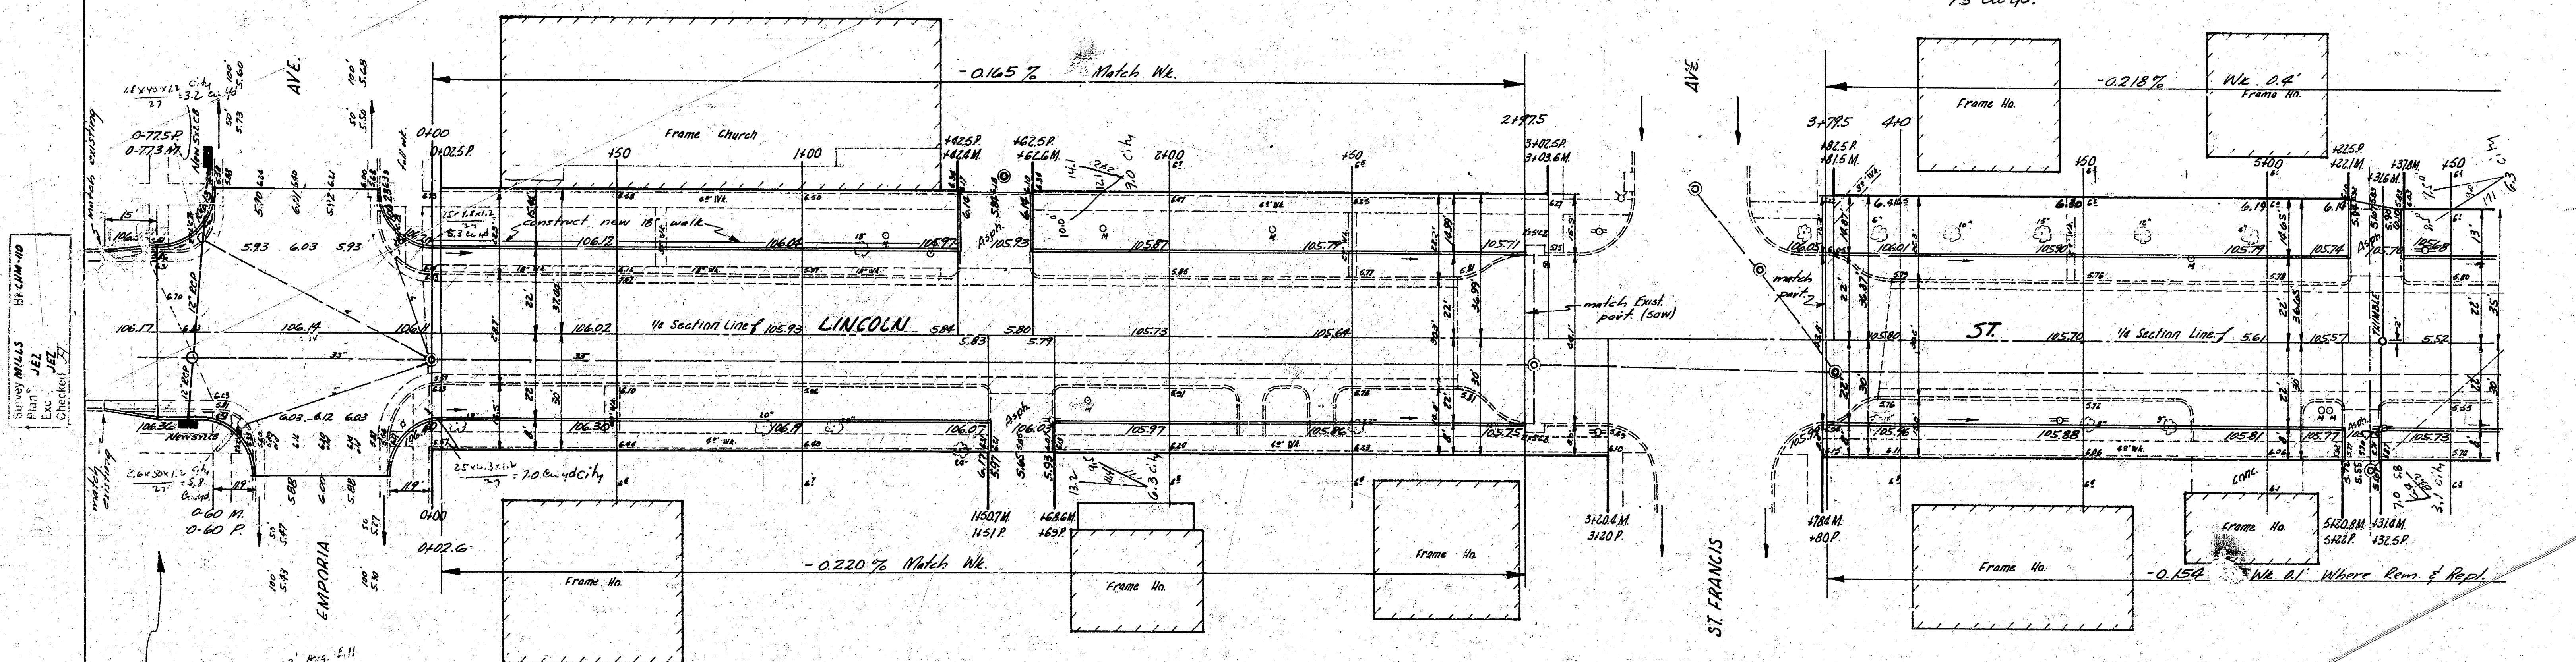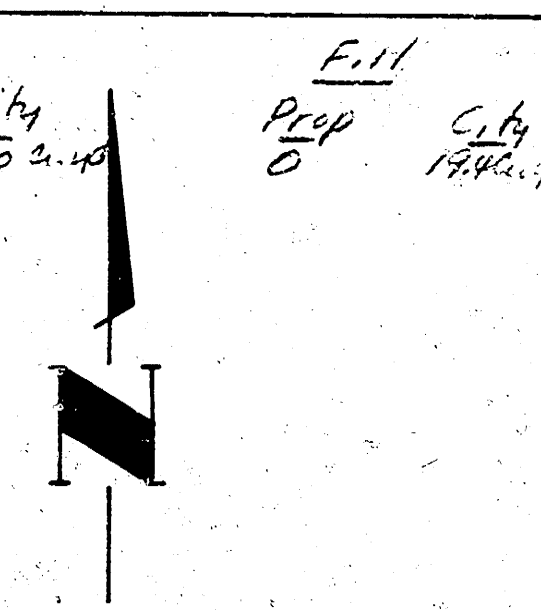



12' x 12' fill City
 1/4 Section Line
 Intersection

NOTE: Remove asphalt surface
 approx. 30' west of 0.775 to reduce
 crown & match new grade of 0.775
 with asphalt back-up. Replace base
 removed with new conc. base.
 Remove approx. 15' of brick part
 north of south from intersection to
 install asphalt back-up.

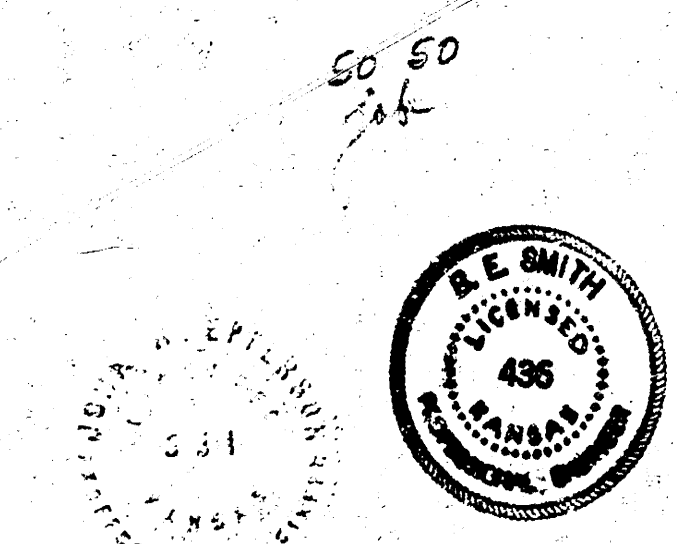


LINCOLN ST.
 W.L. EMPORIA - W.L. IDA
 48'-8" CONC. & CB.
 CITY OF WICHITA, KANS.
 B.E. SMITH CITY ENGINEER
 JULY 1956 PROJ. C16-15

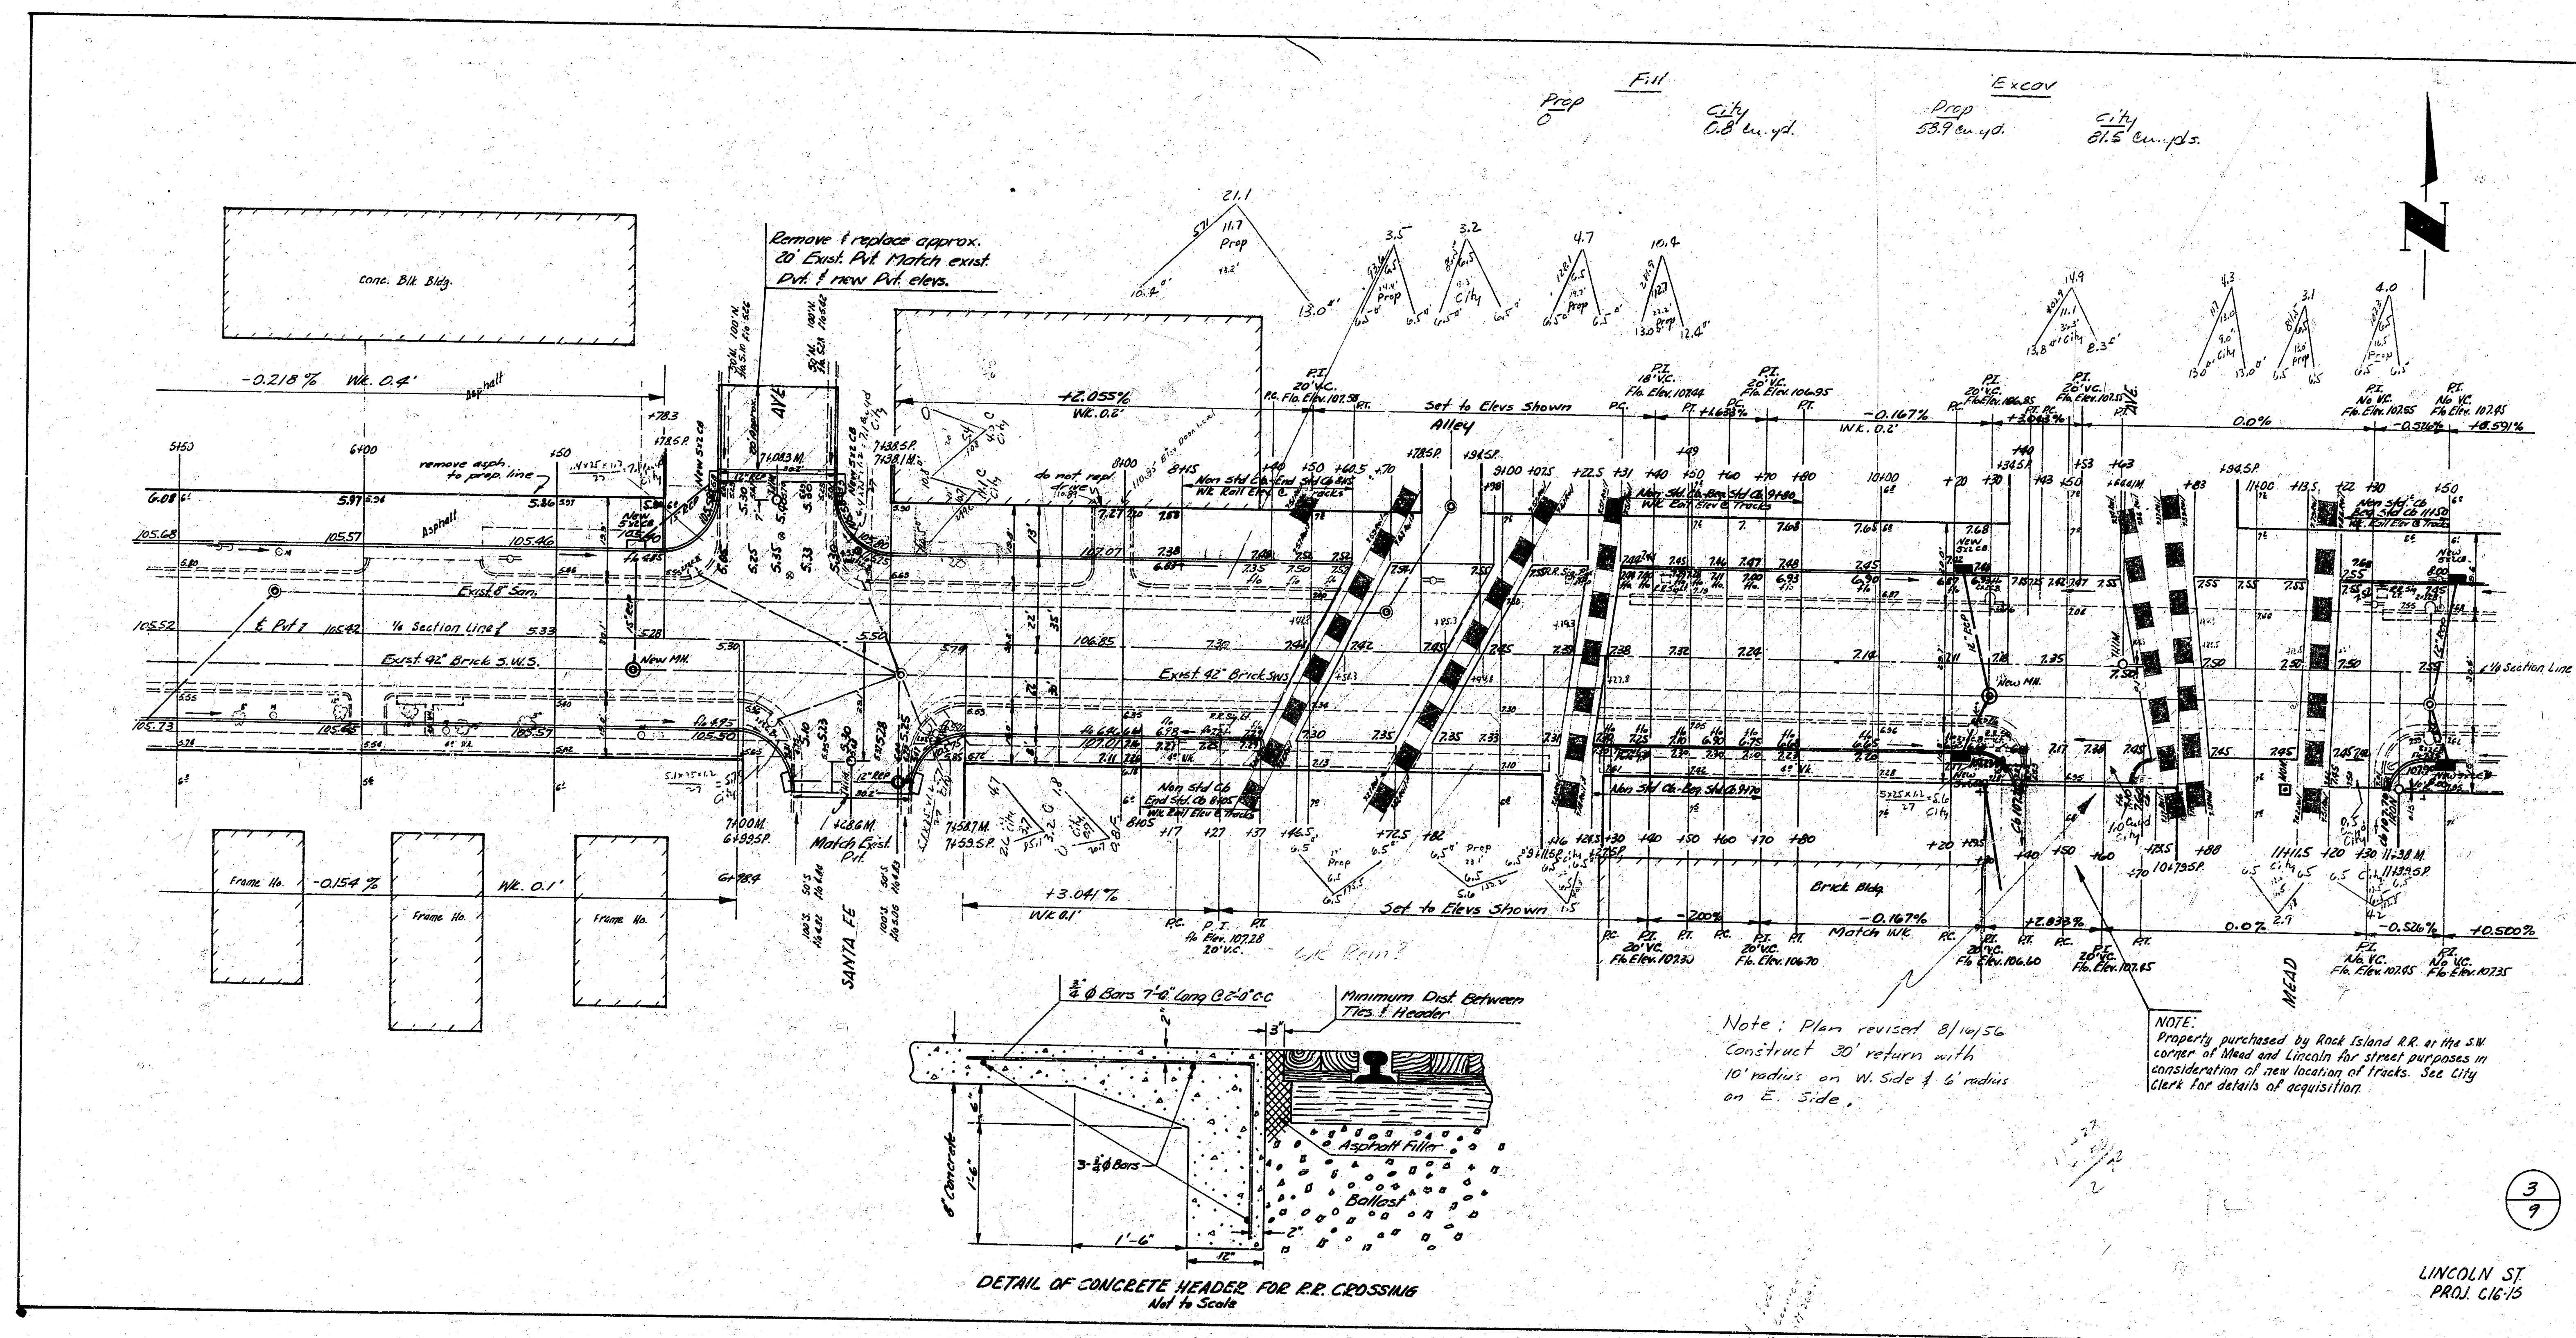

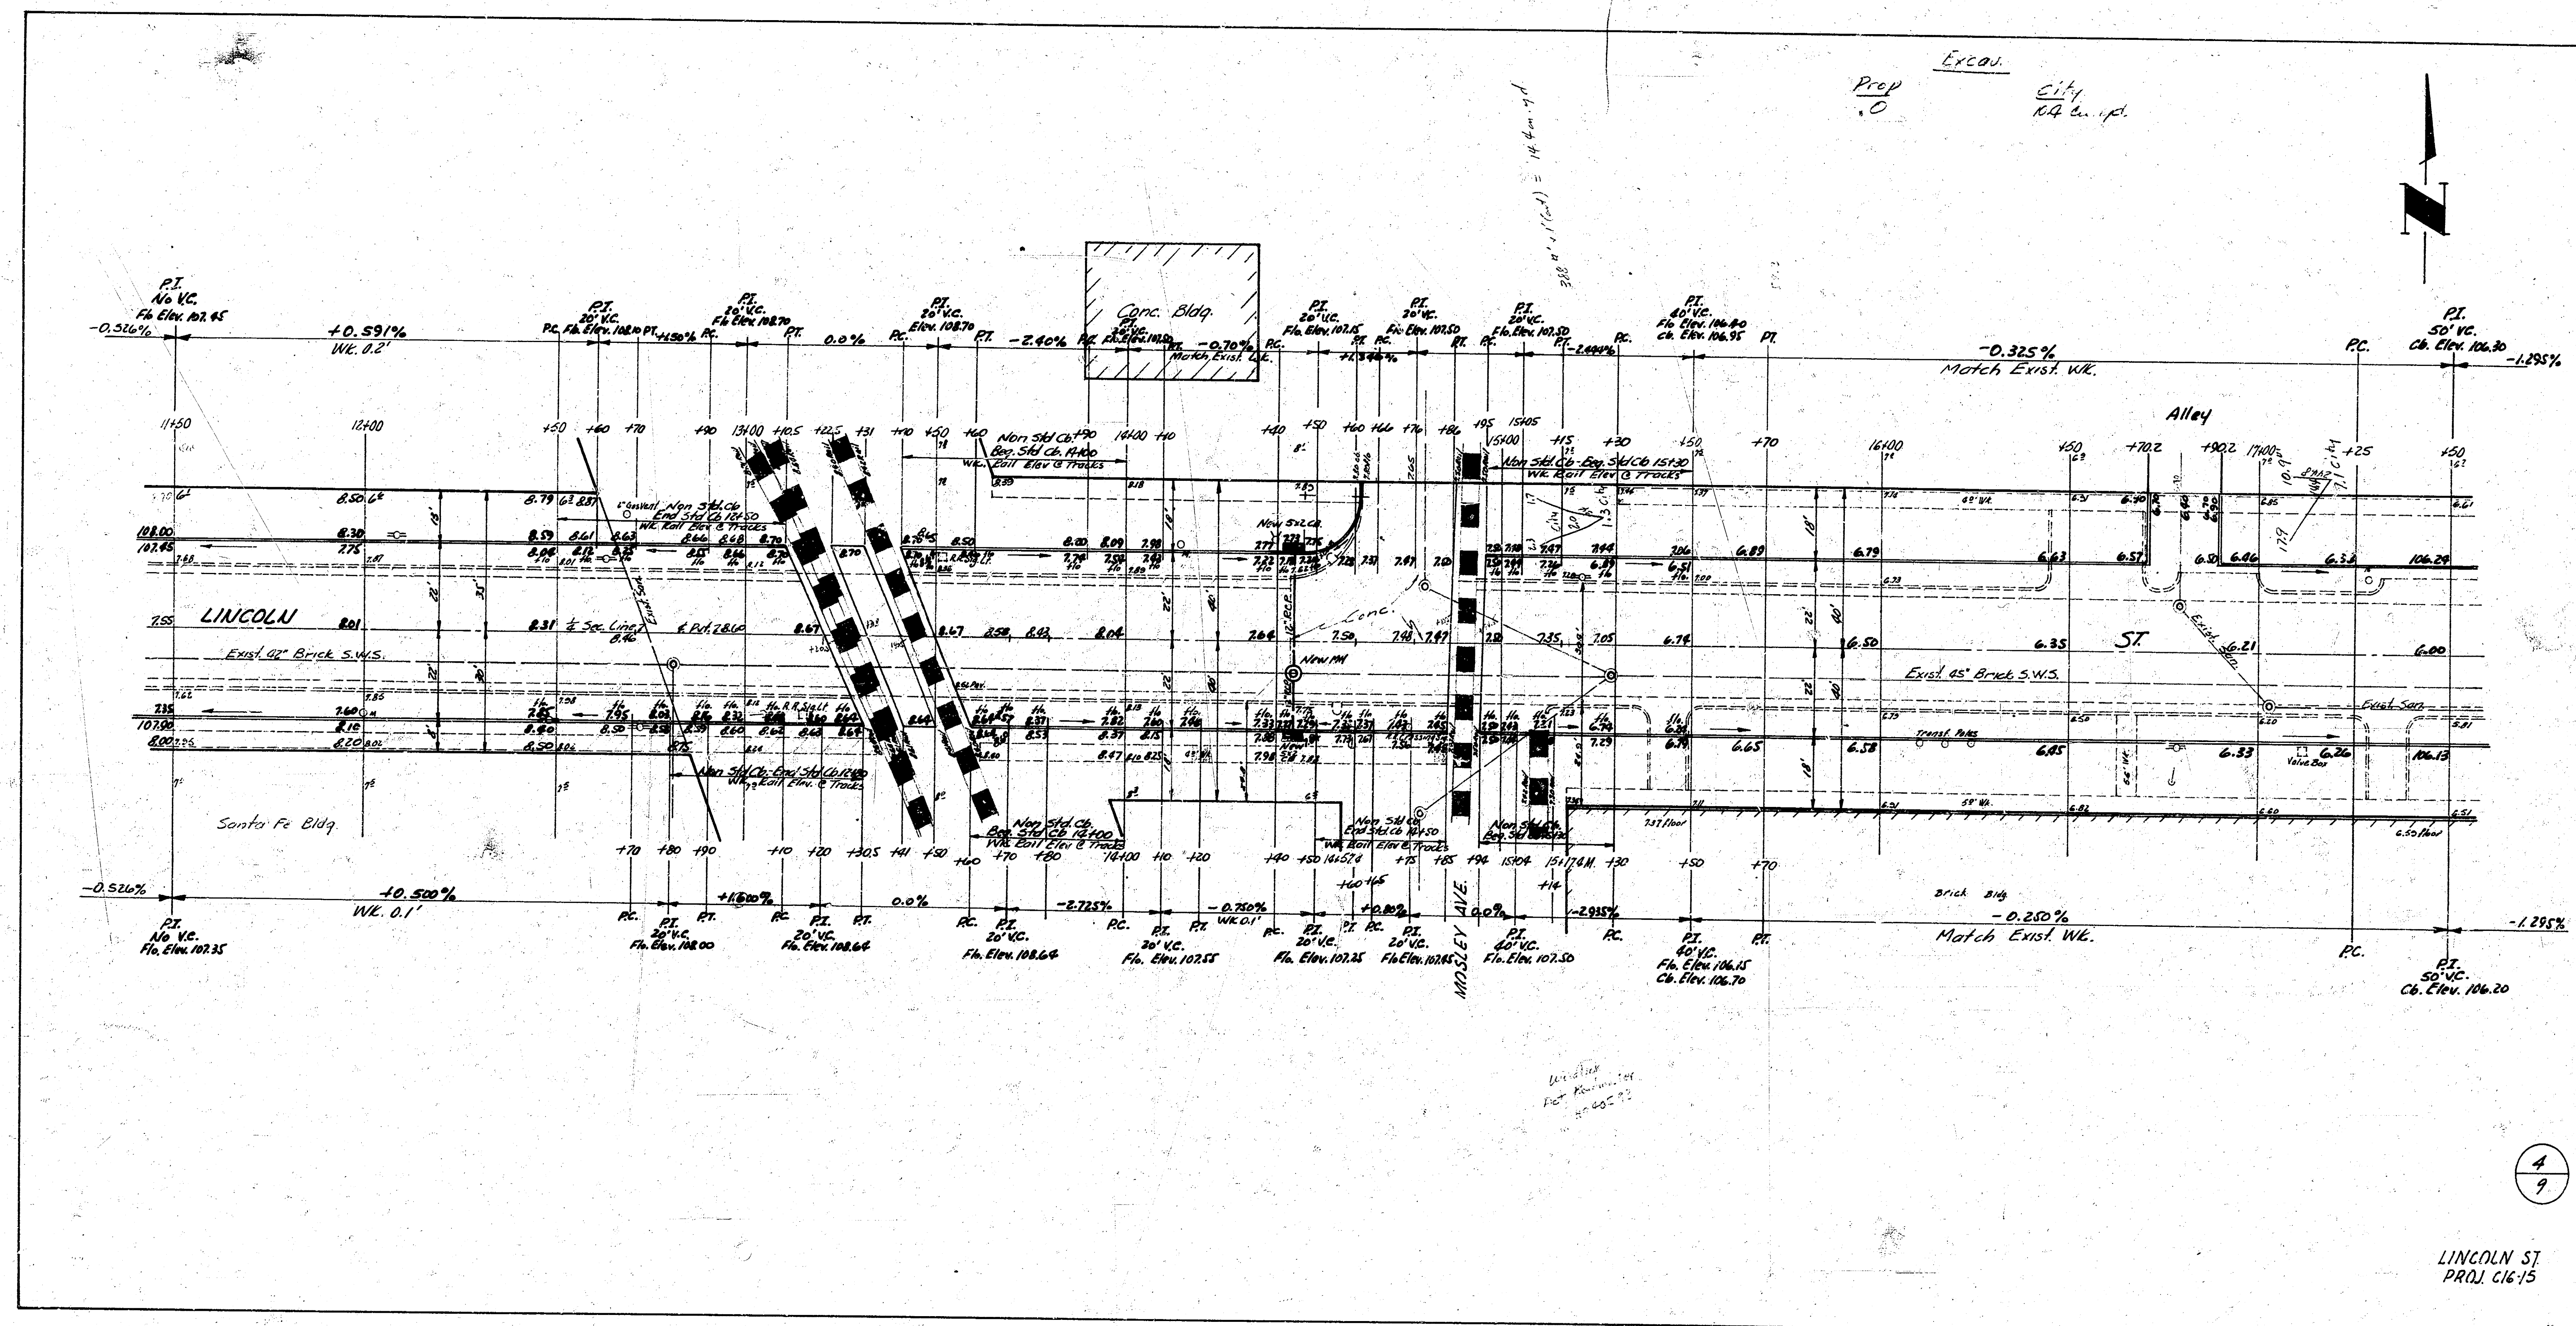

Prop 0 Exec. City 92.6 cu. yd.

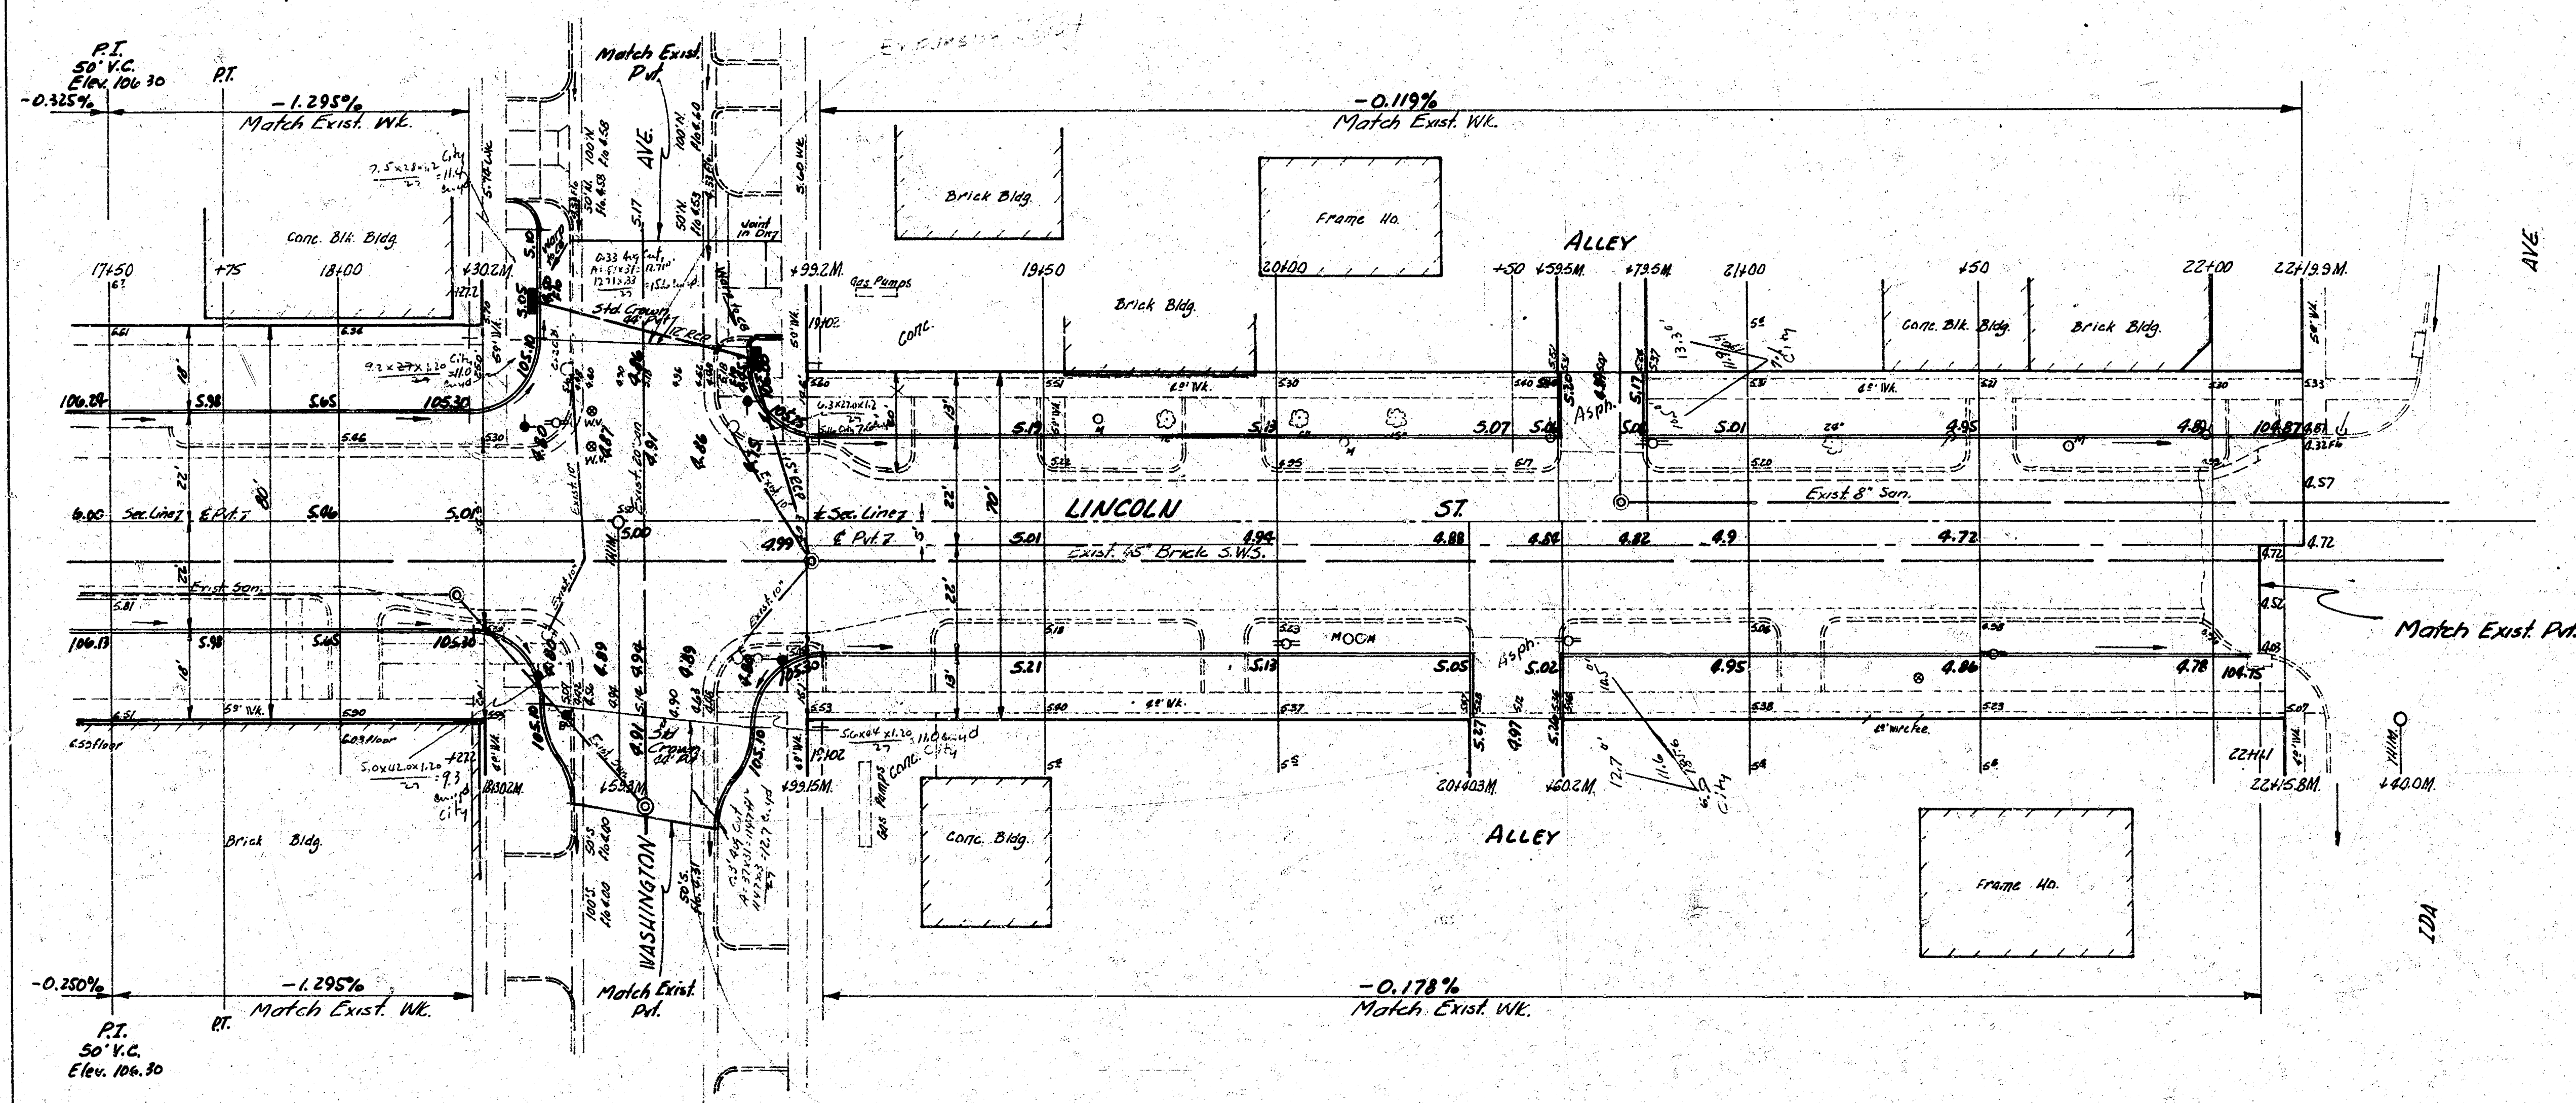

5
9


LINCOLN ST
PROJ. 016-15

B.M. 106.76 'M' in Martin 1' N.E. of N.E. Cor. Emporia & Lincoln

B.M. 105.63 'K' in Keeler C. W. So. (4' S. of S.L.) S.E. Santa Fe & Lincoln

B.M. 108.46 N.E. Cor. R.R. Sp. Lt. Base S.S. Lincoln, 100' W. of Mosley

B.M. 104.87 Star-shaped S.E. Washington & Lincoln

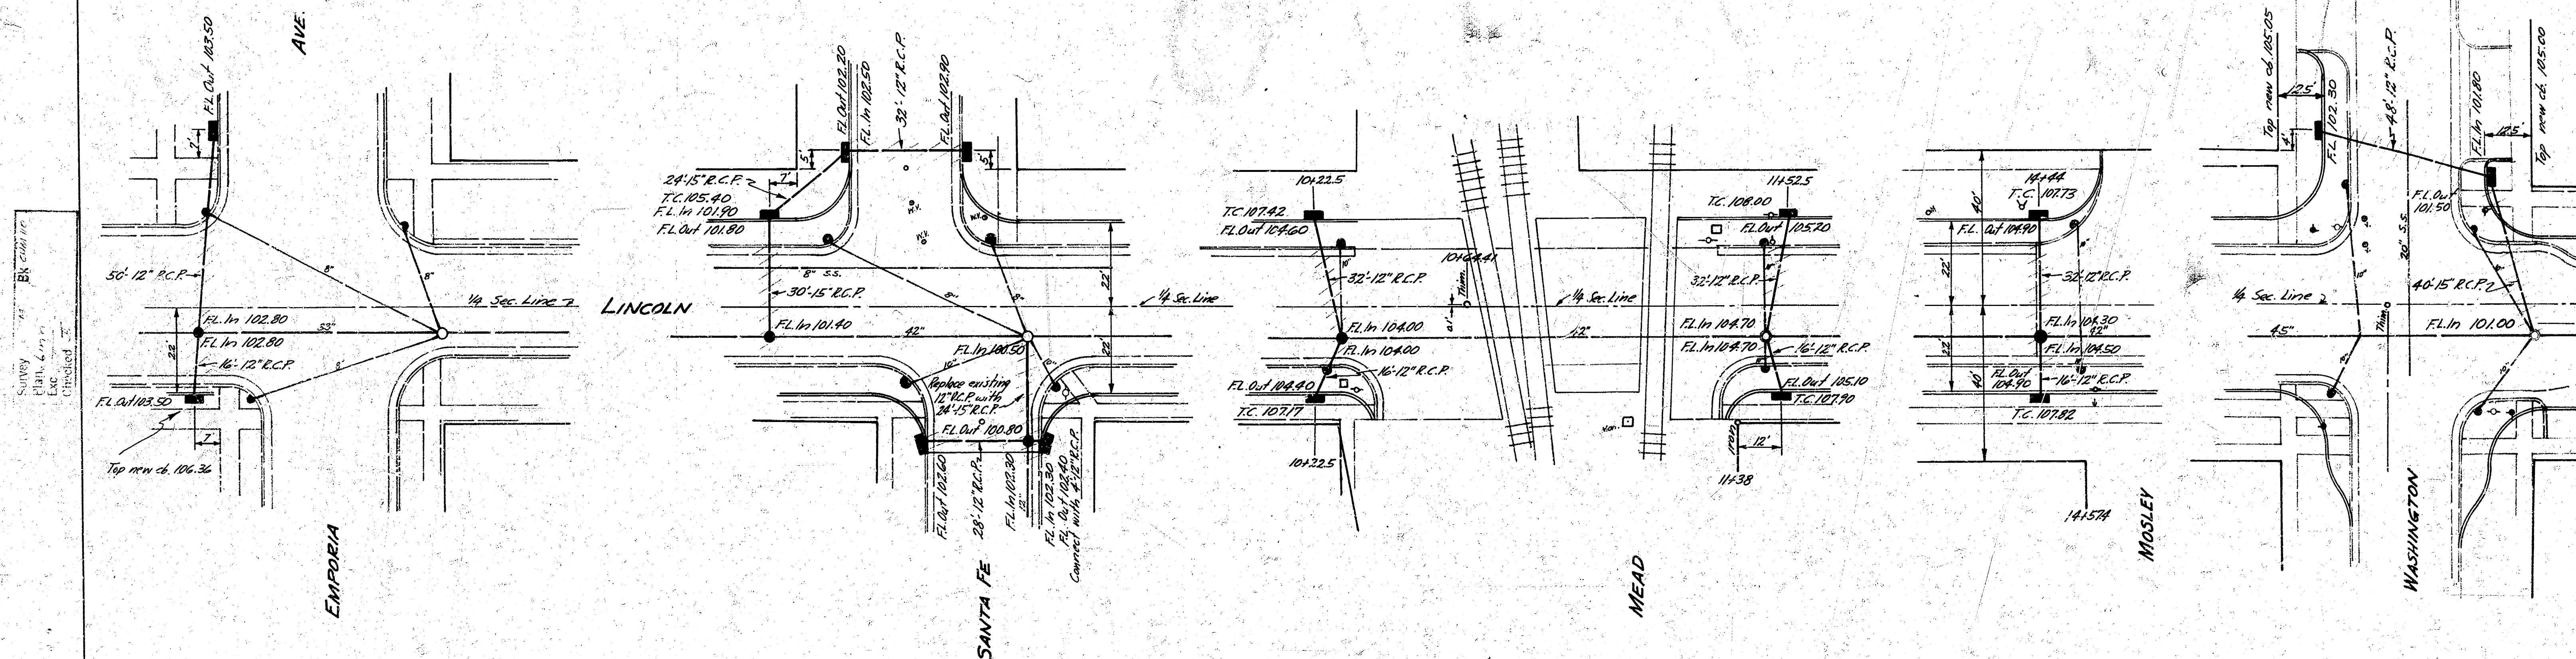

NOTE: Remove existing 24" C.B.s where necessary, only plug all existing C.B. leads of C.B.s and all brick sewer.



INCIDENTAL DRAINAGE
LINCOLN ST.
W.L. EMPORIA TO W.L. IDA
CITY OF WICHITA, KANSAS
B.E. SMITH - CITY ENGINEER
PROJECT No. C16-15
JULY, 1956