

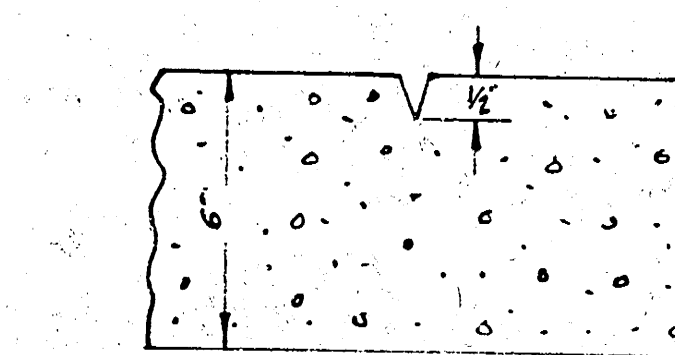



6-6
10.2.2.2

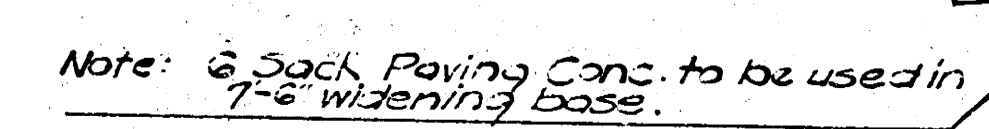

DETAIL - PLANE OF WEAKNESS
PLANE OF WEAKNESS TO BE CUT WITH
DOUBLE-EDGE GROOVER TO DEPTH AS
SHOWN IN A STRAIGHT LINE FROM
CURB TO CURB. 26' CTR. TO CTR.

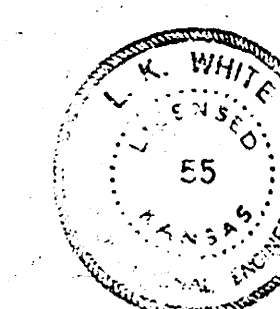


5-4

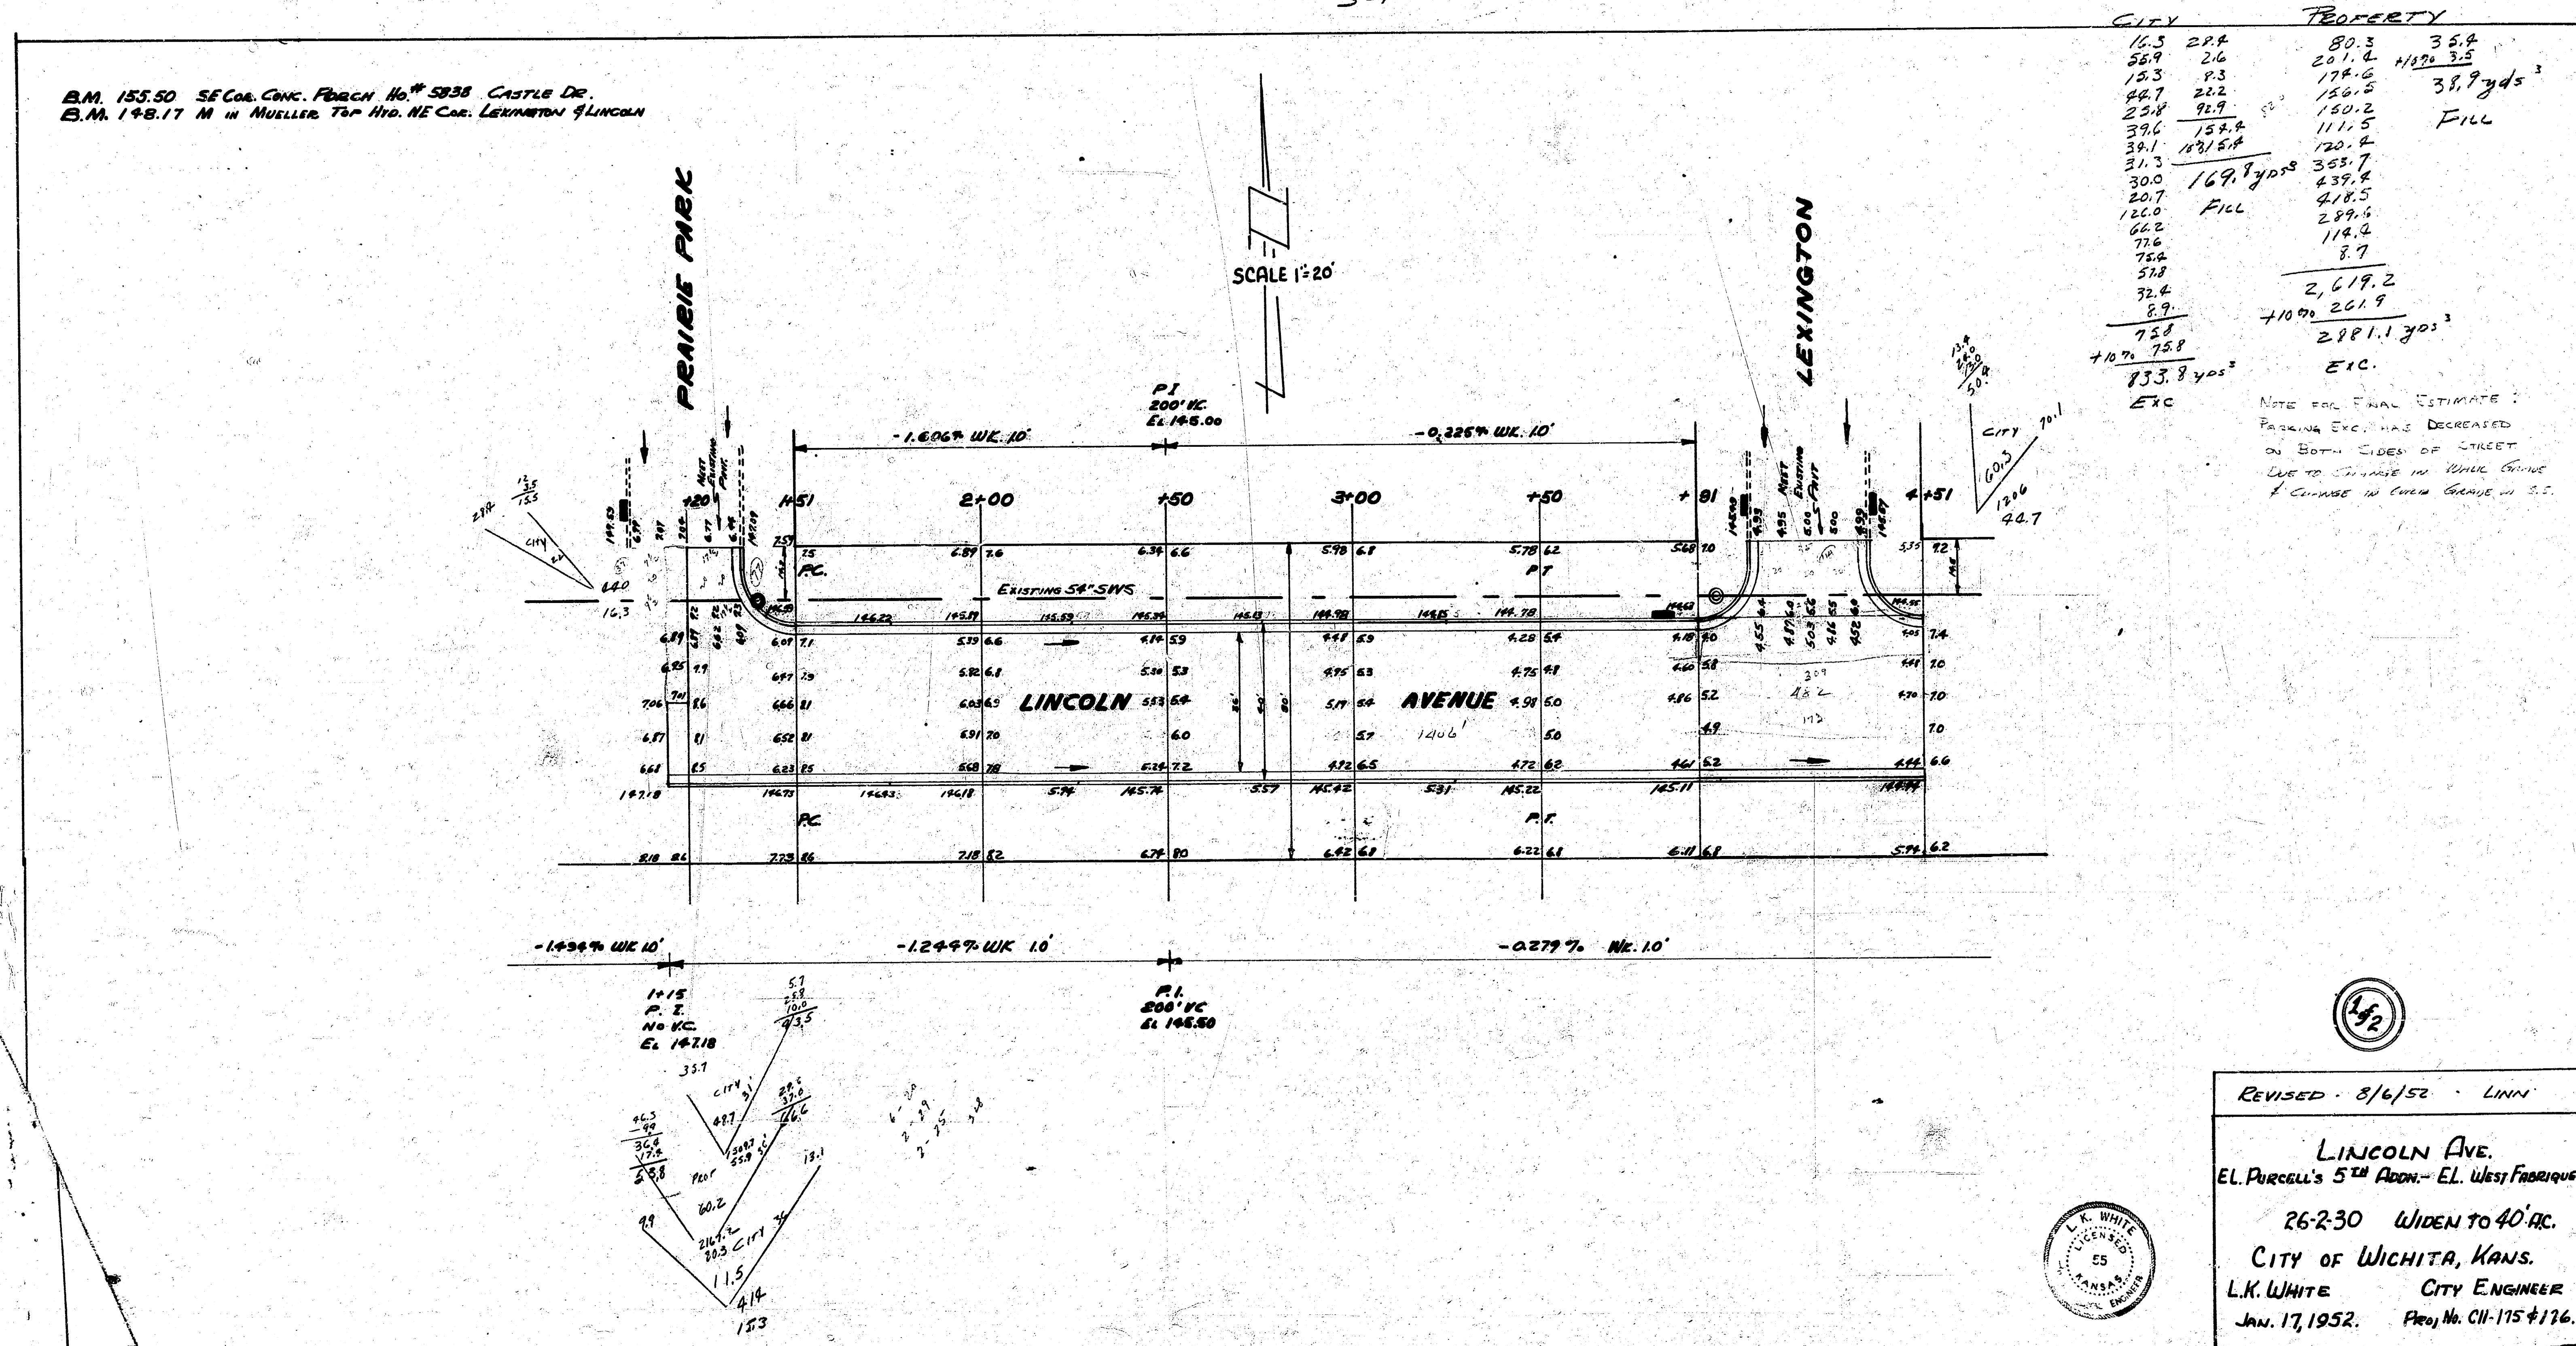


LEXINGTON

SCALE 1"=20'

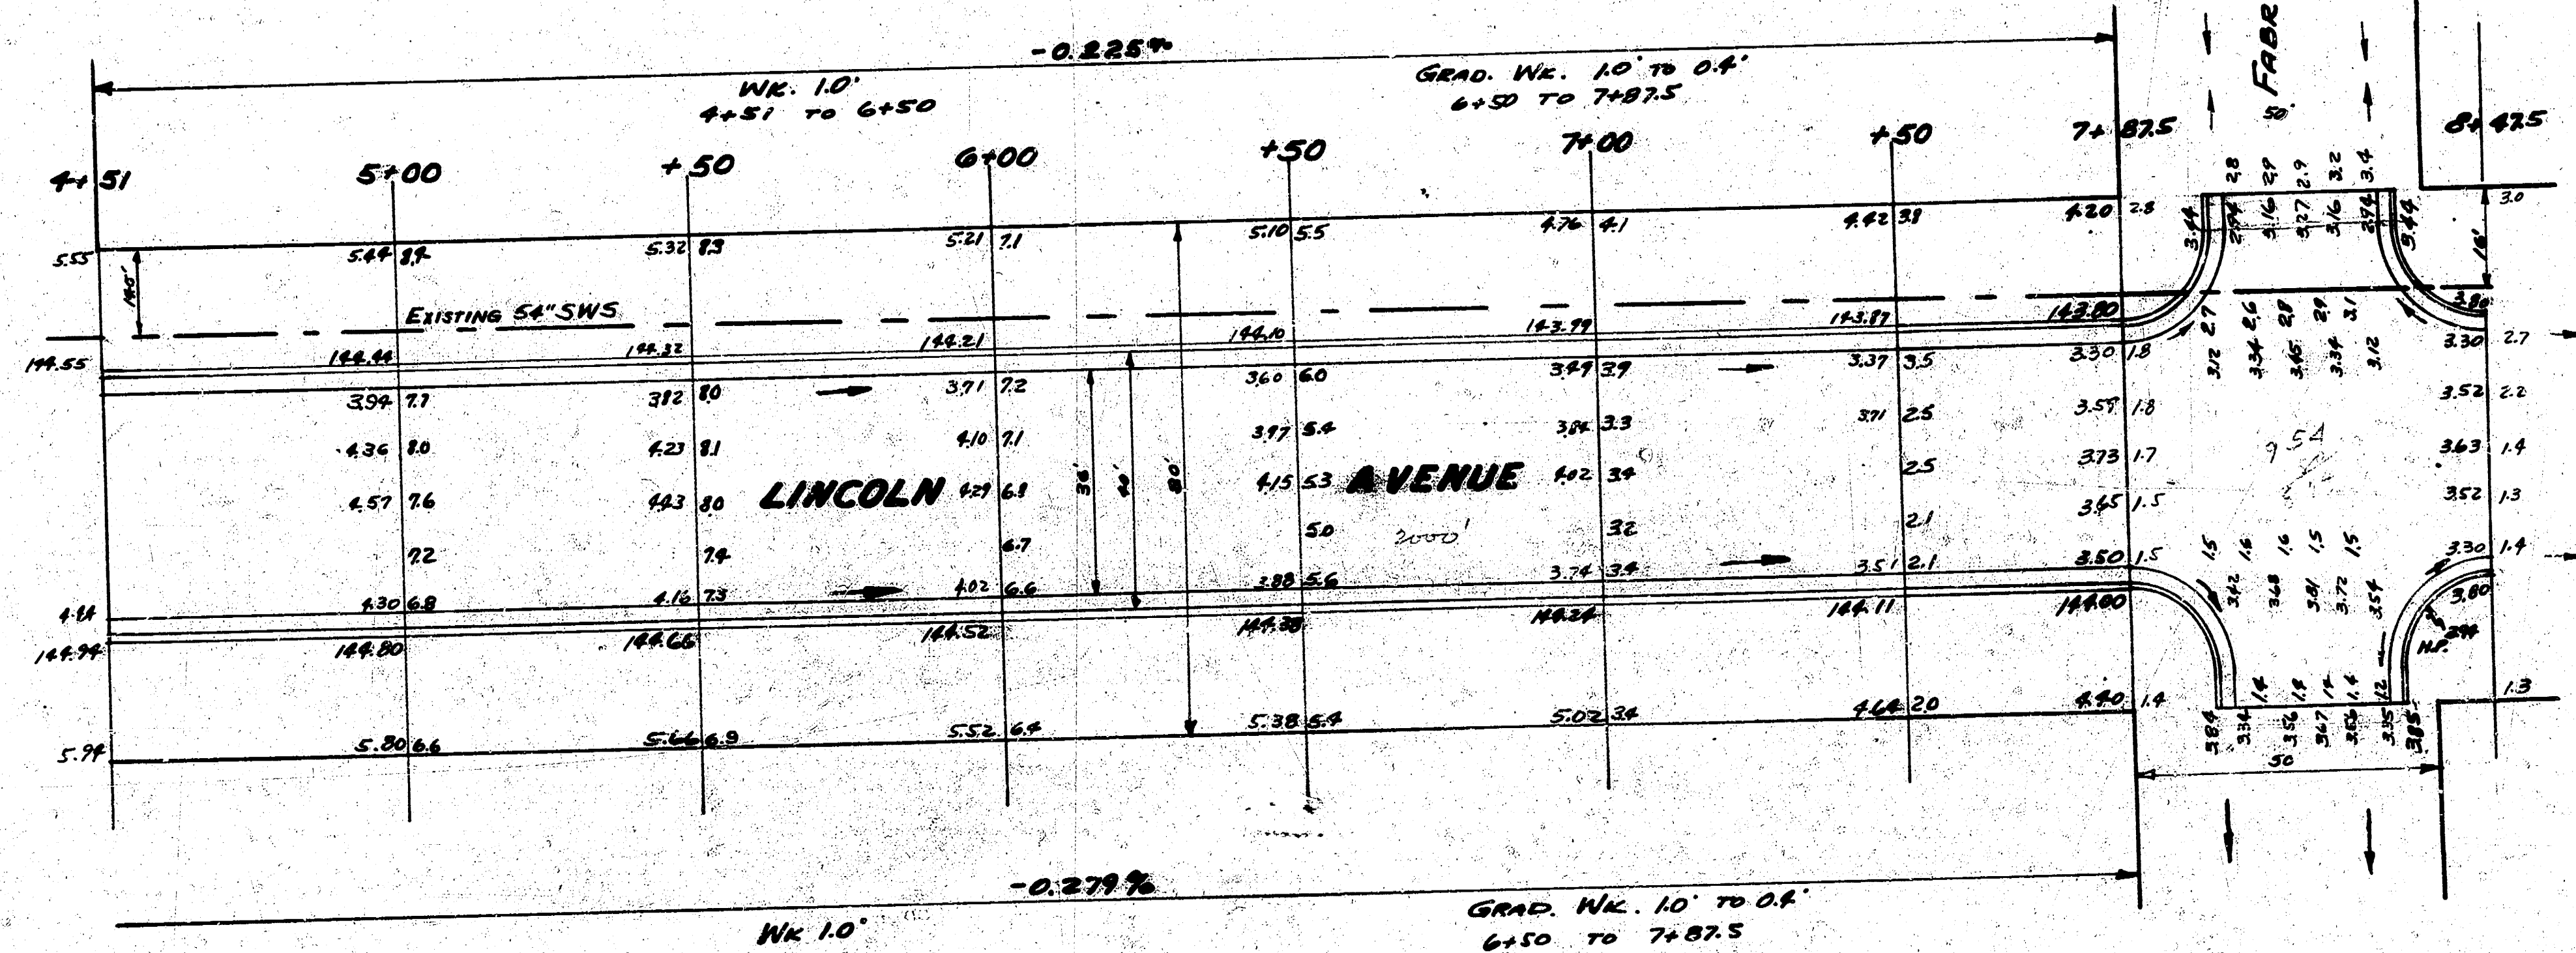

WEST

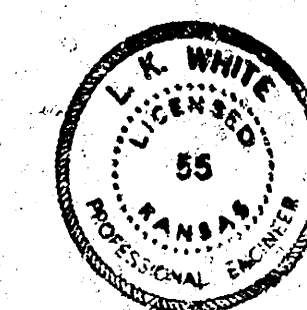

LINCOLN AVE

REVISED - 8/6/52 - LMM

1520